
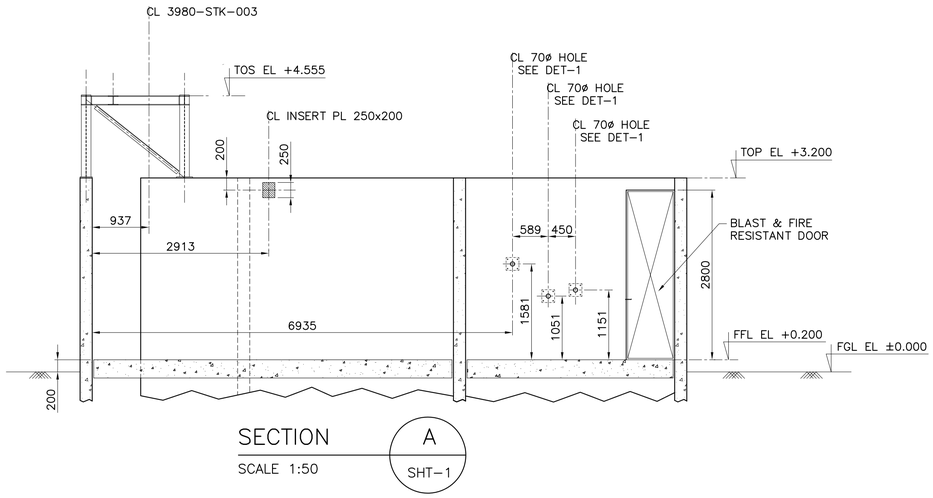



SECTION A
SCALE 1:50
SHT-1

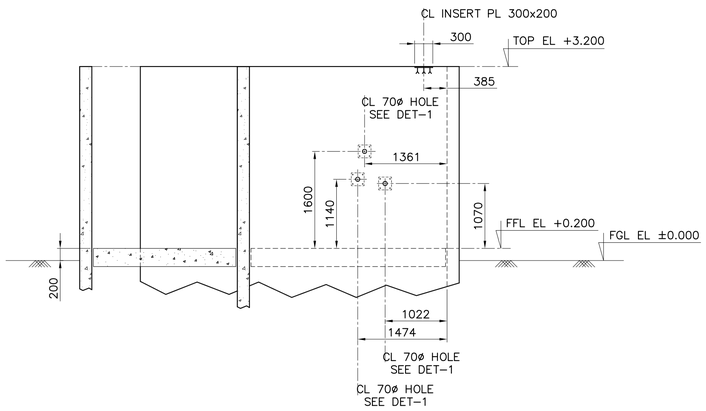

SECTION C
SCALE 1:50
SHT-1

NOTES


1. ALL DIMENSIONS ARE IN MILLIMETER.
2. ALL LEVELS ARE IN METER.
3. FOR ALL OTHER NOTES SEE SHEET-1.
4. FOR LEGEND SEE SHEET-1.

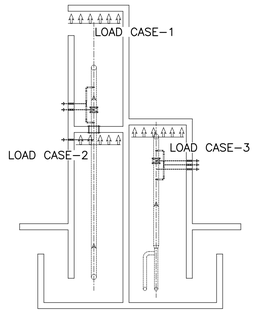


JET LOAD CONSIDERATION

SCALE 1:100


LOAD CASE	HORIZONTAL JET LOAD	REMARKS
1	TOTAL LOAD = 90.0 kN	JET LOAD SHALL BE DIVIDED BY WALL AREA TO GET THE UNIFORM DESIGN PRESSURE ON WALL WALL AREA = WIDTH OF WALL (AS SHOWN IN JET LOAD CASE 1, 2 & 3) X FULL HEIGHT OF WALL PRESSURE IN PIPE = 45 BAR
2	TOTAL LOAD = 90.0 kN	
3	TOTAL LOAD = 90.0 kN	

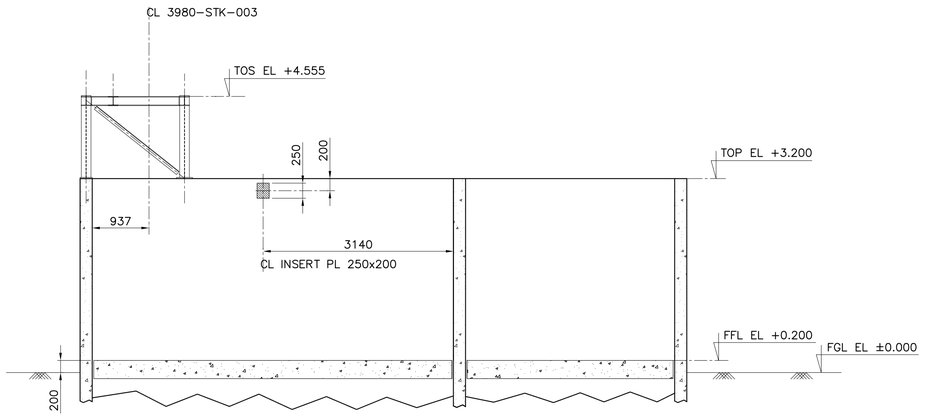

SECTION B
SCALE 1:50
SHT-1

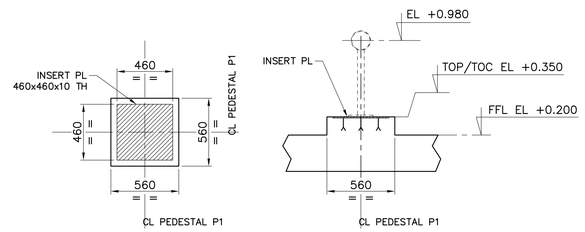

DETAIL PEDESTAL P3
SCALE 1:25

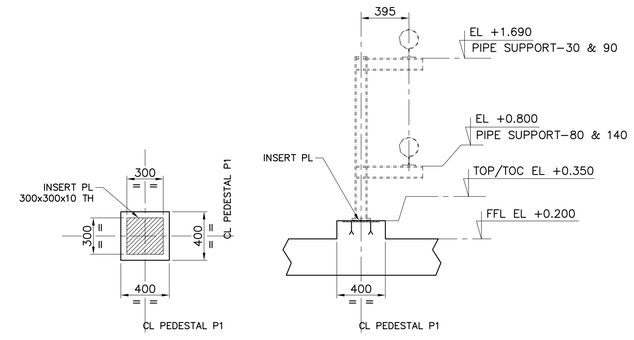

DETAIL PEDESTAL P2B
SCALE 1:25

PIPE LOAD DATA

Pipe Support Point	Vertical loads (Upward +ve)			Horizontal Operational load	
	Empty	Operating	Hydro.	FX	FZ
	[KN]	[KN]	[KN]	[KN] (N-S)	[KN] (E-W)
10	-3.0	-3.0	-3.0	1.0	2.5
20	-4.0	-4.0	-4.0	1.0	2.5
30	-2.0	-6.0	-2.0	-6.5	6.5
40	-6.0	-6.0	-6.0	2.0	1.5
50	-6.0	-6.0	-6.0	2.2	2.0
60	-2.0	-6.5	-2.0	3.0	2.0
70	-6.0	-6.0	-6.0	2.0	2.0
80	-5.0	-5.0	-5.0	3.0	3.0
90	-2.0	-10.0	-2.0	-11.0	8.5
100	-2.0	-2.0	-2.0	0.8	0.8
110	-2.0	-2.0	-2.0	0.8	0.8
120	-2.0	-2.0	-2.0	0.8	0.8
130	-2.0	-2.0	-2.0	0.8	0.8
140	-3.5	-7.0	-3.5	3.0	1.0
150	-	-	-	7.5	7.5
160	-	-	-	12.5	-12.5
170	-	-	-	2.5	2.5

FX - North South Direction

FZ - East West Direction

DOCUMENT NUMBER	REFERENCE DOCUMENTS	REV	DATE	REVISION DESCRIPTION	DRN	CHK	ENG	APP	EMP
		D01	22/02/2023	AS-BUILT	--	STY/SYC/SHH	--	BDA/PRI/JPD	
		C02	23/10/2020	ISSUED FOR CONSTRUCTION	--	STY/SYC/SHH	--	BDA/PRI/JPD	
		C01	07/08/2020	ISSUED FOR CONSTRUCTION	--	STY/SYC/SHH	--	BDA/PRI/JPD	
		A01	29/06/2020	ISSUED FOR INFORMATION	--	STY/SYC/SHH	--	BDA/PRI/JPD	

Air Liquide ENGINEERING & CONSTRUCTION
AIR LIQUIDE CONFIDENTIAL INFORMATION: THIS PRINT IS THE PROPERTY OF L'AIR LIQUIDE S.A. OR ITS DIRECT AND INDIRECT) AFFILIATES OR SUBSIDIARIES AND CONTAINS VALUABLE CONFIDENTIAL INFORMATION. COPYRIGHT AND ALL OTHER RIGHTS IN THIS PRINT ARE EXPRESSLY RESERVED. NO PART OF THIS PRINT MAY BE DISCLOSED BY THE INTENDED RECIPIENT TO A THIRD PARTY, REPRODUCED, COPIED, LENT, OR DISPOSED OF, DIRECTLY OR INDIRECTLY, NOR USED FOR ANY PURPOSE OTHER THAN THAT FOR WHICH IT IS EXPRESSLY FURNISHED. THIS PRINT IS LENT SUBJECT TO RETURN ON DEMAND.

LARSEN & TOUBRO
This drawing is the property of LARSEN & TOUBRO and must not be passed on to any person or body not authorized by us to receive it nor be copied or otherwise made use either in full or in part by such person or body without our prior permission in writing.

Outotec
The content of these documents are the sole property of Outotec Oy). Any rights not expressly granted herein are reserved. Reproduction, transfer or distribution of part or all of the contents in any form without prior written permission of Outotec is prohibited.

MA'ADEN معادن
Saudi Arabian Mining Company شركة التعدين العربية السعودية
This document and the information contained herein is Ma'aden proprietary know-how. This document or any part thereof should not be reproduced, stored in a retrieval system or transmitted by any means, electronic or otherwise, or divulged without prior written permission of Ma'aden.

DRAWING NUMBER	12126-60-01-CS-141221	REVISION	1
STATUS	AFD		
DATE	10/06/2020	DATE	11/06/2020
DATE	25/06/2020		
DRAWN	SGH	CHECKED	ABM
APPROVED	DS		

LARSEN & TOUBRO DRAWING NUMBER	O19045_080_C_V_24225_012	REVISION	3
OUTOTEC DRAWING NUMBER	900707__GAU01__AG22__MTL01__39845	DOCUMENT ID	OU100688445
		REVISION	3

DRAWN	--	--	
CHECKED	STY/ SYC/ SHH	26/06/2020	
ENGINEER	--	--	
APPROVED	BDA/ PRI/ JPD	29/06/2020	
EMPLOYER			
SCALE	1:100, 50	A1	

MANSOURAH - MASSARAH GOLD PROJECT
GENERAL ARRANGEMENT DRAWING
OXYGEN PLANT
GUIDE DRAWING-GOX BARRIER (2 OF 2)

DRAWING NUMBER MD-216-3980-EG-CV-GAD-V551-1485 REV D01