


DRAWING NUMBER: MD-216-3980-EG-CV-GAD-V551-1487 | REV: D01

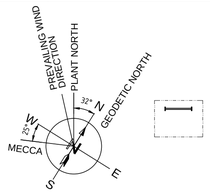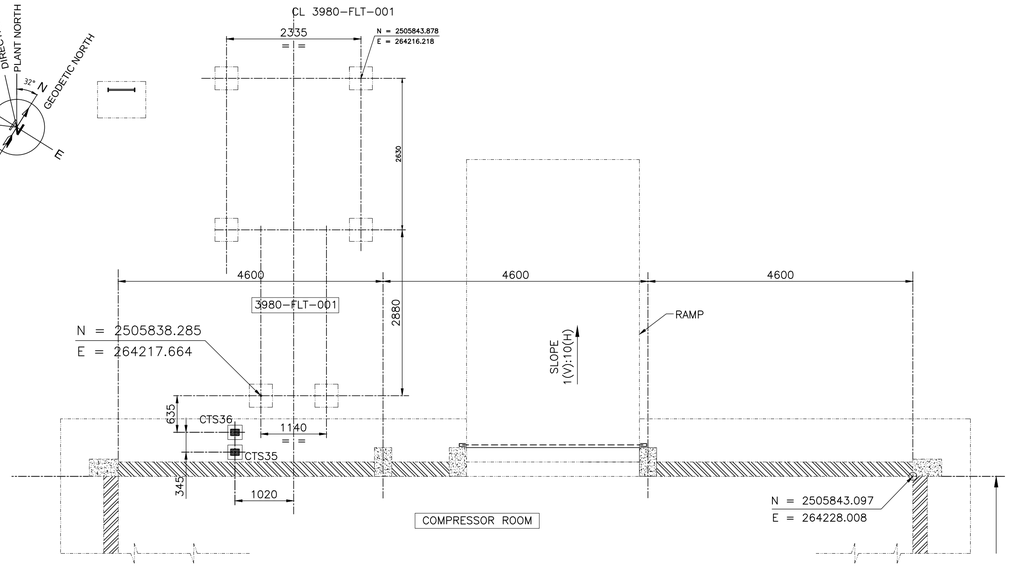



## TRAY SUPPORT PLAN NEAR AIR FILTER

SCALE 1:50

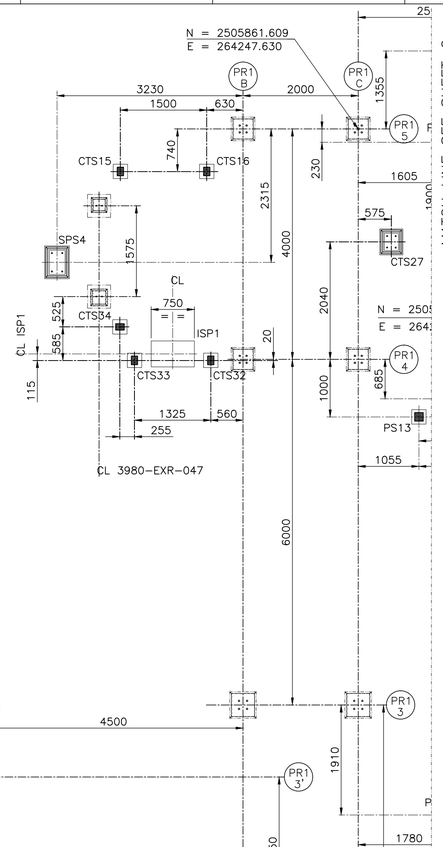


## PIPE & TRAY SUPPORT PLAN

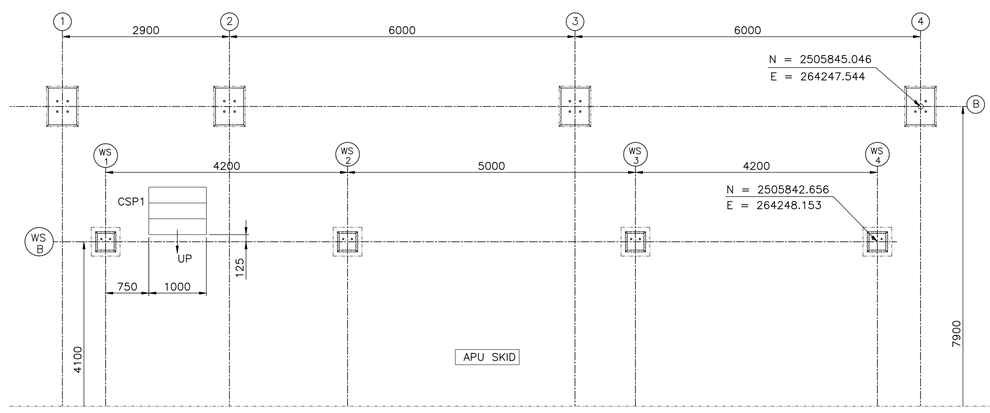
SCALE 1:50

## NOTES

1. ALL DIMENSIONS ARE IN MILLIMETER.
2. ALL LEVELS ARE IN METER.
3. FGL LEVEL ±0.0 CORRESPONDS TO RL 912.350.
4. THE LOADS INDICATED IN LOAD DATA TABLE ARE ACTUAL. FOUNDATION DESIGNER SHOULD CONSIDER NECESSARY MARGIN.
5. SIZE OF FOUNDATION AND PEDESTAL SHALL BE DECIDED BY CIVIL DESIGN ENGINEER AS PER GIVEN LOADING.
6. ADDITIONAL REBAR REQUIREMENT AROUND ANCHOR BOLTS TO ENSURE NO FAILURE OF CONCRETE SHALL BE DECIDED BY CIVIL DESIGN ENGINEER AS PER GIVEN LOADING.
7. FOR ELECTRICAL & INSTRUMENTATION STANCHIONS FOR UNPAVED AREA CONCRETE BLOCKS (300x300x500 HIGH) SHALL BE PROVIDED. FOR LOCATIONS SEE E&I DRAWINGS.
8. FOR PIPE SUPPORT FOUNDATION LOAD DATA SEE SHT-3 & FOR CABLE TRAY SUPPORT FOUNDATION LOAD DATA SEE SHT-6.

LEGEND :

- BCD – BOLT CIRCLE DIAMETER
- C.G. – CENTER OF GRAVITY
- CL – CENTER LINE
- CONC – CONCRETE
- EL – ELEVATION
- EQP – EQUIPMENT
- FGL – FINISHED GROUND LEVEL
- Gr – GRADE
- IL – INVERT LEVEL
- MIN – MINIMUM
- MPa – MEGA PASCAL
- mm – MILLIMETER
- No – NUMBER / NUMBERS
- TOC – TOP OF CONCRETE
- TOG – TOP OF GROUT
- TH – THICKNESS
- TYP – TYPICAL

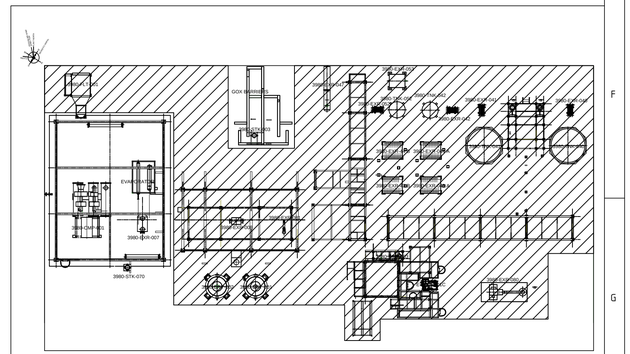

KEY PLAN

| DOCUMENT NUMBER | REFERENCE DOCUMENTS | REV | DATE | REVISION DESCRIPTION | DRN | CHK | ENG | APP | EMP |
|---|---|---|---|---|---|---|---|---|---|
| MD-216-3980-EG-ST-GAD-V551-2397 | PIPE & TRAY SUPPORTS (SHEET-5) | | | | | | | | |
| MD-216-3980-EG-ST-GAD-V551-2396 | PIPE & TRAY SUPPORTS (SHEET-4) | | | | | | | | |
| MD-216-3980-EG-ST-GAD-V551-2395 | PIPE & TRAY SUPPORTS (SHEET-3) | D01 | 08/05/2023 | AS - BUILT | -- | STY/SYC/SHH | -- | BDA/PRI/JPD | |
| MD-216-3980-EG-ST-GAD-V551-2394 | PIPE & TRAY SUPPORTS (SHEET-2) | C01 | 20/03/2021 | ISSUED FOR CONSTRUCTION & REVISED AS PER | | | | | |
| MD-216-3980-EG-ST-GAD-V551-2393 | PIPE & TRAY SUPPORTS (SHEET-1) | | | EMPLOYER'S COMMENT ON 04/02/2021 | -- | STY/SYC/SHH | -- | BDA/PRI/JPD | |
| MD-216-3980-EG-PI-PPD-V551-1001 | PLOT PLAN | A01 | 21/12/2020 | ISSUED FOR INFORMATION | -- | STY/SYC/SHH | -- | BDA/PRI/JPD | |


Air Liquide ENGINEERING & CONSTRUCTION

AIR LIQUIDE CONFIDENTIAL INFORMATION: THIS PRINT IS THE PROPERTY OF L'AIR LIQUIDE S.A. OR ITS DIRECT AND INDIRECT AFFILIATES OR SUBSIDIARIES AND CONTAINS VALUABLE CONFIDENTIAL INFORMATION. COPYRIGHT AND ALL OTHER RIGHTS IN THIS PRINT ARE EXPRESSLY RESERVED. NO PART OF THIS PRINT MAY BE DISCLOSED BY THE INTENDED RECIPIENT TO A THIRD PARTY, REPRODUCED, COPIED, LENT, OR DISPOSED OF, DIRECTLY OR INDIRECTLY, NOR USED FOR ANY PURPOSE OTHER THAN THAT FOR WHICH IT IS EXPRESSLY FURNISHED. THIS PRINT IS LENT SUBJECT TO RETURN ON DEMAND.

LARSEN & TOUBRO

This drawing is the property of LARSEN & TOUBRO and must not be passed on to any person or body not authorized by us to receive it nor be copied or otherwise made use either in full or in part by such person or body without our prior permission in writing.

Outotec

The content of these documents are the sole property of Outotec Oyj. Any rights not expressly granted herein are reserved. Reproduction, transfer or distribution of part or all of the contents in any form without prior written permission of Outotec is prohibited.

MA'ADEN معادن
Saudi Arabian Mining Company شركة معادن العربية السعودية

This document and the information contained herein is Ma'aden proprietary know-how. This document or any part thereof should not be reproduced, stored in a retrieval system or transmitted by any means, electronic or otherwise, or divulged without prior written permission of Ma'aden.


| | | | |
|---|---|---|---|
| DRAWING NUMBER | 12126-60-01-CS-141250 | REVISION | 1 |
| STATUS | AFD | | |
| DATE | 14/12/2020 | DATE | 15/12/2020 |
| DATE | 10/03/2021 | | |
| DRAWN | SGH | CHECKED | ABM |
| APPROVED | DS | | |

| | | | |
|---|---|---|---|
| LARSEN & TOUBRO DRAWING NUMBER | 019045_080_C_V_24225_014 | REVISION | 2 |
| OUTOTEC DRAWING NUMBER | 900707__GAU01__AG22__MTL01__39843 | DOCUMENT ID | OU100687955 |
| | | REVISION | 2 |

| | | |
|---|---|---|
| DRAWN | -- | -- |
| CHECKED | STY/ SYC/ SHH | 11/03/2021 |
| ENGINEER | -- | -- |
| APPROVED | BDA/ PRI/ JPD | 12/03/2021 |
| EMPLOYER | | |
| SCALE | 1:30 | A1 |

MANSOURAH - MASSARAH GOLD PROJECT
GENERAL ARRANGEMENT DRAWING
OXYGEN PLANT
FOUNDATION LOAD-PIPE & TRAY SUPPORT SHT-1

DRAWING NUMBER: MD-216-3980-EG-CV-GAD-V551-1487 | REV: D01

# Mansourah Massarah Gold Project
# Comment Resolution Log Sheet / Compliance Report

**PROJECT:** MANSOURAH MASSARAH GOLD PROJECT **PROJECT NO.:** 216

**STAGE:** 4 - PROJECT EXECUTION. **REVIEW LOG DOC. NO. & REV.:**

**ACONEX REF. NO. & DATE:** MAADEN-STRAN-002805, 04 February 2021

STATUS CODE: A - APPROVED, C - APPROVED WITH COMMENTS, R - REVISE & RESUBMIT & O - OTHERS (INFORMATION, REFERENCE, REVIEWED)

| DOCUMENT NUMBER | Area / Title | Comment No. | PMC/PMT COMMENT<br>DATE: 04 February 2021 | Comment by | EPC Response<br>DATE: 20 March 2021 | Status | Remarks |
|---|---|---|---|---|---|---|---|
| | | | **General Comments (cc)** | | | | |
| MD-216-3980-EG-CV-GAD-V551-1487-A01 | 3980 | 1 | Please include reference drawings | Mr. Doron Golan - Bechtel | Incorporated. | Closed | |