


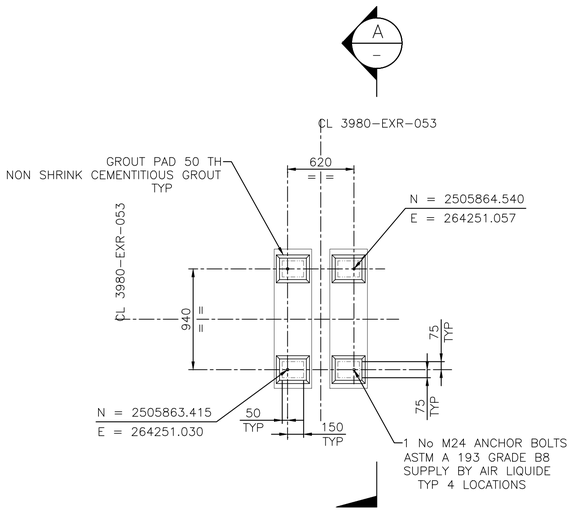

FOUNDATION PLAN SERVICE NITROGEN VAPORIZER


SCALE 1:30

LOAD DATA TABLE

SERVICE NITROGEN VAPORIZER (3980–EXR–053)		
SL No	Description	
1	EMPTY LOAD	8.0 kN
2	OPERATING LOAD	20.0 kN
3	TEST LOAD	20.0 kN
4	WIND MOMENT	20.0 kN–m
	WIND HORIZONTAL FORCE	10.0 kN
5	SEISMIC MOMENT	14.0 kN–m
	SEISMIC HORIZONTAL FORCE	7.0 kN

THESE ARE TOTAL LOAD AT CENTER OF BASE PLATE LEVEL OF EQUIPMENT.

EMPTY, OPERATING AND TEST LOADS ARE VERTICAL DOWNWARD LOAD.

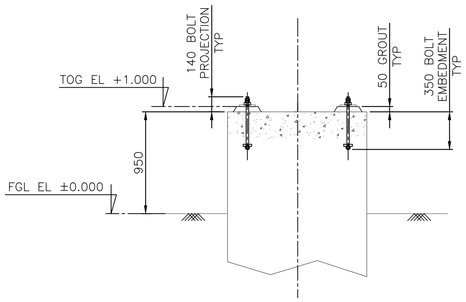

SECTION A


SCALE 1:30

NOTES

1. ALL DIMENSIONS ARE IN MILLIMETER.
2. ALL LEVELS ARE IN METER.
3. FGL LEVEL ±0.0 CORRESPONDS TO RL 912.350.
4. THE LOADS INDICATED IN LOAD DATA TABLE ARE ACTUAL. FOUNDATION DESIGNER SHOULD CONSIDER NECESSARY MARGIN.
5. SIZE OF FOUNDATION AND PEDESTAL SHALL BE DECIDED BY CIVIL DESIGN ENGINEER AS PER GIVEN LOADING.
6. ADDITIONAL REBAR REQUIREMENT AROUND ANCHOR BOLTS TO ENSURE NO FAILURE OF CONCRETE SHALL BE DECIDED BY CIVIL DESIGN ENGINEER AS PER GIVEN LOADING.

LEGEND:

BCD – BOLT CIRCLE DIAMETER
C.G. – CENTER OF GRAVITY
CL – CENTER LINE
CONC – CONCRETE
EL – ELEVATION
EQP – EQUIPMENT
FGL – FINISHED GROUND LEVEL
Gr – GRADE
MIN – MINIMUM
MPa – MEGA PASCAL
mm – MILLIMETER
No – NUMBER / NUMBERS
TOC – TOP OF CONCRETE
TOG – TOP OF GROUT
TH – THICKNESS
TYP – TYPICAL

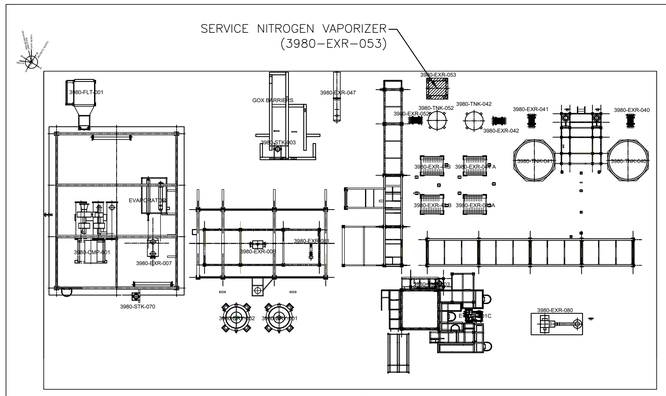

KEY PLAN

REV	DATE	REVISION DESCRIPTION	DRN	CHK	ENG	APP	EMP
D01	22/02/2023	AS-BUILT	--	STY/SYC/SHH	--	BDA/PRI/JPD	
C01	10/08/2020	ISSUED FOR CONSTRUCTION & REVISED AS MARKED	--	STY/SYC/SHH	--	BDA/PRI/JPD	
A01	30/06/2020	ISSUED FOR INFORMATION	--	STY/SYC/SHH	--	BDA/PRI/JPD	

DOCUMENT NUMBER | REFERENCE DOCUMENTS

Air Liquide ENGINEERING & CONSTRUCTION
AIR LIQUIDE CONFIDENTIAL INFORMATION: THIS PRINT IS THE PROPERTY OF L'AIR LIQUIDE S.A. OR ITS DIRECT AND INDIRECT) AFFILIATES OR SUBSIDIARIES AND CONTAINS VALUABLE CONFIDENTIAL INFORMATION. COPYRIGHT AND ALL OTHER RIGHTS IN THIS PRINT ARE EXPRESSLY RESERVED. NO PART OF THIS PRINT MAY BE DISCLOSED BY THE INTENDED RECIPIENT TO A THIRD PARTY, REPRODUCED, COPIED, LENT, OR DISPOSED OF, DIRECTLY OR INDIRECTLY, NOR USED FOR ANY PURPOSE OTHER THAN THAT FOR WHICH IT IS EXPRESSLY FURNISHED. THIS PRINT IS LENT SUBJECT TO RETURN ON DEMAND.

DRAWING NUMBER				REVISION	STATUS
12126-60-01-CS-151141				0	AFD
DATE	24/06/2020	DATE	25/06/2020	DATE	26/06/2020
DRAWN	SGH	CHECKED	ABM	APPROVED	DS

LARSEN & TOUBRO DRAWING NUMBER	REVISION
019045_080_C_V_24225_022	2
OUTOTEC DRAWING NUMBER	DOCUMENT ID / REVISION
900707 _GAU01 _AG22_MTL01 _39831	OU100680056 / 2

LARSEN & TOUBRO
This drawing is the property of *LARSEN & TOUBRO* and must not be passed on to any person or body not authorized by us to receive it nor be copied or otherwise made use either in full or in part by such person or body without our prior permission in writing.

Outotec
The content of these documents are the sole property of Outotec Oyj. Any rights not expressly granted herein are reserved. Reproduction, transfer or distribution of part or all of the contents in any form without prior written permission of Outotec is prohibited.

MA'ADEN معادن
Saudi Arabian Mining Company شركة معادن العربية السعودية
This document and the information contained herein is Ma'aden proprietary know-how. This document or any part thereof should not be reproduced, stored in a retrieval system or transmitted by any means, electronic or otherwise, or divulged without prior written permission of Ma'aden.

DRAWN	--	--
CHECKED	STY/ SYC/ SHH	29/06/2020
ENGINEER	--	--
APPROVED	BDA/ PRI/ JPD	30/06/2020
EMPLOYER		
SCALE	1:30	A1

MANSOURAH - MASSARAH GOLD PROJECT
GENERAL ARRANGEMENT DRAWING
OXYGEN PLANT
FOUNDATION LOAD - NITROGEN VAPORIZER

DRAWING NUMBER: MD-216-3980-EG-CV-GAD-V551-1495 REV: D01