

DRAWING NUMBER: MD-216-3980-EG-CV-GAD-V551-1496
REV: D01

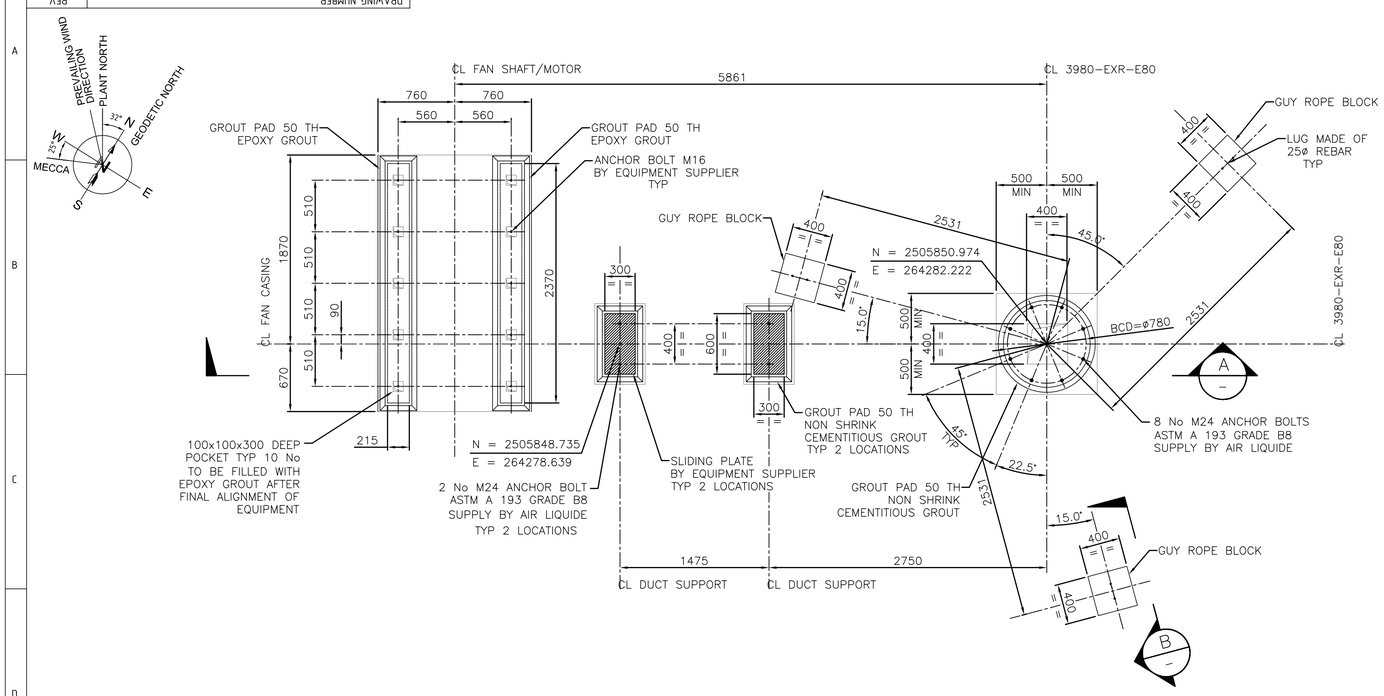


FOUNDATION PLAN LIQUID DISPOSAL SYSTEM

SCALE 1:30

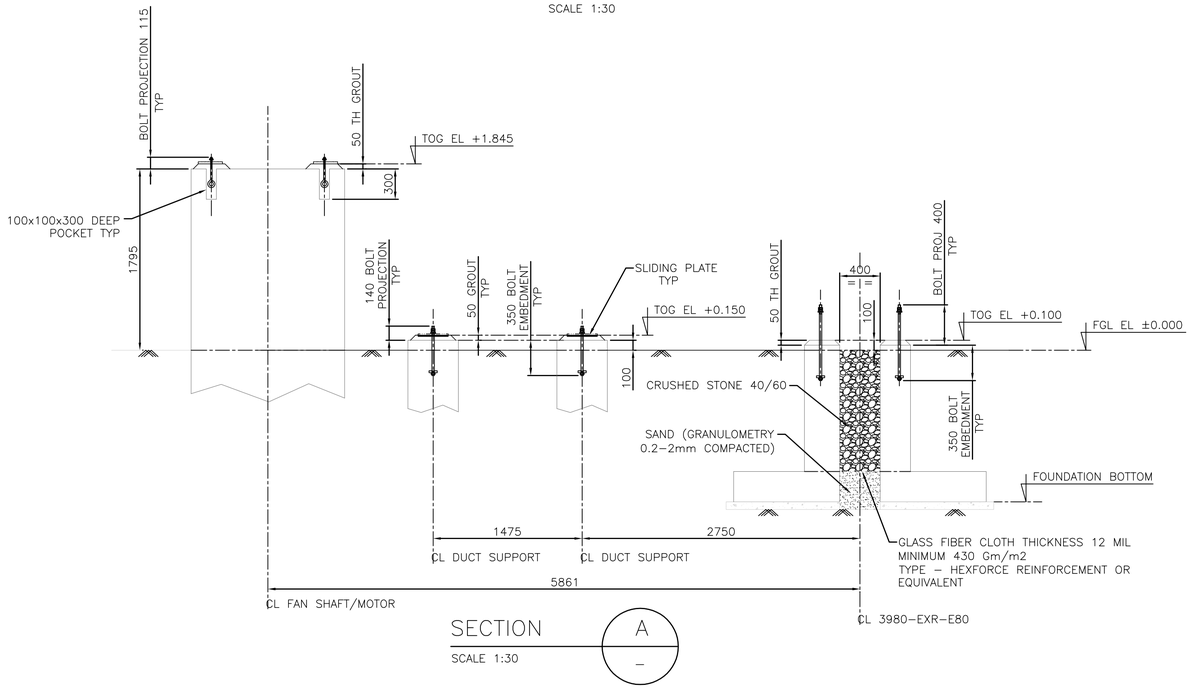

SECTION A

SCALE 1:30

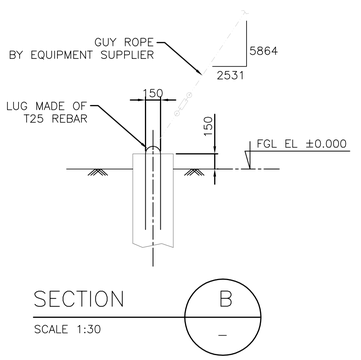

SECTION B

SCALE 1:30

LOAD DATA TABLE

SL No	Description	STACK 3980-EXR-E80	DUCT SUPPORT	FAN	REMARKS
1	OPERATING LOAD	10.0 kN	7.0 kN	STATIC LOAD/BOLT : 2.50 kN, TOTAL = 25.0 kN DYNAMIC LOAD/BOLT : 0.40 kN, TOTAL = 4.0 kN	–
2	WIND MOMENT	10.0 kN–m	2.5 kN–m	–	DESIGN CODE SBC–301–2007 WIND SPEED=49 m/sec
	WIND HORIZONTAL FORCE	3.0 kN	1.5 kN	–	
3	SEISMIC MOMENT	1.5 kN–m	0.6 kN–m	–	DESIGN CODE SBC–301–2007 SS=0.10g, S1=0.02g
	SEISMIC HORIZONTAL FORCE	0.5 kN	0.3 kN	–	

THESE ARE TOTAL LOAD AT CENTER OF BASE PLATE LEVEL FOR THE EQUIPMENT.
OPERATING LOADS ARE VERTICAL DOWNWARD LOAD.

LOAD DATA TABLE


SL No	Description	GUY ROPE
1	WIND AXIAL FORCE	5.0 kN
2	SEISMIC AXIAL FORCE	1.0 kN

NOTES

1. ALL DIMENSIONS ARE IN MILLIMETRE.
2. ALL LEVELS ARE IN METRE.
3. FGL LEVEL ±0.0 CORRESPONDS TO RL 912.350.
4. THE LOADS INDICATED IN LOAD DATA TABLE ARE ACTUAL. FOUNDATION DESIGNER SHOULD CONSIDER NECESSARY MARGIN.
5. SIZE OF FOUNDATION AND PEDESTAL SHALL BE DECIDED BY CIVIL DESIGN ENGINEER AS PER GIVEN LOADING.
6. ADDITIONAL REBAR REQUIREMENT AROUND ANCHOR BOLTS TO ENSURE NO FAILURE OF CONCRETE SHALL BE DECIDED BY CIVIL DESIGN ENGINEER AS PER GIVEN LOADING.

LEGEND :

BCD – BOLT CIRCLE DIAMETER
C.G. – CENTRE OF GRAVITY
CL – CENTRE LINE
CONC – CONCRETE
EL – ELEVATION
EQP – EQUIPMENT
FGL – FINISHED GROUND LEVEL
Gr – GRADE
MIN – MINIMUM
MPa – MEGA PASCAL
mm – MILLIMETRE
No – NUMBER / NUMBERS
TH – THICK
TOC – TOP OF CONCRETE
TOG – TOP OF GROUT
TYP – TYPICAL
ø – DIAMETER
RL. – REDUCED LEVEL

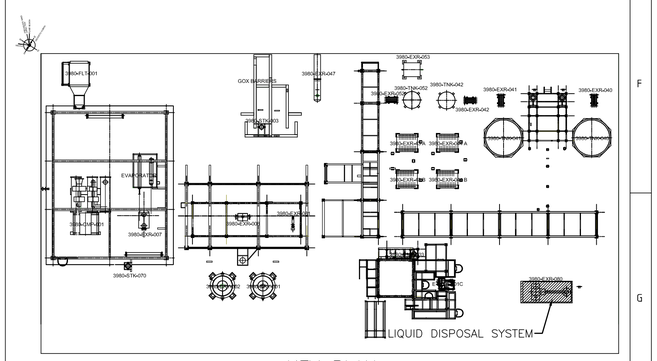

KEY PLAN

REV	DESCRIPTION	DRN	CHK	ENG	APP	EMP	DATE
D01	AS-BUILT	--	STY/SYC/SHH	--	BDA/PRI/JPD		08/09/2023
C01	ISSUED FOR CONSTRUCTION AND REVISED AS PER EMPLOYER'S COMMENT ON 27/10/2020	--	STY/SYC/SHH	--	BDA/PRI/JPD		07/01/2021
A01	ISSUED FOR INFORMATION	--	STY/SYC/SHH	--	BDA/PRI/JPD		03/10/2020

DOCUMENT NUMBER | REFERENCE DOCUMENTS

AIR LIQUIDE CONFIDENTIAL INFORMATION: THIS PRINT IS THE PROPERTY OF L'AIR LIQUIDE S.A. OR ITS DIRECT AND INDIRECT AFFILIATES OR SUBSIDIARIES AND CONTAINS VALUABLE CONFIDENTIAL INFORMATION. COPYRIGHT AND ALL OTHER RIGHTS IN THIS PRINT ARE EXPRESSLY RESERVED. NO PART OF THIS PRINT MAY BE DISCLOSED BY THE INTENDED RECIPIENT TO A THIRD PARTY; REPRODUCED, COPIED, LENT, OR DISPOSED OF, DIRECTLY OR INDIRECTLY, NOR USED FOR ANY PURPOSE OTHER THAN THAT FOR WHICH IT IS EXPRESSLY FURNISHED. THIS PRINT IS LENT SUBJECT TO RETURN ON DEMAND.

Air Liquide ENGINEERING & CONSTRUCTION

LARSEN & TOUBRO

This drawing is the property of LARSEN & TOUBRO and must not be passed on to any person or body not authorized by us to receive it nor be copied or otherwise made use either in full or in part by such person or body without our prior permission in writing.

Outotec

The content of these documents are the sole property of Outotec Oyj. Any rights not expressly granted herein are reserved. Reproduction, transfer or distribution of part or all of the contents in any form without prior written permission of Outotec is prohibited.

MA'ADEN معادن Saudi Arabian Mining Company شركة المعادن العربية السعودية

This document and the information contained herein is Ma'aden proprietary know-how. This document or any part thereof should not be reproduced, stored in a retrieval system or transmitted by any means, electronic or otherwise, or divulged without prior written permission of Ma'aden.

	DATE	DRAWN	CHECKED	APPROVED
DRAWING NUMBER 12126-60-01-CS-151150	04/01/2021	SGH	ABM	DS
REVISION 1	05/01/2021			
STATUS AFD	06/01/2021			

LARSEN & TOUBRO DRAWING NUMBER: 019045_080_C_V_24225_023 — REVISION 2
OUTOTEC DRAWING NUMBER: 900707__GAU01__AG22__MTL01__39832 — DOCUMENT ID: OU100680057 — REVISION 2

DRAWN	--	--
CHECKED	STY/ SYC/ SHH	06/01/2021
ENGINEER	--	--
APPROVED	BDA/ PRI/ JPD	07/01/2021
EMPLOYER		
SCALE	1:30	A1

MANSOURAH - MASSARAH GOLD PROJECT
GENERAL ARRANGEMENT DRAWING
OXYGEN PLANT
FOUNDATION LOAD - LIQUID DISPOSAL SYSTEM

DRAWING NUMBER: MD-216-3980-EG-CV-GAD-V551-1496 — REV: D01

Mansourah Massarah Gold Project
Comment Resolution Log Sheet / Compliance Report

PROJECT: MANSOURAH MASSARAH GOLD PROJECT **PROJECT NO.:** 216

STAGE: 4 - PROJECT EXECUTION. **REVIEW LOG DOC. NO. & REV.:**

ACONEX REF. NO. & DATE: MAADEN-STRAN-001443, 27 October 2020

STATUS CODE: A - APPROVED, C - APPROVED WITH COMMENTS, R - REVISE & RESUBMIT & O - OTHERS (INFORMATION, REFERENCE, REVIEWED)

DOCUMENT NUMBER	Area / Title	Comment No.	PMC/PMT COMMENT DATE: 27 October 2020	Comment by	EPC Response DATE: 07 January 2021	Status	Remarks
			General Comments (cc)				
MD-216-3980-EG-CV-GAD-V551-1496-A01	3980	1	Please establish specific which codes are you using for wind and seismic. Refer to the project design criteria	Mr. Doron Golan - Bechtel	Comment incorporated.	Closed	