


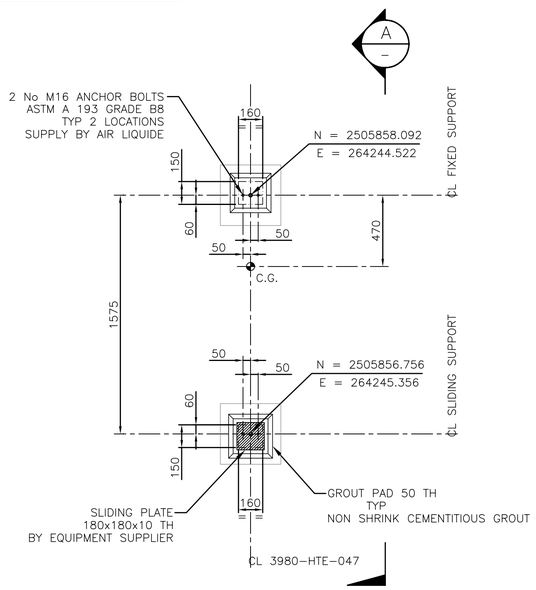

FOUNDATION PLAN GOX HEATER


SCALE 1:20

LOAD DATA TABLE

GOX HEATER (3980-HTE-047)				
SL No	Description			
1	EMPTY LOAD	5.0 kN		
2	OPERATING LOAD	5.0 kN		
3	TEST LOAD	5.5 kN		
4	BUNDLE LOAD	1.5 kN		
	FIXED SUPPORT SHALL BE DESIGNED FOR 2.25 kN HOZ LOAD ALONG PLANT NORTH DIRECTION (EQUIPMENT AXIS)			
		TRANSVERSE DIRECTION	LONGITUDINAL DIRECTION (ALONG NORTH)	REMARKS
5	WIND MOMENT	0.15 kN-m	0.04 kN-m	DESIGN CODE SBC-301-2007 WIND SPEED=49 m/sec
	WIND HORIZONTAL FORCE	0.3 kN	0.1 kN	
6	SEISMIC MOMENT	0.2 kN-m	0.4 kN-m	DESIGN CODE SBC-301-2007 SS=0.10g, S1=0.02g
	SEISMIC HORIZONTAL FORCE	0.5 kN	1.0 kN	

THESE ARE TOTAL LOAD AT CENTER OF BASE PLATE LEVEL.

EMPTY, OPERATING AND TEST LOADS ARE VERTICAL DOWNWARD LOAD.

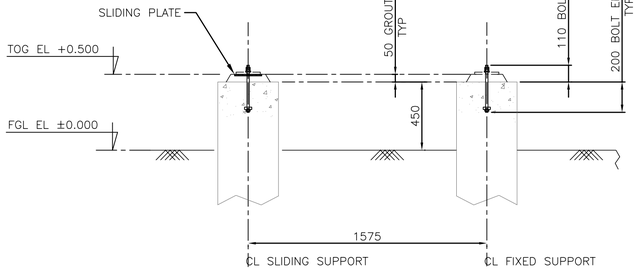

SECTION A–A


SCALE 1:20

NOTES

1. ALL DIMENSIONS ARE IN MILLIMETRE.
2. ALL LEVELS ARE IN METRE.
3. FGL LEVEL ±0.0 CORRESPONDS TO RL 912.350.
4. THE LOADS INDICATED IN LOAD DATA TABLE ARE ACTUAL. FOUNDATION DESIGNER SHOULD CONSIDER NECESSARY MARGIN.
5. SIZE OF FOUNDATION AND PEDESTAL SHALL BE DECIDED BY CIVIL DESIGN ENGINEER AS PER GIVEN LOADING.
6. ADDITIONAL REBAR REQUIREMENT AROUND ANCHOR BOLTS TO ENSURE NO FAILURE OF CONCRETE SHALL BE DECIDED BY CIVIL DESIGN ENGINEER AS PER GIVEN LOADING.

LEGEND :

BCD – BOLT CIRCLE DIAMETER
C.G. – CENTRE OF GRAVITY
CL – CENTRE LINE
CONC – CONCRETE
EL – ELEVATION
EQP – EQUIPMENT
FGL – FINISHED GROUND LEVEL
Gr – GRADE
MIN – MINIMUM
MPa – MEGA PASCAL
mm – MILLIMETRE
No – NUMBER / NUMBERS
TOC – TOP OF CONCRETE
TOG – TOP OF GROUT
TH – THICK
TYP – TYPICAL
RL. – REDUCED LEVEL

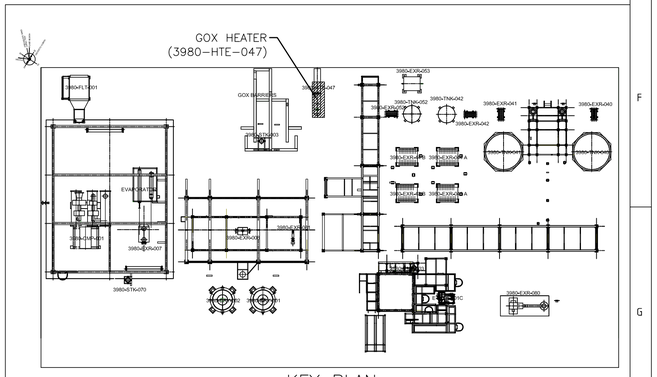

KEY PLAN

DOCUMENT NUMBER	REFERENCE DOCUMENTS	REV	DATE	REVISION DESCRIPTION	DRN	CHK	ENG	APP	EMP
		D01	08/09/2023	AS-BUILT	--	STY/SYC/SHH	--	BDA/PRI/JPD	
		C01	07/01/2021	ISSUED FOR CONSTRUCTION AND REVISED AS PER EMPLOYER'S COMMENT ON 27/10/2020	--	STY/SYC/SHH	--	BDA/PRI/JPD	
		A01	22/09/2020	ISSUED FOR INFORMATION	--	STY/SYC/SHH	--	BDA/PRI/JPD	

Air Liquide ENGINEERING & CONSTRUCTION

AIR LIQUIDE CONFIDENTIAL INFORMATION: THIS PRINT IS THE PROPERTY OF L'AIR LIQUIDE S.A. OR ITS DIRECT AND INDIRECT AFFILIATES OR SUBSIDIARIES AND CONTAINS VALUABLE CONFIDENTIAL INFORMATION. COPYRIGHT AND ALL OTHER RIGHTS IN THIS PRINT ARE EXPRESSLY RESERVED. NO PART OF THIS PRINT MAY BE DISCLOSED BY THE INTENDED RECIPIENT TO A THIRD PARTY, REPRODUCED, COPIED, LENT, OR DISPOSED OF, DIRECTLY OR INDIRECTLY, NOR USED FOR ANY PURPOSE OTHER THAN THAT FOR WHICH IT IS EXPRESSLY FURNISHED. THIS PRINT IS LENT SUBJECT TO RETURN ON DEMAND.

DRAWING NUMBER		REVISION	STATUS
12126-60-01-CS-151160		1	AFD
DATE	04/01/2021	DATE	05/01/2021	DATE	06/01/2021
DRAWN	SGH	CHECKED	ABM	APPROVED	DS

LARSEN & TOUBRO

This drawing is the property of *LARSEN & TOUBRO* and must not be passed on to any person or body not authorized by us to receive it nor be copied or otherwise made use either in full or in part by such person or body without our prior permission in writing.

Outotec

The content of these documents are the sole property of Outotec Oyj. Any rights not expressly granted herein are reserved. Reproduction, transfer or distribution of part or all of the contents in any form without prior written permission of Outotec is prohibited.

MA'ADEN معادن
Saudi Arabian Mining Company شركة التعدين العربية السعودية

This document and the information contained herein is Ma'aden proprietary know-how. This document or any part thereof should not be reproduced, stored in a retrieval system or transmitted by any means, electronic or otherwise, or divulged without prior written permission of Ma'aden.

LARSEN & TOUBRO DRAWING NUMBER		REVISION
019045_080_C_V_24225_024		2
OUTOTEC DRAWING NUMBER	DOCUMENT ID	REVISION
900707__GAU01__AG22__MTL01__39833	OU100680058	2

DRAWN	--	--
CHECKED	STY/ SYC/ SHH	06/01/2021
ENGINEER	--	--
APPROVED	BDA/ PRI/ JPD	07/01/2021
EMPLOYER		
SCALE	1:30	A1

MANSOURAH - MASSARAH GOLD PROJECT
GENERAL ARRANGEMENT DRAWING
OXYGEN PLANT
FOUNDATION LOAD & ANCHORAGE - GOX HEATER

DRAWING NUMBER: MD-216-3980-EG-CV-GAD-V551-1497 REV D01

Mansourah Massarah Gold Project
Comment Resolution Log Sheet / Compliance Report

PROJECT: MANSOURAH MASSARAH GOLD PROJECT **PROJECT NO.: 216**

STAGE: 4 - PROJECT EXECUTION. **REVIEW LOG DOC. NO. & REV.:**

ACONEX REF. NO. & DATE: MAADEN-STRAN-001443, 27 October 2020

STATUS CODE: A - APPROVED, C - APPROVED WITH COMMENTS, R - REVISE & RESUBMIT & O - OTHERS (INFORMATION, REFERENCE, REVIEWED)

DOCUMENT NUMBER	Area / Title	Comment No.	PMC/PMT COMMENT DATE: 27 October 2020	Comment by	EPC Response DATE: 07 January 2021	Status	Remarks
			General Comments (cc)				
MD-216-3980-EG-CV-GAD-V551-1497-A01	3980	1	Please be specific indicating the codes you are following for the wind and seismic loads. They should follow those indicated in this project design criteria. Refer to the project design criteria	Mr. Doron Golan - Bechtel	Comment incorporated.	Closed	