


DRAWING NUMBER MD-216-3980-EG-CV-GAD-V551-1500 REV D01

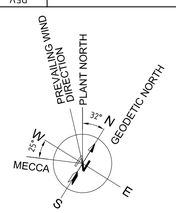

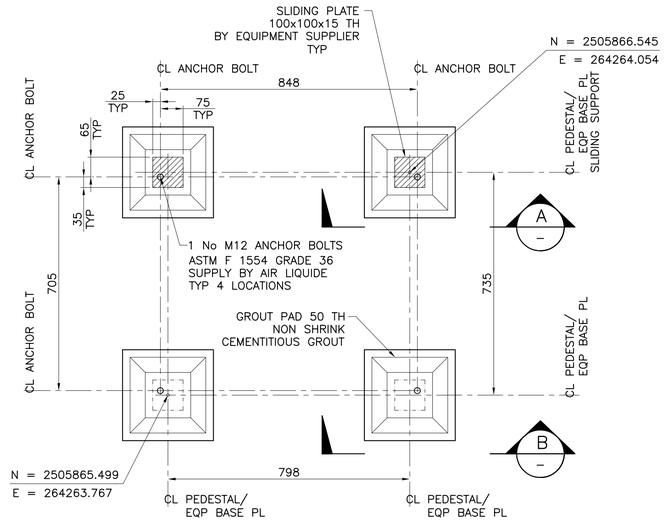


FOUNDATION PLAN LOX PBUC 3980-EXR-041

SCALE 1:10

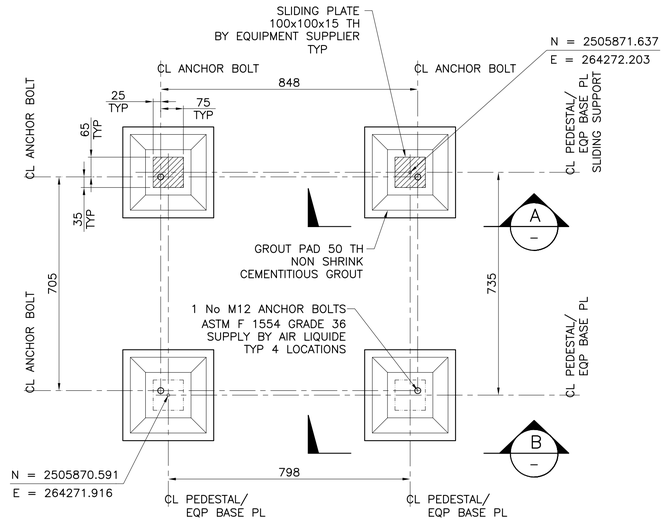


FOUNDATION PLAN LOX PBUC 3980-EXR-040

SCALE 1:10

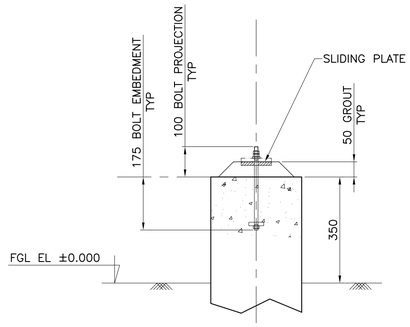

SECTION A

SCALE 1:10

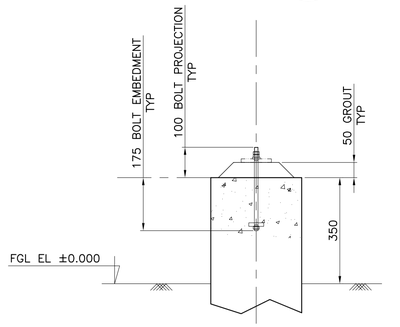

SECTION B

SCALE 1:10

LOAD DATA TABLE-1

LOX PBUC (3980-EXR-040 & 3980-EXR-041)		
SL No	Description	
1	EMPTY LOAD	0.45 kN
2	OPERATING LOAD	0.65 kN
3	WIND MOMENT	3.0 kN-m
	WIND HORIZONTAL FORCE	2.0 kN
4	SEISMIC MOMENT	0.15 kN-m
	SEISMIC HORIZONTAL FORCE	0.1 kN

THESE ARE TOTAL LOAD AT CENTER OF BASE PLATE LEVEL FOR EACH EQUIPMENT.


EMPTY, OPERATING AND TEST LOADS ARE VERTICAL DOWNWARD LOAD.

NOTES

1. ALL DIMENSIONS ARE IN MILLIMETER.
2. ALL LEVELS ARE IN METER.
3. FGL LEVEL ±0.0 CORRESPONDS TO RL 912.350.
4. THE LOADS INDICATED IN LOAD DATA TABLE ARE ACTUAL. FOUNDATION DESIGNER SHOULD CONSIDER NECESSARY MARGIN.
5. SIZE OF FOUNDATION AND PEDESTAL SHALL BE DECIDED BY CIVIL DESIGN ENGINEER AS PER GIVEN LOADING.
6. ADDITIONAL REBAR REQUIREMENT AROUND ANCHOR BOLTS TO ENSURE NO FAILURE OF CONCRETE SHALL BE DECIDED BY CIVIL DESIGN ENGINEER AS PER GIVEN LOADING.
7. WIND & SEISMIC LOADS ARE AS PER SBC 301.


LEGEND :

BCD – BOLT CIRCLE DIAMETER
C.G. – CENTER OF GRAVITY
CL – CENTER LINE
CONC – CONCRETE
EL – ELEVATION
EQP – EQUIPMENT
FGL – FINISHED GROUND LEVEL
Gr – GRADE
MIN – MINIMUM
MPa – MEGA PASCAL
mm – MILLIMETER
No – NUMBER / NUMBERS
TH – THICKNESS
TOC – TOP OF CONCRETE
TOG – TOP OF GROUT
TYP – TYPICAL

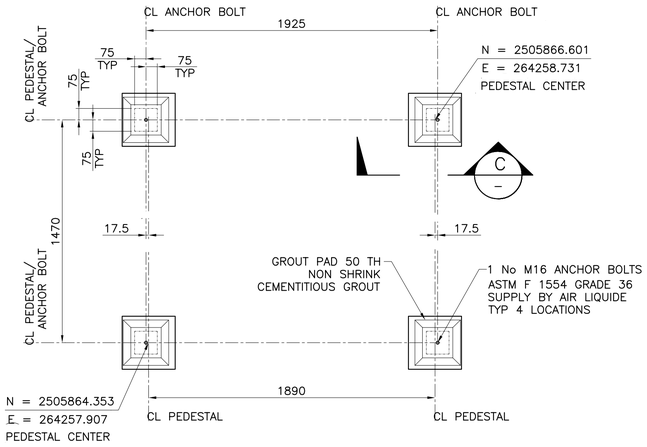

FOUNDATION PLAN HP LOX PBUC 3980-EXR-042

SCALE 1:10

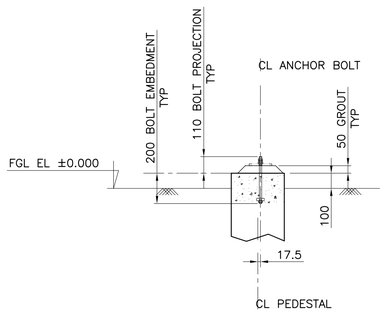

SECTION C


SCALE 1:20

LOAD DATA TABLE-2

HP LOX PBUC (3980-EXR-042)		
SL No	Description	
1	EMPTY LOAD	9.0 kN
2	OPERATING LOAD	14.0 kN
3	WIND MOMENT	8.0 kN-m
	WIND HORIZONTAL FORCE	7.0 kN
4	SEISMIC MOMENT	1.3 kN-m
	SEISMIC HORIZONTAL FORCE	1.0 kN

THESE ARE TOTAL LOAD AT CENTER OF BASE PLATE LEVEL FOR EACH EQUIPMENT.

EMPTY, OPERATING AND TEST LOADS ARE VERTICAL DOWNWARD LOAD.

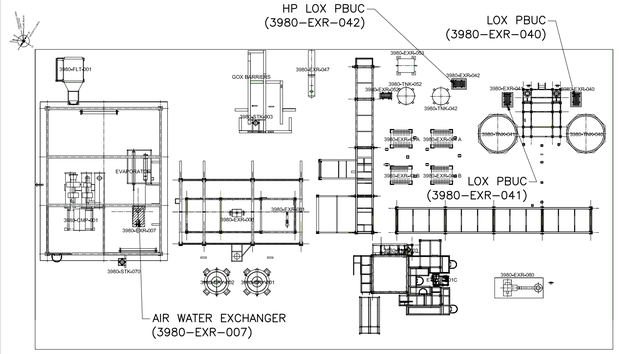

KEY PLAN

DOCUMENT NUMBER	REFERENCE DOCUMENTS	REV	DATE	REVISION DESCRIPTION	DRN	CHK	ENG	APP	EMP
		D01	22/02/2023	AS-BUILT	--	STY/SYC/SHH	--	BDA/PRI/JPD	
		C02	29/12/2020	ISSUED FOR CONSTRUCTION & REVISED AS MARKED	--	STY/SYC/SHH	--	BDA/PRI/JPD	
		C01	06/11/2020	ISSUED FOR CONSTRUCTION & REVISED AS PER EMPLOYER'S COMMENT ON 03/09/2020	--	STY/SYC/SHH	--	BDA/PRI/JPD	
		A01	11/08/2020	ISSUED FOR INFORMATION	--	STY/SYC/SHH	--	BDA/PRI/JPD	

Air Liquide ENGINEERING & CONSTRUCTION

AIR LIQUIDE CONFIDENTIAL INFORMATION: THIS PRINT IS THE PROPERTY OF L'AIR LIQUIDE S.A. OR ITS (DIRECT AND INDIRECT) AFFILIATES OR SUBSIDIARIES AND CONTAINS VALUABLE CONFIDENTIAL INFORMATION. COPYRIGHT AND ALL OTHER RIGHTS IN THIS PRINT ARE EXPRESSLY RESERVED. NO PART OF THIS PRINT MAY BE DISCLOSED BY THE INTENDED RECIPIENT TO A THIRD PARTY, REPRODUCED, COPIED, LENT, OR DISPOSED OF, DIRECTLY OR INDIRECTLY, NOR USED FOR ANY PURPOSE OTHER THAN THAT FOR WHICH IT IS EXPRESSLY FURNISHED. THIS PRINT IS LENT SUBJECT TO RETURN ON DEMAND.

DRAWING NUMBER				REVISION	STATUS
12126-60-01-CS-151134				1	AFD
DATE	05/08/2020	DATE	06/08/2020	DATE	07/08/2020
DRAWN	SGH	CHECKED	ABM	APPROVED	DS

LARSEN & TOUBRO DRAWING NUMBER: 019045_080_C_V_24225_030 — REVISION 3

OUTOTEC DRAWING NUMBER: 900707__GAU01__AG22__MTL01__39872 — DOCUMENT ID: OU100694150 — REVISION 3

LARSEN & TOUBRO

This drawing is the property of LARSEN & TOUBRO and must not be passed on to any person or body not authorized by us to receive it nor be copied or otherwise made use either in full or in part by such person or body without our prior permission in writing.

Outotec

The content of these documents are the sole property of Outotec Oyj. Any rights not expressly granted herein are reserved. Reproduction, transfer or distribution of part or all of the contents in any form without prior written permission of Outotec is prohibited.

MA'ADEN معادن Saudi Arabian Mining Company شركة التعدين العربية السعودية

This document and the information contained herein is Ma'aden proprietary know-how. This document or any part thereof should not be reproduced, stored in a retrieval system or transmitted by any means, electronic or otherwise, or divulged without prior written permission of Ma'aden.

DRAWN	--	--	
CHECKED	STY/ SYC/ SHH	10/08/2020	
ENGINEER	--	--	
APPROVED	BDA/ PRI/ JPD	11/08/2020	
EMPLOYER			
SCALE	1:30	A1	

MANSOURAH - MASSARAH GOLD PROJECT
GENERAL ARRANGEMENT DRAWING
OXYGEN PLANT
FOUNDATION LOAD & ANCHORAGE - LOX PBUC

DRAWING NUMBER: MD-216-3980-EG-CV-GAD-V551-1500 — REV: D01