

DRAWING NUMBER: MD-216-3980-EG-CV-GAD-V551-1501 | REV: D01

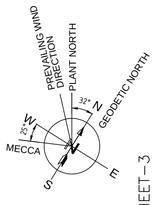

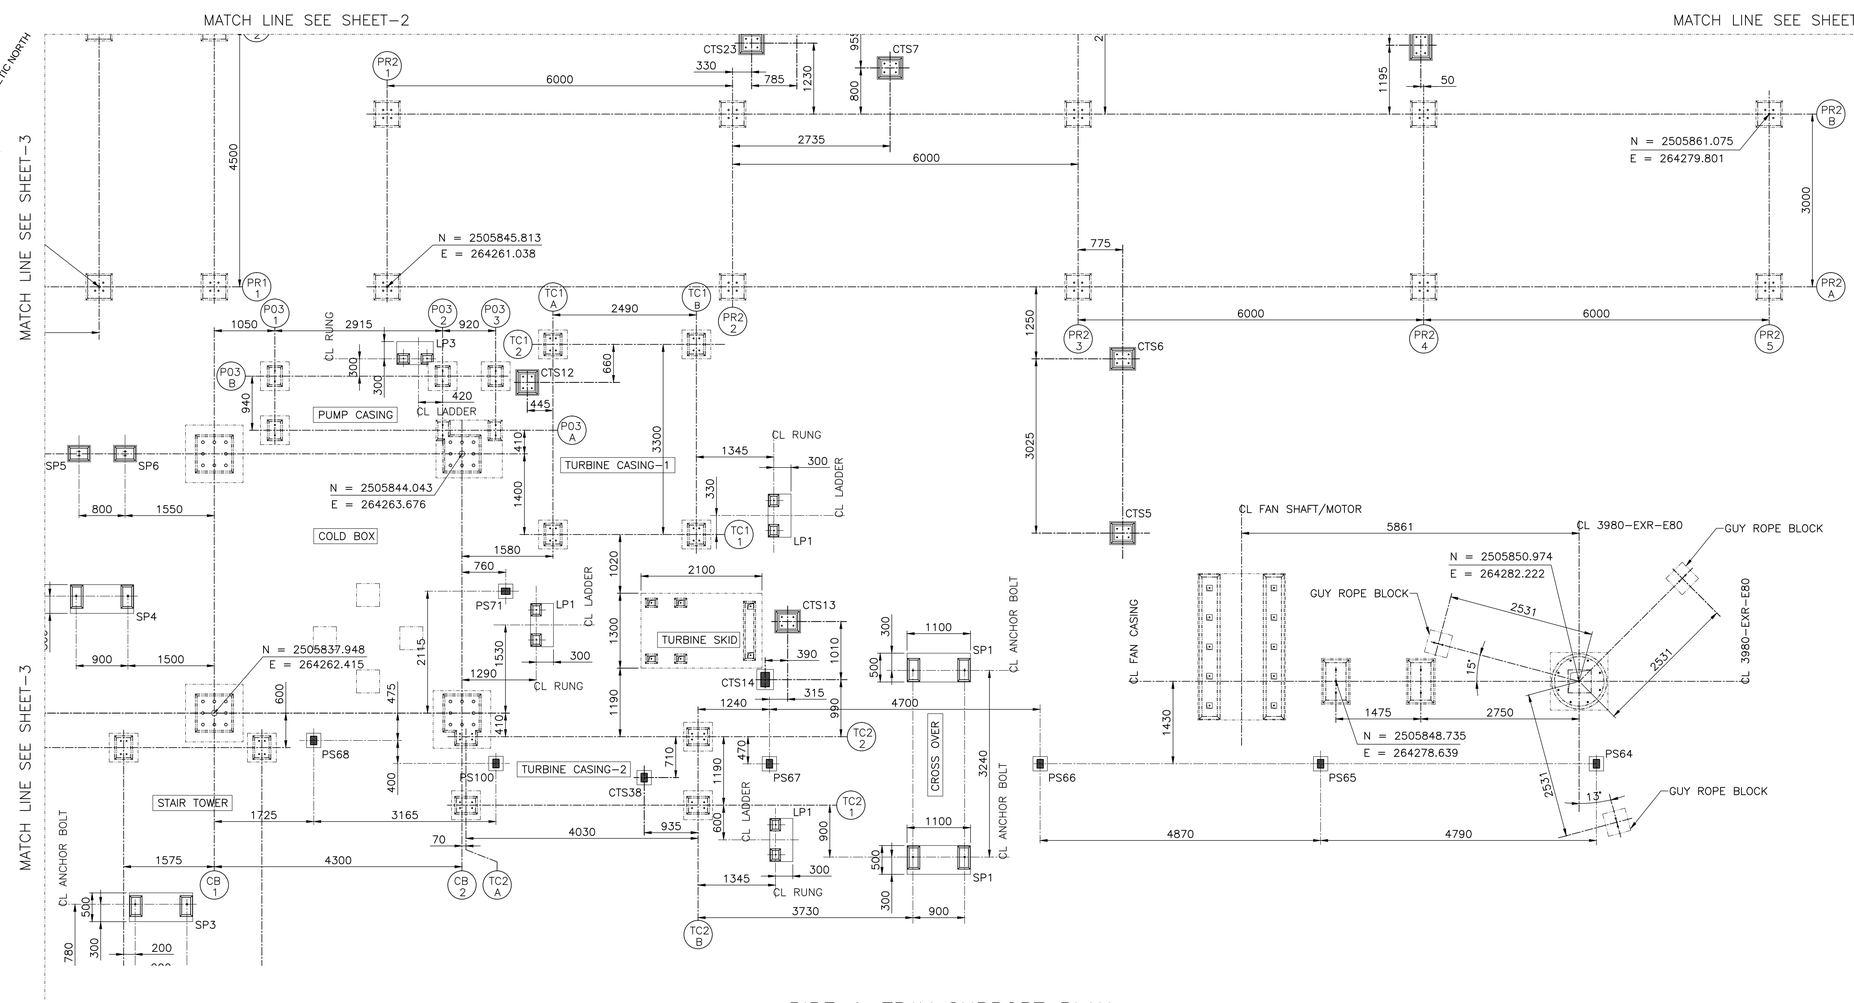

PIPE & TRAY SUPPORT PLAN

SCALE 1:50

NOTES

1. ALL DIMENSIONS ARE IN MILLIMETER.
2. ALL LEVELS ARE IN METER.
3. FGL LEVEL ±0.0 CORRESPONDS TO RL 912.350.
4. FOR ALL OTHER NOTES SEE SHT-1.
5. FOR PIPE SUPPORT FOUNDATION LOAD DATA SEE SHT-3 & FOR CABLE TRAY SUPPORT FOUNDATION LOAD DATA SEE SHT-6.

DOCUMENT NUMBER	REFERENCE DOCUMENTS	REV	DATE	REVISION DESCRIPTION	DRN	CHK	ENG	APP	EMP
MD-216-3980-EG-ST-GAD-V551-2397	PIPE & TRAY SUPPORTS (SHEET-5)								
MD-216-3980-EG-ST-GAD-V551-2396	PIPE & TRAY SUPPORTS (SHEET-4)								
MD-216-3980-EG-ST-GAD-V551-2395	PIPE & TRAY SUPPORTS (SHEET-3)	D01	08/09/2023	AS-BUILT	--	STY/SYC/SHH	--	BDA/PRI/JPD	
MD-216-3980-EG-ST-GAD-V551-2394	PIPE & TRAY SUPPORTS (SHEET-2)	C01	20/03/2021	ISSUED FOR CONSTRUCTION & REVISED AS PER					
MD-216-3980-EG-ST-GAD-V551-2393	PIPE & TRAY SUPPORTS (SHEET-1)			EMPLOYER'S COMMENT ON 04/02/2021	--	STY/SYC/SHH	--	BDA/PRI/JPD	
MD-216-3980-EG-PI-PPD-V551-1001	PLOT PLAN	A01	21/12/2020	ISSUED FOR INFORMATION	--	STY/SYC/SHH	--	BDA/PRI/JPD	

Air Liquide ENGINEERING & CONSTRUCTION

AIR LIQUIDE CONFIDENTIAL INFORMATION: THIS PRINT IS THE PROPERTY OF L'AIR LIQUIDE S.A. OR ITS DIRECT AND INDIRECT AFFILIATES OR SUBSIDIARIES AND CONTAINS VALUABLE CONFIDENTIAL INFORMATION. COPYRIGHT AND ALL OTHER RIGHTS IN THIS PRINT ARE EXPRESSLY RESERVED. NO PART OF THIS PRINT MAY BE DISCLOSED BY THE INTENDED RECIPIENT TO A THIRD PARTY, REPRODUCED, COPIED, LENT, OR DISPOSED OF, DIRECTLY OR INDIRECTLY, NOR USED FOR ANY PURPOSE OTHER THAN THAT FOR WHICH IT IS EXPRESSLY FURNISHED. THIS PRINT IS LENT SUBJECT TO RETURN ON DEMAND.

DRAWING NUMBER				REVISION	STATUS
12126-60-01-CS-141253				1	AFD
DATE	14/12/2020	DATE	15/12/2020	DATE	10/03/2021
DRAWN	SGH	CHECKED	ABM	APPROVED	DS

LARSEN & TOUBRO DRAWING NUMBER			REVISION
019045_080_C_V_24225_031			2
OUTOTEC DRAWING NUMBER		DOCUMENT ID	REVISION
900707 _GAU01 _AG22_ MTL01 _39892		OU100711118	2

LARSEN & TOUBRO

This drawing is the property of LARSEN & TOUBRO and must not be passed on to any person or body not authorized by us to receive it nor be copied or otherwise made use either in full or in part by such person or body without our prior permission in writing.

Outotec

The content of these documents are the sole property of Outotec Oyj. Any rights not expressly granted herein are reserved. Reproduction, transfer or distribution of part or all of the contents in any form without prior written permission of Outotec is prohibited.

MA'ADEN معادن
Saudi Arabian Mining Company شركة التعدين العربية السعودية

This document and the information contained herein is Ma'aden proprietary know-how. This document or any part thereof should not be reproduced, stored in a retrieval system or transmitted by any means, electronic or otherwise, or divulged without prior written permission of Ma'aden.

DRAWN	--	--	MANSOURAH - MASSARAH GOLD PROJECT
CHECKED	STY/ SYC/ SHH	11/03/2021	GENERAL ARRANGEMENT DRAWING
ENGINEER	--	--	OXYGEN PLANT
APPROVED	BDA/ PRI/ JPD	12/03/2021	FOUNDATION LOAD-PIPE & TRAY SUPPORT SHT-4
EMPLOYER			
SCALE	1:30	A1	DRAWING NUMBER: MD-216-3980-EG-CV-GAD-V551-1501 REV: D01

Mansourah Massarah Gold Project
Comment Resolution Log Sheet / Compliance Report

PROJECT: MANSOURAH MASSARAH GOLD PROJECT **PROJECT NO.:** 216

STAGE: 4 - PROJECT EXECUTION. **REVIEW LOG DOC. NO. & REV.:**

ACONEX REF. NO. & DATE: MAADEN-STRAN-002805, 04 February 2021

STATUS CODE: A - APPROVED, C - APPROVED WITH COMMENTS, R - REVISE & RESUBMIT & O - OTHERS (INFORMATION, REFERENCE, REVIEWED)

DOCUMENT NUMBER	Area / Title	Comment No.	PMC/PMT COMMENT DATE: 04 February 2021	Comment by	EPC Response DATE: 20 March 2021	Status	Remarks
			General Comments (cc)				
MD-216-3980-EG-CV-GAD-V551-1501-A01	3980	1	Please include reference drawings	Mr. Doron Golan - Bechtel	Incorporated.	Closed	