DRAWING NUMBER MD-216-4400-EG-CV-GAD-1001 REV D01

EXTENTS OF DETAILED SURVEY PROVIDED

ROAD (INDICATIVE)

MINE ACCESS ROAD

PLANT NORTH

PREVAILING WIND DIRECTION

GEODETIC NORTH

MECCA

FINAL EMBANKMENT TO BE CONSTRUCTED BY NOVEMBER 2025

DISCHARGE RAMP

2400m

DISCHARGE PLATFORM

3%

2.1%

1.65%

0.5%

TAILINGS EXTENTS AT JULY 2032 (132 MONTHS)

INDICATIVE DECANT POND EXTENTS

TRANSITION FROM SPILLWAY TO DECANT OUTLET CHANNEL

SPILLWAY

DECANT

H

98.2m

CELL 1

CELL 2

EVAPORATION POND

EMERGENCY SPILLWAY


MANSOURAH MINE PIT

INDICATIVE WASTE DUMP AREA (BY OTHERS)

FACILITY BOUNDARY DEMARCATION FENCE

MAX. 8.1m EMBANKMENT HEIGHT REQUIRED FOR 45 Mt OF TAILINGS

THIS DRAWING ONLY PRESENTS THE PREDICTED BEACH SLOPE AT THE END OF THE LOM. FURTHER ANALYSIS HAS TO BE DONE BASED ON THE ACHIEVED BEACH SLOPES AND DENSITIES DURING THE OPERATION AND THIS DRAWING SHALL NOT BE USED FOR CONSTRUCTION.

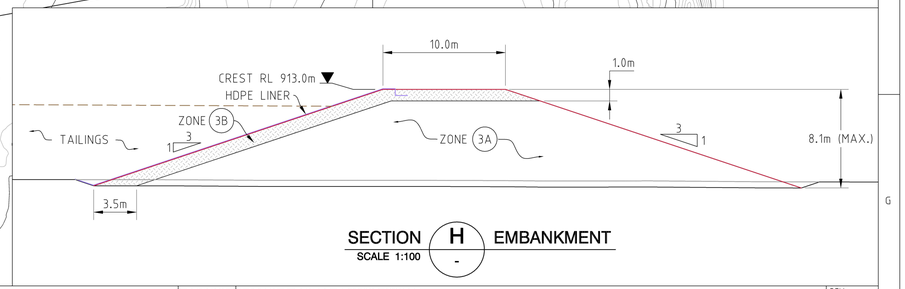

SECTION H - EMBANKMENT
SCALE 1:100

DOCUMENT NUMBER	REFERENCE DOCUMENTS	REV	DATE	REVISION DESCRIPTION	DRN	CHK	ENG	APP	EMP
		D01	05/10/2023	AS BUILT	PML	RBD	AVG	SJM	
		C01	26/10/2020	ISSUED FOR CONSTRUCTION	PML	RBD	AVG	SJM	
		A03	31/07/2020	ISSUED FOR DETAIL DESIGN	PML	RBD	AVG	SJM	
		A02	15/06/2020	REVISED AS PER EMPLOYER'S COMMENTS OF 21/04/20 AND MARKED AS A02	PML	RBD	AVG	SJM	
		A01	29/03/2020	ISSUED FOR APPROVAL	PML	RBD	AVG	SJM	

ATC WILLIAMS
A.B.N. 64 005 931 288
www.atcwilliams.com.au
Melb T +61 3 8587 0900
melbourne@atcwilliams.com.au

LARSEN & TOUBRO

This drawing is the property of LARSEN & TOUBRO and must not be passed on to any person or body not authorized by us to receive it nor be copied or otherwise made use either in full or in part by such person or body without our prior permission in writing.

Outotec

The content of these documents are the sole property of Outotec Oyj. Any rights not expressly granted herein are reserved. Reproduction, transfer or distribution of part or all of the contents in any form without prior written permission of Outotec is prohibited.

MA'ADEN معادن
Saudi Arabian Mining Company شركة معادن العربية السعودية

This document and the information contained herein is Ma'aden proprietary know-how. This document or any part thereof should not be reproduced, stored in a retrieval system or transmitted by any means, electronic or otherwise, or divulged without prior written permission of Ma'aden.

DRAWING NUMBER	REVISION
117168.03-206	0

DATE	DRAWN	CHECKED	ENGINEER	APPROVED	EMPLOYER
09/04/2020	HR	AR	BA/FCS	KDS	-

LARSEN & TOUBRO DRAWING NUMBER: 019045_450_M_V_01351_001 REV 4

OUTOTEC DRAWING NUMBER: 900707_GAU01_ST03_MTL01_44001 DOCUMENT ID: OU100672641 REV 4

DRAWN	--	--
CHECKED	SNM	29/03/2020
ENGINEER	--	--
APPROVED	SJM	29/03/2020
EMPLOYER		
SCALE	1:7,500	A1

MANSOURAH - MASSARAH GOLD PROJECT
GENERAL ARRANGEMENT
TAILINGS STORAGE FACILITY
GENERAL PLAN VIEW FOR LIFE OF MINE (45Mt)

DRAWING NUMBER MD-216-4400-EG-CV-GAD-1001 REV D01