


DRAWING NUMBER: MD-216-3120-EG-CV-GAD-1010
REV: D01

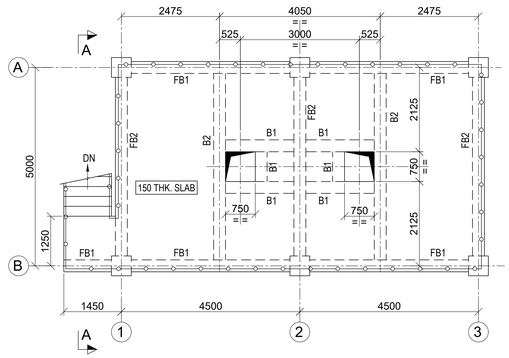


PLAN AT RL. 914.750 (T.O.C)
(SCALE-1:75)

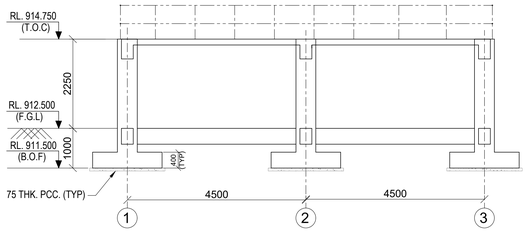

ELEVATION ALONG GRID A
(SCALE-1:75)

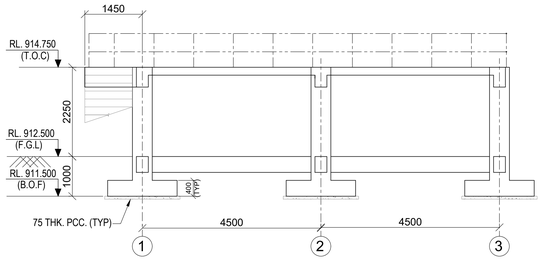

ELEVATION ALONG GRID B
(SCALE-1:75)

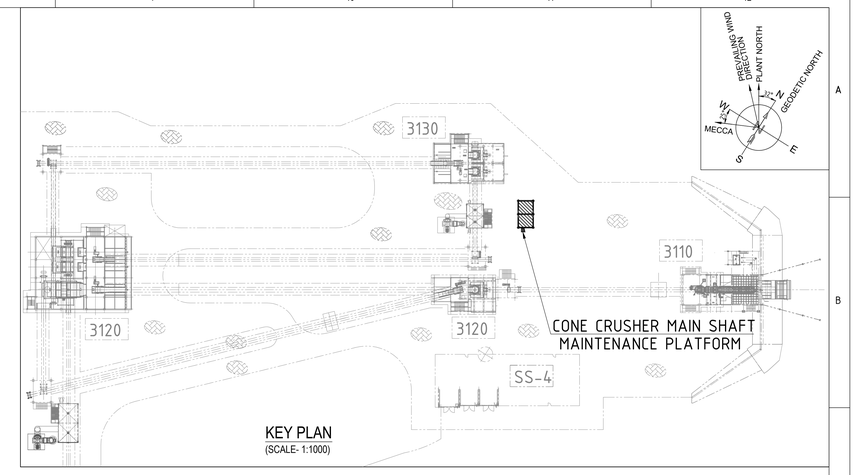


KEY PLAN
(SCALE- 1:1000)

SCHEDULE OF BEAM


BEAM MKD.	SIZE		LEVEL
	WIDTH (mm.)	DEPTH (mm.)	
TB1	300	500	RL.912.500 (T.O.B.)
TB2	300	500	
FB1	300	500	RL. 914.750 (T.O.C.)
FB2	300	500	
B1	300	400	
B2	300	500	


SCHEDULE OF FOUNDATION

FDN. MKD.	COLUMN MKD.	FOUNDATION DETAILS			BOTTOM OF FDN.	TOP OF COLUMN	NOS. FDN.
		L	B	D			
F1	C1	1750	1750	400	RL. 911.500	RL. 914.750	6
F2	-	1200	1000	400	RL. 911.900	-	1

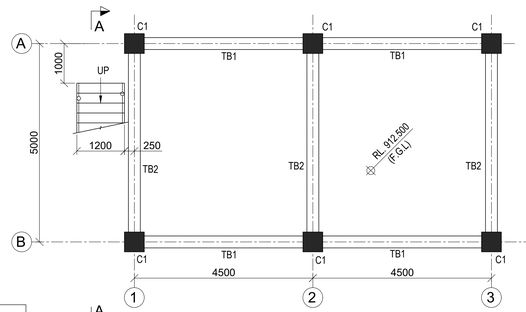


PLAN OF TIE BEAM AT RL. 912.500 (F.G.L)
(SCALE-1:75)

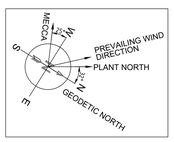


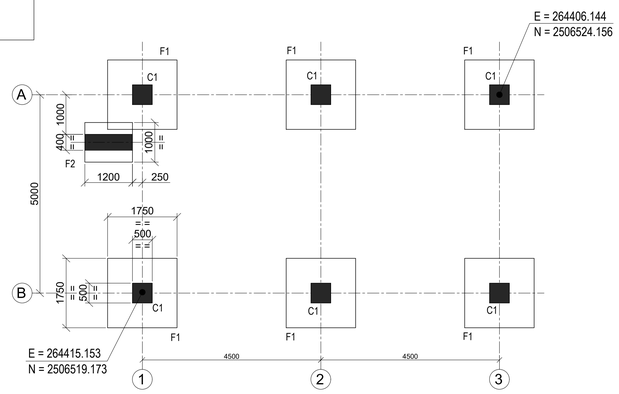


LAYOUT OF FOUNDATION AT RL. 911.500 (B.O.F)
(SCALE-1:75)

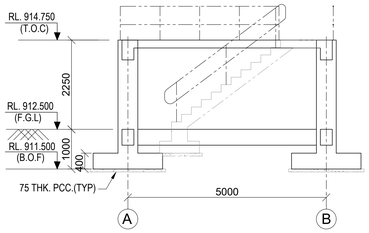


ELEVATION ALONG GRID 1
(SCALE-1:75)

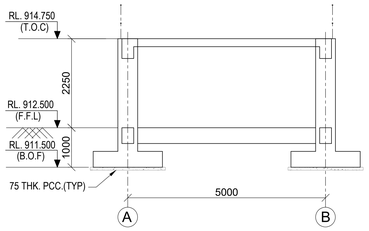

ELEVATION ALONG GRID 2
(SCALE-1:75)

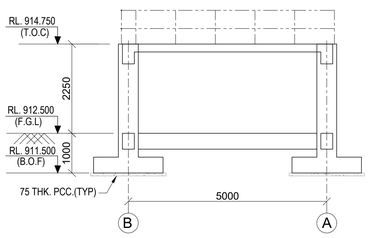

ELEVATION ALONG GRID 3
(SCALE-1:75)

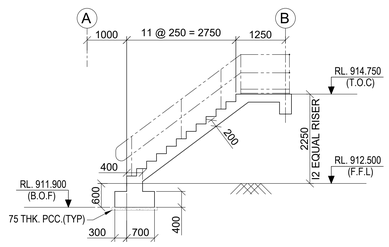

SECTION A-A
(SCALE-1:75)

LEGEND :-

RL. - REDUCED LEVEL
℄ - CENTRE LINE
T.O.C. - TOP OF CONCRETE.
F.G.L. - FINISHED GROUND LEVEL.
F.F.L. - FINISHED FLOOR LEVEL.
B.O.F. - BOTTOM OF FOUNDATION
TYP. - TYPICAL.
R.C.C - REINFORCED CEMENT CONCRETE
P.C.C - PLAIN CEMENT CONCRETE
MKD. - MARKED
MM - MILLIMETRE
DN - DOWN

NOTES :-

1. ALL DIMENSIONS ARE IN MILLIMETRES AND LEVELS AND CO-ORDINATES ARE IN METRES. UNLESS OTHERWISE STATED.
2. GRADE OF CONCRETE SHALL BE C35 FOR FOUNDATION.
3. GRADE OF REINFORCEMENT SHALL BE DEFORMED BAR ASTM A615 - GRADE 60 (fy = 420 MPa).
4. NET SAFE BEARING CAPACITY OF SOIL AT BOTTOM OF FOUNDATION CONSIDERED 600KN/SQ. M.
5. CLEAR COVER TO MAIN REINFORCEMENT SHALL BE AS FOLLOWS
   a) FOUNDATION = 75 mm (BOTTOM & SIDE) 50 mm. (TOP)
   b) COLUMN = 50mm
   c) BEAM = 50mm
   d) SLAB = 40mm
6. FOR MINIMUM LAP LENGTH OF REINFORCEMENT REFER STANDARD DRAWING NO. MD-216-1000-EG-CV-DED-1005
7. FOR DETAIL OF HANDRAIL FIXING REFER STANDARD DRAWING.
8. READ THIS DRAWING IN CONJUNCTION WITH DRAWING NUMBER : MD-216-3120-EG-CV-DED-1008

DOCUMENT NUMBER	REFERENCE DOCUMENTS	REV	DATE	REVISION DESCRIPTION	DRN	CHK	ENG	APP	EMP
		D01	10/03/2023	AS-BUILT	JKM	SBY	RPK	PRI	
		C01	09/04/2021	REVISED AS PER EMPLOYER COMMENTS DATED 05/04/2021 & ISSUED FOR CONSTRUCTION & REVISED AS MARKED	JKM	SBY	RPK	PRI	
		A01	10/03/2021	ISSUED FOR REVIEW	JKM	SBY	RPK	PRI	

RESERVED FOR VENDOR LOGO AND DRAWING NUMBER

LARSEN & TOUBRO
This drawing is the property of LARSEN & TOUBRO and must not be passed on to any person or body not authorized by us to receive it nor be copied or otherwise made use either in full or in part by such person or body without our prior permission in writing.

Outotec
The content of these documents are the sole property of Outotec Oyj. Any rights not expressly granted herein are reserved. Reproduction, transfer or distribution of part or all of the contents in any form without prior written permission of Outotec is prohibited.

MA'ADEN معادن
Saudi Arabian Mining Company شركة التعدين العربية السعودية
This document and the information contained herein is Ma'aden proprietary know-how. This document or any part thereof should not be reproduced, stored in a retrieval system or transmitted by any means, electronic or otherwise, or divulged without prior written permission of Ma'aden.

LARSEN & TOUBRO DRAWING NUMBER: 019045_100_C_G_24600_001 — REVISION: 2
OUTOTEC DRAWING NUMBER: 900707__GAU01__ZC01__MTL01__31290 — DOCUMENT ID: 0U100712929 — REVISION: 2

DRAWN	JKM	06/03/2021
CHECKED	SBY	09/03/2021
ENGINEER	RPK	05/03/2021
APPROVED	PRI	10/03/2021
EMPLOYER		
SCALE	1:100,20,15	A1

MANSOURAH - MASSARAH GOLD PROJECT
GENERAL ARRANGEMENT DRAWING
CONE CRUSHER MAIN SHAFT MAINTENANCE PLATFORM
PLAN, ELEVATIONS & DETAILS

DRAWING NUMBER: MD-216-3120-EG-CV-GAD-1010 — REV: D01