

DRAWING NUMBER
MD - 216 - 3120 - EG - CV - GAD - 1011
REV
D01



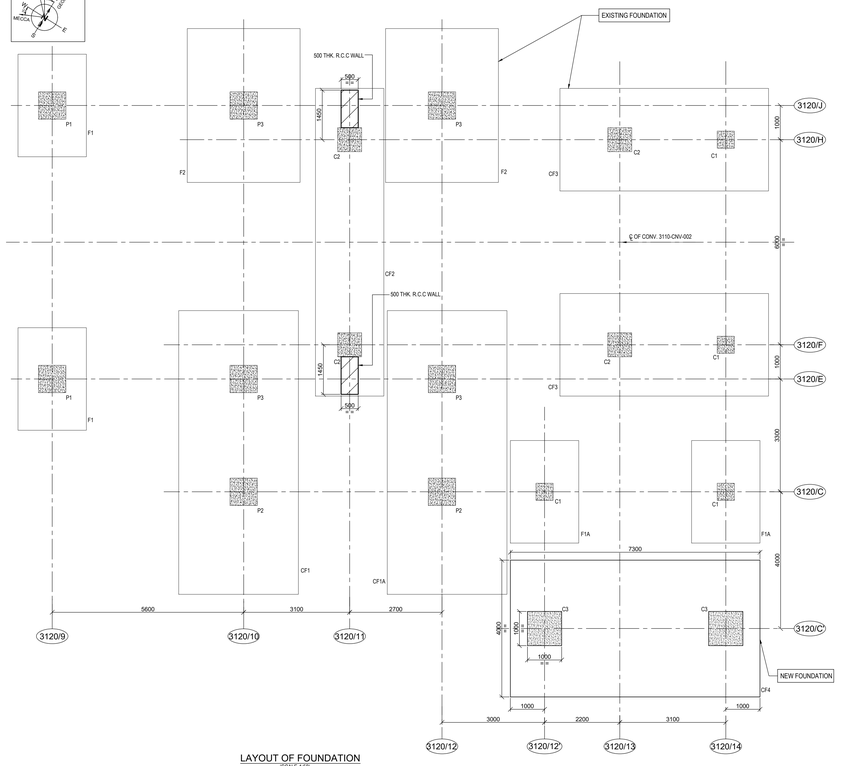


LAYOUT OF FOUNDATION
(SCALE-1:50)

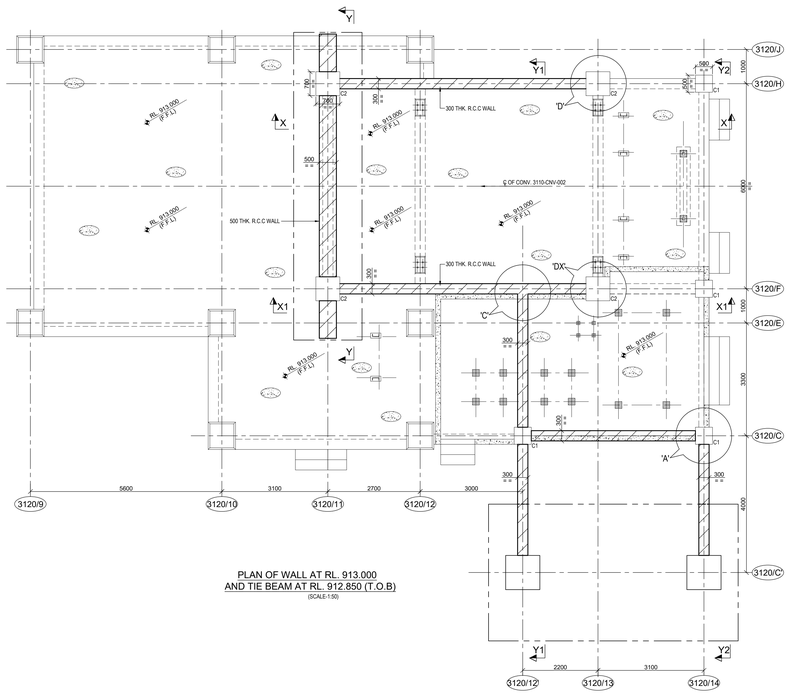


PLAN OF WALL AT RL. 913.000
AND TIE BEAM AT RL. 912.850 (T.O.B)
(SCALE-1:50)


** DIMENSIONS SHALL BE AS PER ACTUAL SITE MEASUREMENT

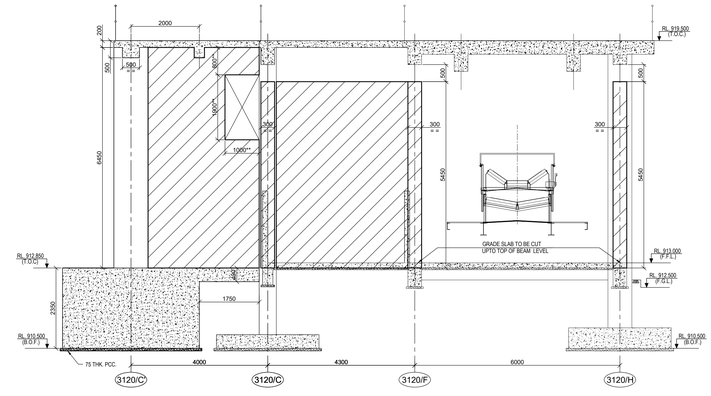


SECTION Y1-Y1
(SCALE-1:50)

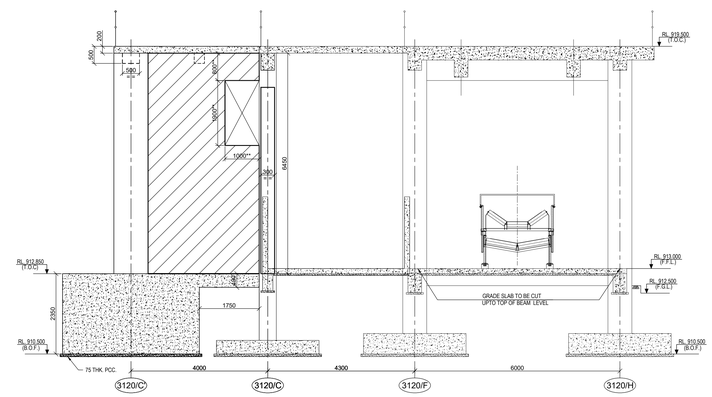

SECTION Y2-Y2
(SCALE-1:50)

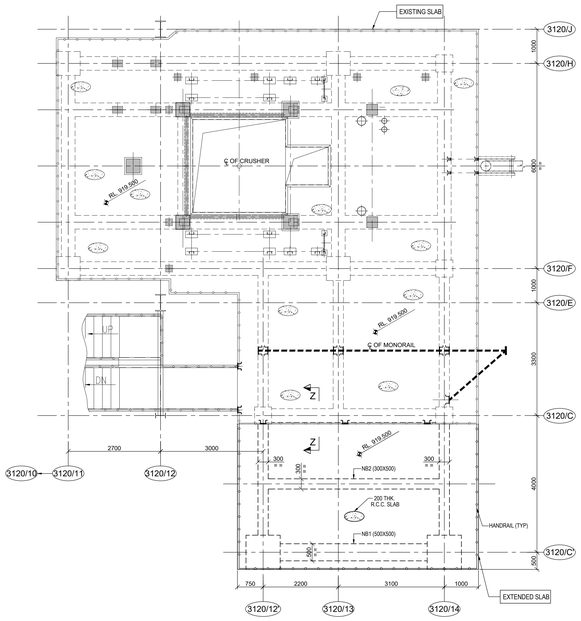


PLAN AT RL 919.500M LEVEL
(SCALE-1:50)

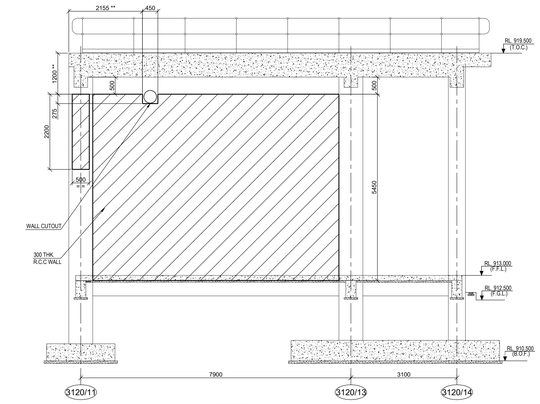


SECTION X-X
(SCALE-1:50)


SECTION X1-X1
(SCALE-1:50)

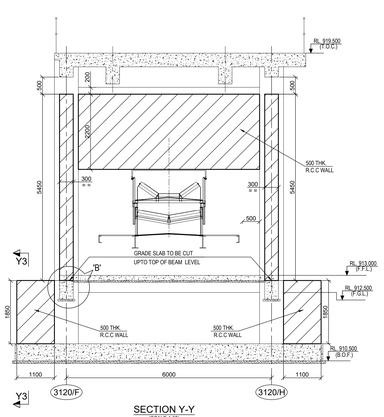

SECTION Y-Y
(SCALE-1:50)

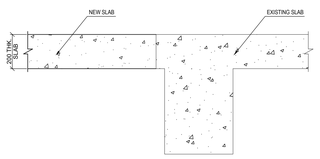

SECTION Z-Z
(SCALE-1:10)

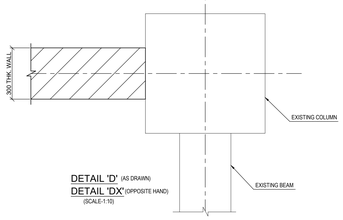

DETAIL 'D' (AS DRAWN)
DETAIL 'DX' (OPPOSITE HAND)
(SCALE-1:10)

LEGENDS :-
RL - REDUCED LEVEL
T.O.C - TOP OF CONCRETE
F.G.L - FINISHED GROUND LEVEL
F.F.L - FINISHED FLOOR LEVEL
B.O.F - BOTTOM OF FOUNDATION
TYP - TYPICAL
P.C.C - PLAIN CEMENT CONCRETE
NEW WALL CONSTRUCTION

NOTES :-
1. ALL DIMENSIONS ARE IN MILLIMETRES AND LEVELS ARE IN METRES.
2. GRADE OF CONCRETE SHALL BE C35.
3. NET SAFE BEARING CAPACITY OF SOIL AT BOTTOM OF FOUNDATION CONSIDERED 500KN/SQ. M.
4. FOR DETAIL OF HANDRAIL FIXING REFER STANDARD DRAWING.
5. QUICK SETTING ADMIXTURE SHALL BE USED FOR REDUCING THE SETTING TIME OF THE CONCRETE.
6. DO NOT SCALE. PLEASE ASK.

DOCUMENT NUMBER	REFERENCE DOCUMENTS	REV	DATE	REVISION DESCRIPTION	DRN	CHK	ENG	APP	EMP
		D01	04/03/2024	AS-BUILT	HSK	SBY	APR	AG	
MD-216-3120-EG-CV-DED-1009	SECONDARY CRUSHING R.C DETAILS OF	C01	10/10/2023	ISSUED FOR CONSTRUCTION	JKM	SBY	APR	AG	
	ADDITIONAL FOUNDATION & WALL	A03	14/10/2022	REVISED AS PER EMPLOYER COMMENTS DATED 06/06/2022	SYA	SBY	APR	AG	
MD-216-3120-EG-CV-GAD-1007	SECONDARY CRUSHING DETAILS & SECTIONS	A02	28/04/2022	REVISED AS PER EMPLOYER COMMENTS DATED 20/04/2022	SYA	SBY	APR	AG	
MD-216-3120-EG-CV-GAD-1004	SECONDARY CRUSHING LAYOUT & DETAIL	A01	12/04/2022	ISSUED OF APPROVAL	SYA	SBY	APR	AG	

RESERVED FOR VENDOR LOGO AND DRAWING NUMBER

LARSEN & TOUBRO

This drawing is the property of LARSEN & TOUBRO and must not be passed on to any person or body not authorized by us to receive it nor be copied or otherwise made use either in full or in part by such person or body without our prior permission in writing.

Outotec

The content of these documents are the sole property of Outotec Oyj. Any rights not expressly granted herein are reserved. Reproduction, transfer or distribution of part or all of the contents in any form without prior written permission of Outotec is prohibited.

MA'ADEN معادن
Saudi Arabian Mining Company شركة معادن السعودية

This document and the information contained herein is Ma'aden proprietary know-how. This document or any part thereof should not be reproduced, stored in a retrieval system or transmitted by any means, electronic or otherwise, or divulged without prior written permission of Ma'aden.

LARSEN & TOUBRO DRAWING NUMBER: O19045_100_C_G_24675_001 — REVISION: 4
OUTOTEC DRAWING NUMBER: 900707 _ GAU01 _ ZC01 _ MTL01 _ 31393 — DOCUMENT ID: OU100750794 — REVISION: 4

DRAWN	SYA	08/04/2022
CHECKED	SBY	11/04/2022
ENGINEER	APR	08/04/2022
APPROVED	AG	12/04/2022
EMPLOYER		

MANSOURAH - MASSARAH GOLD PROJECT
GENERAL ARRANGEMENT DRAWING
SECONDARY CRUSHING
MODIFICATION OF CRUSHER SUPPORT STRUCTURE

SCALE: 1:50,1:25,1:10 — A0
DRAWING NUMBER: MD - 216 - 3120 - EG - CV - GAD - 1011 — REV: D01