


DRAWING NUMBER: MD-216-3120-EG-CV-GAD-2021 | REV: D01

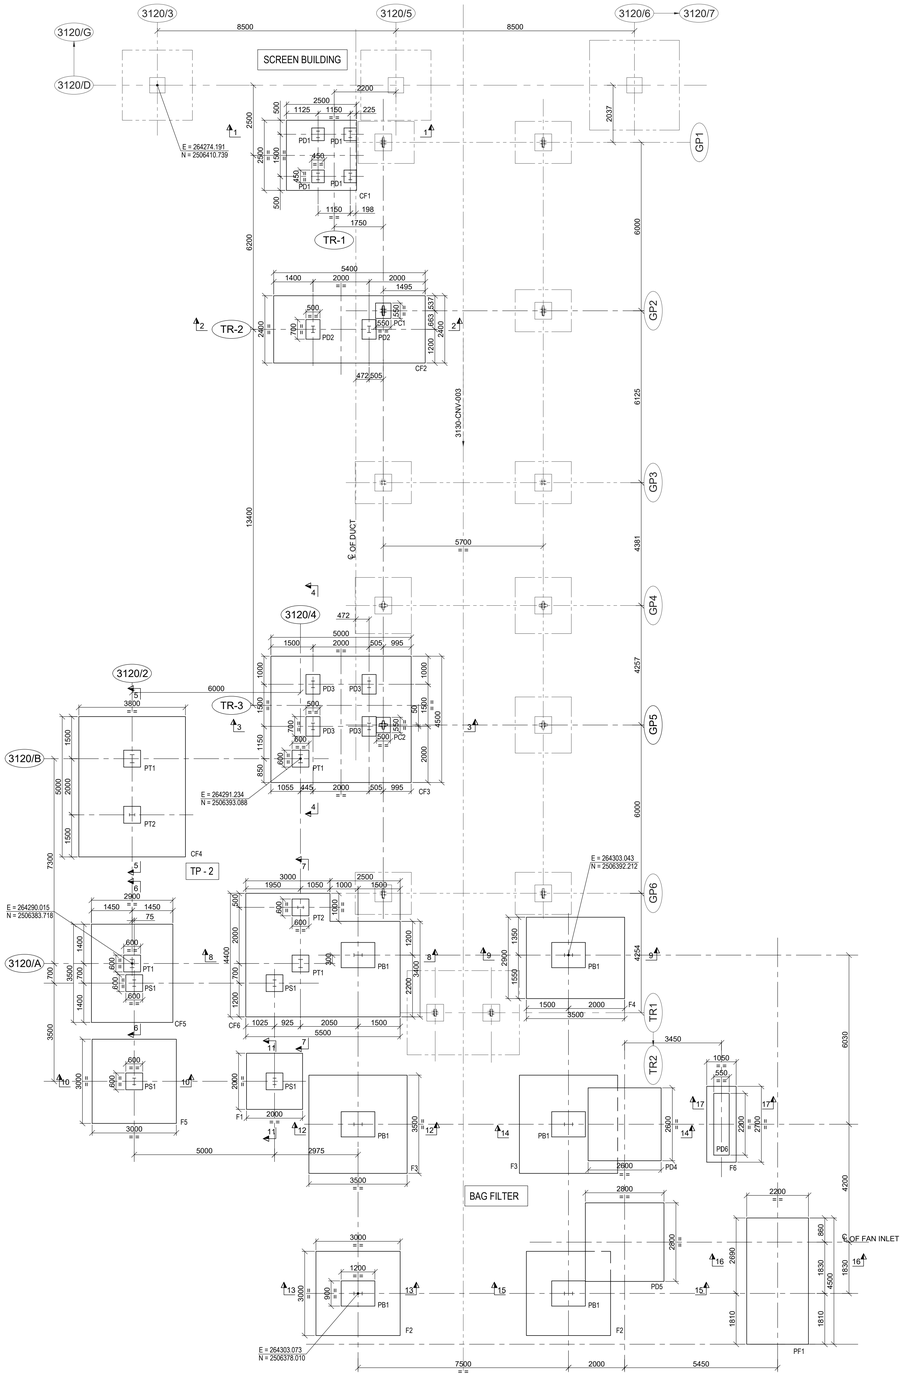

LAYOUT OF FOUNDATION
(SCALE-1:75)

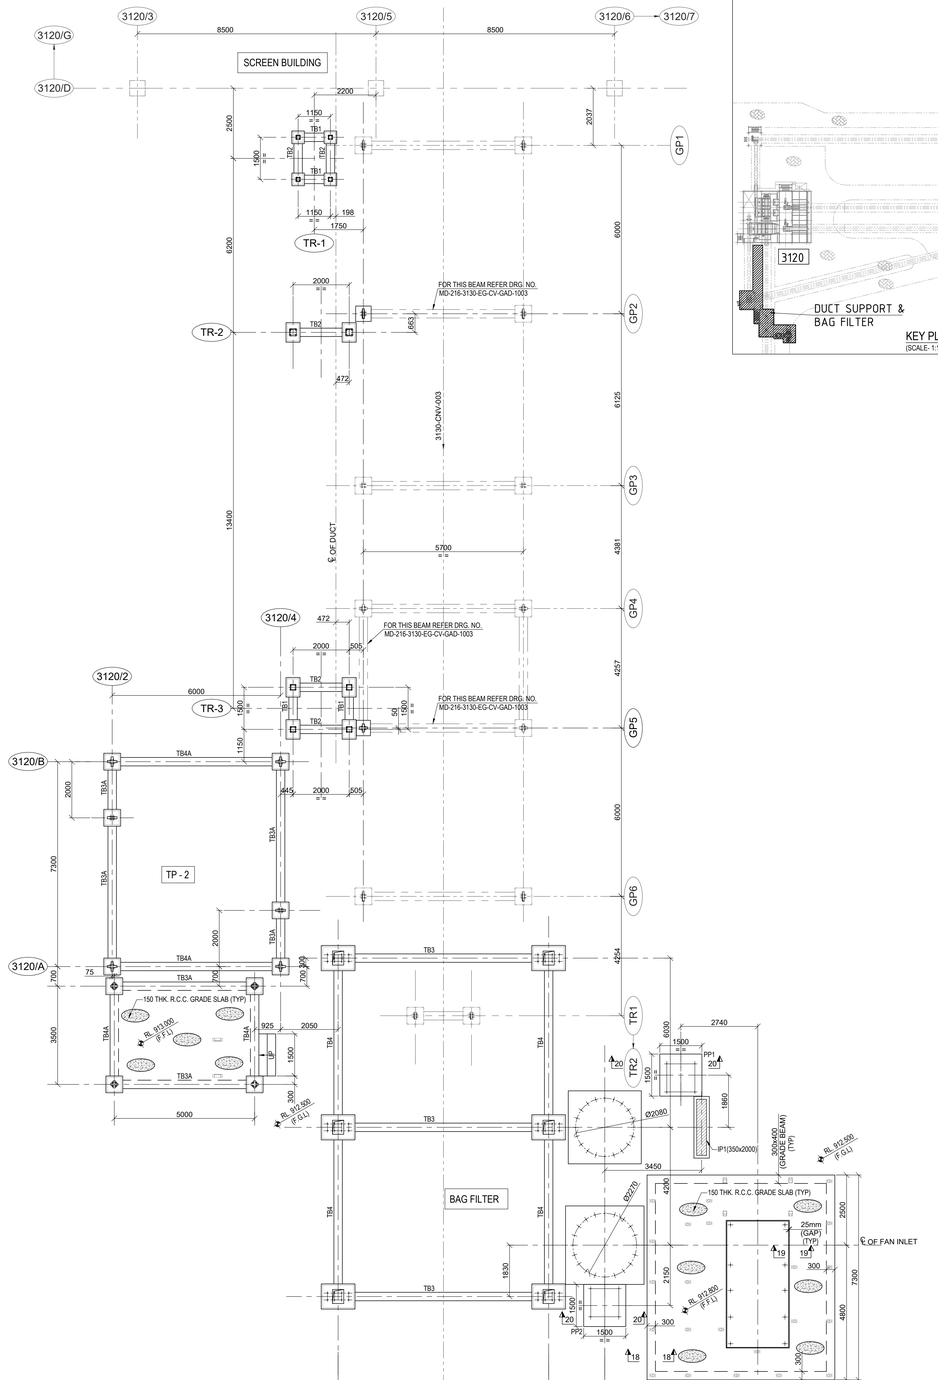

PLAN AT TIE BEAM LEVEL
(SCALE-1:75)

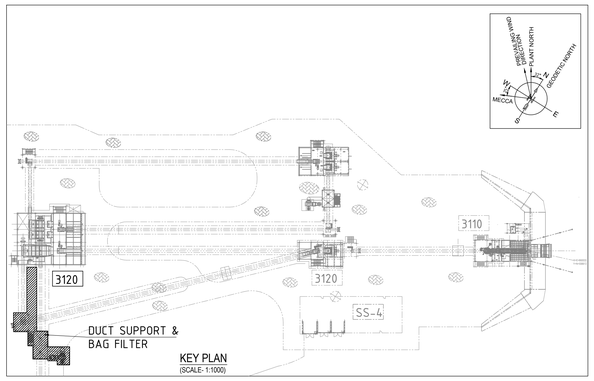

KEY PLAN
(SCALE- 1:1000)

SCHEDULE OF BEAM

BEAM MKD.	SIZE		LEVEL
	WIDTH (mm.)	DEPTH (mm.)	
TB1	300	300	RL. 912.300 (T.O.B.)
TB2	300	400	RL. 912.300 (T.O.B.)
TB3	300	600	RL. 912.300 (T.O.B.)
TB3A	300	600	RL. 912.850 (T.O.B.)
TB4	300	500	RL. 912.300 (T.O.B.)
TB4A	300	500	RL. 912.850 (T.O.B.)

LEGENDS :-

R.L - REDUCED LEVEL
℄ - CENTRE LINE
CJ - CONSTRUCTION JOINT
FDN - FOUNDATION.
T.O.C. - TOP OF CONCRETE.
F.G.L - FINISHED GROUND LEVEL.
F.F.L - FINISHED FLOOR LEVEL.
B.O.F - BOTTOM OF FOUNDATION
TYP. - TYPICAL.
R.C.C - REINFORCED CEMENT CONCRETE
P.C.C - PLAIN CEMENT CONCRETE
MKD - MARKED.
THK. - THICK
PC - PEDESTAL FOR CONVEYOR
PD - PEDESTAL FOR DUCT SUPPORT
PB - PEDESTAL FOR BAG FILTER
PS - PEDESTAL FOR STAIR
PT - PEDESTAL FOR TRANSFER POINT
PF - PEDESTAL FOR FAN
PP - PEDESTAL FOR PLATFORM

NOTES :-

1. ALL DIMENSIONS ARE IN MILLIMETRES AND LEVELS AND CO-ORDINATES ARE IN METRES, UNLESS OTHERWISE STATED.
2. GRADE OF CONCRETE SHALL BE C35 FOR FOUNDATION.
3. GRADE OF REINFORCEMENT SHALL BE DEFORMED BAR ASTM A615 - GRADE 60 (fy = 420 MPa).
4. NET SAFE BEARING CAPACITY OF SOIL AT BOTTOM OF FOUNDATION CONSIDERED 500KN/ SQ. M.
5. CLEAR COVER TO MAIN REINFORCEMENT SHALL BE AS
   a) FOUNDATION = 75 mm (BOTTOM & SIDE) 50 mm. (TOP)
   b) COLUMN & PEDESTAL = 50mm
   c) BEAM = 50mm
   d) SLAB = 40mm
6. FOR MINIMUM LAP LENGTH OF REINFORCEMENT AND OTHER GENERAL NOTES FOR CIVIL WORKS REFER STANDARD DRG : MD-216-1000-EG-CV-DED-1001
7. THIS DRG. SHALL BE READ IN CONJUNCTION WITH DRG. NO. MD-216-3120-EG-CV-GAD-2022
8. ALL STRUCTURAL WORK SHALL CONFORM TO CIVIL STRUCTURAL DESIGN CRITERIA NO. MD - 216 - 1000 -EG -ST - ORT - 1001
9. FOR OTHER STANDARD REINFORCEMENT DETAILS REFER DRG : MD-216-1000-EG-CV-DED-1005

DOCUMENT NUMBER	REFERENCE DOCUMENTS	REV	DATE	REVISION DESCRIPTION	DRN	CHK	ENG	APP	EMP
MD-216-3100-EG-ST-GAD-2024	SCREEN BUILDING BAG FILTER								
	PLAN, ELEVATION AND DETAIL OF STAIR								
MD-216-3130-EG-CV-GAD-1003	GA OF CONVEYORS 3130-CNV-003								
	LAYOUT & DETAIL								
MD-216-3120-EG-ST-GAD-1020	STRUCTURAL GA OF TP-2(3120 CNV-0011-1								
	PLAN, ELEVATIONS & DETAILS								
MD-216-3120-EG-ST-GAD-2022	SCREEN BUILDING-PLAN, ELEVATION AND	D01	10/03/2023	AS-BUILT	JKM	SBY	APL	PRI	
	DETAIL OF DEDUSTING DUCT SUPPORT	C02	10/12/2020	ISSUED FOR CONSTRUCTION & REVISED AS MKD. (C02)	JKM	SBY	APL	PRI	
MD-216-3120-EG-ST-GAD-2026	SCREEN BUILDING- DETAIL OF DEDUSTING DUCT SUPPORT	C01	14/10/2020	ISSUED FOR CONSTRUCTION & REVISED AS MKD. (C01)	JKM	SBY	APL	PRI	
MD-216-3100-EG-ME-LAD-V509-2001	FDN LOAD DATA FOR SEC. & TER. CRUSHER HOUSE BAG FILTER	A01	02/09/2020	ISSUED FOR REFERENCE	JKM	SBY	APL	PRI	

RESERVED FOR VENDOR LOGO AND DRAWING NUMBER

LARSEN & TOUBRO

This drawing is the property of LARSEN & TOUBRO and must not be passed on to any person or body not authorized by us to receive it nor be copied or otherwise made use either in full or in part by such person or body without our prior permission in writing.

Outotec

The content of these documents are the sole property of Outotec Oyj. Any rights not expressly granted herein are reserved. Reproduction, transfer or distribution of part or all of the contents in any form without prior written permission of Outotec is prohibited.

MA'ADEN معادن
Saudi Arabian Mining Company شركة المعادن العربية السعودية

This document and the information contained herein is Ma'aden proprietary know-how. This document or any part thereof should not be reproduced, stored in a retrieval system or transmitted by any means, electronic or otherwise, or divulged without prior written permission of Ma'aden.

LARSEN & TOUBRO DRAWING NUMBER		REVISION
01904 5_080_C_G_24368_002		3
OUTOTEC DRAWING NUMBER	DOCUMENT ID	REVISION
900707__GAU01__ZC01__MTL01__31287	OU100692121	3

DRAWN	JKM	31/08/2020
CHECKED	SBY	01/09/2020
ENGINEER	APL	29/08/2020
APPROVED	PRI	02/09/2020
EMPLOYER		
SCALE 1:50		A0

MANSOURAH - MASSARAH GOLD PROJECT
GENERAL ARRANGEMENT DRAWING
SCREEN BUILDING
LAYOUT OF BAG FILTER & DUCT SUPPORT FOUNDATION SHT 1

DRAWING NUMBER: MD - 216 - 3120 - EG - CV - GAD - 2021 | REV: D01