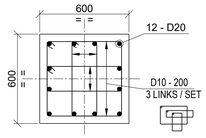
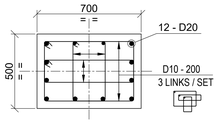
DRAWING NUMBER MD-216-3130-EG-CV-DED-1001 REV D01



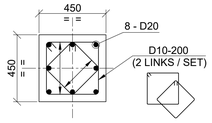

## RC DETAIL OF PEDESTAL MKD. P1, P2, P2A, P3, P5 & P6

(P1 - 2 NOS. REQUIRED)
(P2 - 4 NOS. REQUIRED)
(P2A - 2 NOS. REQUIRED)
(P3 - 4 NOS. REQUIRED)
(P5 - 4 NOS. REQUIRED)
(P6 - 2 NOS. REQUIRED)
(SCALE- 1:20)



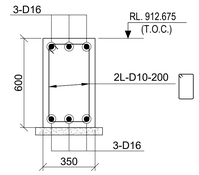

## RC DETAIL OF PEDESTAL MKD. P4

(4 NOS. REQUIRED)
(SCALE- 1:20)



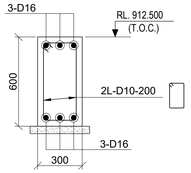

## RC DETAIL OF PEDESTAL MKD. P7

(2 NOS. REQUIRED)



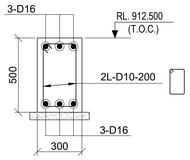

## RC DETAIL OF TIE BEAM MKD. TB1

(SLAB REIN. NOT SHOWN FOR CLARITY)
(SCALE- 1:20)



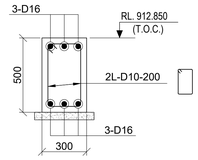

## RC DETAIL OF TIE BEAM MKD. TB1A

(SLAB REIN. NOT SHOWN FOR CLARITY)
(SCALE- 1:20)



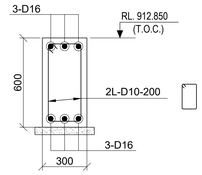

## RC DETAIL OF TIE BEAM MKD. TB2 & TB3

(SLAB REIN. NOT SHOWN FOR CLARITY)
(SCALE- 1:20)



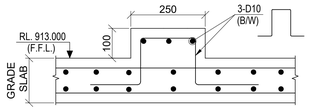

## RC DETAIL OF TIE BEAM MKD. TB4

(SLAB REIN. NOT SHOWN FOR CLARITY)
(SCALE- 1:20)



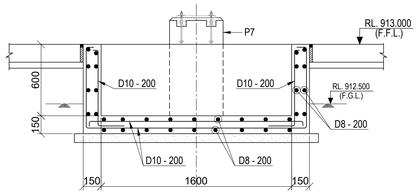

## RC DETAIL OF TIE BEAM MKD. TB5

(SLAB REIN. NOT SHOWN FOR CLARITY)
(SCALE- 1:20)



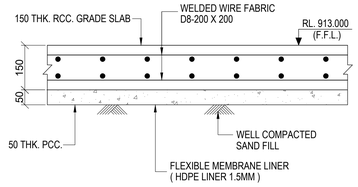

## SECTION Y-Y

(REFER DRAWING NUMBER MD-216-3130-EG-CV-GAD- 1001)
SCALE 1:10



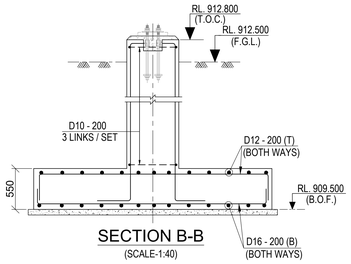

## RC DETAIL OF SAND PIT FOR VGTU

(SCALE-1:25)



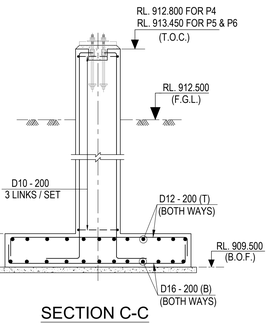

## TYP. DET. OF 150 THK. GRADE SLAB

(SCALE - 1:10)



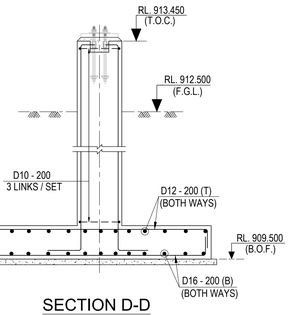

## SECTION B-B

(SCALE-1:40)



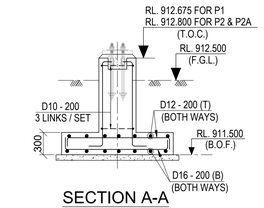

## SECTION C-C

(SCALE-1:40)



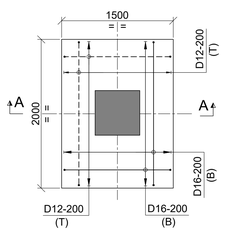

## SECTION D-D

(SCALE-1:40)



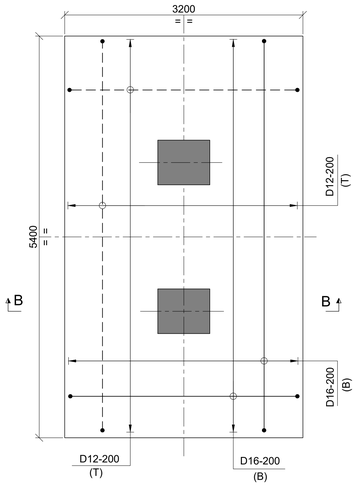

## SECTION A-A

(SCALE-1:40)



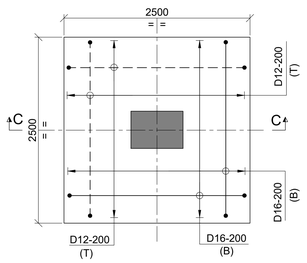

## R.C. DETAIL OF FOUNDATION MKD. F1 & F1A

(F1 - 6 NOS. REQUIRED)
(F1A - 2 NOS. REQUIRED)
(SCALE- 1:40)



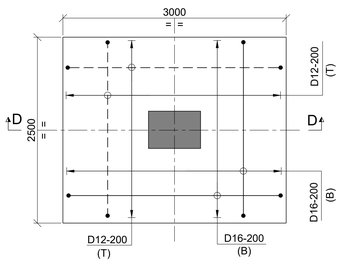

## R.C. DETAIL OF FOUNDATION MKD. F2

(3 NOS. REQUIRED)
(SCALE- 1:40)




## R.C. DETAIL OF FOUNDATION MKD. F3

(6 NOS. REQUIRED)
(SCALE- 1:40)




## R.C. DETAIL OF FOUNDATION MKD. F4

(2 NOS. REQUIRED)
(SCALE- 1:40)

## LEGEND :-

R.L. - REDUCED LEVEL
℄ - CENTRE LINE
CJ - CONSTRUCTION JOINT
FDN. - FOUNDATION.
T.O.C. - TOP OF CONCRETE.
F.G.L. - FINISHED GROUND LEVEL.
F.F.L. - FINISHED FLOOR LEVEL.
B.O.F. - BOTTOM OF FOUNDATION
TYP. - TYPICAL.
R.C. - REINFORCED CONCRETE
P.C.C - PLAIN CEMENT CONCRETE
MKD. - MARKED.
THK. - THICK
D - DIAMETER OF BAR
B/W - BOTH WAYS
Ld - DEVELOPMENT LENGTH
BOTTOM REINFORCEMENT (B) - ———
TOP REINFORCEMENT (T) - - - - - - -
ALTH - ALLTHROUGH
B/F - BOTHFACE
REIN. - REINFORCEMENT

## NOTES :-

1. ALL DIMENSIONS ARE IN MILLIMETRES AND LEVELS AND CO-ORDINATES ARE IN METRES. UNLESS OTHERWISE STATED.
2. GRADE OF CONCRETE SHALL BE C35 FOR FOUNDATION.
3. GRADE OF REINFORCEMENT SHALL BE DEFORMED BAR ASTM A615 - GRADE 60 (fy = 420 MPa).
4. NET SAFE BEARING CAPACITY OF SOIL AT BOTTOM OF FOUNDATION CONSIDERED 500KN/ SQ. M.
5. CLEAR COVER TO MAIN REINFORCEMENT SHALL BE AS
   a) FOUNDATION = 75 mm (BOTTOM & SIDE) 50 mm. (TOP)
   b) COLUMN & PEDESTAL = 50mm
   c) BEAM = 50mm
   d) SLAB = 40mm
6. FOR MINIMUM LAP LENGTH OF REINFORCEMENT AND OTHER GENERAL NOTES FOR CIVIL WORKS REFER STANDARD DRG : MD-216-1000-EG-CV-DED-1001
7. READ THIS DRAWING IN CONJUNCTION WITH DRG: MD-216-3130-EG-CV-GAD-1001
8. FOR OTHER STANDARD REINFORCEMENT DETAILS REFER DRG : MD-216-1000-EG-CV-DED-1005

| DOCUMENT NUMBER | REFERENCE DOCUMENTS | REV | DATE | REVISION DESCRIPTION | DRN | CHK | ENG | APP | EMP |
|---|---|---|---|---|---|---|---|---|---|
| | | D01 | 10/03/2023 | AS-BUILT | AMJ | SBY | APL | PRI | |
| | | C01 | 25/04/2020 | ISSUED FOR CONSTRUCTION, REVISED AS PER EMPLOYER COMMENTS DATED 17/04/2020 & REVISED AS MKD. | AMJ | SBY | APL | PRI | |
| MD-216-3130-EG-CV-GAD-1001 | GA OF CONVEYOR 3130-CNV-001 LAYOUT & DETAIL | A01 | 24/03/2020 | ISSUED FOR REFERENCE | AMJ | SBY | APL | PRI | |

RESERVED FOR VENDOR LOGO AND DRAWING NUMBER

LARSEN & TOUBRO

This drawing is the property of LARSEN & TOUBRO and must not be passed on to any person or body not authorized by us to receive it nor be copied or otherwise made use either in full or in part by such person or body without our prior permission in writing.

Outotec

The content of these documents are the sole property of Outotec Oyj. Any rights not expressly granted herein are reserved. Reproduction, transfer or distribution of part or all of the contents in any form without prior written permission of Outotec is prohibited.

MA'ADEN معادن
Saudi Arabian Mining Company شركة التعدين العربية السعودية

This document and the information contained herein is Ma'aden proprietary know-how. This document or any part thereof should not be reproduced, stored in a retrieval system or transmitted by any means, electronic or otherwise, or divulged without prior written permission of Ma'aden.

LARSEN & TOUBRO DRAWING NUMBER: O19045_100_C_D_24057_004 — REVISION: 2
OUTOTEC DRAWING NUMBER: 900707 __GAU01 __ZC01 __CTB17 __31301 — DOCUMENT ID: OU100670378 — REVISION: 2

| | | | |
|---|---|---|---|
| DRAWN | AMJ | 18/03/2020 | MANSOURAH - MASSARAH GOLD PROJECT |
| CHECKED | SBY | 21/03/2020 | DETAIL DRAWING |
| ENGINEER | APL | 23/03/2020 | RC DETAILS OF CONVEYORS 3130-CNV-001 |
| APPROVED | PRI | 24/03/2020 | RC DETAILS |
| EMPLOYER | | | |
| SCALE | 1:100,20,25 | A1 | DRAWING NUMBER: MD-216-3130-EG-CV-DED-1001 — REV: D01 |