



RC DETAIL OF TIE BEAM MKD. TB1 TO TB3

(SLAB REIN. NOT SHOWN FOR CLARITY)
(SCALE- 1:20)

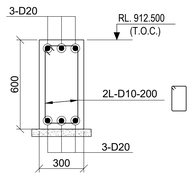


RC DETAIL OF TIE BEAM MKD. T1A

(SLAB REIN. NOT SHOWN FOR CLARITY)
(SCALE- 1:20)

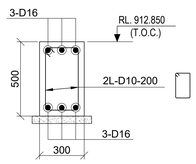


RC DETAIL OF TIE BEAM MKD. TB4 & TB5

(SLAB REIN. NOT SHOWN FOR CLARITY)
(SCALE- 1:20)

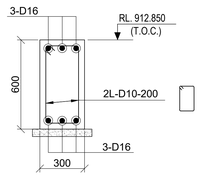


RC DETAIL OF TIE BEAM MKD. TB6

(SLAB REIN. NOT SHOWN FOR CLARITY)
(SCALE- 1:20)

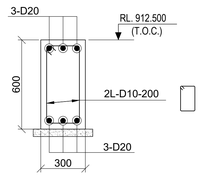


RC DETAIL OF TIE BEAM MKD. TB7

(SLAB REIN. NOT SHOWN FOR CLARITY)
(SCALE- 1:20)

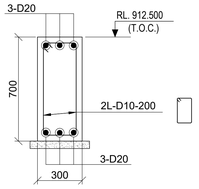


RC DETAIL OF TIE BEAM MKD. TB8

(SLAB REIN. NOT SHOWN FOR CLARITY)
(SCALE- 1:20)

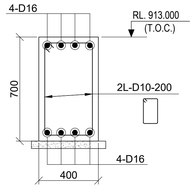


RC DETAIL OF TIE BEAM MKD. TB9

(SLAB REIN. NOT SHOWN FOR CLARITY)
(SCALE- 1:20)

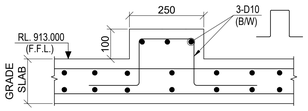


SECTION Y-Y

(REFER DRAWING NUMBER MD-216-3130-EG-CV-GAD- 1003)
SCALE 1:10

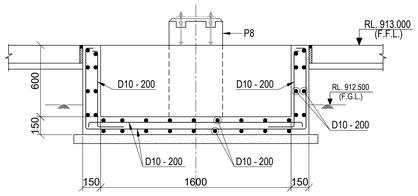


RC DETAIL OF SAND PIT FOR VGTU

(SCALE-1:25)

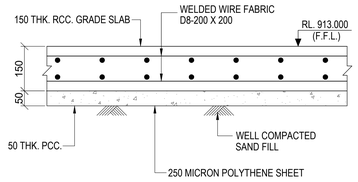


TYP. R.C. DET. OF 150 THK. GRADE SLAB

(SCALE - 1:10)

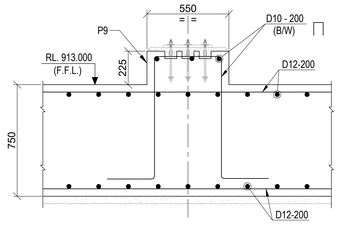


TYP. R.C. DETAIL OF SECTION W-W

(REFER DRAWING NUMBER MD-216-3130-EG-CV-GAD-1003)
(SCALE-1:20)

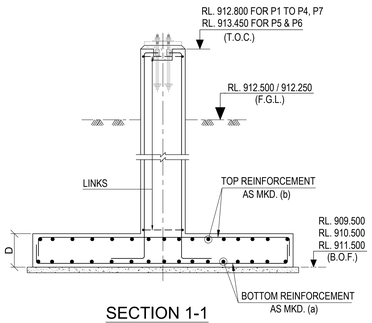


SECTION 1-1

(SCALE-1:40)

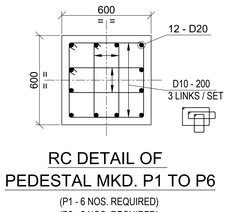


RC DETAIL OF PEDESTAL MKD. P1 TO P6

(P1 - 6 NOS. REQUIRED)
(P2 - 2 NOS. REQUIRED)
(P3 - 4 NOS. REQUIRED)
(P4 - 4 NOS. REQUIRED)
(P5 - 6 NOS. REQUIRED)
(P6 - 2 NOS. REQUIRED)
(SCALE- 1:20)

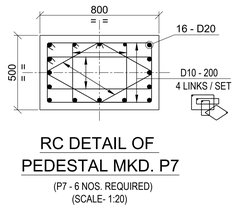


RC DETAIL OF PEDESTAL MKD. P7

(P7 - 6 NOS. REQUIRED)
(SCALE- 1:20)

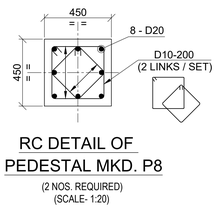

RC DETAIL OF PEDESTAL MKD. P8

(2 NOS. REQUIRED)
(SCALE- 1:20)

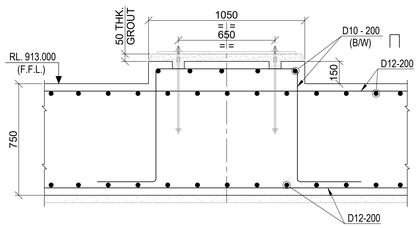


TYP. R.C. DETAIL OF SECTION C1-C1

(REFER DRAWING NUMBER MD-216-3130-EG-CV-GAD-1003)
(SCALE-1:20)

LEGENDS :-

R.L. - REDUCED LEVEL
℄ - CENTRE LINE
CJ - CONSTRUCTION JOINT
FDN. - FOUNDATION.
T.O.C. - TOP OF CONCRETE.
F.G.L. - FINISHED GROUND LEVEL.
F.F.L. - FINISHED FLOOR LEVEL.
B.O.F. - BOTTOM OF FOUNDATION
TYP. - TYPICAL.
R.C. - REINFORCED CONCRETE
P.C.C - PLAIN CEMENT CONCRETE
MKD. - MARKED.
THK - THICK
D - DIAMETER OF BAR
B/W - BOTH WAYS
Ld - DEVELOPMENT LENGTH
BOTTOM REINFORCEMENT (B) - ————
TOP REINFORCEMENT (T) - – – – – – –
ALTH - ALLTHROUGH
B/F - BOTHFACE
REIN. - REINFORCEMENT
DET. - DETAIL

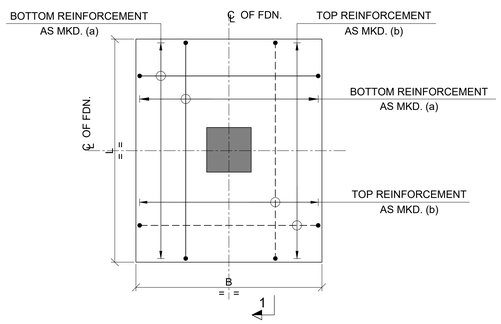


TYPICAL RCC. DET. OF FOUNDATION

(SCALE-1:50)

SCHEDULE OF FOOTING REINFORCEMENT

FDN. MKD.	FOUNDATION DETAILS			REINFORCEMENT DETAIL		BOTTOM OF FDN.	NOS. FDN.
	L	B	D	TOP REIN. (b)	BOTTOM REIN. (a)		
F1	2000	1500	300	D12-200 (B/W)	D16-200 (B/W)	RL. 910.500	2
F2	2000	1500	300	D12-200 (B/W)	D16-200 (B/W)	RL. 911.500	6
F3	2000	2000	300	D12-200 (B/W)	D16-200 (B/W)	RL. 911.500	4
F4	4000	3000	450	D12-200 (B/W)	D16-200 (B/W)	RL. 909.500	1
F5	3000	2500	450	D12-200 (B/W)	D16-200 (B/W)	RL. 909.500	8
F6	2000	2000	350	D12-150 (B/W)	D12-150 (B/W)	RL. 909.500	2
F7	3600	3000	450	D12-150 (B/W)	D16-150 (B/W)	RL. 909.500	6

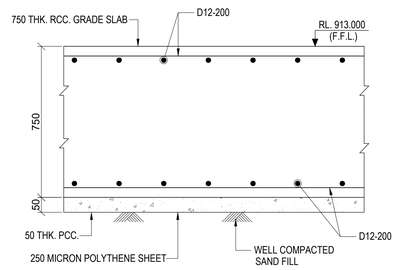

TYP. R.C. DET. OF 750 THK. GRADE SLAB

(SCALE - 1:10)

NOTES :-

1. ALL DIMENSIONS ARE IN MILLIMETRES AND LEVELS AND CO-ORDINATES ARE IN METRES. UNLESS OTHERWISE STATED.
2. GRADE OF CONCRETE SHALL BE C35 FOR FOUNDATION.
3. GRADE OF REINFORCEMENT SHALL BE DEFORMED BAR ASTM A615 - GRADE 60 (fy = 420 MPa).
4. NET SAFE BEARING CAPACITY OF SOIL AT BOTTOM OF FOUNDATION CONSIDERED 500KN/ SQ. M.
5. CLEAR COVER TO MAIN REINFORCEMENT SHALL BE AS
   a) FOUNDATION = 75 mm (BOTTOM & SIDE) 50 mm. (TOP)
   b) COLUMN & PEDESTAL = 50mm
   c) BEAM = 50mm
   d) SLAB = 40mm
6. FOR MINIMUM LAP LENGTH OF REINFORCEMENT AND OTHER GENERAL NOTES FOR CIVIL WORKS REFER STANDARD DRG : MD-216-1000-EG-CV-DED-1001
7. READ THIS DRAWING IN CONJUNCTION WITH DRG: MD-216-3130-EG-CV-GAD-1003
8. FOR OTHER STANDARD REINFORCEMENT DETAILS REFER DRG : MD-216-1000-EG-CV-DED-1005

DOCUMENT NUMBER	REFERENCE DOCUMENTS	REV	DATE	REVISION DESCRIPTION	DRN	CHK	ENG	APP	EMP
		D01	10/03/2023	AS-BUILT	HSK	SBY	RPK/APL	PRI	
		C04	29/01/2021	ISSUED FOR CONSTRUCTION, REVISED AS MKD. (C04)	HSK	SBY	RPK/APL	PRI	
		C03	12/12/2020	ISSUED FOR CONSTRUCTION, REVISED AS MKD. (C03)	HSK	SBY	RPK/APL	PRI	
		C02	12/09/2020	ISSUED FOR CONSTRUCTION, REVISED AS MKD. (C02)	JKM	SBY	RPK/APL	PRI	
		C01	29/05/2020	ISSUED FOR CONSTRUCTION, REVISED AS PER EMPLOYER	AMJ	SBY	RPK/APL	PRI	
				COMMENTS DATED 26/05/2020 & REVISED AS MKD. (C01)					
MD-216-3130-EG-CV-GAD-1003	GA OF CONVEYOR 3130-CNV-003 LAYOUT & DETAIL	A01	30/03/2020	ISSUED FOR REFERENCE	AMJ	SBY	RPK/APL	PRI	

RESERVED FOR VENDOR LOGO AND DRAWING NUMBER

LARSEN & TOUBRO
This drawing is the property of LARSEN & TOUBRO and must not be passed on to any person or body not authorized by us to receive it nor be copied or otherwise made use either in full or in part by such person or body without our prior permission in writing.

Outotec
The content of these documents are the sole property of Outotec Oyj. Any rights not expressly granted herein are reserved. Reproduction, transfer or distribution of part or all of the contents in any form without prior written permission of Outotec is prohibited.

MA'ADEN معادن
Saudi Arabian Mining Company شركة التعدين العربية السعودية
This document and the information contained herein is Ma'aden proprietary know-how. This document or any part thereof should not be reproduced, stored in a retrieval system or transmitted by any means, electronic or otherwise, or divulged without prior written permission of Ma'aden.

LARSEN & TOUBRO DRAWING NUMBER	O19045_100_C_D_24057_006	REVISION 5
OUTOTEC DRAWING NUMBER	900707__GAU01__ZC01__CTB17__31303	DOCUMENT ID OU100670380 REVISION 5
DRAWN	AMJ	28/03/2020
CHECKED	SBY	29/03/2020
ENGINEER	RPK/APL	27/03/2020
APPROVED	PRI	30/03/2020
EMPLOYER		
SCALE	1:100,20,25	A1

MANSOURAH - MASSARAH GOLD PROJECT
DETAIL DRAWING
RC DETAILS OF CONVEYORS 3130-CNV-003
RC DETAILS

DRAWING NUMBER MD - 216 - 3130 - EG - CV - DED - 1003 REV D01