


DRAWING NUMBER MD-216-3130-EG-CV-DED-1004 REV D01

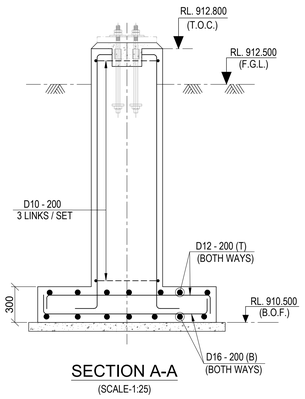


SECTION A-A
(SCALE-1:25)

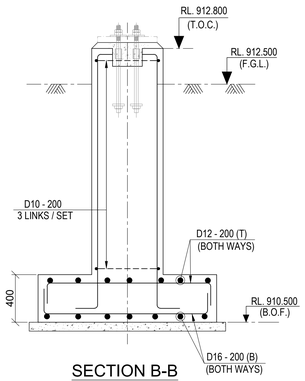


SECTION B-B
(SCALE-1:25)

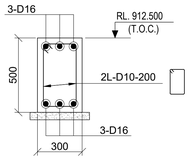


RC DETAIL OF
TIE BEAM MKD. TB1
(SCALE- 1:20)

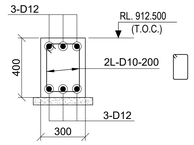


RC DETAIL OF
TIE BEAM MKD. TB2
(SCALE- 1:20)

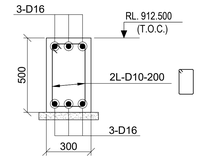


RC DETAIL OF
TIE BEAM MKD. TB3
(SCALE- 1:20)

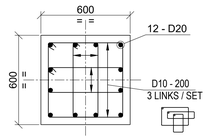

RC DETAIL OF
PEDESTAL MKD. P1, P2 & P3
(P1 - 2 NOS. REQUIRED)
(P2 - 4 NOS. REQUIRED)
(P3 - 6 NOS. REQUIRED)
(SCALE- 1:20)

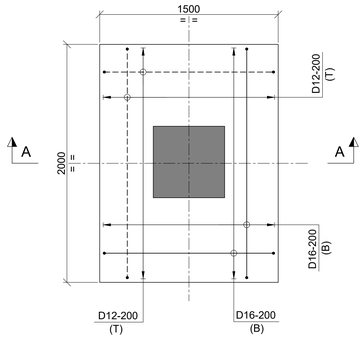

R.C. DETAIL OF FOUNDATION MKD. F1
(F1 - 8 NOS. REQUIRED)
(SCALE- 1:25)

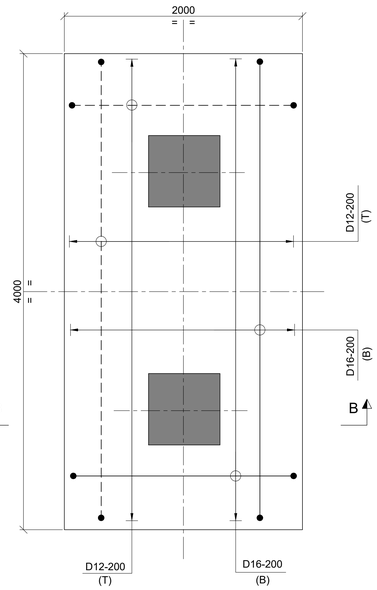

R.C. DETAIL OF FOUNDATION MKD. F2
(F2 - 2 NOS. REQUIRED)
(SCALE- 1:25)

LEGENDS :-

R.L. - REDUCED LEVEL
℄ - CENTRE LINE
CJ - CONSTRUCTION JOINT
FDN. - FOUNDATION.
T.O.C. - TOP OF CONCRETE.
F.G.L. - FINISHED GROUND LEVEL.
F.F.L. - FINISHED FLOOR LEVEL.
B.O.F. - BOTTOM OF FOUNDATION
TYP. - TYPICAL.
R.C. - REINFORCED CONCRETE
P.C.C - PLAIN CEMENT CONCRETE
MKD. - MARKED.
THK. - THICK
D - DIAMETER OF BAR
B/W - BOTH WAYS
Ld - DEVELOPMENT LENGTH
BOTTOM REINFORCEMENT (B) - ————
TOP REINFORCEMENT (T) - – – – – – –
ALTH - ALLTHROUGH
B/F - BOTHFACE
REIN. - REINFORCEMENT

NOTES :-

1. ALL DIMENSIONS ARE IN MILLIMETRES AND LEVELS AND CO-ORDINATES ARE IN METRES. UNLESS OTHERWISE STATED.
2. GRADE OF CONCRETE SHALL BE C35 FOR FOUNDATION.
3. GRADE OF REINFORCEMENT SHALL BE DEFORMED BAR ASTM A615 - GRADE 60 (fy = 420 MPa).
4. NET SAFE BEARING CAPACITY OF SOIL AT BOTTOM OF FOUNDATION CONSIDERED 500KN/ SQ. M.
5. CLEAR COVER TO MAIN REINFORCEMENT SHALL BE AS
   a) FOUNDATION = 75 mm (BOTTOM & SIDE) 50 mm. (TOP)
   b) COLUMN & PEDESTAL = 50mm
   c) BEAM = 50mm
   d) SLAB = 40mm
6. FOR MINIMUM LAP LENGTH OF REINFORCEMENT AND OTHER GENERAL NOTES FOR CIVIL WORKS REFER STANDARD DRG : MD-216-1000-EG-CV-DED-1001
7. READ THIS DRAWING IN CONJUNCTION WITH DRG: MD-216-3130-EG-CV-GAD-1004
8. FOR OTHER STANDARD REINFORCEMENT DETAILS REFER DRG : MD-216-1000-EG-CV-DED-1005

DOCUMENT NUMBER	REFERENCE DOCUMENTS	REV	DATE	REVISION DESCRIPTION	DRN	CHK	ENG	APP	EMP
		D01	10/03/2023	AS-BUILT	AMJ	SBY	APL	PRI	
		C02	11/08/2020	ISSUED FOR CONSTRUCTION, REVISED AS MKD. (C02)	JKM	SBY	APL	PRI	
		C01	29/04/2020	ISSUED FOR CONSTRUCTION, REVISED AS PER EMPLOYER	AMJ	SBY	APL	PRI	
				COMMENTS DATED 27/04/2020 & REVISED AS MKD. (C01)					
MD-216-3130-EG-CV-GAD-1004	GA OF CONVEYORS 3130-FDR-003 & FDR-004	A01	04/04/2020	ISSUED FOR REFERENCE	AMJ	SBY	APL	PRI	

RESERVED FOR VENDOR LOGO AND DRAWING NUMBER

LARSEN & TOUBRO
This drawing is the property of LARSEN & TOUBRO and must not be passed on to any person or body not authorized by us to receive it nor be copied or otherwise made use either in full or in part by such person or body without our prior permission in writing.

Outotec
The content of these documents are the sole property of Outotec Oyj. Any rights not expressly granted herein are reserved. Reproduction, transfer or distribution of part or all of the contents in any form without prior written permission of Outotec is prohibited.

MA'ADEN معادن
Saudi Arabian Mining Company شركة معادن العربية السعودية
This document and the information contained herein is Ma'aden proprietary know-how. This document or any part thereof should not be reproduced, stored in a retrieval system or transmitted by any means, electronic or otherwise, or divulged without prior written permission of Ma'aden.

LARSEN & TOUBRO DRAWING NUMBER: O19045_100_C_D_24057_007 — REVISION: 3
OUTOTEC DRAWING NUMBER: 900707 __GAU01 __ZC01 __CTB17 __31304 — DOCUMENT ID: OU100670381 — REVISION: 3

DRAWN	AMJ	02/04/2020
CHECKED	SBY	03/04/2020
ENGINEER	APL	01/04/2020
APPROVED	PRI	04/04/2020
EMPLOYER		
SCALE	1:100,20,25	A1

MANSOURAH - MASSARAH GOLD PROJECT
DETAIL DRAWING
RC DETAILS OF CONVEYORS 3130-FDR-003 & FDR-004
RC DETAILS

DRAWING NUMBER: MD-216-3130-EG-CV-DED-1004 — REV: D01