

DRAWING NUMBER MD-216-3130-EG-CV-DED-1006 REV D01

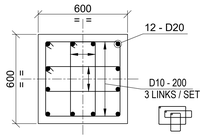


RC DETAIL OF PEDESTAL MKD. P1 & P2

(P1 - 2 NOS. REQUIRED)
(P2 - 4 NOS. REQUIRED)
(SCALE-1:20)

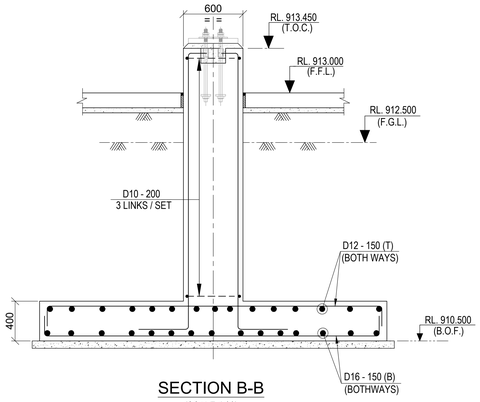


SECTION B-B

(SCALE-1:30)

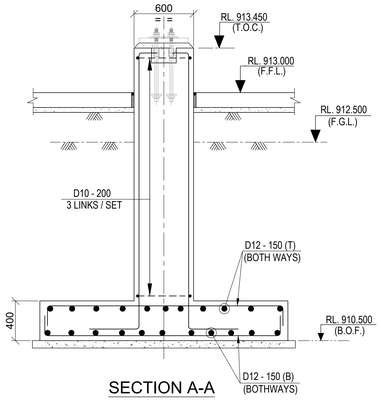


SECTION A-A

(SCALE-1:30)

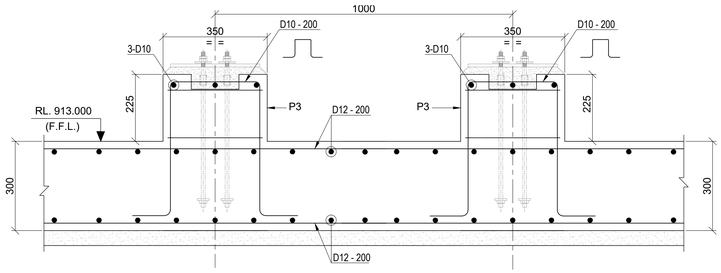


TYP. R.C. DETAIL OF SECTION A-A

(REFER DRAWING NUMBER MD-216-3130-EG-CV-GAD-1006)
(SCALE-1:10)

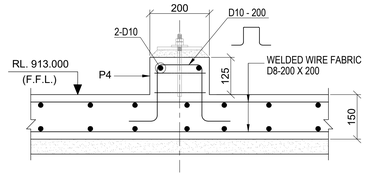


TYP. R.C. DETAIL OF SECTION B-B

(REFER DRAWING NUMBER MD-216-3130-EG-CV-GAD-1006)
(SCALE-1:10)

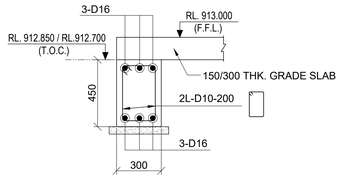


RC DETAIL OF GRADE BEAM MKD. GB1

(REINFORCEMENT SHALL BE CURTAILED AT THE FACE OF COLUMN)
(GRADE SLAB REIN. NOT SHOWN FOR CLARITY)
(SCALE- 1:20)

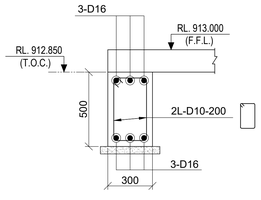


RC DETAIL OF TIE BEAM MKD. TB1

(GRADE SLAB REIN. NOT SHOWN FOR CLARITY)
(SCALE- 1:20)

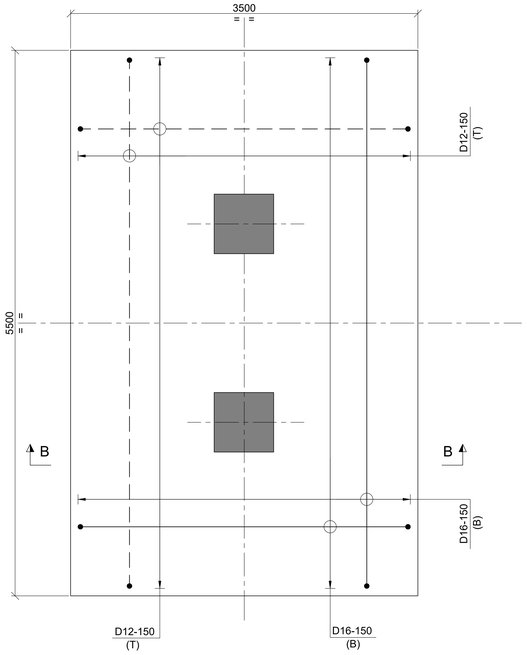


R.C. DETAIL OF FOUNDATION MKD. F2

(F1-2 NOS. REQUIRED)
(SCALE- 1:30)

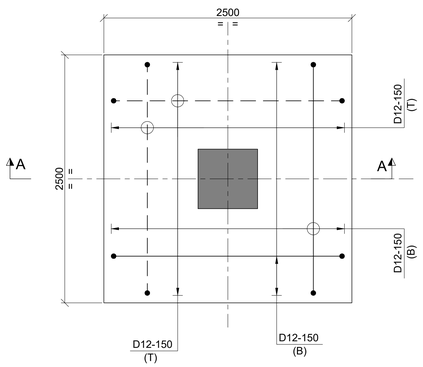


R.C. DETAIL OF FOUNDATION MKD. F1

(F1-2 NOS. REQUIRED)
(SCALE- 1:30)

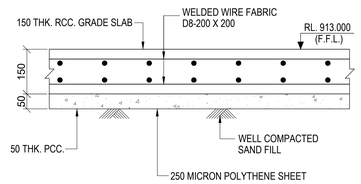

TYP. R.C. DET. OF 150 THK. GRADE SLAB

(SCALE - 1:10)

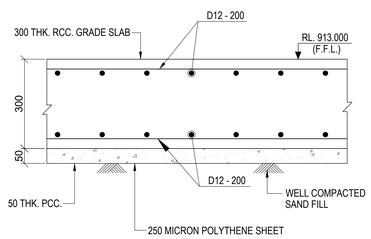

TYP. R.C. DET. OF 300 THK. GRADE SLAB

(SCALE - 1:10)

LEGENDS :-

R.L. - REDUCED LEVEL
℄ - CENTRE LINE
CJ - CONSTRUCTION JOINT
FDN. - FOUNDATION.
T.O.C. - TOP OF CONCRETE.
F.G.L. - FINISHED GROUND LEVEL.
F.F.L. - FINISHED FLOOR LEVEL.
B.O.F. - BOTTOM OF FOUNDATION
TYP. - TYPICAL.
R.C. - REINFORCED CONCRETE
P.C.C - PLAIN CEMENT CONCRETE
MKD. - MARKED.
THK. - THICK
D - DIAMETER OF BAR
B/W - BOTH WAYS
Ld - DEVELOPMENT LENGTH
BOTTOM REINFORCEMENT (B) - ———
TOP REINFORCEMENT (T) - – – – – –
ALTH - ALLTHROUGH
B/F - BOTHFACE
REIN. - REINFORCEMENT

NOTES :-

1. ALL DIMENSIONS ARE IN MILLIMETRES AND LEVELS AND CO-ORDINATES ARE IN METRES. UNLESS OTHERWISE STATED.
2. GRADE OF CONCRETE SHALL BE C35 FOR FOUNDATION.
3. GRADE OF REINFORCEMENT SHALL BE DEFORMED BAR ASTM A615 - GRADE 60 (fy = 420 MPa).
4. NET SAFE BEARING CAPACITY OF SOIL AT BOTTOM OF FOUNDATION CONSIDERED 500KN/ SQ. M.
5. CLEAR COVER TO MAIN REINFORCEMENT SHALL BE AS
   a) FOUNDATION = 75 mm (BOTTOM & SIDE) 50 mm. (TOP)
   b) COLUMN & PEDESTAL = 50mm
   c) BEAM = 50mm
   d) SLAB = 40mm
6. FOR MINIMUM LAP LENGTH OF REINFORCEMENT REFER STANDARD DRG : MD-216-1000-EG-CV-DED-1001
7. READ THIS DRAWING IN CONJUNCTION WITH DRG: MD-216-3130-EG-CV-GAD-1006
8. FOR OTHER STANDARD REINFORCEMENT DETAILS REFER DRG : MD-216-1000-EG-CV-DED-1005

DOCUMENT NUMBER	REFERENCE DOCUMENTS	REV	DATE	REVISION DESCRIPTION	DRN	CHK	ENG	APP	EMP
		D01	10/03/2023	AS-BUILT	JKM	SBY	RPK	PRI	
		C02	29/01/2021	ISSUED FOR CONSTRUCTION & REVISED AS MKD. C02	JKM	SBY	RPK	PRI	
		C01	11/05/2020	ISSUED FOR CONSTRUCTION, REVISED AS PER EMPLOYER COMMENTS DATED 05/05/2020 & REVISED AS MKD. C01	AMJ	SBY	RPK	PRI	
MD-216-3130-EG-CV-GAD-1006	GA OF TP – 4 (3130 CNV-002) LAYOUT & DETAIL	A01	10/04/2020	ISSUED FOR REFERENCE	AMJ	SBY	RPK	PRI	

RESERVED FOR VENDOR LOGO AND DRAWING NUMBER

LARSEN & TOUBRO
This drawing is the property of LARSEN & TOUBRO and must not be passed on to any person or body not authorized by us to receive it nor be copied or otherwise made use either in full or in part by such person or body without our prior permission in writing.

Outotec
The content of these documents are the sole property of Outotec Oyj. Any rights not expressly granted herein are reserved. Reproduction, transfer or distribution of part or all of the contents in any form without prior written permission of Outotec is prohibited.

MA'ADEN معادن
Saudi Arabian Mining Company شركة المعادن العربية السعودية
This document and the information contained herein is Ma'aden proprietary know-how. This document or any part thereof should not be reproduced, stored in a retrieval system or transmitted by any means, electronic or otherwise, or divulged without prior written permission of Ma'aden.

LARSEN & TOUBRO DRAWING NUMBER	O19045_100_C_D_24110_002	REVISION 3
OUTOTEC DRAWING NUMBER	900707 _GAU01 _ZC01 _CTB01 _31302	DOCUMENT ID OU100668050 / REVISION 3
DRAWN	AMJ	08/04/2020
CHECKED	SBY	09/04/2020
ENGINEER	RPK	07/04/2020
APPROVED	PRI	10/04/2020
EMPLOYER		
SCALE	1:100,20,15	A1

MANSOURAH - MASSARAH GOLD PROJECT
DETAIL DRAWING
RC DETAILS OF TP-4
RC DETAILS

DRAWING NUMBER MD - 216 - 3130 - EG - CV - DED - 1006 REV D01