


DRAWING NUMBER MD-216-3130-EG-CV-DED-1007 REV D01

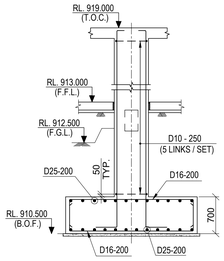


SECTION : 1-1
(SCALE- 1:50)

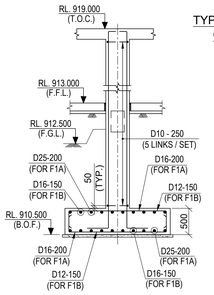


SECTION : 1A-1A
(SCALE- 1:50)

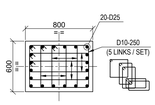


TYP. CROSS SECTION OF COLUMN MKD. C1
(8 NO. REQUIRED)
(SCALE- 1:25)

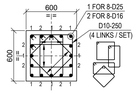


TYP. CROSS SECTION OF COLUMN MKD. C2
(8 NO. REQUIRED)
(SCALE- 1:25)

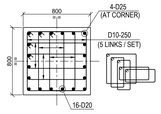


TYP. CROSS SECTION OF PEDESTAL MKD. P1 & P2
(6 NOS. P1 & 2 NOS. P2 REQUIRED)
(SCALE- 1:25)

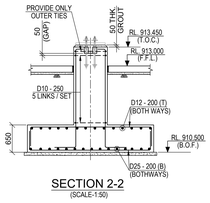


SECTION 2-2
(SCALE-1:50)

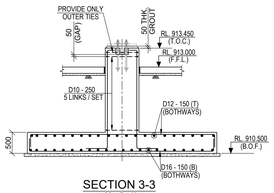


SECTION 3-3
(SCALE-1:50)

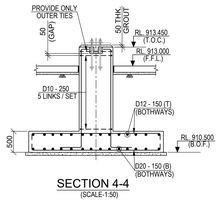


SECTION 4-4
(SCALE-1:50)

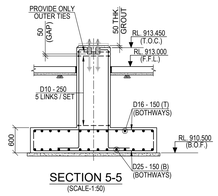


SECTION 5-5
(SCALE-1:50)

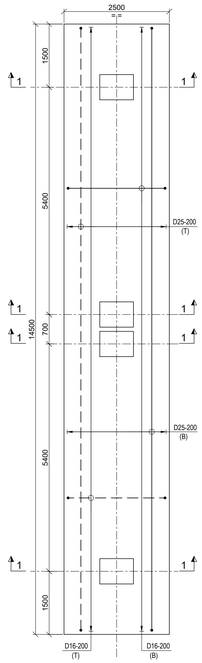


R.C. DETAIL OF FOUNDATION MKD. F1
(1 NO. REQUIRED)
(SCALE- 1:50)

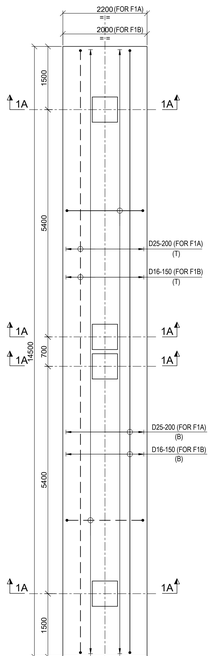


R.C. DETAIL OF FOUNDATION MKD. F1A & F1B
(1 NO. F1A & 2 NOS. F1B REQUIRED)
(SCALE- 1:50)

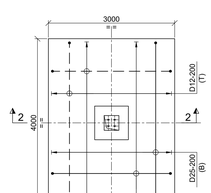


R.C. DETAIL OF FOUNDATION MKD. F2
(2 NOS. REQUIRED)
(SCALE- 1:50)

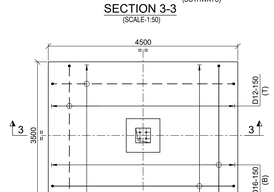


R.C. DETAIL OF FOUNDATION MKD. F3
(2 NOS. REQUIRED)
(SCALE- 1:50)

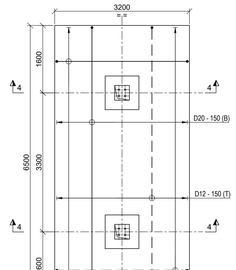


R.C. DETAIL OF FOUNDATION MKD. F4
(1 NO. REQUIRED)
(SCALE- 1:50)

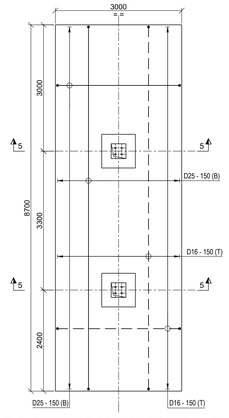


R.C. DETAIL OF FOUNDATION MKD. F5
(1 NO. REQUIRED)
(SCALE- 1:50)

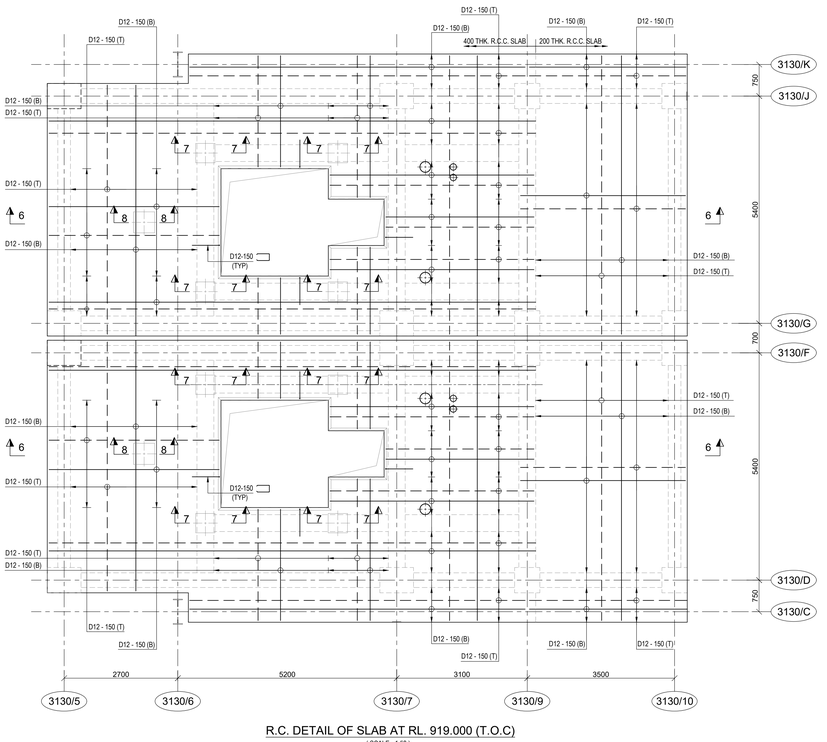


R.C. DETAIL OF SLAB AT RL. 919.000 (T.O.C)
(SCALE - 1:50)

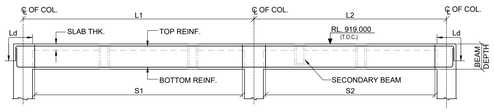


TYP. R.C DETAIL OF BEAM
(SLAB REIN. NOT SHOWN FOR CLARITY)
(SCALE- 1:50)

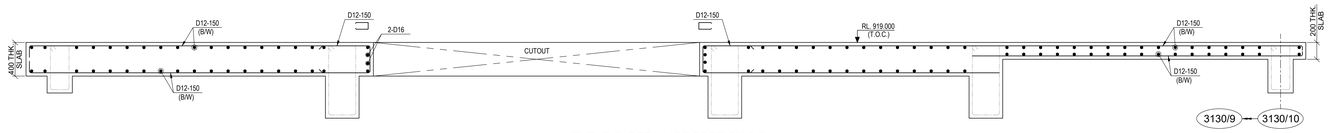


TYP. R.C. DETAIL OF SECTION 6-6
(BEAM REIN. NOT SHOWN FOR CLARITY)
(SCALE- 1:25)

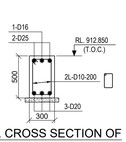


TYP. CROSS SECTION OF BEAM MKD. TB1
(SLAB REIN. NOT SHOWN FOR CLARITY)
(SCALE- 1:25)

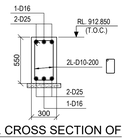


TYP. CROSS SECTION OF BEAM MKD. TB2
(SLAB REIN. NOT SHOWN FOR CLARITY)
(SCALE- 1:25)

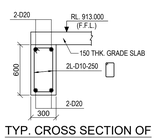


TYP. CROSS SECTION OF GRADE BEAM
(GRADE SLAB REIN. NOT SHOWN FOR CLARITY)
(SCALE- 1:25)

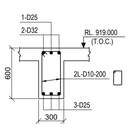


TYP. CROSS SECTION OF BEAM MKD. FB1
(SLAB REIN. NOT SHOWN FOR CLARITY)
(SCALE- 1:25)

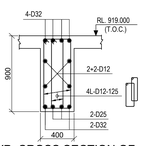


TYP. CROSS SECTION OF BEAM MKD. FB2
(SLAB REIN. NOT SHOWN FOR CLARITY)
(SCALE- 1:25)

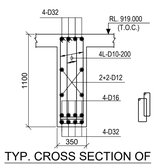

TYP. CROSS SECTION OF BEAM MKD. FB3
(SLAB REIN. NOT SHOWN FOR CLARITY)
(SCALE- 1:25)

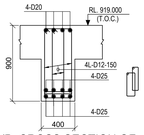


TYP. CROSS SECTION OF BEAM MKD. B1
(SLAB REIN. NOT SHOWN FOR CLARITY)
(SCALE- 1:25)

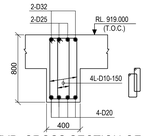


TYP. CROSS SECTION OF BEAM MKD. B2
(SLAB REIN. NOT SHOWN FOR CLARITY)
(SCALE- 1:25)


LEGEND :-
RL - REDUCED LEVEL
℄ - CENTRE LINE
T.O.C - TOP OF CONCRETE
F.G.L - FINISHED GROUND LEVEL
B.O.F - BOTTOM OF FOUNDATION
N.T.S - NOT TO SCALE
TYP - TYPICAL
R.C.C - REINFORCED CEMENT CONCRETE
P.C.C - PLAIN CEMENT CONCRETE
MKD - MARKED
THK - THICK
MM - MILLIMETER
R.C - REINFORCED CONCRETE
T - TOP
B - BOTTOM
– – – – - TOP REINFORCEMENT
——— - BOTTOM REINFORCEMENT
D - DIAMETER OF BAR
B/W - BOTH WAYS
REINF. - TOP REINFORCEMENT
Ld - DEVELOPMENT LENGTH

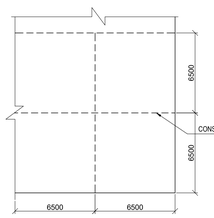


TYP. PLAN OF CONSTRUCTION JOINT
(CONCRETE GRADE SLAB AREA)
(SCALE - 1:100)

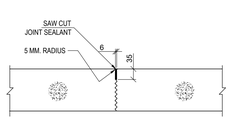


CONSTRUCTION JOINT
(SCALE 1:10)

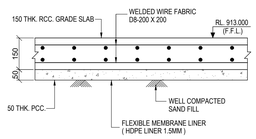


TYP. DET. OF 150 THK. GRADE SLAB
(SCALE - 1:10)

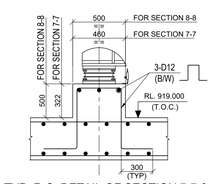

TYP. R.C. DETAIL OF SECTION 7-7 & 8-8
(SCALE 1:20)

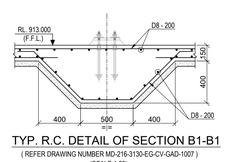

TYP. R.C. DETAIL OF SECTION B1-B1
(REFER DRAWING NUMBER MD-216-3130-EG-CV-GAD-1007)
(SCALE-1:20)

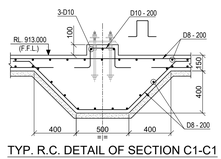

TYP. R.C. DETAIL OF SECTION C1-C1
(REFER DRAWING NUMBER MD-216-3130-EG-CV-GAD-1007)
(SCALE-1:20)

NOTES :-
1. ALL DIMENSIONS ARE IN MILLIMETRES AND LEVELS AND CO-ORDINATES ARE IN METRES, UNLESS OTHERWISE STATED.
2. GRADE OF CONCRETE SHALL BE C35 FOR FOUNDATION.
3. GRADE OF REINFORCEMENT SHALL BE DEFORMED BAR ASTM A615 - GRADE 60 (fy = 420 MPa).
4. NET SAFE BEARING CAPACITY OF SOIL AT BOTTOM OF FOUNDATION CONSIDERED 500KN/SQ. M.
5. CLEAR COVER TO MAIN REINFORCEMENT SHALL BE AS
   a) FOUNDATION = 75mm (BOTTOM & SIDE) 50 mm (TOP)
   b) TIE BEAM = 50 mm c) COLUMN = 50mm d) BEAM = 50mm e) SLAB = 40mm
6. MINIMUM LAP LENGTH OF REINFORCEMENT SHALL BE 40 x DIA. OF BAR.
7. THIS DRG. SHALL BE READ IN CONJUNCTION WITH DRG. NO. MD-216-3130-EG-CV-GAD-1007-A02 & MD-216-3130-EG-CV-GAD-1008-A01

DOCUMENT NUMBER	REFERENCE DOCUMENTS	REV	DATE	REVISION DESCRIPTION	DRN	CHK	ENG	APP	EMP
		D01	10/03/2023	AS-BUILT	HSK	SBY	RPK	AG	
		C02	21/08/2020	ISSUED FOR CONSTRUCTION, REVISED AS MKD. (C02)	HSK	SBY	RPK	AG	
		C01	12/03/2020	ISSUED FOR CONSTRUCTION, REVISED AS PER EMPLOYER COMMENTS DATED 26.02.2020 & REVISED AS MKD. (C01)	HSK	SBY	RPK	AG	
MD-216-1000-EG-ST-CRT-1001	CIVIL,STRUCTURAL AND ARCHITECTURAL DESIGN CRITERIA	A01	27/01/2020	ISSUED FOR REFERENCE	HSK	SBY	RPK	AG	

RESERVED FOR VENDOR LOGO AND DRAWING NUMBER

LARSEN & TOUBRO

This drawing is the property of LARSEN & TOUBRO and must not be passed on to any person or body not authorised by us to receive it nor be copied or otherwise made use either in full or in part by such person or body without our prior permission in writing.

Outotec

The content of these documents are the sole property of Outotec Oyj. Any rights not expressly granted herein are reserved. Reproduction, transfer or distribution of part or all of the contents in any form without prior written permission of Outotec is prohibited.

MA'ADEN معادن Saudi Arabian Mining Company شركة معادن العربية السعودية

This document and the information contained herein is Ma'aden proprietary know-how. This document or any part thereof should not be reproduced, stored in a retrieval system or transmitted by any means, electronic or otherwise, or divulged without prior written permission of Ma'aden.

LARSEN & TOUBRO DRAWING NUMBER: 019045_100_C_D_24066_001 — REVISION: 3
OUTOTEC DRAWING NUMBER: 900707 _ GAU01 _ ZC01 _ CTB17 _ 31305 — DOCUMENT ID: OU100670455 — REVISION: 3

DRAWN	HSK	10/01/2020
CHECKED	SBY	23/01/2020
ENGINEER	RPK	20/01/2020
APPROVED	AG	27/01/2020
EMPLOYER		

SCALE: 1:50,1:25,1:20,1:10 — A0

MANSOURAH - MASSARAH GOLD PROJECT
DETAIL DRAWING
TERTIARY CRUSHING
RC DETAILS

DRAWING NUMBER: MD - 216 - 3130 - EG - CV - DED - 1007 — REV: D01