
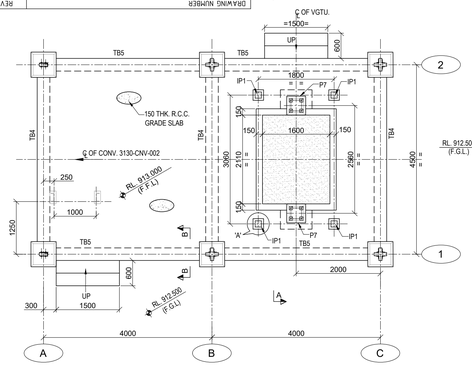



PLAN OF GRADE SLAB AT RL. 913.000 AND TIE BEAM AT RL. 912.850 (T.O.B) (FOR VGTU TOWER)

(SCALE-1:50)

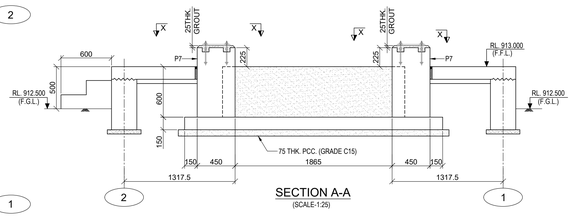

SECTION A-A

(SCALE-1:25)

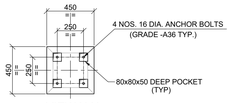


VIEW X-X


DETAIL OF PEDESTAL MKD. P7

(SCALE 1:20)

SCHEDULE OF BOLTS						
D BOLT DIA. MM	BxB BOTTOM PLATE (SQUARE) SQ MM	DIMENSIONS (MM)				
		L	A	C	T	H
16	50x50	350	120	100	10	30
20	60x60	450	160	110	10	30
24	75x75	600	175	125	12	30

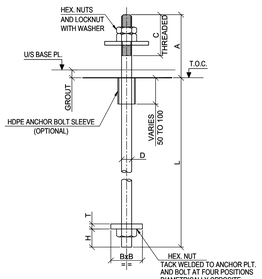


TYP. DETAIL OF BOLT

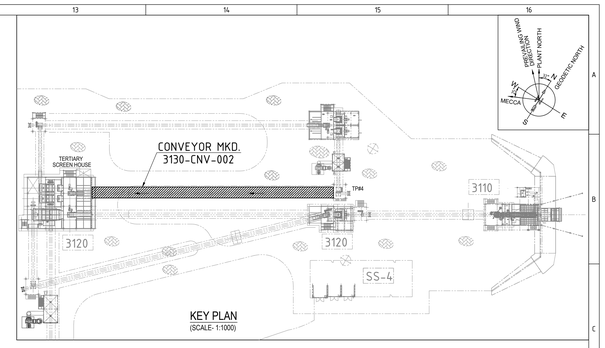


KEY PLAN

(SCALE- 1:1000)

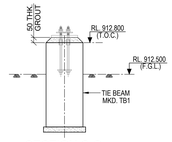


SECTION C-C

(SCALE-1:20)

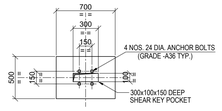


DETAIL OF PEDESTAL MKD. P4

(SCALE-1:25)

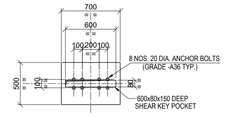


DETAIL OF PEDESTAL MKD. P4A

(SCALE-1:25)

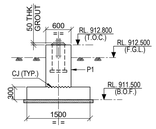


SECTION 1A-1A

(SCALE-1:50)

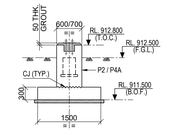


SECTION 1-1

(SCALE-1:50)

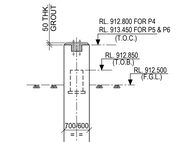


SECTION 3-3

(SCALE-1:50)

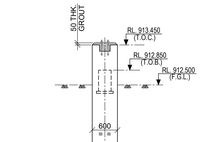


SECTION 4-4

(SCALE-1:50)

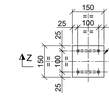


DETAIL OF INSERT PLATE - IP1

(SCALE 1:10)

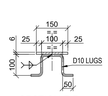


SECTION Z-Z

(SCALE 1:10)

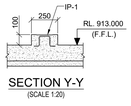


SECTION Y-Y

(SCALE 1:20)

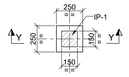


DETAIL - 'A'

(SCALE 1:20)

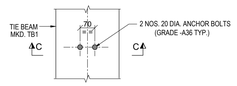


DETAIL - 'B'

(SCALE 1:10)

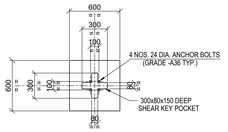


DETAIL OF PEDESTAL MKD. P5

(SCALE-1:25)

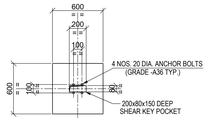


DETAIL OF PEDESTAL MKD. P6

(SCALE-1:25)

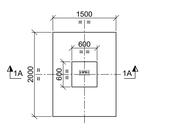


DETAIL OF FOUNDATION MKD. F1A

(SCALE-1:50)

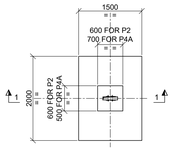


DETAIL OF FOUNDATION MKD. F1

(SCALE-1:50)

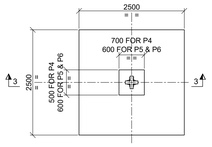


DETAIL OF FOUNDATION MKD. F3

(SCALE-1:50)

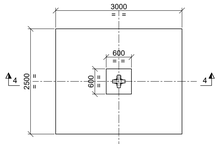

DETAIL OF FOUNDATION MKD. F4

(SCALE-1:50)

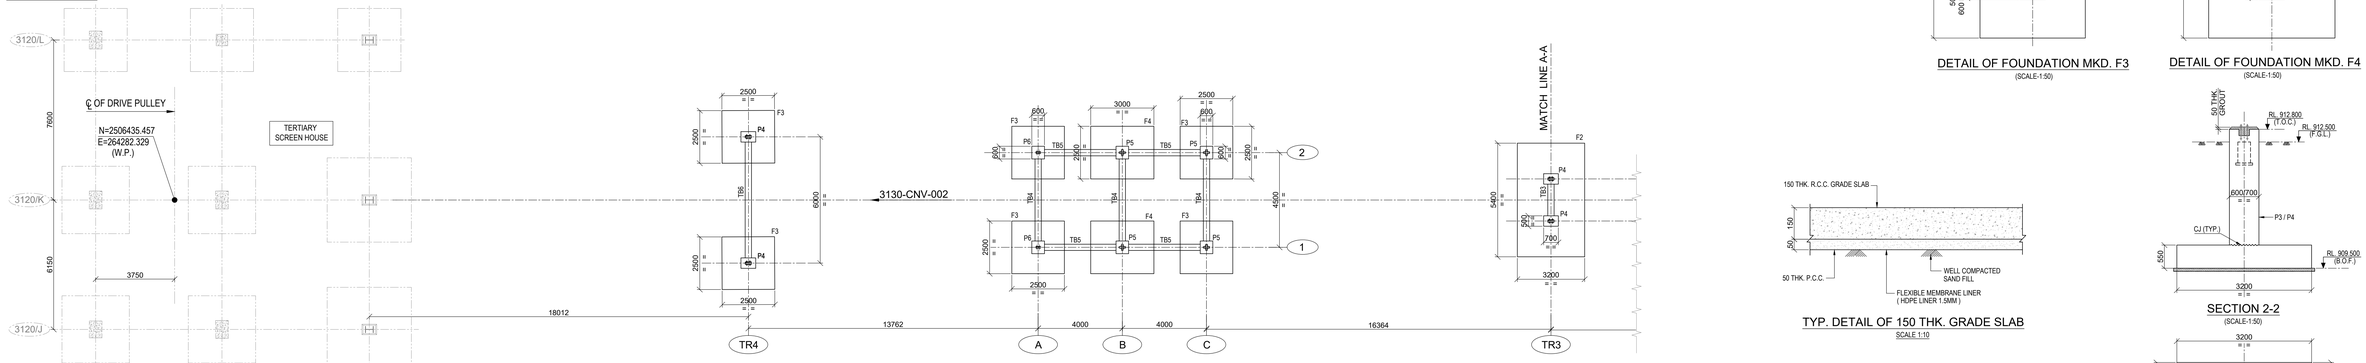

LAYOUT OF FOUNDATION AND TIE BEAM


(SCALE-1:100)

LAYOUT OF FOUNDATION AND TIE BEAM

(SCALE-1:100)


TYP. DETAIL OF 150 THK. GRADE SLAB

SCALE 1:10

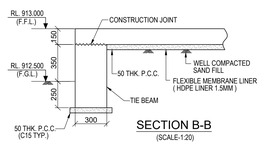

SECTION B-B

(SCALE-1:20)

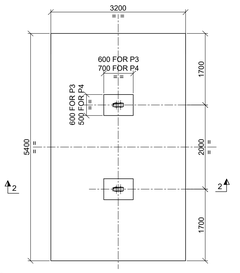

DETAIL OF FOUNDATION MKD. F2

(SCALE-1:50)

SCHEDULE OF BEAM			
BEAM MKD.	SIZE		LEVEL
	WIDTH (mm.)	DEPTH (mm.)	
TB1	350	600	RL. 912.800 (T.O.B.)
TB2	300	500	RL. 912.500 (T.O.B.)
TB2A	300	500	RL. 912.500 (T.O.B.)
TB3	300	500	RL. 912.500 (T.O.B.)
TB4	300	500	RL. 912.850 (T.O.B.)
TB5	300	600	RL. 912.850 (T.O.B.)
TB6	300	600	RL. 912.500 (T.O.B.)

NOTES :-

1. ALL DIMENSIONS ARE IN MILLIMETRES AND LEVELS AND CO-ORDINATES ARE IN METRES. UNLESS OTHERWISE STATED.
2. GRADE OF CONCRETE SHALL BE C35 FOR FOUNDATION.
3. GRADE OF REINFORCEMENT SHALL BE DEFORMED BAR ASTM A615 - GRADE 60 (fy = 420 MPa).
4. NET SAFE BEARING CAPACITY OF SOIL AT BOTTOM OF FOUNDATION CONSIDERED 500KN/ SQ. M.
5. CLEAR COVER TO MAIN REINFORCEMENT SHALL BE AS
   a) FOUNDATION = 75 mm (BOTTOM & SIDE) 50 mm. (TOP)
   b) COLUMN & PEDESTAL = 50mm
   c) BEAM = 50mm
   d) SLAB = 40mm
6. FOR MINIMUM LAP LENGTH OF REINFORCEMENT REFER STANDARD DRG : MD-216-1000-EG-CV-DED-1001
7. THIS DRAWING IS TO BE READ IN CONJUNCTION WITH DRAWING MD - 216 - 3130 -EG -ST - GAD - 1006 TO MD - 216 - 3130 -EG -ST - GAD - 1010
8. ALL STRUCTURAL WORK SHALL CONFORM TO CIVIL STRUCTURAL DESIGN CRITERIA NO. MD - 216 - 1000 -EG -ST - CRT - 1001

LEGENDS :-

R.L. - REDUCED LEVEL
℄ - CENTRE LINE
C.J - CONSTRUCTION JOINT
FDN. - FOUNDATION
T.O.C. - TOP OF CONCRETE
F.G.L. - FINISHED GROUND LEVEL.
F.F.L. - FINISHED FLOOR LEVEL.
B.O.F. - BOTTOM OF FOUNDATION
TYP. - TYPICAL.
B.O.B. - BOTTOM OF BEAM.
B.O.M. - BOTTOM OF MONORAIL.
R.C.C. - REINFORCED CEMENT CONCRETE
P.C.C. - PLAIN CEMENT CONCRETE
IP. - INSERT PLATE
MKD. - MARKED.
THK. - THICK

DOCUMENT NUMBER	REFERENCE DOCUMENTS	REV	DATE	REVISION DESCRIPTION	DRN	CHK	ENG	APP	EMP
		D01	10/03/2023	AS-BUILT	AMJ	SBY	RPK	PRI	
		C03	07/01/2021	ISSUED FOR CONSTRUCTION & REVISE AS MKD. C03	AMJ	SBY	RPK	PRI	
MD-216-3130-EG-ME-ELV-1107	TERTIARY CRUSHING CONV. 3130-CNV-002-ELEVATION	C02	12/12/2020	ISSUED FOR CONSTRUCTION & REVISE AS MKD. C02	AMJ	SBY	RPK	PRI	
MD-216-3130-EG-ME-ELV-1006	TERTIARY CRUSHING CONV. 3130-CNV-002-ELEVATION	C01	24/04/2020	ISSUED FOR CONSTRUCTION, REVISED AS PER EMPLOYER	AMJ	SBY	RPK	PRI	
MD-216-3130-EG-ME-ELV-1005	TERTIARY CRUSHING CONV. 3130-CNV-002-ELEVATION			COMMENTS DATED 13/04/2020 & REVISE AS MKD. C01					
MD-216-3130-EG-ME-LPX-1003	TERTIARY CRUSHING CONV. 3130-CNV-002 - PLAN	A01	26/03/2020	ISSUED FOR REFERENCE	AMJ	SBY	RPK	PRI	

RESERVED FOR VENDOR LOGO AND DRAWING NUMBER

LARSEN & TOUBRO

This drawing is the property of LARSEN & TOUBRO and must not be passed on to any person or body not authorised by us to receive it nor be copied or otherwise made use either in full or in part by such person or body without our prior permission in writing.

Outotec

The content of these documents are the sole property of Outotec Oy. Any rights not expressly granted herein are reserved. Reproduction, transfer or distribution of part or all of the contents in any form without prior written permission of Outotec is prohibited.

MA'ADEN معادن Saudi Arabian Mining Company شركة المعادن العربية السعودية

This document and the information contained herein is Ma'aden proprietary know-how. This document or any part thereof should not be reproduced, stored in a retrieval system or transmitted by any means, electronic or otherwise, or divulged without prior written permission of Ma'aden.

LARSEN & TOUBRO DRAWING NUMBER	019045_100_C_G_24056_005
REVISION	4
OUTOTEC DRAWING NUMBER	900707__GA001__ZC01__MTL01__31358
DOCUMENT ID	OU100670365
REVISION	4
DRAWN	AMJ 24/03/2020
CHECKED	SBY 25/03/2020
ENGINEER	RPK 23/03/2020
APPROVED	PRI 26/03/2020
EMPLOYER	
SCALE	1:100,50,20,10 A0
PROJECT	MANSOURAH - MASSARAH GOLD PROJECT
	GENERAL ARRANGEMENT DRAWING
	CONVEYOR 3130-CNV-002
	LAYOUT & DETAIL
DRAWING NUMBER	MD-216-3130-EG-CV-GAD-1002
REV	D01