DRAWING NUMBER MD-216-3130-EG-CV-GAD-1003 REV D01

SCHEDULE OF BEAM


BEAM MKD.	SIZE WIDTH (mm.)	SIZE DEPTH (mm.)	LEVEL
TB1	300	500	RL. 912.500 (T.O.B.)
TB1A	300	600	RL. 912.500 (T.O.B.)
TB2	300	500	RL. 912.500 (T.O.B.)
TB3	300	500	RL. 912.500 (T.O.B.)
TB4	300	500	RL. 912.850 (T.O.B.)
TB5	300	500	RL. 912.850 (T.O.B.)
TB6	300	600	RL. 912.850 (T.O.B.)
TB7	300	600	RL. 912.500 (T.O.B.)
TB8	300	700	RL. 912.500 (T.O.B.)
TB9	400	700	RL. 913.000 (T.O.B.)

SCHEDULE OF FOUNDATION

FDN. MKD.	TYPE MKD.	PEDESTAL	FOUNDATION DETAILS L	B	D	BOTTOM OF FDN.	TOP OF PEDESTAL	NOS. FDN.
F1	I	P1	2000	1500	300	RL. 910.500	RL. 912.800	2
F2	I	P1 & P2	2000	1500	300	RL. 911.500	RL. 912.800	6
F3	I	P3	2000	2000	300	RL. 911.500	RL. 912.800	4
F4	II	P4	4000	3000	450	RL. 909.500	RL. 912.800	1
F5	I	P4 & P5	3000	2500	450	RL. 909.500	RL. 912.800 FOR P4 RL. 913.450 FOR P5	8
F6	I	P6	2000	2000	350	RL. 909.500	RL. 913.450	2
F7	I	P7	3600	3000	450	RL. 909.500	RL. 912.800	6


SCHEDULE OF BOLTS

D BOLT DIA. MM	BxB BOTTOM PLATE (SQUARE) SQ MM	DIMENSIONS (MM) L	A	C	T	H
16	50x50	350	120	80	10	30
20	60x60	450	160	110	10	30
30 & 32	100x100	800	200	150	16	35

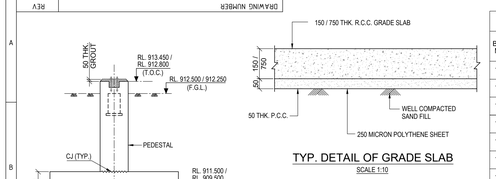


SECTION 1-1
(SCALE-1:50)


TYP. DETAIL OF GRADE SLAB
SCALE 1:10

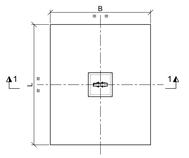


TYPICAL FOUNDATION PLAN
(TYPE-I)
(SCALE-1:50)

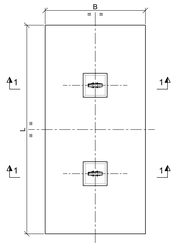


TYPICAL FOUNDATION PLAN
(TYPE-II)
(SCALE-1:50)

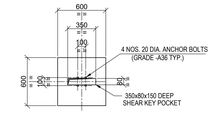


DETAIL OF PEDESTAL MKD. P1
(SCALE-1:25)

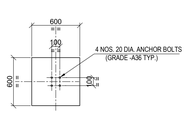


DETAIL OF PEDESTAL MKD. P2 & P6
(SCALE-1:25)

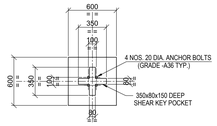


DETAIL OF PEDESTAL MKD. P3
(SCALE-1:25)

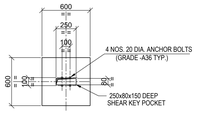


DETAIL OF PEDESTAL MKD. P4
(SCALE-1:25)

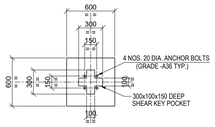


DETAIL OF PEDESTAL MKD. P5
(SCALE-1:25)

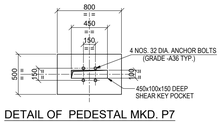


DETAIL OF PEDESTAL MKD. P7
(SCALE-1:25)

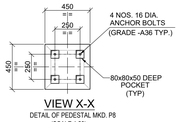


VIEW X-X
DETAIL OF PEDESTAL MKD. P8
(SCALE 1:20)

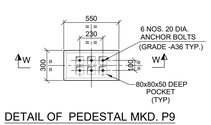


DETAIL OF PEDESTAL MKD. P9
(SCALE-1:20)

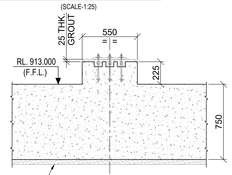


SECTION W-W
(SCALE-1:20)

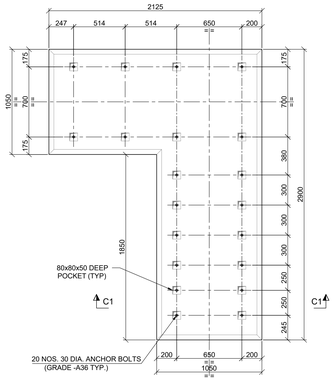


DETAIL - 'C'
(SCALE 1:20)

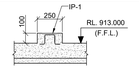


SECTION Y-Y
(SCALE 1:20)

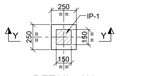


DETAIL - 'A'
(SCALE 1:20)

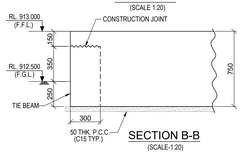



SECTION B-B
(SCALE-1:20)

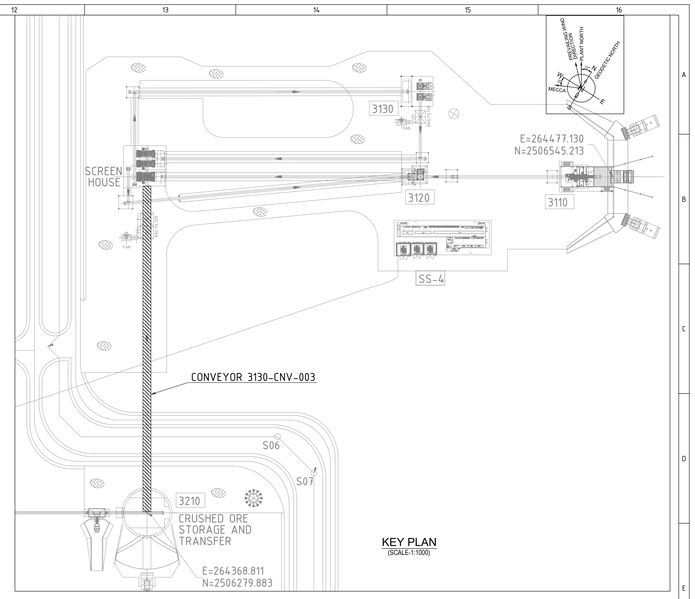



KEY PLAN
(SCALE-1:1000)

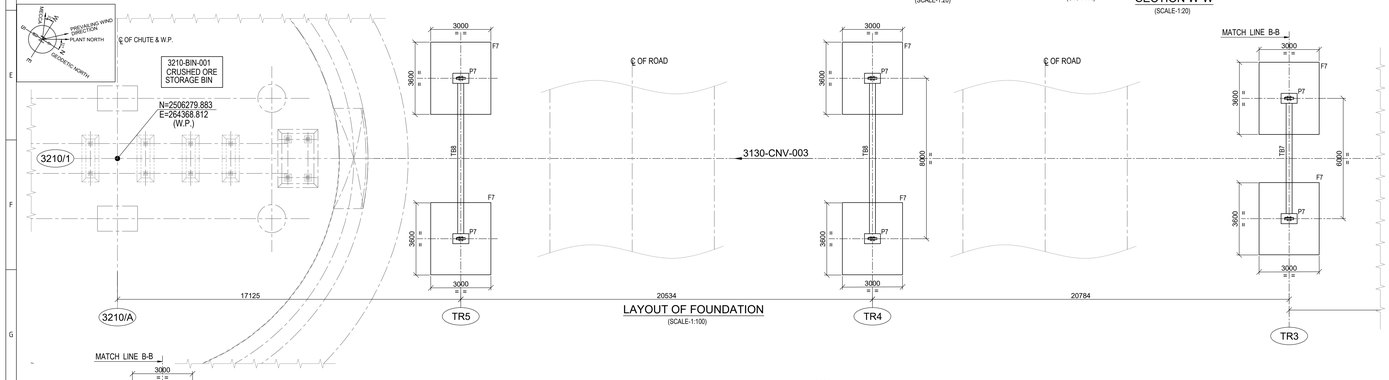

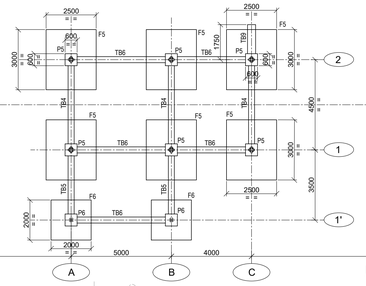


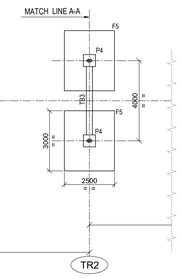

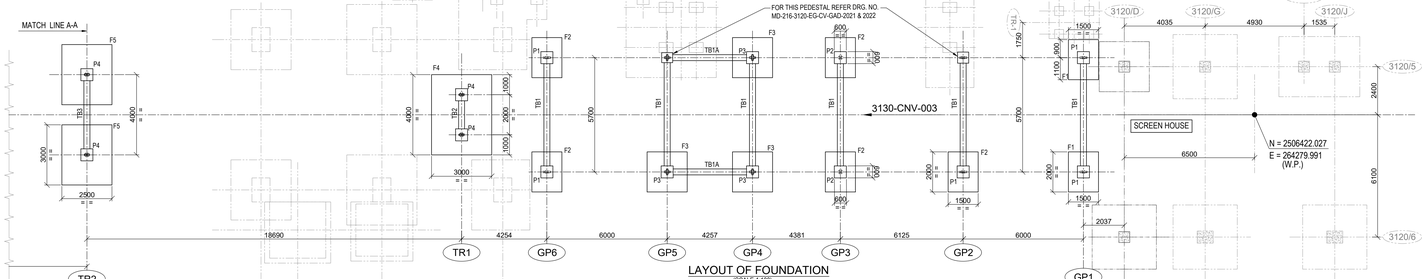


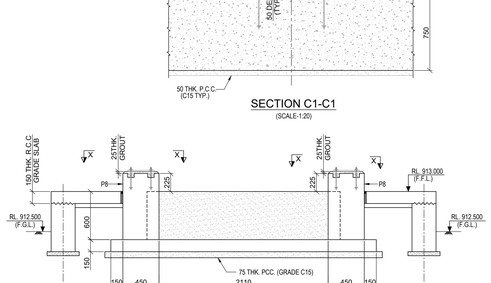

SECTION C1-C1
(SCALE-1:20)

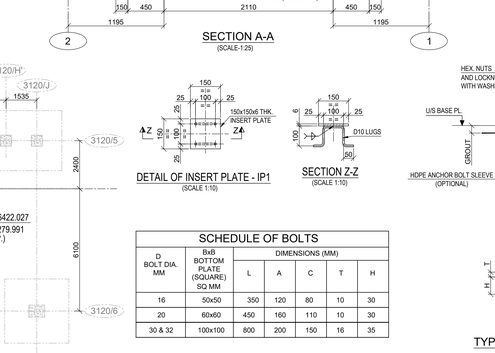


SECTION A-A
(SCALE-1:25)

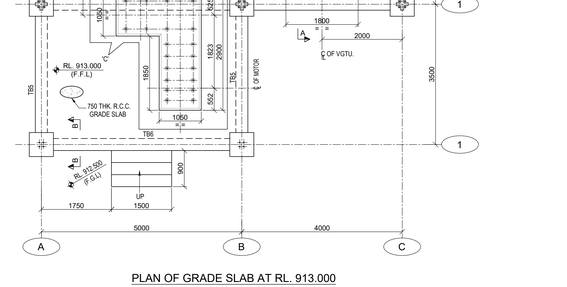

PLAN OF GRADE SLAB AT RL. 913.000 AND TIE BEAM AT RL. 912.850 (T.O.B) (FOR VGTU TOWER)
(SCALE-1:50)

DETAIL OF INSERT PLATE - IP1
(SCALE 1:10)

SECTION Z-Z
(SCALE 1:10)

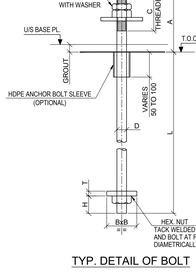

TYP. DETAIL OF BOLT

NOTES :-

1. ALL DIMENSIONS ARE IN MILLIMETRES AND LEVELS AND CO-ORDINATES ARE IN METRES. UNLESS OTHERWISE STATED.
2. GRADE OF CONCRETE SHALL BE C35 FOR FOUNDATION.
3. GRADE OF REINFORCEMENT SHALL BE DEFORMED BAR ASTM A615 - GRADE 60 (fy = 420 MPa).
4. NET SAFE BEARING CAPACITY OF SOIL AT BOTTOM OF FOUNDATION CONSIDERED 100kN/ SQ. M.
5. CLEAR COVER TO MAIN REINFORCEMENT SHALL BE AS
   a) FOUNDATION = 75 mm (BOTTOM & SIDE) 50 mm. (TOP)
   b) COLUMN & PEDESTAL = 50mm
   c) BEAM = 50mm
   d) SLAB = 40mm
6. FOR MINIMUM LAP LENGTH OF REINFORCEMENT AND OTHER GENERAL NOTES FOR CIVIL WORKS REFER STANDARD DRG : MD-216-1000-EG-CV-DED-1001
7. THIS DRAWING IS TO BE READ IN CONJUNCTION WITH DRAWING MD - 216 - 3130 -EG -ST - GAD - 1011 TO MD - 216 - 3130 -EG -ST - GAD - 1016
8. ALL STRUCTURAL WORK SHALL CONFORM TO CIVIL STRUCTURAL DESIGN CRITERIA NO. MD - 216 - 1000 -EG - ST - CRT - 1001
9. FOR OTHER STANDARD REINFORCEMENT DETAILS REFER DRG : MD-216-1000-EG-CV-DED-1005

LEGENDS :-

RL. - REDUCED LEVEL
℄ - CENTRE LINE
C/J - CONSTRUCTION JOINT
FDN. - FOUNDATION
T.O.C. - TOP OF CONCRETE.
F.G.L. - FINISHED GROUND LEVEL.
F.F.L. - FINISHED FLOOR LEVEL.
B.O.F. - BOTTOM OF FOUNDATION
TYP. - TYPICAL.
B.O.B. - BOTTOM OF BEAM.
B.O.M. - BOTTOM OF MONORAIL.
R.C.C. - REINFORCED CEMENT CONCRETE
P.C.C. - PLAIN CEMENT CONCRETE
IP. - INSERT PLATE
MKD. - MARKED.
THK. - THICK

DOCUMENT NUMBER	REFERENCE DOCUMENTS	REV	DATE	REVISION DESCRIPTION	DRN	CHK	ENG	APP	EMP
		D01	10/03/2023	AS-BUILT	HSK	SBY	RPK/APL	PRI	
		C04	29/01/2021	ISSUED FOR CONSTRUCTION & REVISED AS MKD. (C04)	HSK	SBY	RPK/APL	PRI	
		C03	12/12/2020	ISSUED FOR CONSTRUCTION & REVISED AS MKD. (C03)	HSK	SBY	RPK/APL	PRI	
MD-216-3130-EG-ME-ELV-1011	TERTIARY CRUSHING CONV.3130-CNV-003 - ELEVATION	C02	12/09/2020	ISSUED FOR CONSTRUCTION & REVISED AS MKD. (C02)	JKM	SBY	RPK/APL	PRI	
MD-216-3130-EG-ME-ELV-1010	TERTIARY CRUSHING CONV.3130-CNV-003 - ELEVATION	C01	29/05/2020	ISSUED FOR CONSTRUCTION, REVISED AS PER EMPLOYER	AMJ	SBY	RPK/APL	PRI	
MD-216-3130-EG-ME-ELV-1009	TERTIARY CRUSHING CONV.3130-CNV-003 - ELEVATION			COMMENTS DATED 26/05/2020 & REVISED AS MKD. (C01)					
MD-216-3130-EG-ME-LPX-1005	TERTIARY CRUSHING CONV.3130-CNV-003 - PLAN	A01	30/03/2020	ISSUED FOR REFERENCE	AMJ	SBY	RPK/APL	PRI	

RESERVED FOR VENDOR LOGO AND DRAWING NUMBER

LARSEN & TOUBRO

This drawing is the property of LARSEN & TOUBRO and must not be passed on to any person or body not authorized by us to receive it nor be copied or otherwise made use either in full or in part by such person or body without our prior permission in writing.

Outotec

The content of these documents are the sole property of Outotec Oyj. Any rights not expressly granted herein are reserved. Reproduction, transfer or distribution of part or all of the contents in any form without prior written permission of Outotec is prohibited.

MA'ADEN معادن
Saudi Arabian Mining Company شركة المعادن العربية السعودية

This document and the information contained herein is Ma'aden proprietary know-how. This document or any part thereof should not be reproduced, stored in a retrieval system or transmitted by any means, electronic or otherwise, or divulged without prior written permission of Ma'aden.

LARSEN & TOUBRO DRAWING NUMBER	019045_100_C_G_24056_006		REVISION 5
OUTOTEC DRAWING NUMBER	900707__GAU01__ZC01_MTL01__31359	DOCUMENT ID OU100670366	REVISION 5
DRAWN	AMJ	28/03/2020	MANSOURAH - MASSARAH GOLD PROJECT
CHECKED	SBY	29/03/2020	GENERAL ARRANGEMENT DRAWING
ENGINEER	RPK/APL	27/03/2020	GA OF CONVEYOR 3130-CNV-003
APPROVED	PRI	30/03/2020	LAYOUT & DETAIL
EMPLOYER			
SCALE	1:100,50,20,10	A0	DRAWING NUMBER MD-216-3130-EG-CV-GAD-1003 REV D01