

DRAWING NUMBER: MD-216-3130-EG-CV-GAD-1004 | REV: D01

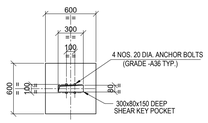

DETAIL OF PEDESTAL MKD. P1

(FOR CONVEYOR MKD. 3130-FDR-003)


(SCALE-1:25)

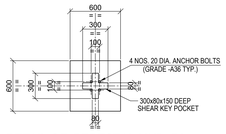

DETAIL OF PEDESTAL MKD. P2

(FOR CONVEYOR MKD. 3130-FDR-003)


(SCALE-1:25)

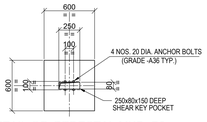


DETAIL OF PEDESTAL MKD. P3


(FOR CONVEYOR MKD. 3130-FDR-003 & 004)

(SCALE-1:25)

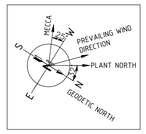

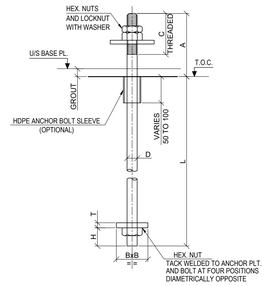


TYP. DETAIL OF BOLT

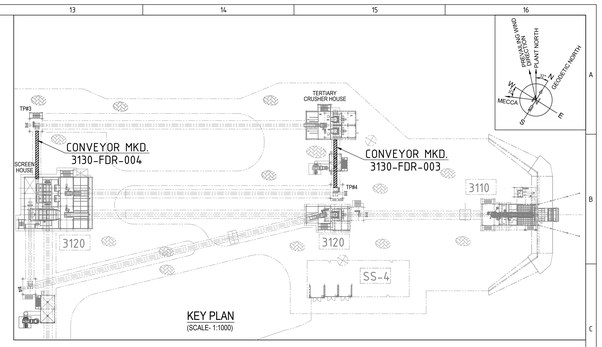

KEY PLAN

(SCALE- 1:1000)


SCHEDULE OF BOLTS						
⌀ BOLT DIA. MM	BxB BOTTOM PLATE (SQUARE) SQ MM	DIMENSIONS (MM)				
		L	A	C	T	H
20	60x60	450	160	130	10	30

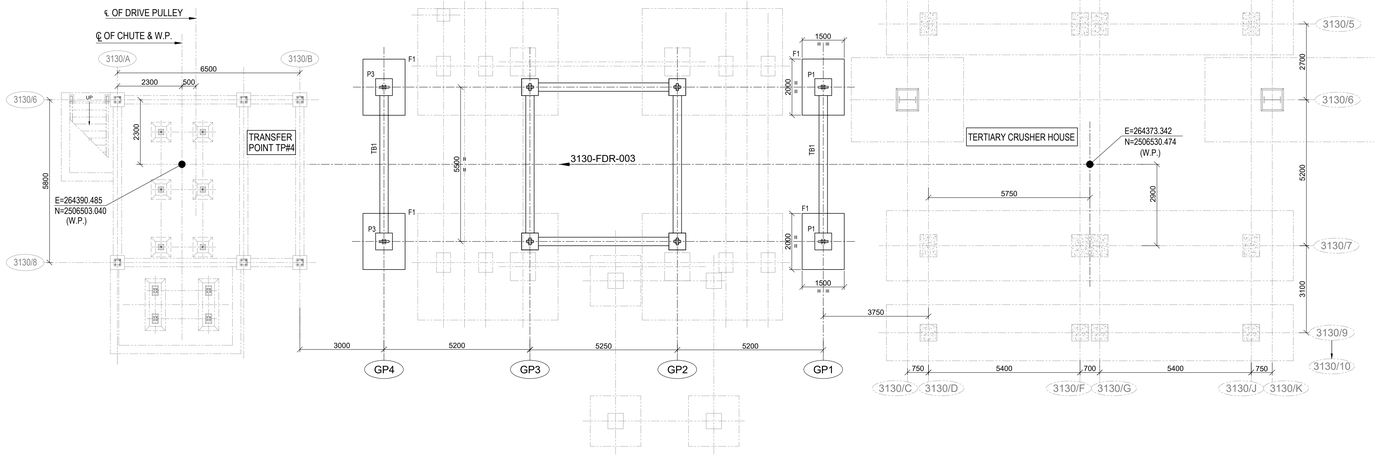

LAYOUT OF FOUNDATION AND TIE BEAM FOR CONVEYOR MKD. 3130-FDR-003


(SCALE-1:75)

SCHEDULE OF BEAM			
BEAM MKD.	SIZE		LEVEL
	WIDTH (mm.)	DEPTH (mm.)	
TB1	300	500	RL. 912.500 (T.O.B.)
TB2	300	400	RL. 912.500 (T.O.B.)
TB3	300	500	RL. 912.500 (T.O.B.)

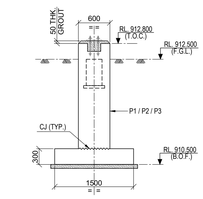


SECTION 1-1

(SCALE-1:40)

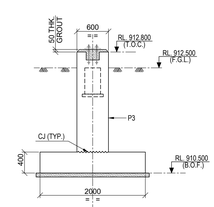

SECTION 2-2


(SCALE-1:40)

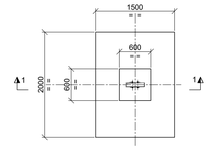

DETAIL OF FOUNDATION MKD. F1

(FOR CONVEYOR MKD. 3130-FDR-003)


(SCALE-1:40)

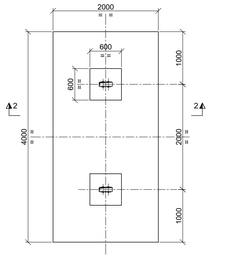

DETAIL OF FOUNDATION MKD. F2

(FOR CONVEYOR MKD. 3130-FDR-004)

(SCALE-1:40)

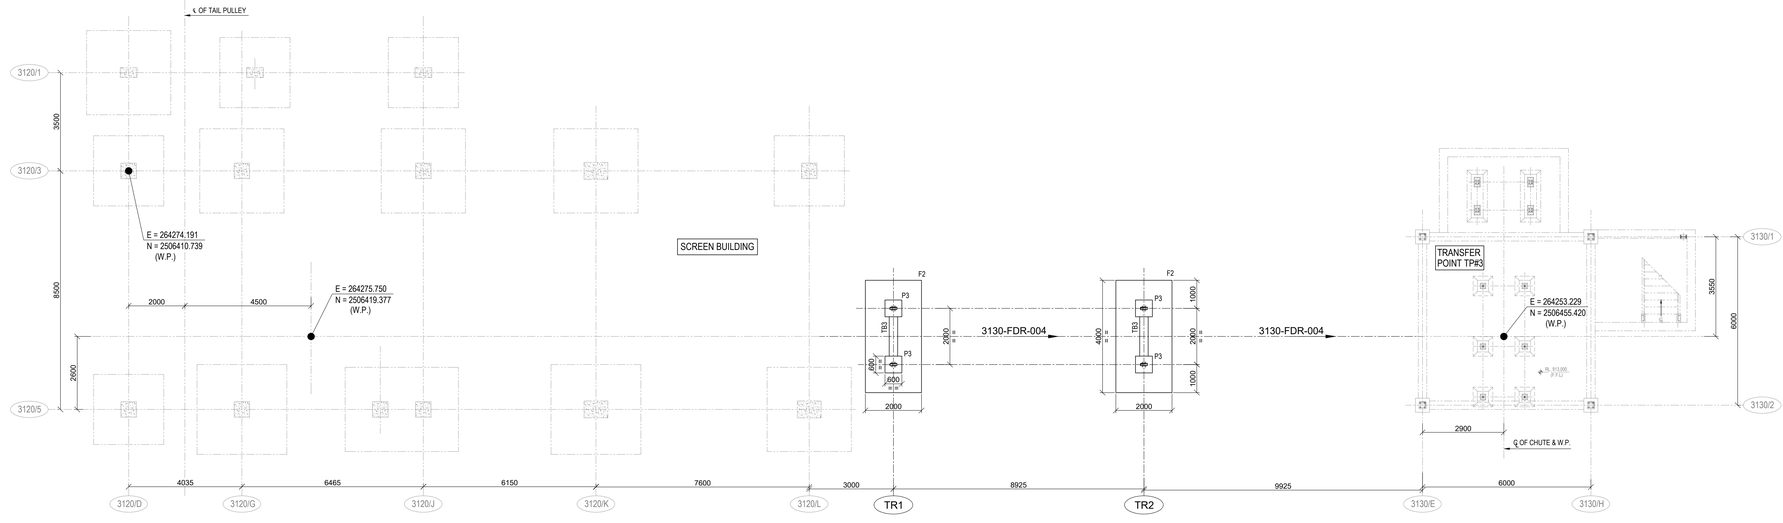

LAYOUT OF FOUNDATION AND TIE BEAM FOR CONVEYOR MKD. 3130-FDR-004

(SCALE-1:75)

LEGEND :-

R.L. - REDUCED LEVEL
℄ - CENTRE LINE
CJ - CONSTRUCTION JOINT
FDN. - FOUNDATION.
T.O.C. - TOP OF CONCRETE.
F.G.L. - FINISHED GROUND LEVEL.
F.F.L. - FINISHED FLOOR LEVEL.
B.O.F. - BOTTOM OF FOUNDATION
TYP. - TYPICAL.
B.O.B. - BOTTOM OF BEAM.
B.O.M. - BOTTOM OF MONORAIL.
R.C.C. - REINFORCED CEMENT CONCRETE
P.C.C. - PLAIN CEMENT CONCRETE
IP. - INSERT PLATE
MKD. - MARKED.
THK. - THICK

NOTES :-

1. ALL DIMENSIONS ARE IN MILLIMETRES AND LEVELS AND CO-ORDINATES ARE IN METRES. UNLESS OTHERWISE STATED.
2. GRADE OF CONCRETE SHALL BE C35 FOR FOUNDATION.
3. GRADE OF REINFORCEMENT SHALL BE DEFORMED BAR ASTM A615 - GRADE 60 (fy = 420 MPa).
4. NET SAFE BEARING CAPACITY OF SOIL AT BOTTOM OF FOUNDATION CONSIDERED 500KN/ SQ. M.
5. CLEAR COVER TO MAIN REINFORCEMENT SHALL BE AS
   a) FOUNDATION = 75 mm (BOTTOM & SIDE) 50 mm. (TOP)
   b) COLUMN & PEDESTAL = 50mm
   c) BEAM = 50mm
   d) SLAB = 40mm
6. FOR MINIMUM LAP LENGTH OF REINFORCEMENT AND OTHER GENERAL NOTES FOR CIVIL WORKS REFER STANDARD DRG : MD-216-1000-EG-CV-DED-1001
7. THIS DRAWING IS TO BE READ IN CONJUNCTION WITH DRAWING MD - 216 - 3130 -EG -ST - GAD - 1017 TO MD - 216 - 3130 -EG -ST - GAD - 1019.
8. ALL STRUCTURAL WORK SHALL CONFORM TO CIVIL STRUCTURAL DESIGN CRITERIA NO. MD - 216 - 1000 -EG -ST - CRT - 1001
9. FOR OTHER STANDARD REINFORCEMENT DETAILS REFER DRG : MD-216-1000-EG-CV-DED-1005

DOCUMENT NUMBER	REFERENCE DOCUMENTS	REV	DATE	REVISION DESCRIPTION	DRN	CHK	ENG	APP	EMP
MD-216-3130-EG-ME-ELV-1015	TERTIARY CRUSHING FEEDER 3130-FDR-004-ELEVATION	D01	10/03/2023	AS-BUILT	JKM	SBY	APL	PRI	
MD-216-3130-EG-ME-LPX-1008	TERTIARY CRUSHING FEEDER 3130-FDR-004-PLAN	C02	07/09/2020	ISSUED FOR CONSTRUCTION & REVISED AS MKD. (2A)	JKM	SBY	APL	PRI	
MD-216-3110-EG-ME-ELV-1013	TERTIARY CRUSHING FEEDER 3130-FDR-003-ELEVATION	C01	29/04/2020	ISSUED FOR CONSTRUCTION, REVISED AS PER EMPLOYER	AMJ	SBY	APL	PRI	
MD-216-3130-EG-ME-LPX-1007	TERTIARY CRUSHING FEEDER 3130-FDR-003-PLAN			COMMENTS DATED 27/04/2020 & REVISED AS MKD. (1A)					
		A01	04/04/2020	ISSUED FOR REFERENCE	AMJ	SBY	APL	PRI	

RESERVED FOR VENDOR LOGO AND DRAWING NUMBER

LARSEN & TOUBRO

This drawing is the property of LARSEN & TOUBRO and must not be passed on to any person or body not authorised by us to receive it nor be copied or otherwise made use either in full or in part by such person or body without our prior permission in writing.

Outotec

The content of these documents are the sole property of Outotec Oyj. Any rights not expressly granted herein are reserved. Reproduction, transfer or distribution of part or all of the contents in any form without prior written permission of Outotec is prohibited.

MA'ADEN معادن — Saudi Arabian Mining Company — شركة المعادن العربية السعودية

This document and the information contained herein is Ma'aden proprietary know-how. This document or any part thereof should not be reproduced, stored in a retrieval system or transmitted by any means, electronic or otherwise, or divulged without prior written permission of Ma'aden.

LARSEN & TOUBRO DRAWING NUMBER	019045_100_C_G_24056_007		REVISION 3
OUTOTEC DRAWING NUMBER	900707 _ GAU01 _ ZC01 _ MTL01 _ 31360	DOCUMENT ID OU100670367	REVISION 3
DRAWN	AMJ	02/04/2020	
CHECKED	SBY	03/04/2020	
ENGINEER	APL	01/04/2020	
APPROVED	PRI	04/04/2020	
EMPLOYER			
SCALE	1:100,50,20,10	A0	

MANSOURAH - MASSARAH GOLD PROJECT
GENERAL ARRANGEMENT DRAWING
GA OF CONVEYORS 3130-FDR-003 & FDR-004
LAYOUT & DETAIL

DRAWING NUMBER: MD - 216 - 3130 - EG - CV - GAD - 1004 | REV: D01