




SECTION A-A
(SCALE 1:10)

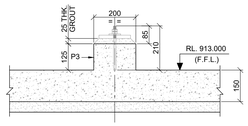


SECTION B-B
(SCALE 1:10)

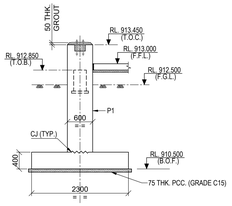


SECTION 1-1
(SCALE-1:50)

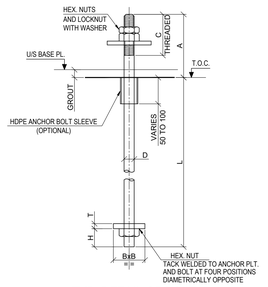


TYP. DETAIL OF BOLT

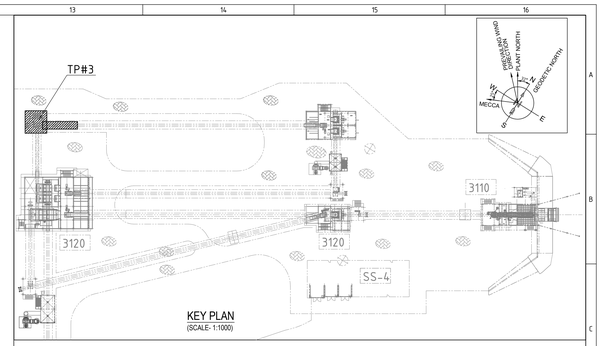


KEY PLAN
(SCALE- 1:1000)

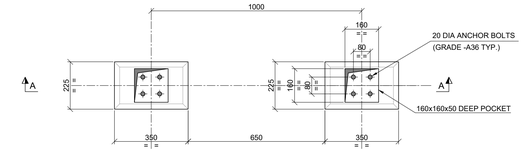

DETAIL OF PEDESTAL MKD. P2
(SCALE 1:10)

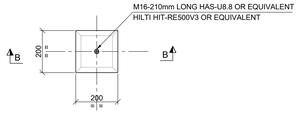


DETAIL OF PEDESTAL MKD. P3
(SCALE 1:10)

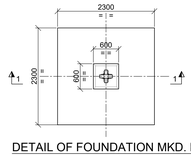


DETAIL OF FOUNDATION MKD. F1
(SCALE-1:50)

SCHEDULE OF BOLTS


D BOLT DIA. MM	BxB BOTTOM PLATE (SQUARE) SQ MM	DIMENSIONS (MM)				
		L	A	C	T	H
20	60x60	450	160	130	10	30

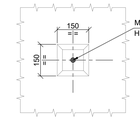


VIEW X-X
(SCALE 1:10)

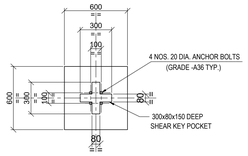


DETAIL OF PEDESTAL MKD. P1
(SCALE-1:20)

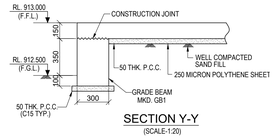


SECTION Y-Y
(SCALE-1:20)

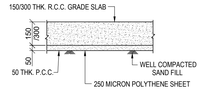

TYP. DETAIL OF GRADE SLAB
SCALE 1:20

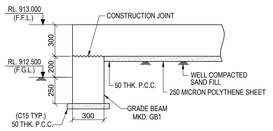


SECTION D-D
(SCALE-1:20)

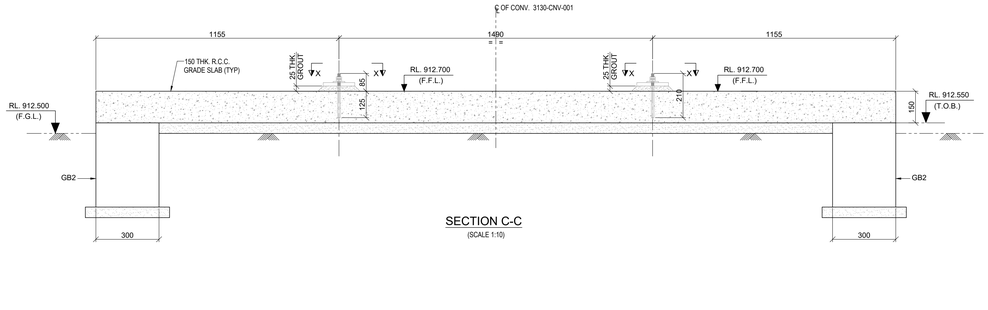


SECTION C-C
(SCALE 1:10)


SCHEDULE OF BEAM

BEAM MKD.	SIZE		LEVEL
	WIDTH (mm.)	DEPTH (mm.)	
TB1	300	500	RL. 912.850 (T.O.B.)
GB1	300	450	RL. 912.850 (T.O.B.) RL. 912.700 (T.O.B.)
GB2	300	400	RL. 912.550 (T.O.B.)

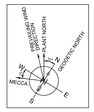

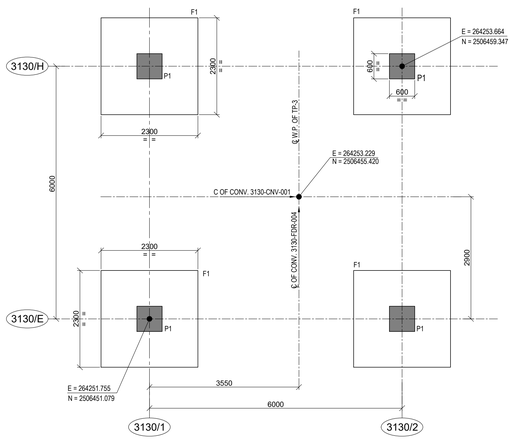

LAYOUT OF FOUNDATION AT RL. 910.500 (B.O.F)
(SCALE-1:50)

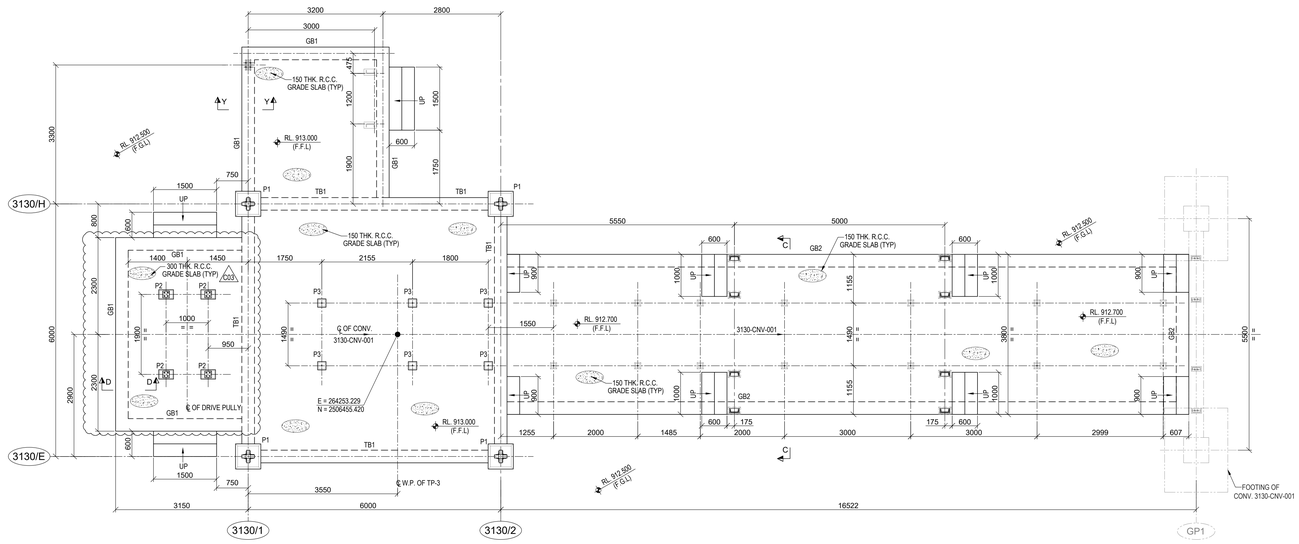

PLAN OF GRADE SLAB AT RL. 913.000 (F.F.L) AND 912.700 (F.F.L)
(SCALE-1:50)

LEGENDS :-

R.L. - REDUCED LEVEL
℄ - CENTRE LINE
C/J - CONSTRUCTION JOINT
FDN. - FOUNDATION
T.O.C. - TOP OF CONCRETE.
F.G.L. - FINISHED GROUND LEVEL.
F.F.L. - FINISHED FLOOR LEVEL.
B.O.F. - BOTTOM OF FOUNDATION

B.O.B. - BOTTOM OF BEAM.
B.O.M. - BOTTOM OF MONORAIL.
R.C.C - REINFORCED CEMENT CONCRETE
P.C.C - PLAIN CEMENT CONCRETE
'P' - INSERT PLATE

NOTES :-

1. ALL DIMENSIONS ARE IN MILLIMETRES AND LEVELS AND CO-ORDINATES ARE IN METRES. UNLESS OTHERWISE STATED.
2. GRADE OF CONCRETE SHALL BE C35 FOR FOUNDATION.
3. GRADE OF REINFORCEMENT SHALL BE DEFORMED BAR ASTM A615 - GRADE 60 (fy = 420 MPa).
4. NET SAFE BEARING CAPACITY OF SOIL AT BOTTOM OF FOUNDATION CONSIDERED 500KN/ SQ. M.
5. CLEAR COVER TO MAIN REINFORCEMENT SHALL BE AS
   a) FOUNDATION = 75 mm (BOTTOM & SIDE) 50 mm. (TOP)
   b) COLUMN & PEDESTAL = 50mm
   c) BEAM = 50mm
   d) SLAB = 40mm
6. FOR MINIMUM LAP LENGTH OF REINFORCEMENT REFER STANDARD DRG : MD-216-1000-EG-CV-DED-1001
7. THIS DRAWING IS TO BE READ IN CONJUNCTION WITH DRAWING
   MD - 216 - 3130 -EG -ST - GAD - 1024 & MD - 216 - 3130 -EG -ST - GAD - 1025
8. ALL STRUCTURAL WORK SHALL CONFORM TO CIVIL STRUCTURAL DESIGN CRITERIA NO.: MD - 216 - 1000-EG -ST - CRT - 1001
9. FOR OTHER STANDARD REINFORCEMENT DETAILS REFER DRG : MD-216-1000-EG-CV-DED-1005

DOCUMENT NUMBER	REFERENCE DOCUMENTS	REV	DATE	REVISION DESCRIPTION	DRN	CHK	ENG	APP	EMP
		D01	10/03/2023	AS-BUILT	JKM	SBY	RPK	PRI	
		C03	28/01/2021	ISSUED FOR CONSTRUCTION & REVISED AS MKD. C03	JKM	SBY	RPK	PRI	
		C02	17/12/2020	ISSUED FOR CONSTRUCTION & REVISED AS MKD. C02	HSK	SBY	RPK	PRI	
		C01	11/05/2020	ISSUED FOR CONSTRUCTION, REVISED AS PER EMPLOYER	AMJ	SBY	RPK	PRI	
MD-216-3130-EG-ME-ELV-1020	TERTIARY CRUSHING TRANSFER POINT TP#3 - ELEVATION			COMMENTS DATED 05/05/2020 & REVISED AS MKD. C01					
MD-216-3130-EG-ME-LPX-1015	TERTIARY CRUSHING TRANSFER POINT TP#3 - PLAN VIEW	A01	10/04/2020	ISSUED FOR REFERENCE	AMJ	SBY	RPK	PRI	

RESERVED FOR VENDOR LOGO AND DRAWING NUMBER

LARSEN & TOUBRO

This drawing is the property of LARSEN & TOUBRO and must not be passed on to any person or body not authorised by us to receive it nor be copied or otherwise made use either in full or in part by such person or body without our prior permission in writing.

Outotec

The content of these documents are the sole property of Outotec Oyj. Any rights not expressly granted herein are reserved. Reproduction, transfer or distribution of part or all of the contents in any form without prior written permission of Outotec is prohibited.

MA'ADEN معادن
Saudi Arabian Mining Company شركة المعادن العربية السعودية

This document and the information contained herein is Ma'aden proprietary know-how. This document or any part thereof should not be reproduced, stored in a retrieval system or transmitted by any means, electronic or otherwise, or divulged without prior written permission of Ma'aden.

LARSEN & TOUBRO DRAWING NUMBER: 019045_100_C_G_24108_001 — REVISION: 4
OUTOTEC DRAWING NUMBER: 900707__GAU01__ZC01__MTL01__31301 — DOCUMENT ID: OU100668045 — REVISION: 4

DRAWN	AMJ	08/04/2020
CHECKED	SBY	09/04/2020
ENGINEER	RPK	07/04/2020
APPROVED	PRI	10/04/2020
EMPLOYER		
SCALE	1:100,50,25,20,10	A0

MANSOURAH - MASSARAH GOLD PROJECT
GENERAL ARRANGEMENT DRAWING
GA OF TP - 3 (3130 CNV-001)
LAYOUT & DETAIL

DRAWING NUMBER: MD - 216 - 3130 - EG - CV - GAD - 1005 — REV: D01