

DRAWING NUMBER: MD-216-3130-EG-CV-GAD-1007 REV D01

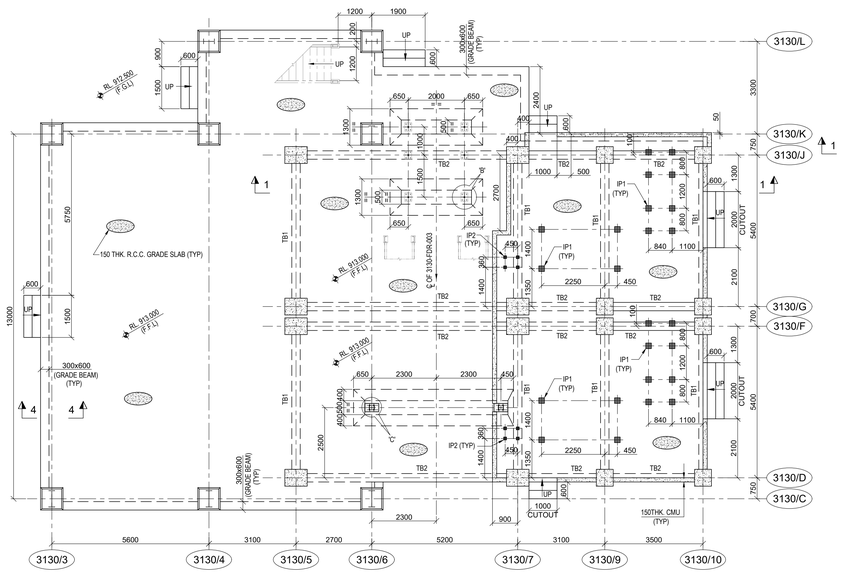


PLAN OF GRADE SLAB AT RL.913.000 (F.F.L) AND TIE BEAM AT RL. 912.850 (T.O.B)


(SCALE - 1:75)

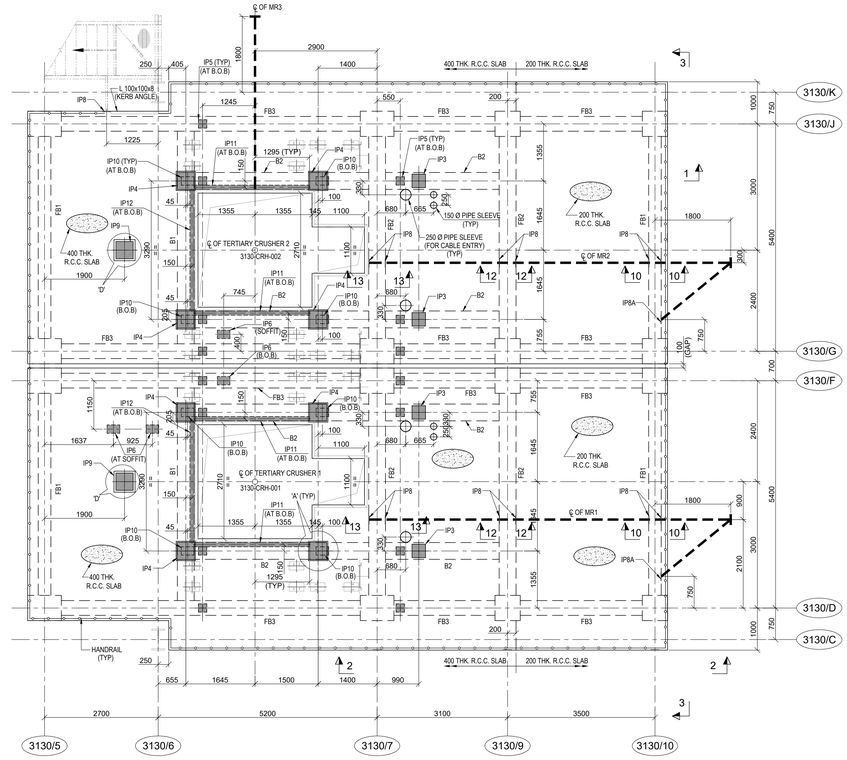

PLAN AT RL. 919.000 (T.O.C)


(SCALE - 1:50)

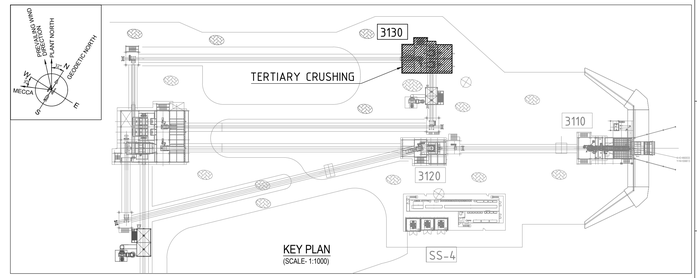

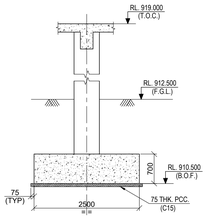


SECTION A-A

(SCALE - 1:50)

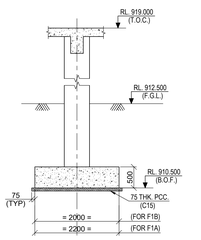


SECTION B-B

(SCALE - 1:50)

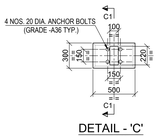

DETAIL - 'C'

(SCALE-1:25)

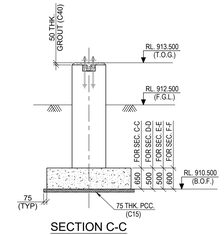


SECTION C-C
SECTION D-D
SECTION E-E
SECTION F-F

(SCALE - 1:50)


SCHEDULE OF BEAM

BEAM MKD.	SIZE WIDTH (mm.)	SIZE DEPTH (mm.)	LEVEL
TB1	300	500	RL +912.850 (T.O.B.)
TB2	300	550	
FB1	300	600	RL +919.000 (T.O.C.)
FB2	400	900	
FB3	350	1100	
B1	400	900	
B2	400	800	

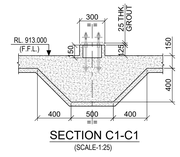


SECTION C1-C1

(SCALE-1:25)

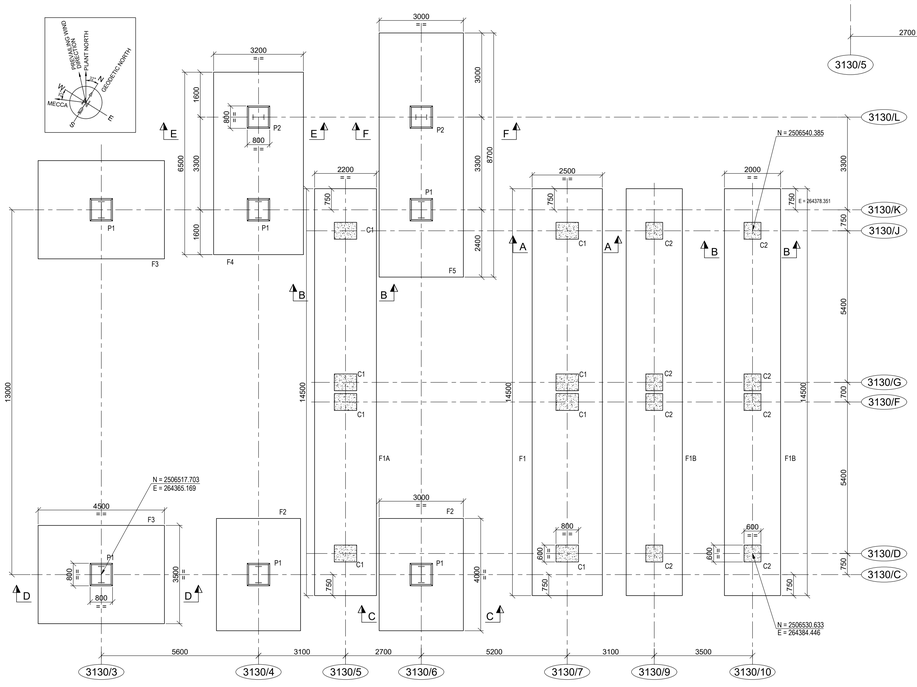


LAYOUT OF FOUNDATION AT RL. 910.500 (B.O.F)

(SCALE - 1:75)

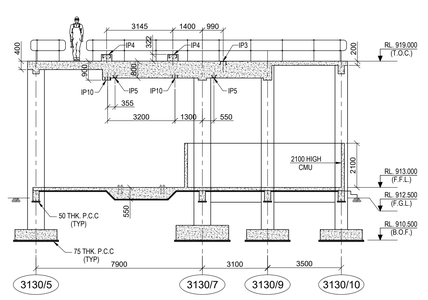


SECTION 1-1

(SCALE - 1:100)

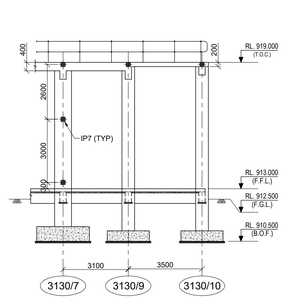


SECTION 2-2

(SCALE - 1:100)

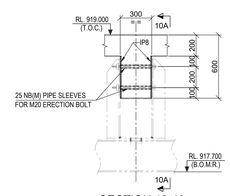


SECTION 10-10

(SCALE-1:20)

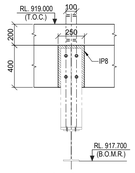


SECTION 10A-10A

(SCALE-1:20)

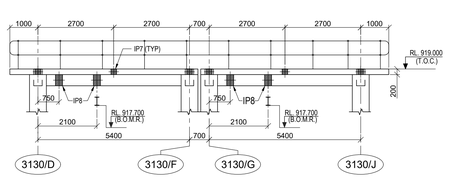


SECTION 3-3

(SCALE - 1:75)

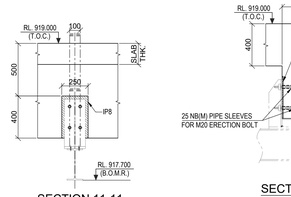


SECTION 11-11

(SCALE-1:20)

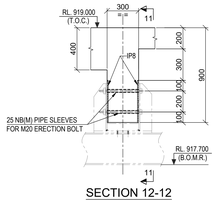

SECTION 12-12

(SCALE-1:20)

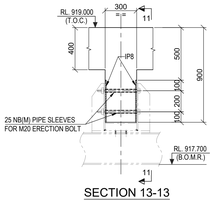

SECTION 13-13

(SCALE-1:20)

LEGENDS :-

RL - REDUCED LEVEL
℄ - CENTRE LINE
T.O.C. - TOP OF CONCRETE.
F.G.L. - FINISHED GROUND LEVEL.
B.O.F. - BOTTOM OF FOUNDATION
B.O.B. - BOTTOM OF BEAM
TYP. - TYPICAL.
R.C.C - REINFORCED CEMENT CONCRETE
P.C.C - PLAIN CEMENT CONCRETE
MKD. - MARKED
THK. - THICK
MR. - MONORAIL
B.O.M.R. - BOTTOM OF MONORAIL
SEC. - SECTION
IP - INSERT PLATE
MM - MILLIMETER
SQ. - SQUARE
CMU - CONCRETE MASONRY UNIT

NOTES :-

1. ALL DIMENSIONS ARE IN MILLIMETRES AND LEVELS AND CO-ORDINATES ARE IN METRES. UNLESS OTHERWISE STATED.
2. GRADE OF CONCRETE SHALL BE C35 FOR FOUNDATION.
3. GRADE OF REINFORCEMENT SHALL BE DEFORMED BAR ASTM A615 - GRADE 60 (fy = 420 MPa).
4. NET SAFE BEARING CAPACITY OF SOIL AT BOTTOM OF FOUNDATION CONSIDERED 500KN/SQ. M.
5. CLEAR COVER TO MAIN REINFORCEMENT SHALL BE AS
   a) FOUNDATION = 75mm (BOTTOM & SIDE) 50 mm (TOP)
   b) TIE BEAM = 50 mm c) COLUMN = 50mm d) BEAM = 50mm e) SLAB = 40mm
6. FOR MINIMUM LAP LENGTH OF REINFORCEMENT REFER STANDARD DRAWING NO. MD-216-1000-EG-CV-DED-1001
7. THIS DRG. SHALL BE READ IN CONJUNCTION WITH DRG. NO. MD-216-3130-EG-CV-GAD-1008 & MD-216-3130-EG-CV-DED-1007
8. FOR DETAIL OF HANDRAIL FIXING REFER STANDARD DRAWING.

DOCUMENT NUMBER	REFERENCE DOCUMENTS	REV	DATE	REVISION DESCRIPTION	DRN	CHK	ENG	APP	EMP
MD-216-3130-EG-ME-LPX-1009	TERTIARY CRUSHER HOUSE-PLAN VIEW	D01	10/03/2023	AS-BUILT	HSK	SBY	RPK	AG	
MD-216-3130-EG-ME-LPX-1010	TERTIARY CRUSHER HOUSE-PLAN VIEW	C03	17/02/2021	ISSUED FOR CONSTRUCTION & REVISED AS MKD. C03	HSK	SBY	RPK	AG	
MD-216-3130-EG-ME-LPX-1012	TERTIARY CRUSHER HOUSE-PLAN VIEW	C02	21/08/2020	ISSUED FOR CONSTRUCTION & REVISED AS MKD. C02	HSK	SBY	RPK	AG	
MD-216-3130-EG-ME-LPX-1013	TERTIARY CRUSHER HOUSE-PLAN VIEW	C01	09/04/2020	ISSUED FOR CONSTRUCTION, REVISED AS PER EMPLOYER					
MD-216-3130-EG-ME-LPX-1014	TERTIARY CRUSHER HOUSE-PLAN VIEW			COMMENTS DATED 04/04/2020 & REVISED AS MKD. C01	HSK	SBY	RPK	AG	
MD-216-3130-EG-ME-ELV-1017	TERTIARY CRUSHER HOUSE-ELEVATION	A02	12/03/2020	REVISED AS PER EMPLOYER COMMENTS ON 26/02/2020	HSK	SBY	RPK	AG	
MD-216-3130-EG-ME-ELV-1018	TERTIARY CRUSHER HOUSE-ELEVATION	A01	27/01/2020	ISSUED OF REFERENCE	HSK	SBY	RPK	AG	

RESERVED FOR VENDOR LOGO AND DRAWING NUMBER

LARSEN & TOUBRO

This drawing is the property of LARSEN & TOUBRO and must not be passed on to any person or body not authorised by us to receive it nor be copied or otherwise made use either in full or in part by such person or body without our prior permission in writing.

Outotec

The content of these documents are the sole property of Outotec Oyj. Any rights not expressly granted herein are reserved. Reproduction, transfer or distribution of part or all of the contents in any form without prior written permission of Outotec is prohibited.

MA'ADEN معادن Saudi Arabian Mining Company شركة معادن العربية السعودية

This document and the information contained herein is Ma'aden proprietary know-how. This document or any part thereof should not be reproduced, stored in a retrieval system or transmitted by any means, electronic or otherwise, or divulged without prior written permission of Ma'aden.

LARSEN & TOUBRO DRAWING NUMBER: 019045_100_C_G_24065_001 — REVISION: 5
OUTOTEC DRAWING NUMBER: 900707__GAU01__ZC01__MTL01__31372 — DOCUMENT ID: OU100670454 — REVISION: 5

DRAWN	HSK	10/01/2020
CHECKED	SBY	21/01/2020
ENGINEER	RPK	20/01/2020
APPROVED	AG	27/01/2020
EMPLOYER		

MANSOURAH - MASSARAH GOLD PROJECT
GENERAL ARRANGEMENT DRAWING
TERTIARY CRUSHING
LAYOUT & DETAIL

SCALE: 1:100,1:75,1:50,1:25,1:20,1:10 — A0

DRAWING NUMBER: MD-216-3130-EG-CV-GAD-1007 — REV: D01