

DRAWING NUMBER: MD-216-3130-EG-CV-GAD-1009 | REV: D01




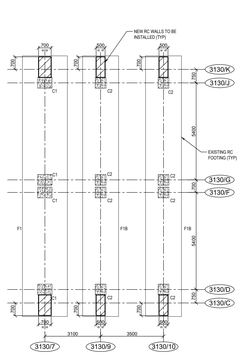


PART LAYOUT OF FOUNDATION AT RL. 910.500 (B.O.F) AND NEW RC WALLS
(SCALE - 1:75)

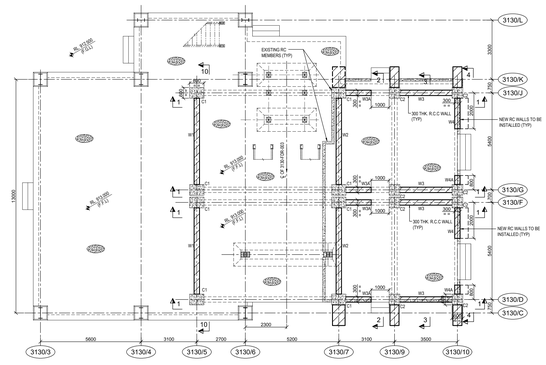


PLAN OF GRADE SLAB AT RL 913.000 (F.F.L), TIE BEAM AT RL. 912.850 (T.O.B) AND NEW RC WALL
(SCALE - 1:75)

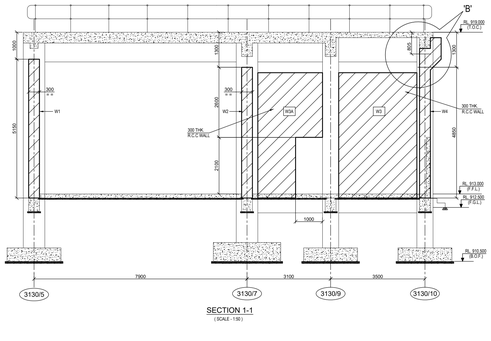


SECTION 1-1
(SCALE - 1:50)

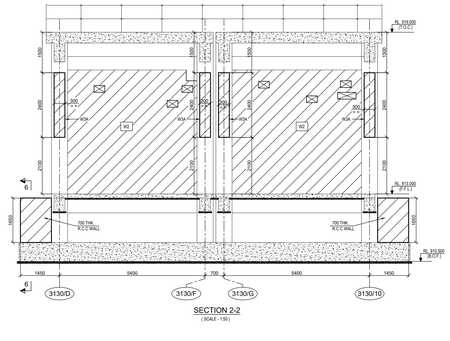


SECTION 2-2
(SCALE - 1:50)

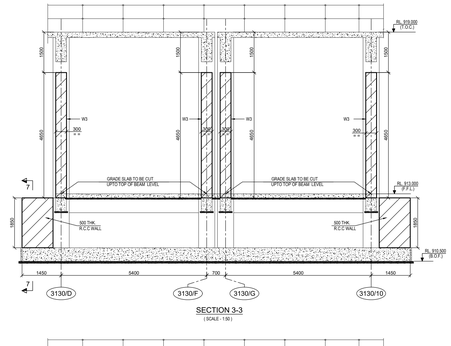


SECTION 3-3
(SCALE - 1:50)

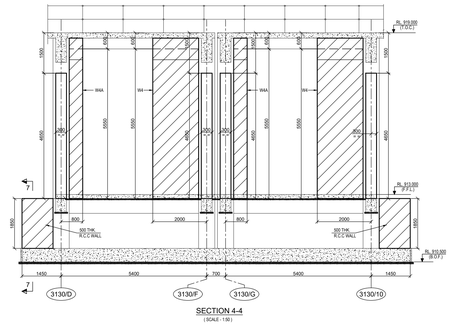


SECTION 4-4
(SCALE - 1:50)

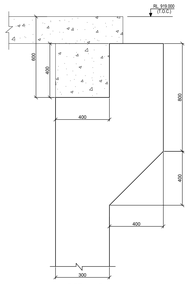

DETAIL- B
(SCALE-1:10)

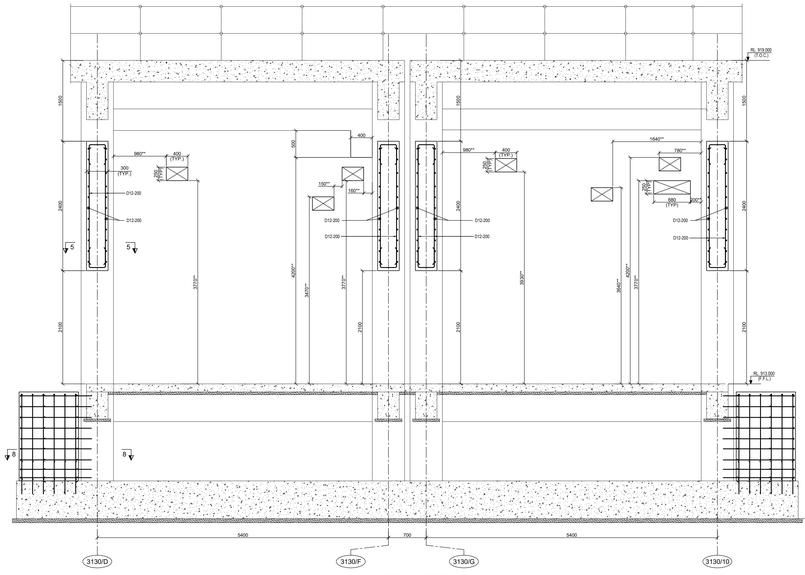


R.C.C DETAIL OF SECTION 2-2
(SCALE - 1:25)

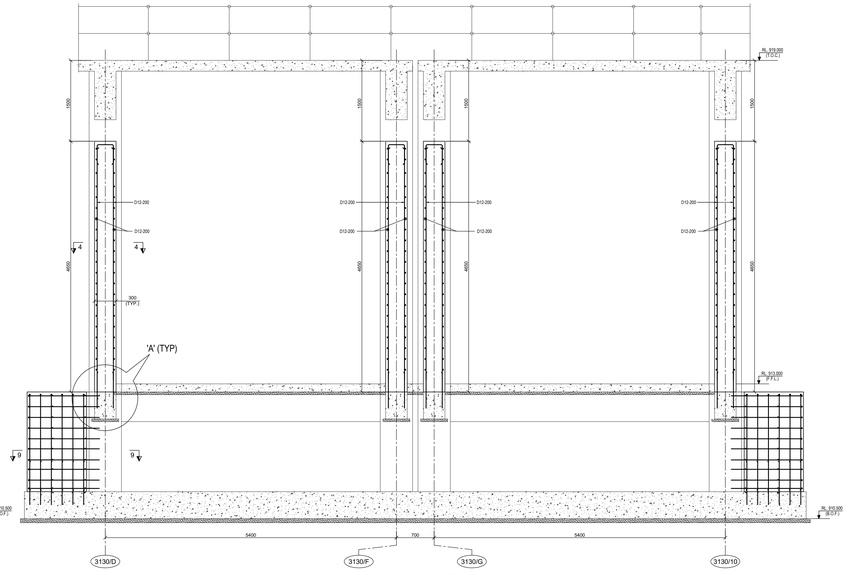


R.C.C DETAIL OF SECTION 3-3
(SCALE - 1:25)


- 200 MM. LONG 15 MM. DIA DRILLED HOLE.
- 12 MM. DIA REBAR INSERTED IN HOLE. MINIMUM (Ld) PROJECTION FOR REBAR LAPPING.
- HOLE GROUTED WITH ANCHORING CHEMICAL (AS PER MANUFACTURER'S SPECIFICATION).

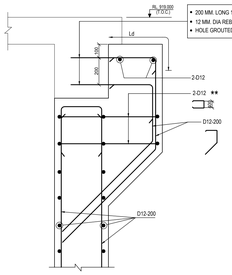

DETAIL-B
(R.C.C DETAILS)
(2 NOS FOR 4A & 8 NOS FOR 4)
(SCALE-1:10)

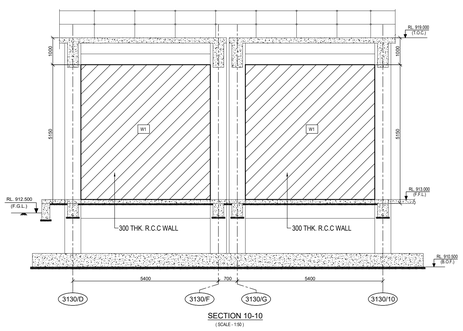


SECTION 10-10
(SCALE - 1:50)

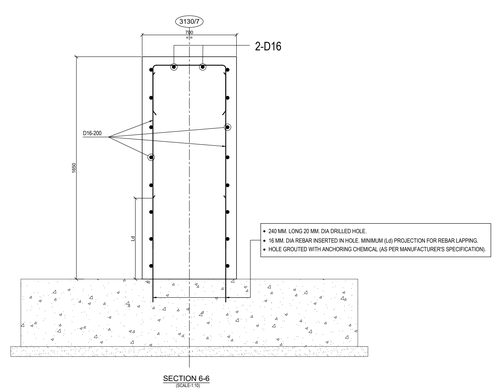

- 240 MM. LONG 20 MM. DIA DRILLED HOLE.
- 16 MM. DIA REBAR INSERTED IN HOLE. MINIMUM (Ld) PROJECTION FOR REBAR LAPPING.
- HOLE GROUTED WITH ANCHORING CHEMICAL (AS PER MANUFACTURER'S SPECIFICATION).


SECTION 6-6
(SCALE-1:10)

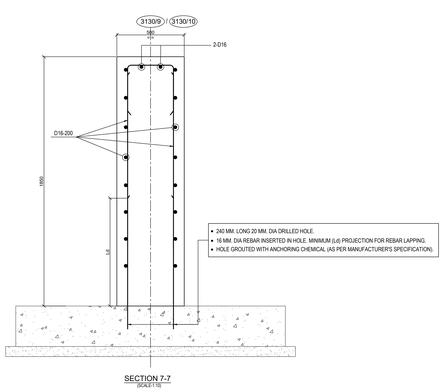

- 240 MM. LONG 20 MM. DIA DRILLED HOLE.
- 16 MM. DIA REBAR INSERTED IN HOLE. MINIMUM (Ld) PROJECTION FOR REBAR LAPPING.
- HOLE GROUTED WITH ANCHORING CHEMICAL (AS PER MANUFACTURER'S SPECIFICATION).


SECTION 7-7
(SCALE-1:10)

- 240 MM. LONG 20 MM. DIA DRILLED HOLE.
- 16 MM. DIA REBAR INSERTED IN HOLE. MINIMUM (Ld) PROJECTION FOR REBAR LAPPING.
- HOLE GROUTED WITH ANCHORING CHEMICAL (AS PER MANUFACTURER'S SPECIFICATION).

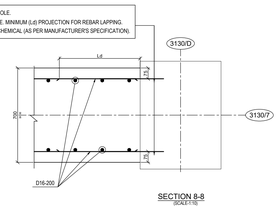


(SCALE-1:10)

- 240 MM. LONG 20 MM. DIA DRILLED HOLE.
- 16 MM. DIA REBAR INSERTED IN HOLE. MINIMUM (Ld) PROJECTION FOR REBAR LAPPING.
- HOLE GROUTED WITH ANCHORING CHEMICAL (AS PER MANUFACTURER'S SPECIFICATION).

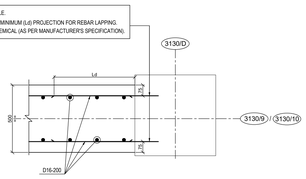


SECTION 9-9
(SCALE-1:10)

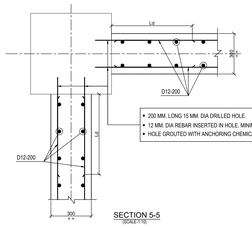

SECTION 5-5
(SCALE-1:10)

- 200 MM. LONG 15 MM. DIA DRILLED HOLE.
- 12 MM. DIA REBAR INSERTED IN HOLE. MINIMUM (Ld) PROJECTION FOR REBAR LAPPING.
- HOLE GROUTED WITH ANCHORING CHEMICAL (AS PER MANUFACTURER'S SPECIFICATION).

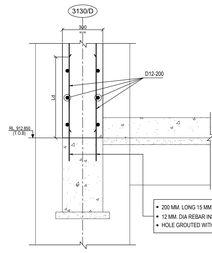

DETAIL-A
(SCALE-1:10)

- 200 MM. LONG 15 MM. DIA DRILLED HOLE.
- 12 MM. DIA REBAR INSERTED IN HOLE. MINIMUM (Ld) PROJECTION FOR REBAR LAPPING.
- HOLE GROUTED WITH ANCHORING CHEMICAL (AS PER MANUFACTURER'S SPECIFICATION).

WALL MARK	WALL TOP LEVEL
W1	RL. 918.000
W2	RL. 917.700
W3	RL. 917.500
W3A	RL. 917.500
W4	RL. 918.400
W4A	RL. 918.400

LEGENDS :-
RL :- REDUCED LEVEL
T.O.C :- TOP OF CONCRETE
F.G.L :- FINISHED GROUND LEVEL
F.F.L :- FINISHED FLOOR LEVEL
B.O.F :- BOTTOM OF FOUNDATION
TYP :- TYPICAL
R.C.C :- REINFORCED CEMENT CONCRETE
NEW WALL CONSTRUCTION

NOTES :-
1. ALL DIMENSIONS ARE IN MILLIMETRES AND LEVELS ARE IN METRES.
2. GRADE OF CONCRETE SHALL BE C35 FOR WALL.
3. GRADE OF REINFORCEMENT SHALL BE DEFORMED BAR ASTM A615 - GRADE 60 (fy = 420 MPa).
4. QUICK SETTING ADMIXTURE SHALL BE USED FOR REDUCING THE SETTING TIME OF THE CONCRETE.
5. CLEAR COVER TO MAIN REINFORCEMENT FOR WALL SHALL BE 40 MM ABOVE F.G.L & 75 MM BELOW F.G.L.
6. MINIMUM LAP LENGTH OF REINFORCEMENT SHALL BE 40 X DIA. OF BAR.
7. DO NOT SCALE. PLEASE ASK.

DOCUMENT NUMBER	REFERENCE DOCUMENTS	REV	DATE	REVISION DESCRIPTION	DRN	CHK	ENG	APP	EMP
		D01	04/03/2024	AS-BUILT	HSK	SBY	RPK	AG	
		C01	10/10/2023	ISSUED FOR CONSTRUCTION	HSK	SBY	RPK	AG	
		A03	15/10/2022	ISSUED OF APPROVAL	HSK	SBY	RPK	AG	
MD-216-3130-EG-CV-GAD-1008	TERTIARY CRUSHING DETAILS & SECTIONS	A02	29/04/2022	ISSUED OF APPROVAL	SYA	SBY	RPK	AG	
MD-216-3130-EG-CV-GAD-1007	TERTIARY CRUSHING LAYOUT & DETAIL	A01	12/04/2022	ISSUED OF APPROVAL	SYA	SBY	RPK	AG	

RESERVED FOR VENDOR LOGO AND DRAWING NUMBER

LARSEN & TOUBRO

This drawing is the property of LARSEN & TOUBRO and must not be passed on to any person or body not authorized by us to receive it nor be copied or otherwise made use either in full or in part by such person or body without our prior permission in writing.

Outotec

The content of these documents are the sole property of Outotec Oyj. Any rights not expressly granted herein are reserved. Reproduction, transfer or distribution of part or all of the contents in any form without prior written permission of Outotec is prohibited.

MA'ADEN معادن Saudi Arabian Mining Company شركة معادن السعودية للتعدين

This document and the information contained herein is Ma'aden proprietary know-how. This document or any part thereof should not be reproduced, stored in a retrieval system or transmitted by any means, electronic or otherwise, or divulged without prior written permission of Ma'aden.

LARSEN & TOUBRO DRAWING NUMBER: D19045_100_C_G_24677_001 | REVISION: 4
OUTOTEC DRAWING NUMBER: 900707__GAU01__ZC01__MTL01__31394 | DOCUMENT ID: OU100750795 | REVISION: 4

DRAWN	SYA	08/04/2022
CHECKED	SBY	11/04/2022
ENGINEER	RPK	08/04/2022
APPROVED	AG	12/04/2022
EMPLOYER		
SCALE	1:75,1:50,1:25,1:10	A0

MANSOURAH - MASSARAH GOLD PROJECT
GENERAL ARRANGEMENT DRAWING
TERTIARY CRUSHING
MODIFICATION OF CRUSHER SUPPORT STRUCTURE

DRAWING NUMBER: MD-216-3130-EG-CV-GAD-1009 | REV: D01