


DRAWING NUMBER: MD - 216 - 3230 - EG - CV - DED - 1164
REV: D01

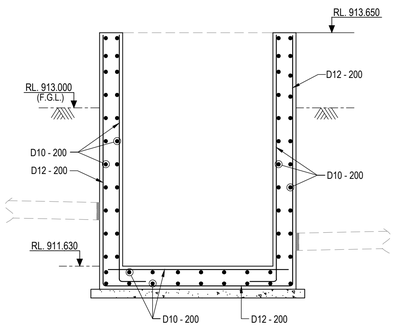


SECTION: G - G
(REF. GA DWG.)
(SCALE 1:25)

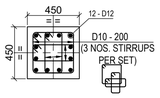


SECTION : A1 - A1
(SCALE 1:25)

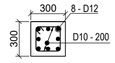


SECTION : A2 - A2
(SCALE 1:25)

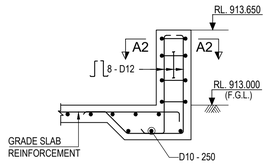


DETAIL OF PEDESTAL MKD. P6
(REF. DWG. NO. : MD-216-3230-EG-CV-GAD-1160)
(SCALE 1:25)

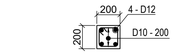


SECTION : C2 - C2
(SCALE 1:25)

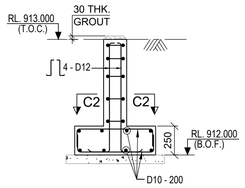


SECTION C1-C1
(SCALE-1:25)

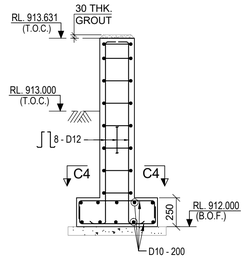


SECTION C3-C3
(SCALE-1:25)

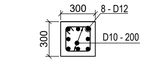


SECTION : C4 - C4
(SCALE 1:25)

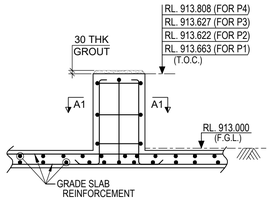


DETAIL OF PEDESTAL MKD. P1,P2,P3 & P4
(REF. DWG. NO. : MD-216-3230-EG-CV-GAD-1160)
(SCALE 1:25)

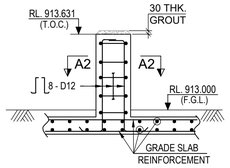


DETAIL OF PEDESTAL MKD. P5
(REF. DWG. NO. : MD-216-3230-EG-CV-GAD-1160)
(SCALE 1:25)

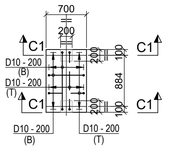


R.C. DETAIL OF FOUNDATION - F1
(REF. DRG. NO : MD-216-3230-EG-CV-GAD-1160)
(SCALE 1:50)

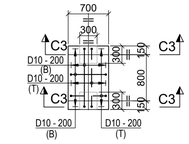


R.C. DETAIL OF FOUNDATION - F2
(REF. DRG. NO : MD-216-3230-EG-CV-GAD-1160)
(SCALE 1:50)

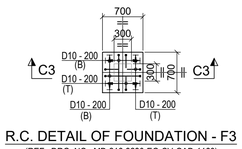

R.C. DETAIL OF FOUNDATION - F3
(REF. DRG. NO : MD-216-3230-EG-CV-GAD-1160)
(SCALE 1:50)

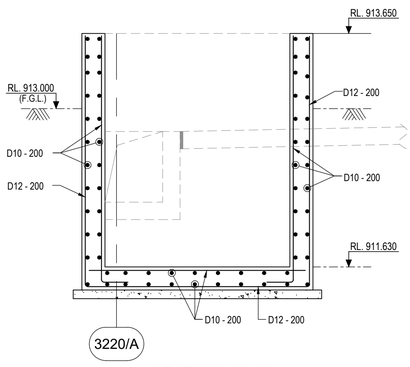


SECTION: C - C
(REF. GA DWG.)
(SCALE 1:25)

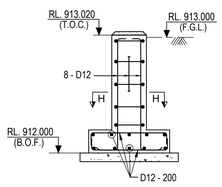


SECTION : D - D
(REF. GA DWG.)
(SCALE 1:25)


SECTION H-H
(SCALE 1:25)

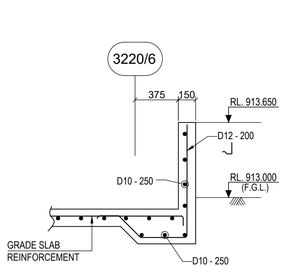


SECTION: E - E
(REF. GA DWG.)
(SCALE 1:25)

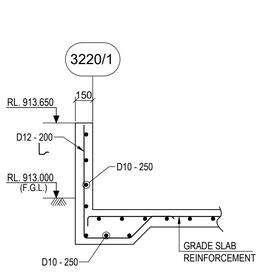

SECTION: F - F
(REF. GA DWG.)
(SCALE 1:25)

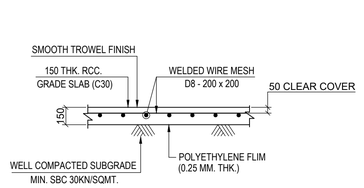

TYP DETAIL OF LIGHT DUTY PAVING
(FLOOR LOAD UPTO 15KN/SQM.)
(SCALE 1:25)

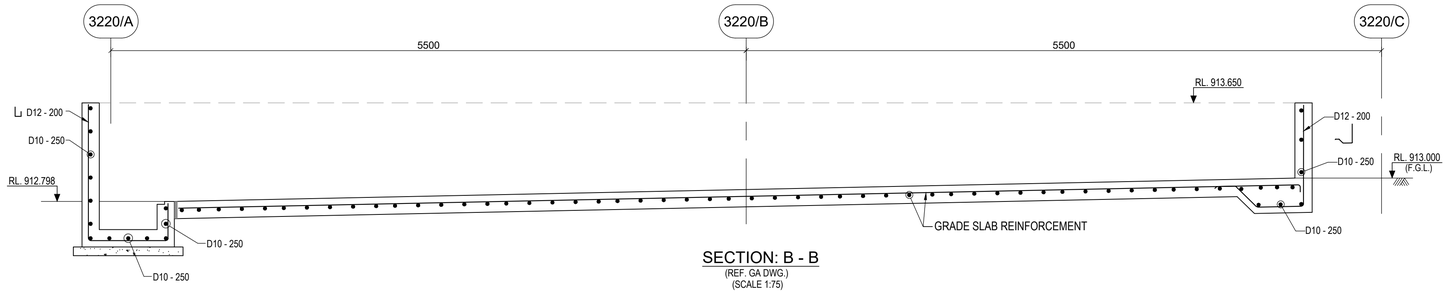

SECTION: B - B
(REF. GA DWG.)
(SCALE 1:75)

LEGEND:-

R.L. - REDUCED LEVEL
T.O.C - TOP OF CONCRETE
F.G.L - FINISHED GROUND LEVEL
P.C.C - PLAIN CEMENT CONCRETE
TYP - TYPICAL
MKD - MARKED
REF. - REFERENCE
GA - GENERAL ARRANGEMENT
DWG. - DRAWING

NOTES:-

1. ALL DIMENSIONS ARE IN MILLIMETRES AND LEVELS ARE IN METRES UNLESS OTHERWISE STATED.
2. GRADE OF CONCRETE SHALL BE C35 UNLESS OTHERWISE NOTED.
3. GRADE OF REINFORCEMENT SHALL BE DEFORMED BAR ASTM A615-GRADE 60 (fy=420 MPa)
4. CLEAR COVER TO MAIN REINFORCEMENT SHALL BE AS FOLLOWS:
   a) WALL : 50 mm. (FOR DOUBLE LAYER REINF.)
      75 mm. (FOR SINGLE LAYER REINF.)
   b) SLAB : 50 mm.
   c) PEDESTAL : 50 mm.
5. FOR GA DRAWING REF. DRG. NO. MD - 216 - 3230 - EG - CV - GAD - 1160.
6. FOR SPLICE LENGTHS OF REINF. REF. DWG. NO. MD-261-1000-EG-CV-DED-1001. - CL. NO. 5.3 & 5.4
7. FOR GENERAL NOTE FOR CIVIL WORK REF. DRG. NO : MD-216-1000-EG-CV-DED-1001.
8. FOR STANDERD REINF. DETAIL REF. DRG. NO : MD-216-1000-EG-CV-DED-1005.
9. FOR STANDARD DETAILS FOR PAVING REF. DRG. NO : MD-216-1000-EG-CV-DED-1002.
10. REINFORCEMENT MAY BE SLIGHTLY ADJUSTED AT SITE TO ACCOMMODATE EMBEDDED PART.

DOCUMENT NUMBER	REFERENCE DOCUMENTS	REV	DATE	REVISION DESCRIPTION	DRN	CHK	ENG	APP	EMP
		D01	10/03/2023	AS-BUILT	SBH	BDA	SUE	AG	
		C04	22/01/2021	ISSUED FOR CONSTRUCTION & REVISED AS MKD. C04	SBH	BDA	SUE	AG	
		C03	30/12/2020	ISSUED FOR CONSTRUCTION & REVISED AS MKD. C03	SBH	BDA	SUE	AG	
		C02	21/09/2020	ISSUED FOR CONSTRUCTION	SBH	BDA	SUE	AG	
		C01	10/04/2020	ISSUED FOR CONSTRUCTION	SBH	BDA	SUE	AG	
		A01	20/03/2020	ISSUED FOR REFERENCE	SBH	BDA	SUE	AG	

RESERVED FOR VENDOR LOGO AND DRAWING NUMBER

LARSEN & TOUBRO

This drawing is the property of LARSEN & TOUBRO and must not be passed on to any person or body not authorized by us to receive it nor be copied or otherwise made use either in full or in part by such person or body without our prior permission in writing.

Outotec

The content of these documents are the sole property of Outotec Oyj. Any rights not expressly granted herein are reserved. Reproduction, transfer or distribution of part or all of the contents in any form without prior written permission of Outotec is prohibited.

MA'ADEN معادن
Saudi Arabian Mining Company شركة معادن العربية السعودية

This document and the information contained herein is Ma'aden proprietary know-how. This document or any part thereof should not be reproduced, stored in a retrieval system or transmitted by any means, electronic or otherwise, or divulged without prior written permission of Ma'aden.

LARSEN & TOUBRO DRAWING NUMBER: 019045_450_C_D_24081_002 — REVISION: 5
OUTOTEC DRAWING NUMBER: 900707 __GAU01 __ZA01__CTB05 __32302 — DOCUMENT ID: 0U100671092 — REVISION: 5

DRAWN	SBH	18/03/2020
CHECKED	BDA	19/03/2020
ENGINEER	SUE	18/03/2020
APPROVED	AG	20/03/2020
EMPLOYER		
SCALE	1:30	A1

MANSOURAH - MASSARAH GOLD PROJECT
DETAIL DRAWING
GRAVITY SEPARATION
GRADE SLAB RC DETAILS

DRAWING NUMBER: MD - 216 - 3230 - EG - CV - DED - 1164
REV: D01