


DRAWING NUMBER: MD - 216 - 3230 - EG - CV - GAD - 1159 | REV: D01

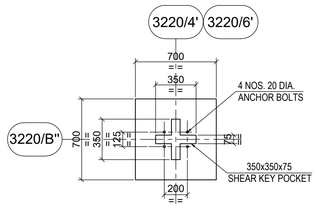


DETAIL OF COLUMN MKD. - C1
(SCALE-1:25)

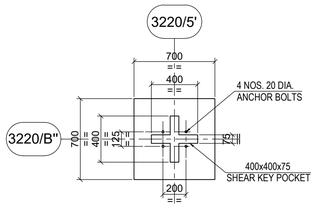


DETAIL OF COLUMN MKD. - C1
(SCALE-1:25)

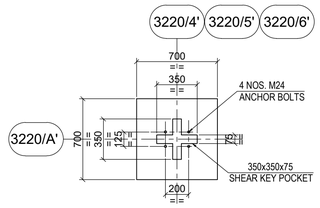


DETAIL OF COLUMN MKD. - C1
(SCALE-1:25)

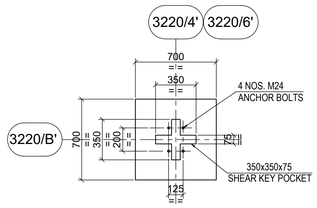


DETAIL OF COLUMN MKD. - C1
(SCALE-1:25)

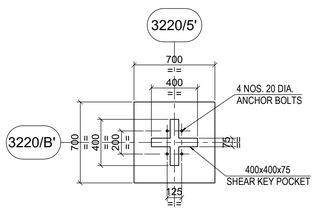


DETAIL OF COLUMN MKD. - C1
(SCALE-1:25)

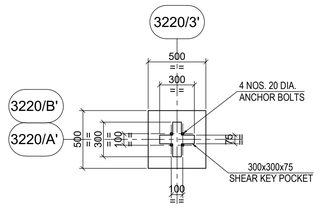


DETAIL OF COLUMN MKD. - C2
(SCALE-1:25)

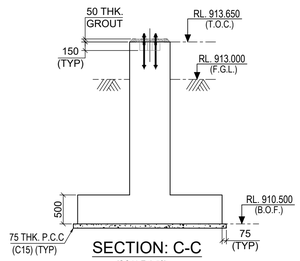


SECTION: C-C
(SCALE 1:50)

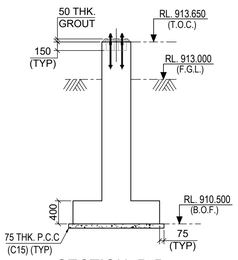


SECTION: D-D
(SCALE 1:50)

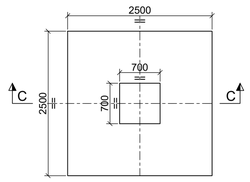


DETAIL OF FOUNDATION MKD. F2
(SCALE 1:50)

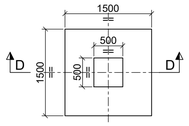


DETAIL OF FOUNDATION MKD. F3
(SCALE 1:50)

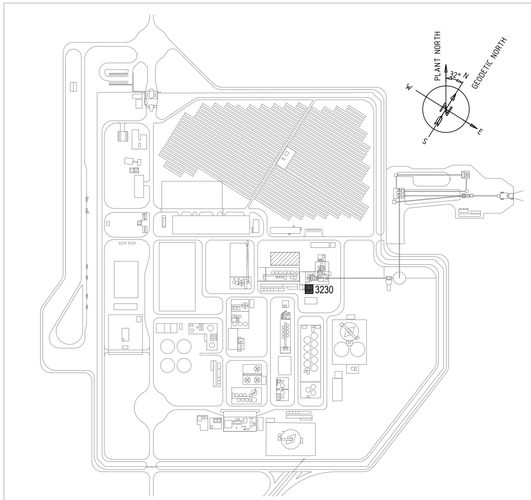


KEY PLAN
(SCALE 1:500)

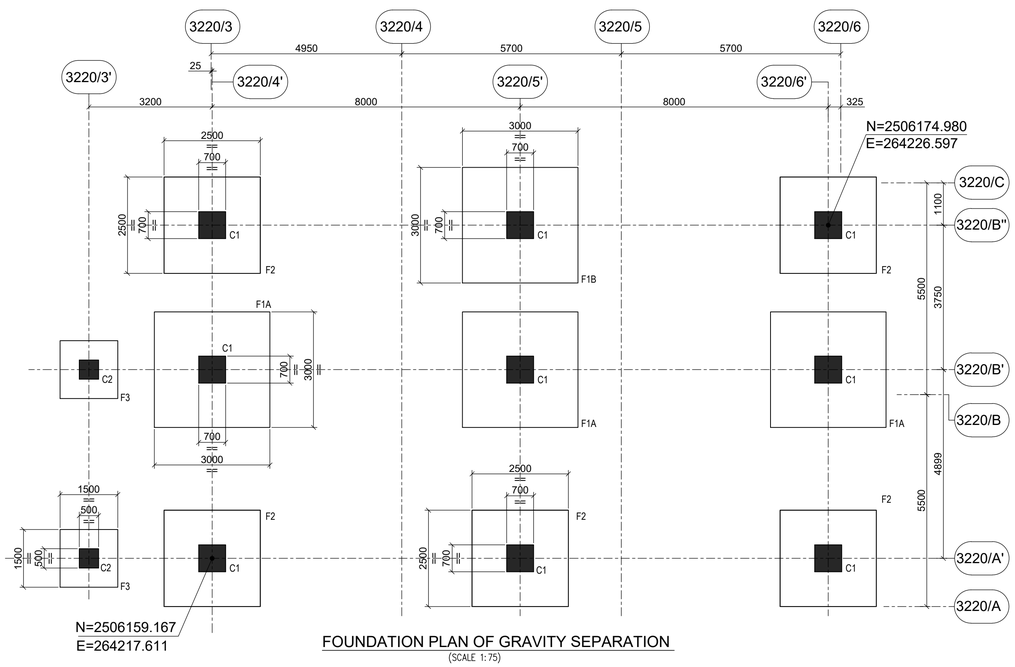


FOUNDATION PLAN OF GRAVITY SEPARATION
(SCALE 1:75)

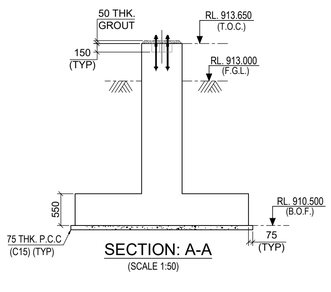


SECTION: A-A
(SCALE 1:50)

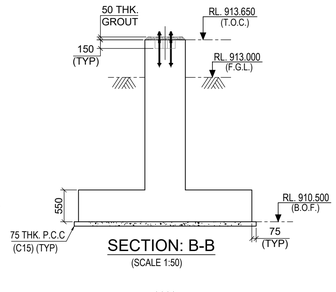

SECTION: B-B
(SCALE 1:50)

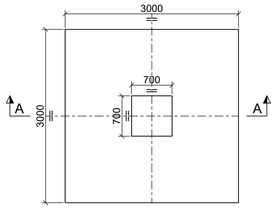

DETAIL OF FOUNDATION MKD. F1A
(SCALE 1:50)

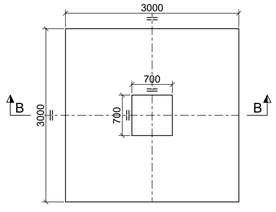

DETAIL OF FOUNDATION MKD. F1B
(SCALE 1:50)

LEGEND :-
R.L. - REDUCED LEVEL
T.O.C. - TOP OF CONCRETE.
F.G.L. - FINISHED GROUND LEVEL.
B.O.F. - BOTTOM OF FOUNDATION
TYP. - TYPICAL.
P.C.C - PLAIN CEMENT CONCRETE
MKD. - MARKED.
THK. - THICK

NOTES :-
1. ALL DIMENSIONS ARE IN MILLIMETRES AND LEVELS AND CO-ORDINATES ARE IN METRES. UNLESS OTHERWISE STATED.
2. GRADE OF CONCRETE SHALL BE C35.
3. GRADE OF REINFORCEMENT SHALL BE DEFORMED BAR ASTM A615 - GRADE 60 (fy = 420 MPa).
4. NET SAFE BEARING CAPACITY OF SOIL AT BOTTOM OF FOUNDATION CONSIDERED 670KN/SQ. M.
5. IF ANY PART OF FOUNDATION COMES ON BACKFILL ZONE OF ADJACENT FOUNDATION OR ANY LOOSE PACKETS ARE ENCOUNTERED BELOW FOUNDATION LEVEL THE SAME SHALL BE REMOVED AND FILLED WITH PCC.
7. FOR FOUNDATION BOLT DETAILS REF. DRG. NO : MD-216-1000-EG-CV-DED-1003.
7. FOR REINFORCEMENT DETAIL REF. DRG. NO : MD-216-3230-EG-CV-DED-1163.

DOCUMENT NUMBER	REFERENCE DOCUMENTS	REV	DATE	REVISION DESCRIPTION	DRN	CHK	ENG	APP	EMP
		D01	10/03/2023	AS-BUILT	SBH	BDA	SUE	AG	
		C04	04/01/2021	ISSUED FOR CONSTRUCTION & REVISED AS MKD.	SBH	BDA	SUE	AG	
		C03	21/09/2020	ISSUED FOR CONSTRUCTION	SBH	BDA	SUE	AG	
MD-216-3230-EG-ME-GAD-1085	GRINDING AND CLASSIFICATION-BALL MILL PLAN AT EL.(+)913.000	C02	29/04/2020	ISSUED FOR CONSTRUCTION	SBH	BDA	SUE	AG	
MD-216-3230-EG-ST-GAD-2151	GRAVITY SEPARATION PLAN,ELEVATION & DETAILS	C01	27/03/2020	ISSUED FOR CONSTRUCTION	SBH	BDA	SUE	AG	
MD-216-3230-EG-ST-GAD-2150	GRAVITY SEPARATION PLAN,ELEVATION & DETAILS	A01	29/02/2020	ISSUED FOR REFERENCE	SBH	BDA	SUE	AG	

RESERVED FOR VENDOR LOGO AND DRAWING NUMBER

LARSEN & TOUBRO

This drawing is the property of LARSEN & TOUBRO and must not be passed on to any person or body not authorized by us to receive it nor be copied or otherwise made use either in full or in part by such person or body without our prior permission in writing.

Outotec

The content of these documents are the sole property of Outotec Oyj. Any rights not expressly granted herein are reserved. Reproduction, transfer or distribution of part or all of the contents in any form without prior written permission of Outotec is prohibited.

MA'ADEN معادن
Saudi Arabian Mining Company شركة فحص العربية السعودية

This document and the information contained herein is Ma'aden proprietary know-how. This document or any part thereof should not be reproduced, stored in a retrieval system or transmitted by any means, electronic or otherwise, or divulged without prior written permission of Ma'aden.

LARSEN & TOUBRO DRAWING NUMBER	019045_450_C_G_24080_001	REVISION 5
OUTOTEC DRAWING NUMBER	900707 __GAU01 __ZA01__MTL01 __32308	DOCUMENT ID 0U100671088 / REVISION 5

DRAWN	SBH	27/02/2020
CHECKED	BDA	28/02/2020
ENGINEER	SUE	27/02/2020
APPROVED	AG	29/02/2020
EMPLOYER		
SCALE	1:30	A1

MANSOURAH - MASSARAH GOLD PROJECT
GENERAL ARRANGEMENT DRAWING
GRAVITY SEPARATION
FOUNDATION PLAN & SECTIONS

DRAWING NUMBER: MD - 216 - 3230 - EG - CV - GAD - 1159 | REV: D01