


DRAWING NUMBER: MD-216-3230-EG-CV-GAD-1160 | REV: D01

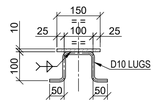


SECTION B1 - B1
(SCALE 1:10)

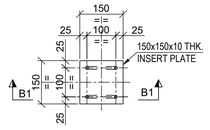


DETAIL OF INSERT PLATE - IP1
(SCALE 1:10)

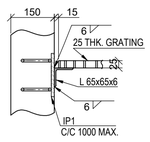


DETAIL -`B'
(SCALE 1:10)

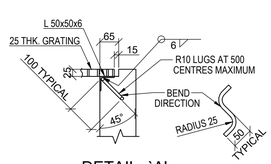


DETAIL -`A'
(SCALE 1:10)

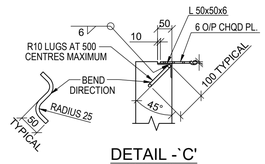


DETAIL -`C'
(SCALE 1:10)

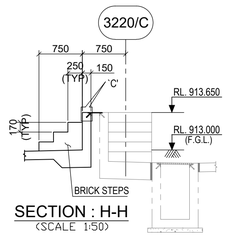


SECTION : H-H
(SCALE 1:50)

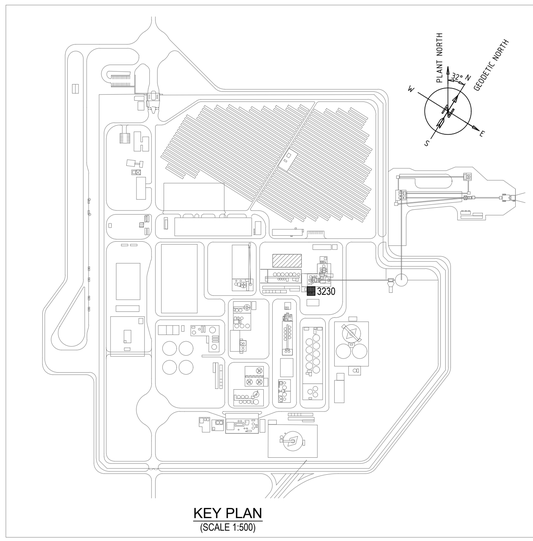


KEY PLAN
(SCALE 1:500)

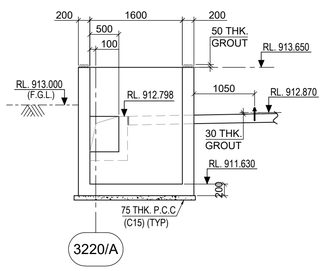


SECTION : C-C
(SCALE 1:50)

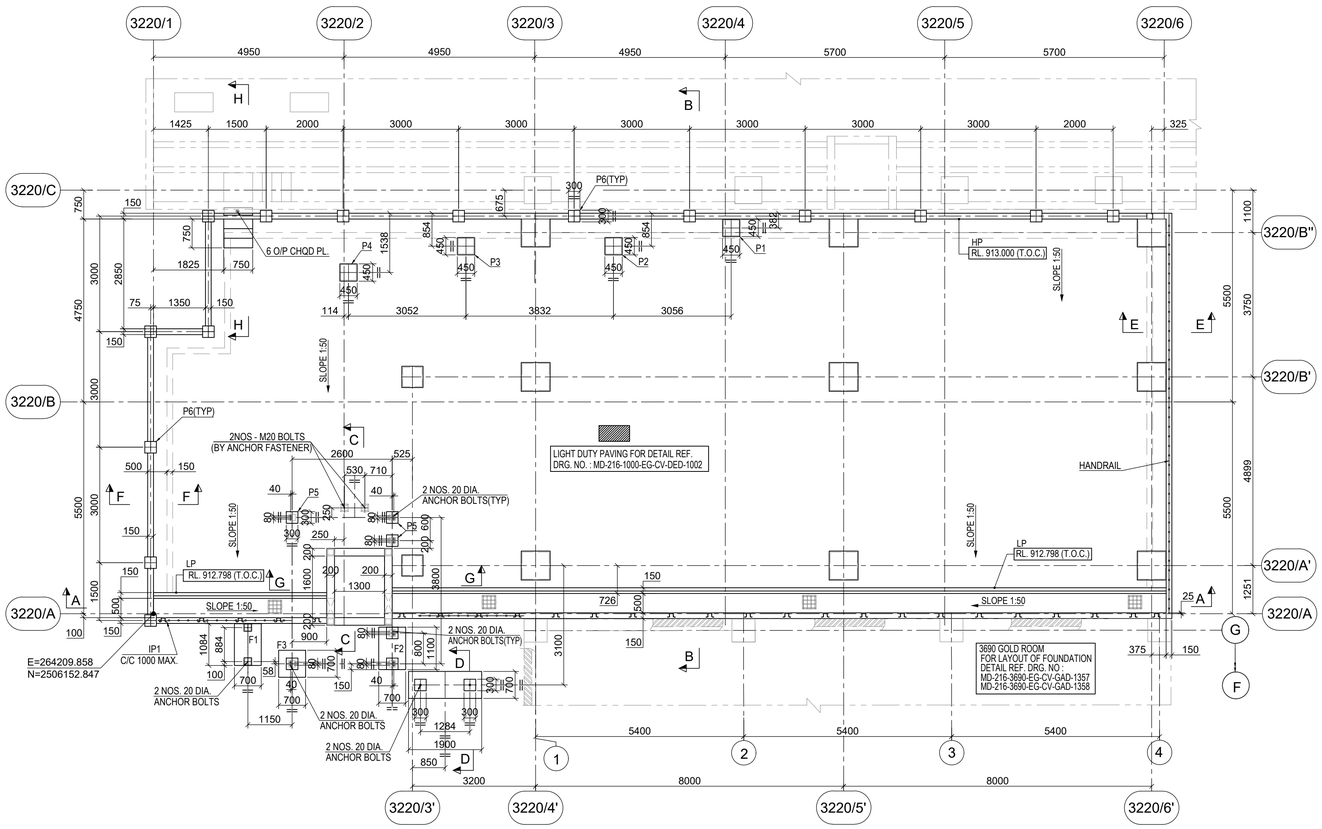


GRADE SLAB PLAN OF GRAVITY SEPARATION
(SCALE 1:75)

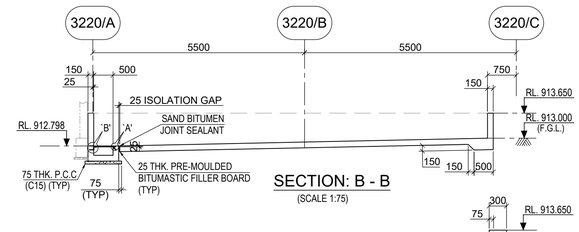


SECTION: B - B
(SCALE 1:75)

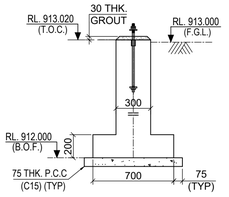


SECTION : D - D
(SCALE 1:25)

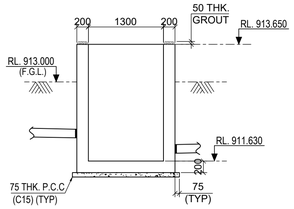


SECTION : G - G
(SCALE 1:50)

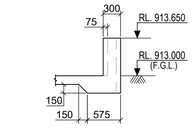

DETAIL OF PEDESTAL MKD. P6
(SCALE 1:50)

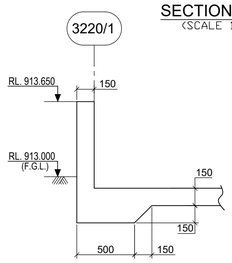

SECTION: F - F
(SCALE 1:25)

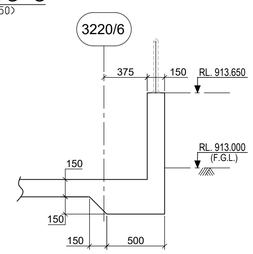

SECTION: E - E
(SCALE 1:25)

LEGEND :-

R.L. - REDUCED LEVEL
T.O.C. - TOP OF CONCRETE.
F.G.L. - FINISHED GROUND LEVEL.
TYP. - TYPICAL.
P.C.C - PLAIN CEMENT CONCRETE
MKD. - MARKED.
THK. - THICK
H.P. - HIGH POINT
L.P. - LOW POINT

NOTES :-

1. ALL DIMENSIONS ARE IN MILLIMETRES AND LEVELS AND CO-ORDINATES ARE IN METRES. UNLESS OTHERWISE STATED.
2. GRADE OF CONCRETE SHALL BE C35. UNLESS NOTED OTHERWISE.
3. GRADE OF REINFORCEMENT SHALL BE DEFORMED BAR ASTM A615 - GRADE 60 (fy = 420 MPa).
4. IF ANY PART OF FOUNDATION COMES ON BACKFILL ZONE OF ADJACENT FOUNDATION OR ANY LOOSE PACKETS ARE ENCOUNTERED BELOW FOUNDATION LEVEL THE SAME SHALL BE REMOVED AND FILLED WITH PCC.
5. FOR REINFORCEMENT DETAIL REF. DRG. NO : MD-216-3230-EG-CV-DED-1164.
6. FOR FOUNDATION BOLT DETAILS REF. DRG. NO : MD-216-1000-EG-CV-DED-1003.
7. FOR STANDARD DETAILS OF PAVING REF. DRG. NO : MD-216-1000-EG-CV-DED-1002.
8. FOR GENERAL NOTE FOR CIVIL WORK REF. DRG. NO : MD-216-1000-EG-CV-DED-1001.

DOCUMENT NUMBER	REFERENCE DOCUMENTS	REV	DATE	REVISION DESCRIPTION	DRN	CHK	ENG	APP	EMP
		D01	10/03/2023	AS-BUILT	SBH	BDA	SUE	AG	
		C06	05/03/2021	ISSUED FOR CONSTRUCTION & REVISED AS MKD. C06	SBH	BDA	SUE	AG	
		C05	22/01/2021	ISSUED FOR CONSTRUCTION & REVISED AS MKD. C05	SBH	BDA	SUE	AG	
MD-216-3220-EG-CV-GAD-1004	PLAN AT EL.(+)913.000-GRID A-C/1-6	C04	30/12/2020	ISSUED FOR CONSTRUCTION & REVISED AS MKD. C04	SBH	BDA	SUE	AG	
MD-216-3230-EG-ME-GAD-1085	PLAN AT EL.(+)913.000	C03	21/09/2020	ISSUED FOR CONSTRUCTION	SBH	BDA	SUE	AG	
MD-216-3230-EG-CV-GAD-1159	GRAVITY SEPARATION FOUNDATION PLAN & SECTION	C02	29/04/2020	ISSUED FOR CONSTRUCTION	SBH	BDA	SUE	AG	
MD-216-3230-EG-ST-GAD-2151	GRAVITY SEPARATION PLAN,ELEVATION & DETAILS	C01	10/04/2020	ISSUED FOR CONSTRUCTION	SBH	BDA	SUE	AG	
MD-216-3230-EG-ST-GAD-2150	GRAVITY SEPARATION PLAN,ELEVATION & DETAILS	A01	20/03/2020	ISSUED FOR REFERENCE	SBH	BDA	SUE	AG	

RESERVED FOR VENDOR LOGO AND DRAWING NUMBER

LARSEN & TOUBRO

This drawing is the property of LARSEN & TOUBRO and must not be passed on to any person or body not authorized by us to receive it nor be copied or otherwise made use either in full or in part by such person or body without our prior permission in writing.

Outotec

The content of these documents are the sole property of Outotec Oyj. Any rights not expressly granted herein are reserved. Reproduction, transfer or distribution of part or all of the contents in any form without prior written permission of Outotec is prohibited.

MA'ADEN معادن
Saudi Arabian Mining Company شركة معادن العربية السعودية

This document and the information contained herein is Ma'aden proprietary know-how. This document or any part thereof should not be reproduced, stored in a retrieval system or transmitted by any means, electronic or otherwise, or divulged without prior written permission of Ma'aden.

LARSEN & TOUBRO DRAWING NUMBER: 019045_450_C_G_24080_002 | REVISION: 7
OUTOTEC DRAWING NUMBER: 900707__GAU01__ZA01__MTL01__32309 | DOCUMENT ID: OU100671089 | REVISION: 7

DRAWN	SBH	18/03/2020
CHECKED	BDA	19/03/2020
ENGINEER	SUE	18/03/2020
APPROVED	AG	20/03/2020
EMPLOYER		
SCALE	1:30	A1

MANSOURAH - MASSARAH GOLD PROJECT
GENERAL ARRANGEMENT DRAWING
GRAVITY SEPARATION
GRADE SLAB

DRAWING NUMBER: MD-216-3230-EG-CV-GAD-1160 | REV: D01