


DRAWING NUMBER: MD-216-3690-EG-AR-GAD-3063
REV: D01

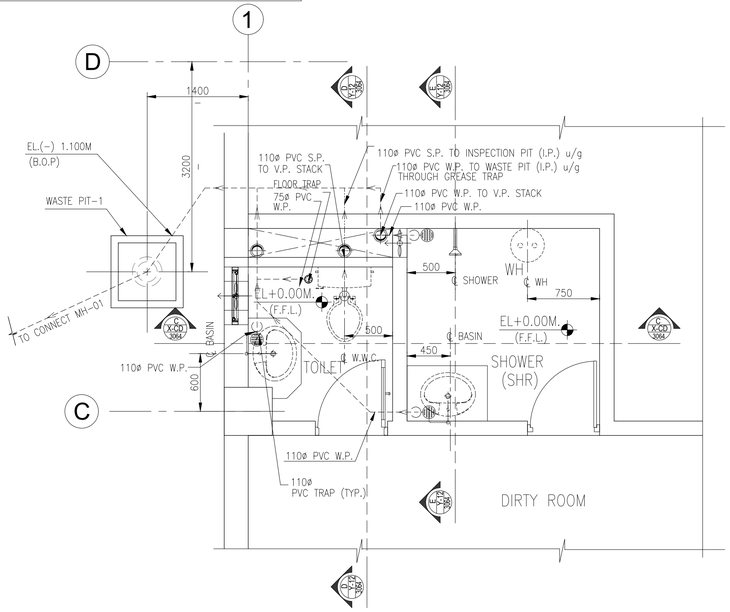


TOILET-1
PLAN OF TOILET AT ±0.0 LEVEL
LAYOUT OF SOIL, WASTE AND VENT PIPES
SCALE 1:30

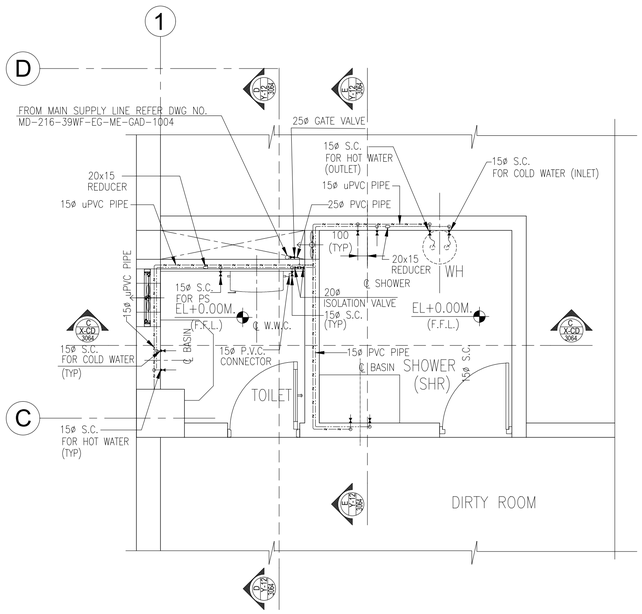

TOILET-1
PLAN OF TOILET AT ±0.0 LEVEL
LAYOUT OF WATER DISTRIBUTION PIPES
SCALE 1:30

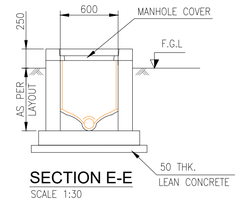



SECTION E-E
SCALE 1:30

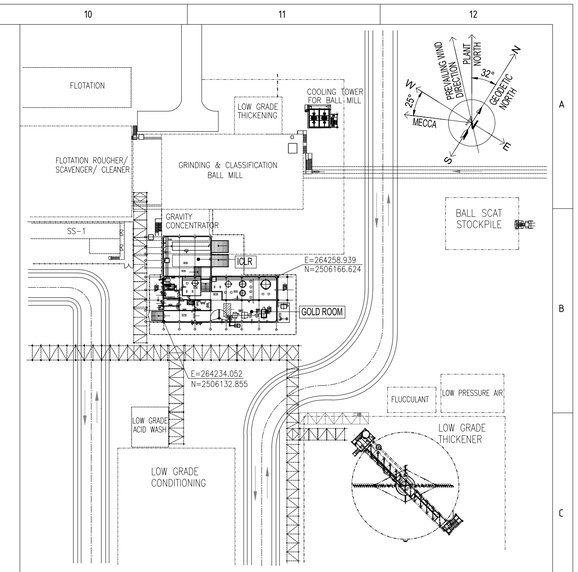


MASTER KEY PLAN
SCALE 1:1000

BUILDING KEY PLAN

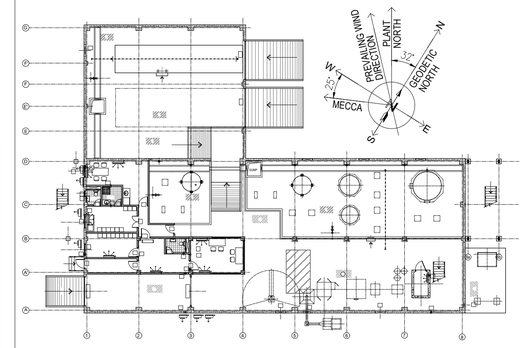


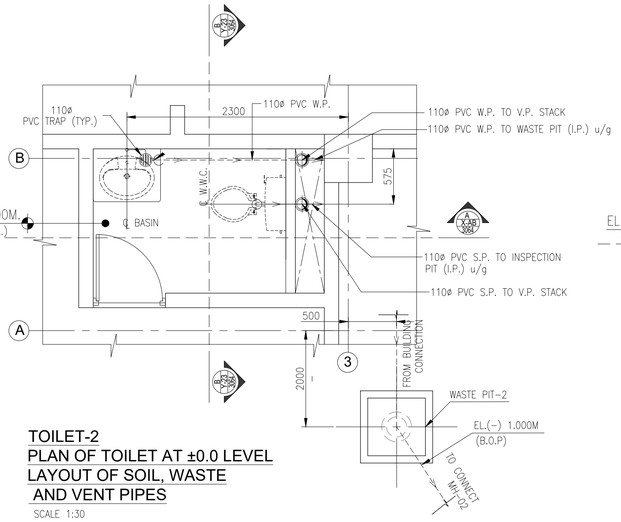

TOILET-2
PLAN OF TOILET AT ±0.0 LEVEL
LAYOUT OF SOIL, WASTE AND VENT PIPES
SCALE 1:30

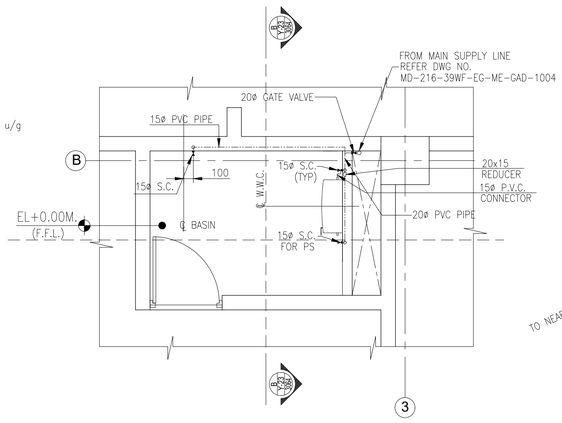

TOILET-2
PLAN OF TOILET AT ±0.0 LEVEL
LAYOUT OF WATER DISTRIBUTION PIPES
SCALE 1:30

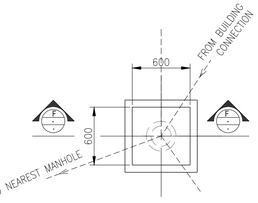

TYPICAL PLAN OF WASTE PIT
SCALE 1:30

ABBREVATIONS / LEGENDS	
FGL	FINISH GRADE LEVEL
FFL	FINISH FLOOR LEVEL
TYP.	TYPICAL
SD	SOAP DISH
V.P.	VENT PIPE
S.P.	SOIL PIPE
W.P.	WASTE PIPE
I.P.	INSPECTION PIT
u/g	UNDER GROUND
S.C.	STOP COCK
W.W.C	WESTERN WATER CLOSET
WH	WATER HEATER

LEGENDS

SOIL PIPE (S.P.) SHOWN THUS	
WASTE PIPE (W.P.) SHOWN THUS	
NORMAL WATER PIPE (PVC) SHOWN THUS	
HOT WATER PIPE (uPVC) SHOWN THUS	HW HW

NOTES:

1. ALL DIMENSIONS ARE IN MILLIMETER & LEVELS ARE IN METER UNLESS OTHERWISE STATED.
2. ALL DWG. IN 1:30 SCALE UNLESS OTHERWISE STATED.
3. ALL DRAWINGS MUST BE READ IN CONJUNCTION WITH ALL OTHER ARCHITECTURAL AND ENGINEERING OTHER ARCHITECTURAL AND ENGINEERING DRAWINGS RELATED TO THE SAME SHEET AND ANY ITEM ON IT.
4. FOR GRADED FINISHED FLOOR LEVEL (F.F.L) REFER DRAWING NUMBER MD–216–1000–EG–PPD–1002, PLOT PLAN GENERAL PROCESS PLANT LAYOUT.
5. PLUMBING TO BE IN ACCORDANCE WITH SBC701.

DOCUMENT NUMBER	REFERENCE DOCUMENTS	REV	DATE	REVISION DESCRIPTION	DRN	CHK	ENG	APP	EMP
		D01	10/03/2023	AS-BUILT	APEX	DRO	TH	SJM	
MD-216-3690-EG-AR-GAD-3064	PLUMBING AND SANITARY DETAIL-2	C04	05/03/2022	ISSUED FOR CONSTRUCTION & REVISED AS MARKED (04)	APEX	DRO	TH	SJM	
MD-216-3690-EG-AR-GAD-3062	FALSE CEILING PLAN & TOILET DETAIL	C03	08/03/2021	ISSUED FOR CONSTRUCTION & REVISED AS MARKED (03)	APEX	DRO	TH	SJM	
MD-261-3960-EG-AR-GAD-3061	PROCESS AREA : BUILDING ELEVATIONS & SECTIONS	C02	24/11/2020	ISSUED FOR CONSTRUCTION & REVISED AS MARKED (02)	APEX	DRO	DRO	SJM	
MD-216-3960-EG-AR-GAD-3060	PROCESS AREA : BUILDING PLANS & SCHEDULE OF FINISHES	C01	23/06/2020	REVISED AS PER BECHTEL COMMENTS DT. 19/06/2020 & AS MKD. (01)	APEX	DRO	DRO	SJM	
MD-216-1000-EG-ST-CRT-1001	CIVIL, STRUCTURAL AND ARCHITECTURAL DESIGN CRITERIA	A01	26/05/2020	ISSUED FOR REFERENCE	APEX	DRO	DRO	SJM	

RESERVED FOR VENDOR LOGO AND DRAWING NUMBER

LARSEN & TOUBRO

This drawing is the property of LARSEN & TOUBRO and must not be passed on to any person or body not authorized by us to receive it nor be copied or otherwise made use either in full or in part by such person or body without our prior permission in writing.

Outotec

The content of these documents are the sole property of Outotec Oyj. Any rights not expressly granted herein are reserved. Reproduction, transfer or distribution of part or all of the contents in any form without prior written permission of Outotec is prohibited.

MA'ADEN معادن
Saudi Arabian Mining Company شركة معادن العربية السعودية

This document and the information contained herein is Ma'aden proprietary know-how. This document or any part thereof should not be reproduced, stored in a retrieval system or transmitted by any means, electronic or otherwise, or divulged without prior written permission of Ma'aden.

LARSEN & TOUBRO DRAWING NUMBER: 019045_450_A_G_25011_004 — REVISION: 5
OUTOTEC DRAWING NUMBER: 900707 __GAU01 __EE14 __MTL01 __36912 — DOCUMENT ID: OU100682601 — REVISION: 5

DRAWN	APEX	21/05/2020
CHECKED	DRO	23/05/2020
ENGINEER	DRO	23/05/2020
APPROVED	SJM	26/05/2020
EMPLOYER		
SCALE	1:30	A1

MANSOURAH - MASSARAH GOLD PROJECT
GENERAL ARRANGEMENT DRAWING
PROCESS AREA : GOLD ROOM
PLUMBING AND SANITARY DETAIL-1

DRAWING NUMBER: MD-216-3690-EG-AR-GAD-3063 — REV: D01