

DRAWING NUMBER: MD-216-39WQ-EG-AR-GAD-3225 | REV: D01

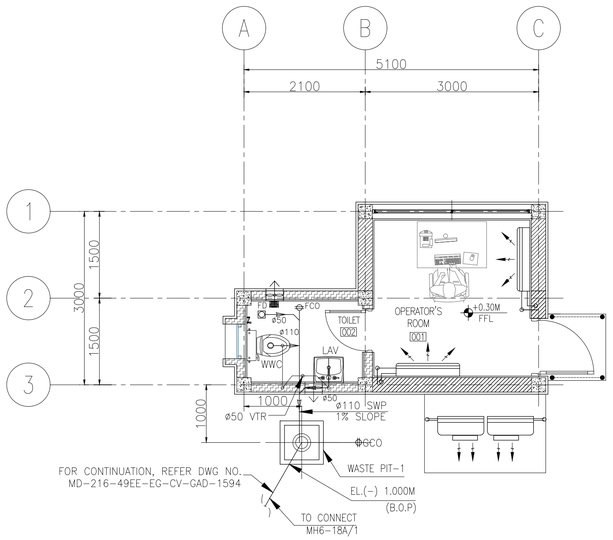

SEWER DRAIN PIPING LAYOUT

SCALE- 1:50

1

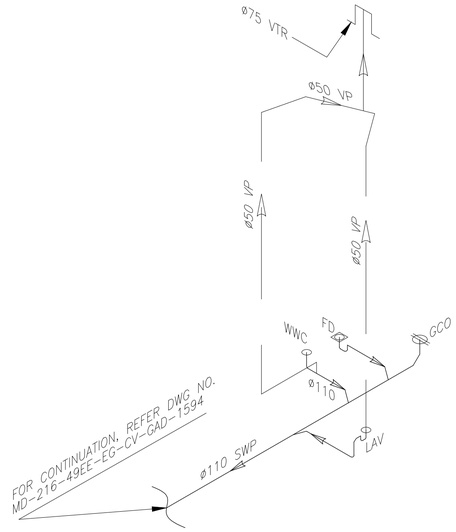


SEWER DRAIN PIPING ISOMETRIC

SCALE- NTS

2


LEGEND AND DESCRIPTION		
WALL	FINISHES	SAMPLE
WO1	250 MM THK. CMU BLOCK WALL WITH INSULATION AND 38 MM THK. PLASTER EXTERNAL AND 25 MM THK.PLASTER INSIDE.	
WO2	150 MM THK. CMU BLOCK WALL WITH 25 MM, THK. PLASTER FINISHING FAIR FACED ON THE DRY SIDE AND GLAZED CERAMIC TILING ON TOILET SIDE.	
RCC	RCC COLUMN / BEAM / SLAB	
B/W	BLOCKWORK IN ELEVATION	
PCC	LEAN CONCRETE	
INS	INSULATION	
	COMPACTED FILL	
	HOLLOW CORE SLAB	
	GYPSUM BOARD FALSE CEILING (START POINT)	
	GYPSUM BOARD MOISTURE PROOFING FALSE CEILING	
	600mmX600mm ACOUSTIC CEILING TILES	
	ROOF HATCH PATTERN	SLOPE 1%

MASTER KEY PLAN

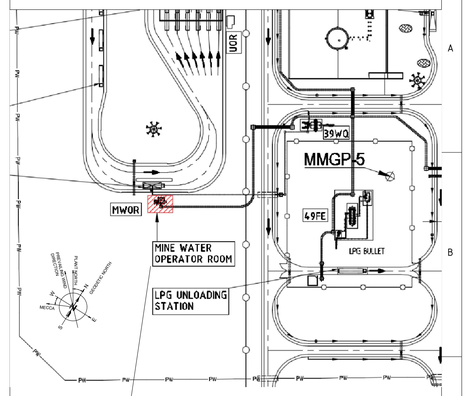


MINE WATER AREA: OPERATOR ROOM

BUILDING KEY PLAN

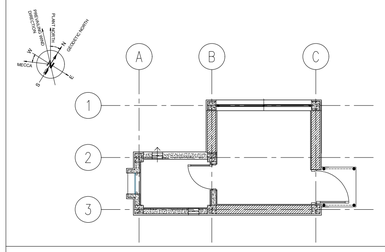


NOTES

1. ALL DIMENSIONS ARE IN MILLIMETRES AND ALL LEVELS ARE GIVEN IN METRES UNLESS OTHERWISE NOTED.
2. ALL DRAWINGS MUST BE READ IN CONJUNCTION WITH ALL OTHER ARCHITECTURAL AND ENGINEERING DRAWINGS RELATED TO THE SAME SHEET AND ANY ITEM ON IT.
3. FOR GRADED FINISHED FLOOR LEVEL (F.F.L) REFER DRAWING NUMBER MD-216-39WQ-EG-CV-DED-1451 FOR MINE WATER AREA : OPERATOR ROOM PLAN ELEVATION
4. FOR BUILDING SITE SETTING OUT PLAN AND DATA, SEE SURVEYORS/CIVIL DRAWINGS.
5. PLUMBING IN ACCORDANCE TO SBC 701.

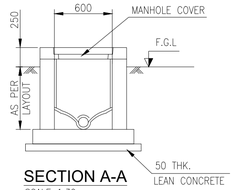


SECTION A-A

SCALE 1:30

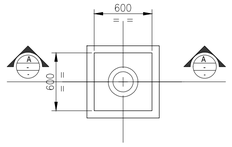

TYPICAL PLAN OF WASTE PIT


SCALE 1:30

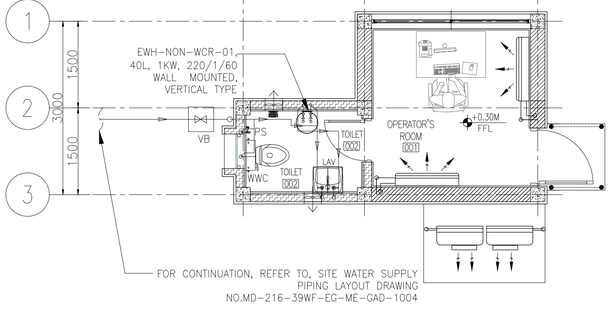

WATER SUPPLY PIPING LAYOUT

SCALE- 1:50

3

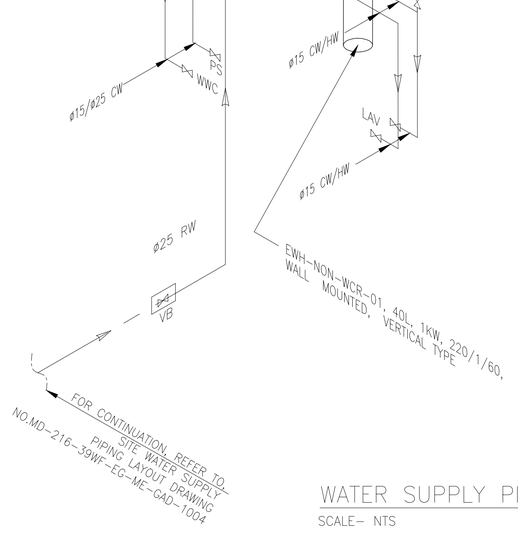

WATER SUPPLY PIPING ISOMETRIC

SCALE- NTS

4

LEGENDS:

FFL	FINISH FLOOR LEVEL
FGL	FINISH GROUND LEVEL
THK.	THICK
EWH	ELECTRIC WATER HEATER
CW	COLD WATER SUPPLY
HW	HOT WATER SUPPLY
PS	PERENIAL SPRAY
LAV	LAVATORY
SHO	SHOWER
WHA	WATER HAMMER ARRESTOR
WWC	WESTERN WATER CLOSET
ø	DIAMETER
VB	VALVE BOX
DWG	DRAWING
NTS	NOT TO SCALE
VTR	VENT THROUGH ROOF
SWP	SURFACE WATER PIPE

REV	DATE	REVISION DESCRIPTION	DRN	CHK	ENG	APP	EMP
D01	11/03/2021	AS-BUILT	MNS	DRO	TH	SJM	
C02	11/03/2021	ISSUED FOR CONSTRUCTION AND REVISED AS MARKED (C02)	MNS	DRO	TH	SJM	
C01	01/02/2021	ISSUED FOR CONSTRUCTION AND REVISED AS PER EMPLOYER'S COMMENT ON 27/01/2021 & REVISED AS MARKED (C01)	MNS	DRO	TH	SJM	
A01	04/01/2021	ISSUED FOR APPROVAL	MNS	DRO	TH	SJM	

DOCUMENT NUMBER	REFERENCE DOCUMENTS
MD-216-1000-EG-ST-CRT-1001	CIVIL, STRUCTURAL AND ARCHITECTURAL DESIGN CRITERIA

RESERVED FOR VENDOR LOGO AND DRAWING NUMBER

LARSEN & TOUBRO

This drawing is the property of LARSEN & TOUBRO and must not be passed on to any person or body not authorized by us to receive it nor be copied or otherwise made use either in full or in part by such person or body without our prior permission in writing.

Outotec

The content of these documents are the sole property of Outotec Oyj. Any rights not expressly granted herein are reserved. Reproduction, transfer or distribution of part or all of the contents in any form without prior written permission of Outotec is prohibited.

MA'ADEN معادن
Saudi Arabian Mining Company شركة المعادن العربية السعودية

This document and the information contained herein is Ma'aden proprietary know-how. This document or any part thereof should not be reproduced, stored in a retrieval system or transmitted by any means, electronic or otherwise, or divulged without prior written permission of Ma'aden.

LARSEN & TOUBRO DRAWING NUMBER: O19045_080_A_G_25080_002 | REVISION: 3

OUTOTEC DRAWING NUMBER: 900707 _GAU01 _AG35_MTL01 _39110 | DOCUMENT ID: OU100711097 | REVISION: 3

DRAWN	MNS	29/12/2020
CHECKED	DRO	31/12/2020
ENGINEER	TH	30/12/2020
APPROVED	SJM	04/01/2021
EMPLOYER		
SCALE	1:100	A1

MANSOURAH - MASSARAH GOLD PROJECT
GENERAL ARRANGEMENT
MINE WATER AREA : OPERATOR ROOM
PLUMBING & SANITARY DETAILS

DRAWING NUMBER: MD-216-39WQ-EG-AR-GAD-3225 | REV: D01