


DRAWING NUMBER: MD-216-4000-EG-AR-GAD-3009 | REV: D01

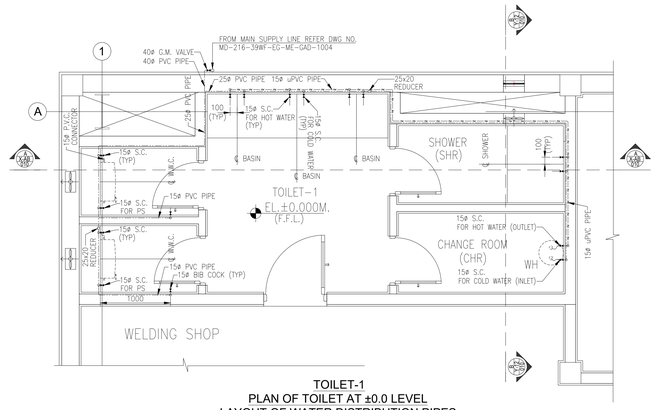


TOILET-1
PLAN OF TOILET AT ±0.0 LEVEL
LAYOUT OF WATER DISTRIBUTION PIPES
SCALE 1:30

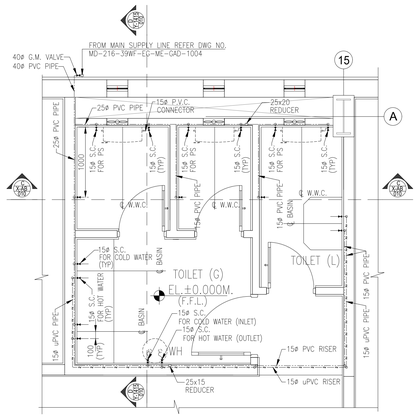

TOILET-2
PLAN OF TOILET AT ±0.0 LEVEL
LAYOUT OF WATER DISTRIBUTION PIPES
SCALE 1:30

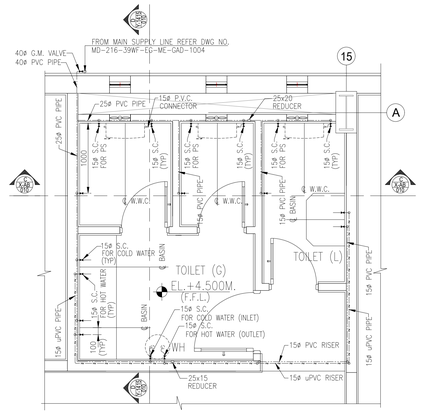



TOILET-3
PLAN OF TOILET AT +4.5M. LEVEL
LAYOUT OF WATER DISTRIBUTION PIPES
SCALE 1:30

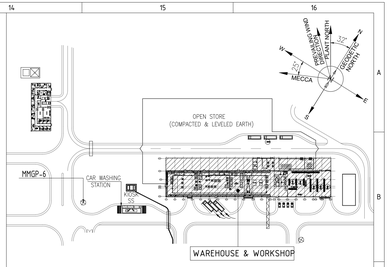


MASTER KEY PLAN

BUILDING KEY PLAN

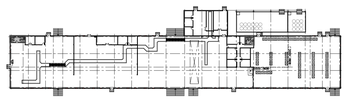


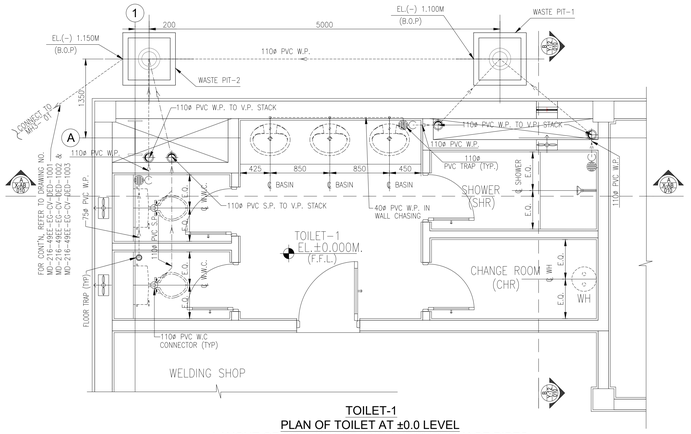


TOILET-1
PLAN OF TOILET AT ±0.0 LEVEL
LAYOUT OF SOIL, WASTE AND ANTISYPHONAGE PIPES
SCALE 1:30

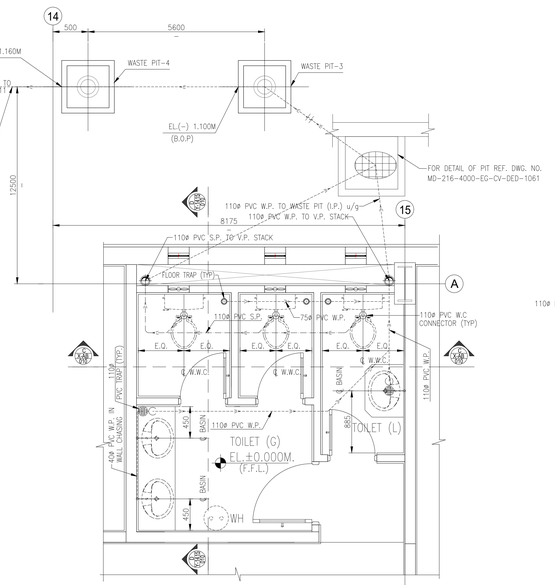


TOILET-2
PLAN OF TOILET AT ±0.0 LEVEL
LAYOUT OF SOIL, WASTE AND VENT PIPES
SCALE 1:30

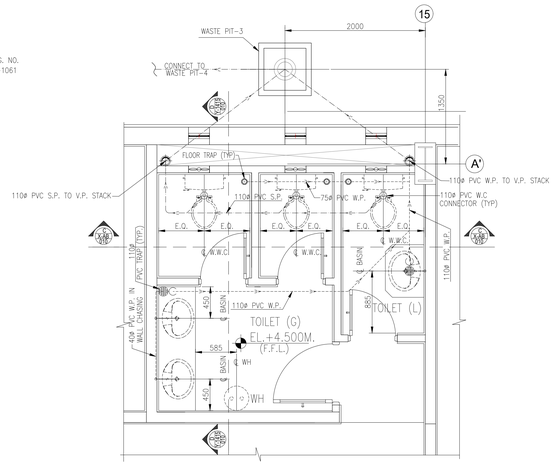

TOILET-3
PLAN OF TOILET AT +4.5M. LEVEL
LAYOUT OF SOIL, WASTE AND ANTISYPHONAGE PIPES
SCALE 1:30

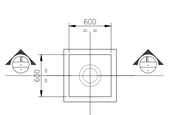

TYPICAL PLAN OF WASTE PIT
SCALE 1:30

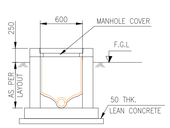

SECTION E-E
SCALE 1:30

LEGENDS

SOIL PIPE (S.P.) SHOWN THUS	
WASTE PIPE (W.P.) SHOWN THUS	
NORMAL WATER PIPE (PVC) SHOWN THUS	
HOT WATER PIPE (uPVC) SHOWN THUS	HW HW

ABBREVATIONS / LEGENDS

FGL	FINISH GRADE LEVEL
FFL	FINISH FLOOR LEVEL
TYP.	TYPICAL
SSL	STRUCTURAL SLAB LEVEL
V.P.	VENT PIPE
S.P.	SOIL PIPE
W.P.	WASTE PIPE
I.P.	INSPECTION PIT
u/g	UNDER GROUND
S.C.	STOP COCK
W.W.C	WESTERN WATER CLOSET
WH	WATER HEATER

NOTES:

1. ALL DIMENSIONS ARE IN MILLIMETER & LEVELS ARE IN METER UNLESS OTHERWISE STATED.
2. ALL DWG. IN 1:30 SCALE UNLESS OTHERWISE STATED.
3. ALL DRAWINGS MUST BE READ IN CONJUNCTION WITH ALL OTHER ARCHITECTURAL AND ENGINEERING DRAWINGS RELATED TO THE SAME SHEET AND ANY ITEM ON IT.
4. FOR GRADED FINISHED FLOOR LEVEL (F.F.L) REFER DRAWING NUMBER MD-216-1000-EG-PPD-1002, PLOT PLAN GENERAL PROCESS PLANT LAYOUT.
5. PLUMBING TO BE IN ACCORDANCE WITH SBC 701.

DOCUMENT NUMBER	REFERENCE DOCUMENTS	REV	DATE	REVISION DESCRIPTION	DRN	CHK	ENG	APP	EMP
		D01	09/03/2023	AS-BUILT	APEX	DRO	TH	SJM	
		C03	05/03/2022	ISSUED FOR CONSTRUCTION & REVISED AS MARKED	APEX	DRO	TH	SJM	
MD-216-4000-EG-AR-GAD-3006	TOILET DETAILS	C02	08/03/2021	ISSUED FOR CONSTRUCTION & REVISED AS MARKED	APEX	DRO	TH	SJM	
MD-216-1000-EG-ST-CRT-1001	CIVIL, STRUCTURAL AND ARCHITECTURAL DESIGN CRITERIA	C01	29/04/2020	ISSUED FOR CONSTRUCTION & REVISED AS PER EMPLOYER'S	APEX	DRO	DRO	SJM	
MD-216-4000-EG-ME-GAD-1002	WAREHOUSE AND MAINTANCE WORKSHOP SECTION			COMMENT DATED 20/04/2020					
MD-216-4000-EG-ME-GAD-1001	WAREHOUSE AND MAINTANCE WORKSHOP PLN VIEW	A01	30/03/2020	ISSUED FOR REFERENCE	APEX	DRO	DRO	SJM	

RESERVED FOR VENDOR LOGO AND DRAWING NUMBER

This drawing is the property of LARSEN & TOUBRO and must not be passed on to any person or body not authorized by us to receive it nor be copied or otherwise made use either in full or in part by such person or body without our prior permission in writing.

The content of these documents are the sole property of Outotec Oyj. Any rights not expressly granted herein are reserved. Reproduction, transfer or distribution of part or all of the contents in any form without prior written permission of Outotec is prohibited.

This document and the information contained herein is Ma'aden proprietary know-how. This document or any part thereof should not be reproduced, stored in a retrieval system or transmitted by any means, electronic or otherwise, or divulged without prior written permission of Ma'aden.

LARSEN & TOUBRO DRAWING NUMBER	019045_501_A_G_25002_007
REVISION	4
OUTOTEC DRAWING NUMBER	900707__GAU01__AN03__MTL01__40039
DOCUMENT ID	OU100676255
REVISION	4
DRAWN	APEX 28/03/2020
CHECKED	DRO 29/03/2020
ENGINEER	DRO 29/03/2020
APPROVED	SJM 30/03/2020
EMPLOYER	
SCALE	1:30
	A0

MANSOURAH - MASSARAH GOLD PROJECT
GENERAL ARRANGEMENT DRAWING
PROCESS AREA : WAREHOUSE & WORKSHOP
PLUMBING AND SANITARY DETAILS

DRAWING NUMBER: MD-216-4000-EG-AR-GAD-3009 | REV: D01