


DRAWING NUMBER: MD-216-4000-EG-AR-GAD-3023 | REV: D01

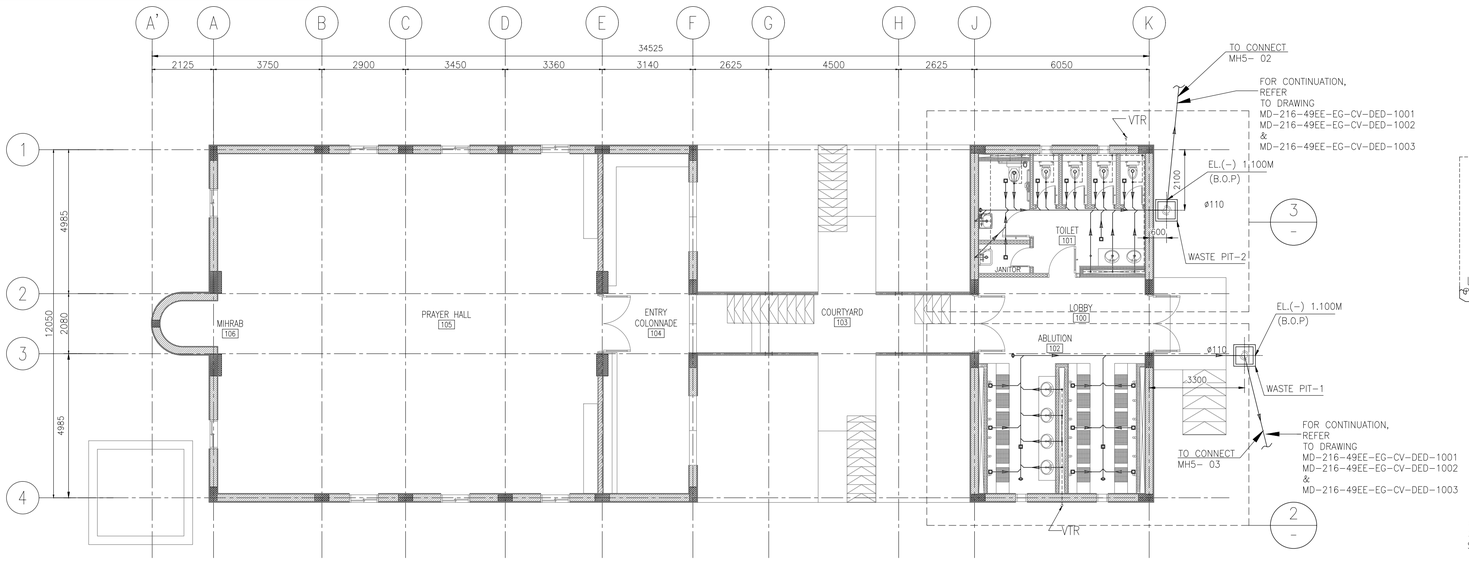


GROUND FLOOR SEWER DRAIN PIPING LAYOUT (1)
SCALE- 1:100

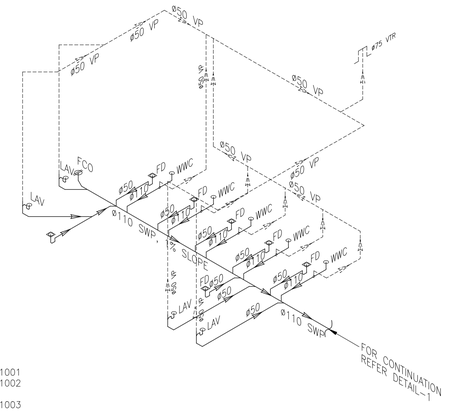


SEWER DRAIN PIPING ISOMETRIC-TOILET 101 (4)
SCALE- NTS

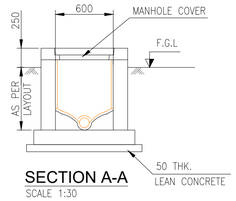


SECTION A-A
SCALE 1:30

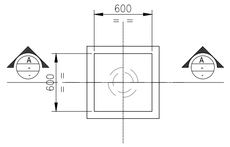


TYPICAL PLAN OF WASTE PIT
SCALE 1:30

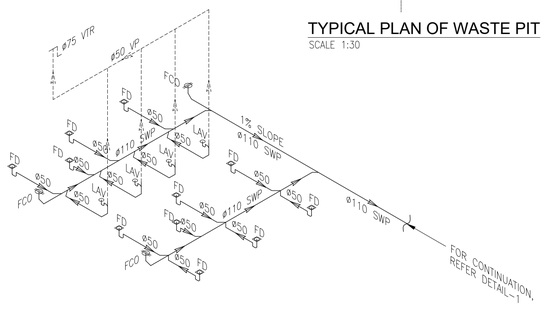

SEWER DRAIN PIPING ISOMETRIC-ABLUTION 102 (5)
SCALE- NTS

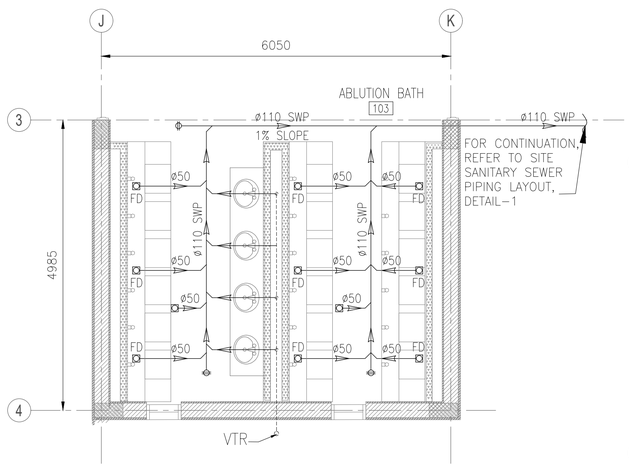


ENLARGED SEWER PIPING LAYOUT-ABLUTION 102 (2)
SCALE- 1:50

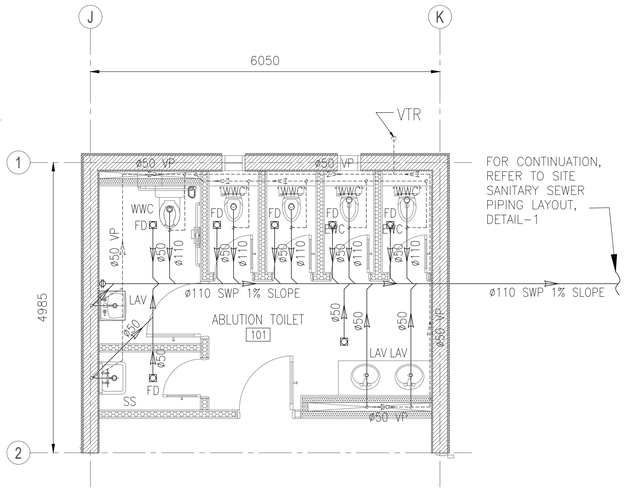


ENLARGED SEWER PIPING LAYOUT-TOILET 101 (3)
SCALE- 1:50

MASTER KEY PLAN

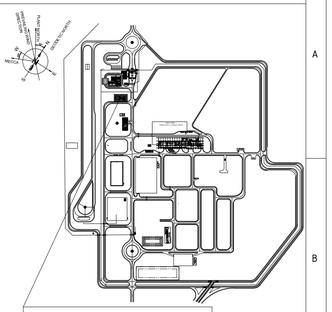

MOSQUE & ABLUTION

BUILDING KEY PLAN

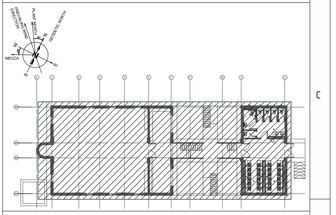

NOTES

1. ALL DIMENSIONS ARE IN MILLIMETERS AND ALL LEVELS ARE GIVEN IN METERS UNLESS OTHERWISE NOTED.
2. ALL DRAWINGS MUST BE READ IN CONJUNCTION WITH ALL OTHER ARCHITECTURAL AND ENGINEERING DRAWINGS RELATED TO THE SAME SHEET AND ANY ITEM ON IT.
3. FOR GRADED FINISHED FLOOR LEVEL (F.F.L) REFER DRAWING NUMBER MD-216-1000-EG-PPD-1002, PLOT PLAN GENERAL PROCESS PLANT LAYOUT.
4. FOR BUILDING SITE SETTING OUT PLAN AND DATA, SEE SURVEYORS/CIVIL DRAWINGS.
5. PLUMBING IN ACCORDANCE TO SBC 701.

LEGEND/ABBREVIATIONS

AC	AIR-CONDITIONING UNIT
FCO	FLOOR CLEAN-OUT
FD	FLOOR DRAIN
GCO	GROUND CLEANOUT
LAV	LAVATORY
SHO	SHOWER
SWP	SANITARY WASTE PIPE
VP	VENT PIPE
WWC	WESTERN WATER CLOSET
ø	DIAMETER

SCALE

0 0.5 1 2 3 4 5 6 7 7.5 METERS
SCALE 1 : 75

DOCUMENT NUMBER	REFERENCE DOCUMENTS	REV	DATE	REVISION DESCRIPTION	DRN	CHK	ENG	APP	EMP
		D01	09/03/2023	AS-BUILT		DRO		SJM	
MD-216-4000-EG-AR-GAD-3019-C01	MOSQUE & ABLUTION: TOILET DETAILS	C03	11/03/2021	ISSUED FOR CONSTRUCTION & REVISED AS MARKED C03		DRO		SJM	
MD-216-4000-EG-AR-GAD-3018-C01	MOSQUE & ABLUTION: BUILDING ELEVATIONS & SECTIONS	C02	16/11/2020	ISSUED FOR CONSTRUCTION & REVISED AS MARKED C02	-	DRO	-	SJM	
MD-216-4010-EG-AR-DGA-0006-C01	VILLAGE SITE & PROCESS AREA: MOSQUE & ABLUTION	C01	28/05/2020	REVISED AS PER EMPLOYER'S COMMENTS DATED 26/05/2020	-	DRO	-	SJM	
MD-216-6000-EG-AR-DA-3123	CIVIL, STRUCTURAL & ARCHITECTURAL DESIGN CRITERIA	A01	01/05/2020	ISSUED FOR REFERENCE	-	DRO	-	SJM	

DESIGNER: مكتب الخليج للاستشارات الهندسية GULF CONSULT ARCHITECTS AND ENGINEERS

DRAWING NUMBER						REVISION
MD-NON-MAA-PL-001						C02
DATE	26/04/2020	DATE	27/04/2020	DATE	28/04/2020	
DRAWN	ABD	CHECKED	ZYD	APPROVED	NILO	

LARSEN & TOUBRO DRAWING NUMBER		REVISION
019045_900_A_G_25004_007		4
OUTOTEC DRAWING NUMBER	DOCUMENT ID	REVISION
900707__GAU01__AN03__MTL01__40002	OU100669232	4

DRAWN	-	-
CHECKED	DRO	30/04/2020
ENGINEER	-	-
APPROVED	SJM	01/05/2020
EMPLOYER		
SCALE	1:100	A1

MANSOURAH - MASSARAH GOLD PROJECT
GENERAL ARRANGEMENT DRAWING
PROCESS AREA: MOSQUE & ABLUTION
PLUMBING & SANITARY DETAILS-1

DRAWING NUMBER: MD - 216 - 4000 - EG - AR - GAD - 3023 | REV: D01

LARSEN & TOUBRO
This drawing is the property of LARSEN & TOUBRO and must not be passed on to any person or body not authorized by us to receive it nor be copied or otherwise made use either in full or in part by such person or body without our prior permission in writing.

Outotec
The content of these documents are the sole property of Outotec Oyj. Any rights not expressly granted herein are reserved. Reproduction, transfer or distribution of part or all of the contents in any form without prior written permission of Outotec is prohibited.

MA'ADEN معادن
Saudi Arabian Mining Company شركة معادن العربية السعودية
This document and the information contained herein is Ma'aden proprietary know-how. This document or any part thereof should not be reproduced, stored in a retrieval system or transmitted by any means, electronic or otherwise, or divulged without prior written permission of Ma'aden.