


DRAWING NUMBER: MD-216-4000-EG-AR-GAD-3024 | REV: D01

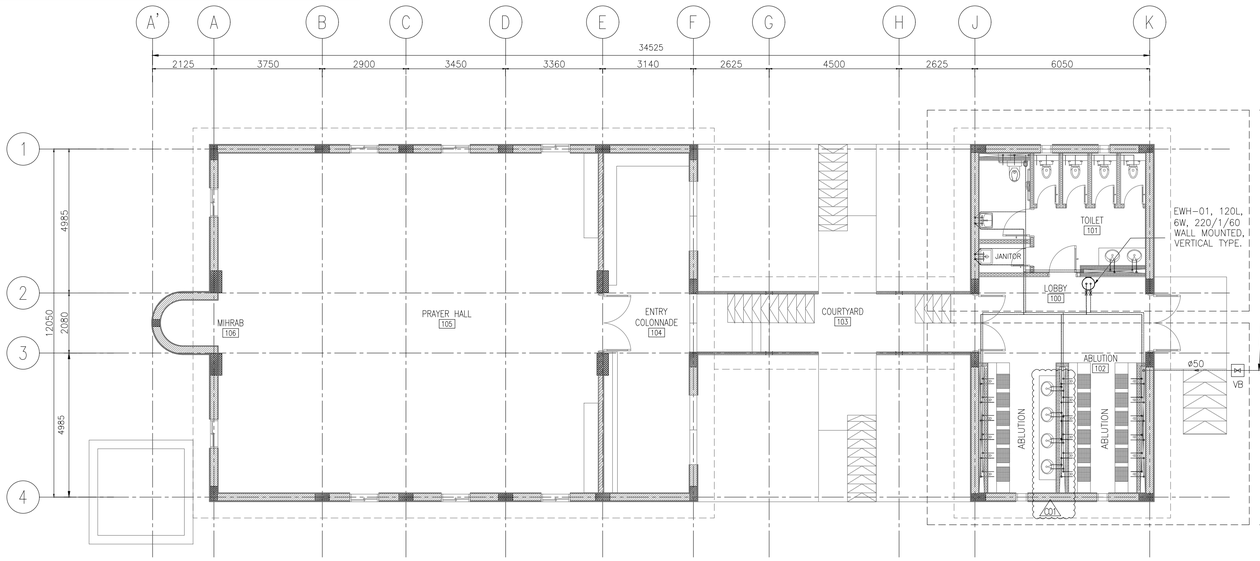


GROUND FLOOR WATER SUPPLY PIPING LAYOUT 1
SCALE- 1:100

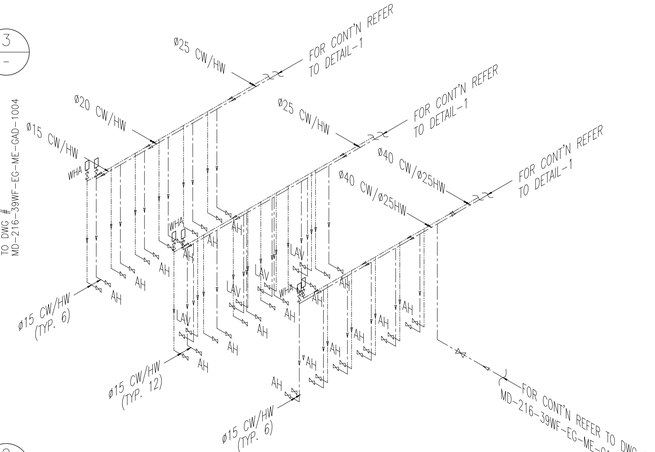


WATER SUPPLY PIPING ISOMETRIC-ABLUTION 102 5
SCALE- NTS

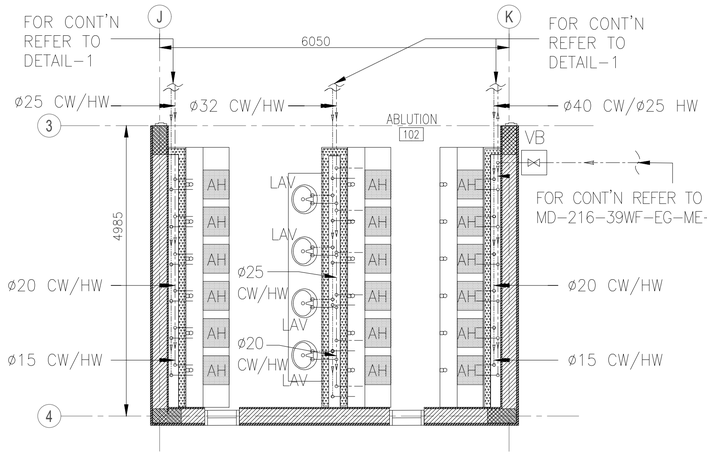

GROUND FLOOR WATER SUPPLY PIPING LAYOUT 2
SCALE- 1:50

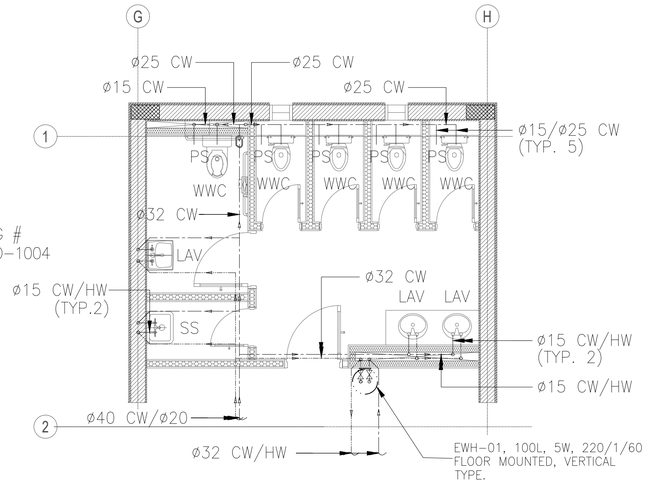


GROUND FLOOR WATER SUPPLY PIPING LAYOUT 3
SCALE- 1:50

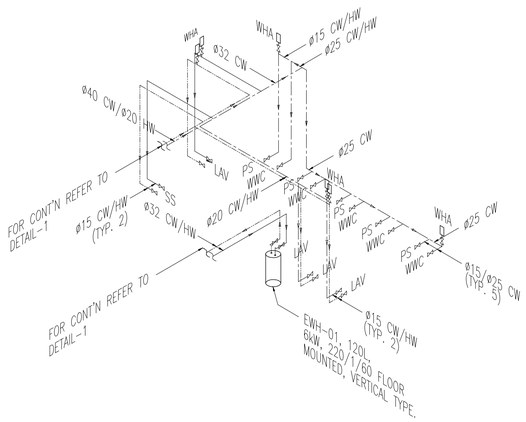


WATER SUPPLY PIPING ISOMETRIC-TOILET 101 4
SCALE- NTS

MASTER KEY PLAN

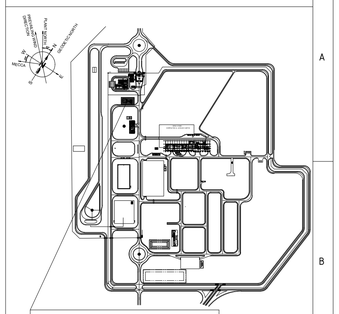

BUILDING KEY PLAN

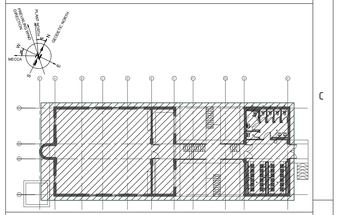

NOTES

1. ALL DIMENSIONS ARE IN MILLIMETERS AND ALL LEVELS ARE GIVEN IN METERS UNLESS OTHERWISE NOTED.
2. ALL DRAWINGS MUST BE READ IN CONJUNCTION WITH ALL OTHER ARCHITECTURAL AND ENGINEERING DRAWINGS RELATED TO THE SAME SHEET AND ANY ITEM ON IT.
3. FOR GRADED FINISHED FLOOR LEVEL (F.F.L) REFER DRAWING NUMBER MD-216-1000-EG-PPD-1002, PLOT PLAN GENERAL PROCESS PLANT LAYOUT.
4. FOR BUILDING SITE SETTING OUT PLAN AND DATA, SEE SURVEYORS/CIVIL DRAWINGS.
5. PLUMBING IN ACCORDANCE TO SBC 701.

LEGEND/ABBREVIATIONS

EWH	ELECTRIC WATER HEATER
CW	COLD WATER SUPPLY
HW	HOT WATER SUPPLY
PS	PERENIAL SPRAY
LAV	LAVATORY
SHO	SHOWER
WHA	WATER HAMMER ARRESTOR
WWC	WESTERN WATER CLOSET
ø	DIAMETER

SCALE

0 0.5 1 2 3 4 5 6 7 7.5
SCALE 1 : 75
METERS

DOCUMENT NUMBER	REFERENCE DOCUMENTS	REV	DATE	REVISION DESCRIPTION	DRN	CHK	ENG	APP	EMP
MD-216-4000-EG-AR-GAD-3019-C01	MOSQUE & ABLUTION: TOILET DETAILS	D01	09/03/2023	AS-BUILT	-	DRO	-	SJM	
MD-216-4000-EG-AR-GAD-3018-C01	MOSQUE & ABLUTION: BUILDING ELEVATIONS & SECTIONS	C02	16/11/2020	ISSUED FOR CONSTRUCTION & REVISED AS MARKED (C02)	-	DRO	-	SJM	
MD-216-4010-EG-AR-DGA-0006-C01	VILLAGE SITE & PROCESS AREA: MOSQUE & ABLUTION	C01	28/05/2020	REVISED AS PER EMPLOYER'S COMMENTS DATED 26/05/2020	-	DRO	-	SJM	
MD-216-6000-EG-AR-DA-3123	CIVIL, STRUCTURAL & ARCHITECTURAL DESIGN CRITERIA	A01	01/05/2020	ISSUED FOR REFERENCE	-	DRO	-	SJM	

DESIGNER: مكتب الخليج للاستشارات الهندسية, الجبيل, المملكة العربية السعودية — GULF CONSULT ARCHITECTS AND ENGINEERS

LARSEN & TOUBRO
This drawing is the property of LARSEN & TOUBRO and must not be passed on to any person or body not authorized by us to receive it nor be copied or otherwise made use either in full or in part by such person or body without our prior permission in writing.

Outotec
The content of these documents are the sole property of Outotec Oyj. Any rights not expressly granted herein are reserved. Reproduction, transfer or distribution of part or all of the contents in any form without prior written permission of Outotec is prohibited.

MA'ADEN معادن
Saudi Arabian Mining Company شركة معادن العربية السعودية
This document and the information contained herein is Ma'aden proprietary know-how. This document or any part thereof should not be reproduced, stored in a retrieval system or transmitted by any means, electronic or otherwise, or divulged without prior written permission of Ma'aden.

DRAWING NUMBER	MD-NON-MAA-PL-002	REVISION	C02
DATE	26/04/2020	DATE	27/04/2020
DRAWN	ABD	CHECKED	ZYD
DATE	28/04/2020	APPROVED	NILO

LARSEN & TOUBRO DRAWING NUMBER	019045_900_A_G_25004_008	REVISION	3
OUTOTEC DRAWING NUMBER	900707__GAU01__AN03__MTL01__40001	DOCUMENT ID	OU100669231
		REVISION	3

DRAWN	-	-	
CHECKED	DRO	30/04/2020	
ENGINEER	-	-	
APPROVED	SJM	01/05/2020	
EMPLOYER			
SCALE	1:100	A1	

MANSOURAH - MASSARAH GOLD PROJECT
GENERAL ARRANGEMENT DRAWING
PROCESS AREA: MOSQUE & ABLUTION
PLUMBING & SANITARY DETAILS-2

DRAWING NUMBER: MD-216-4000-EG-AR-GAD-3024 | REV: D01