


DRAWING NUMBER: MD-216-4000-EG-AR-GAD-3038 | REV: D01

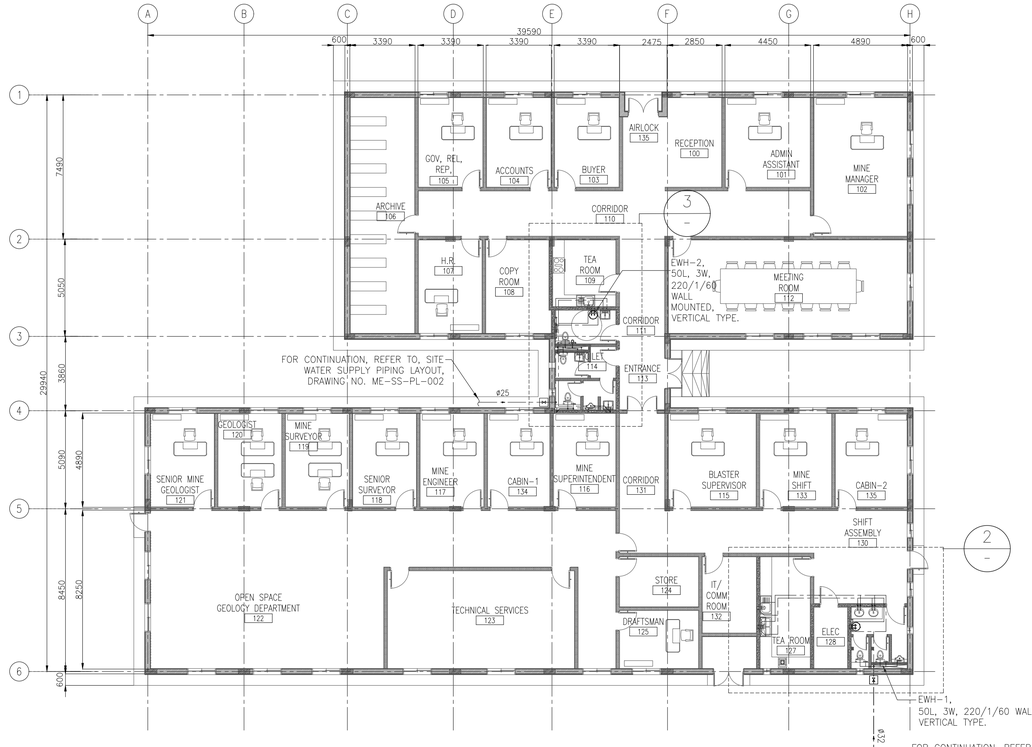


GROUND FLOOR WATER SUPPLY PIPING LAYOUT — 1
SCALE- 1:150

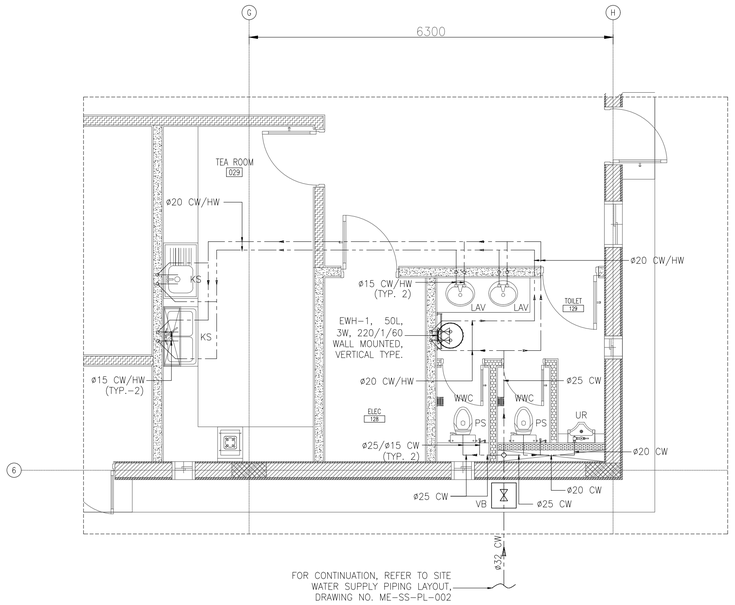


ENLARGED WATER SUPPLY PIPING LAYOUT — 2
SCALE- 1:75

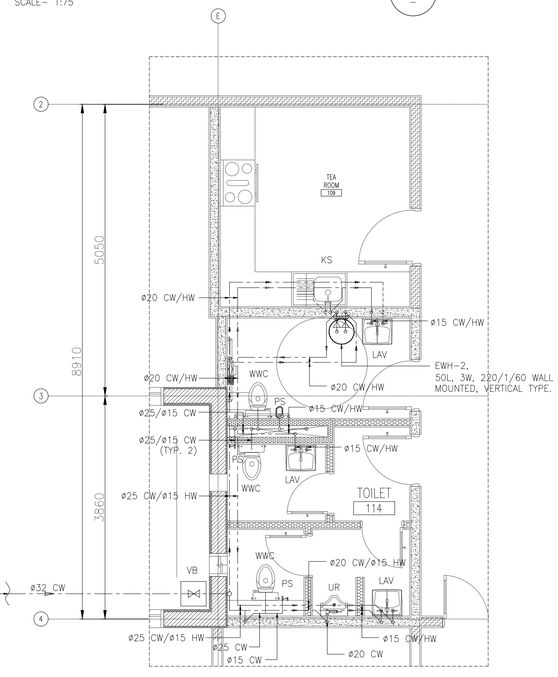


WATER SUPPLY PIPING ISOMETRIC-TOILET/TEA RM — 5
SCALE- NTS

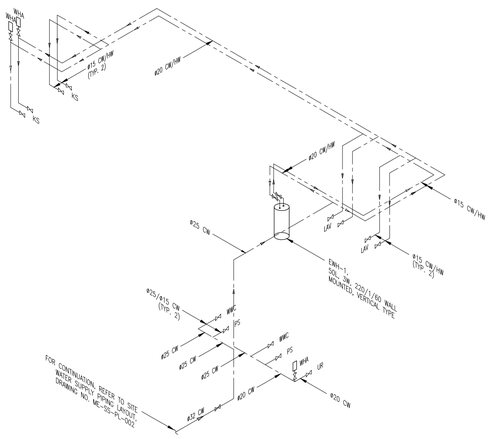


WATER SUPPLY PIPING ISOMETRIC-TOILET 114 — 4
SCALE- NTS

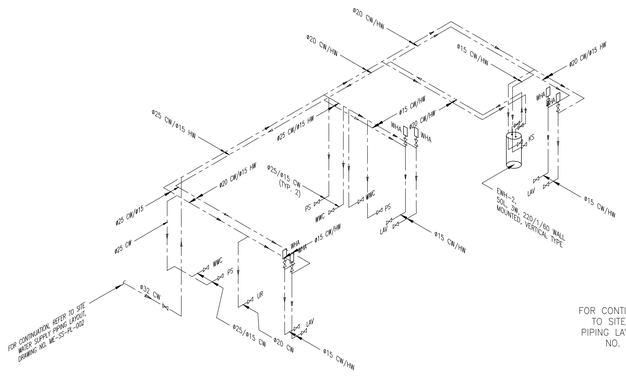

MASTER KEY PLAN

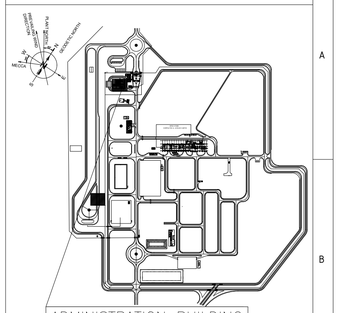

BUILDING KEY PLAN

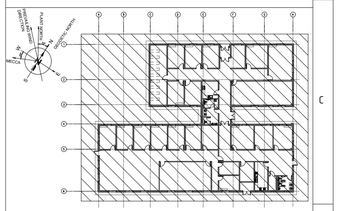

NOTES

1. ALL DIMENSIONS ARE IN MILLIMETERS AND ALL LEVELS ARE GIVEN IN METERS UNLESS OTHERWISE NOTED.
2. ALL DRAWINGS MUST BE READ IN CONJUNCTION WITH ALL OTHER ARCHITECTURAL AND ENGINEERING DRAWINGS RELATED TO THE SAME SHEET AND ANY ITEM ON IT.
3. FOR GRADED FINISHED FLOOR LEVEL (F.F.L) REFER DRAWING NUMBER 'MD-216-1000-EG-PPD-1002, PLOT PLAN GENERAL PROCESS PLANT LAYOUT.
4. FOR BUILDING SITE SETTING OUT PLAN AND DATA, SEE SURVEYORS/CIVIL DRAWINGS.
5. PLUMBING IN ACCORDANCE TO SBC 701.

LEGEND/ABBREVIATIONS

KS	KITCHEN SINK
FD	FLOOR DRAIN
WWC	WESTERN WATER CLOSET
CW	COLD WATER
HW	HOT WATER
UR	URINAL

0 1 2 3 4 5 6 7 8 9 10 METERS
SCALE 1 : 100

DOCUMENT NUMBER	REFERENCE DOCUMENTS	REV	DATE	REVISION DESCRIPTION	DRN	CHK	ENG	APP	EMP
MD-216-4000-EG-AR-GAD-3032-C01	ADMINISTRATION BUILDING: TOILET DEATILS-2								
MD-216-4000-EG-AR-GAD-3031-C01	ADMINISTRATION BUILDING: TOILET DEATILS-1								
MD-216-4000-EG-AR-GAD-3030-C01	ADMINISTRATION BUILDING: BUILDING ELEVATIONS & SECTIONS	D01	09/03/2023	AS-BUILT	-	DRO	-	SJM	
MD-216-3010-EG-AR-DGA-0001-C01	PROCESS AREA : ADMINISTRATION BUILDING	C01	25/05/2020	ISSUED FOR CONSTRUCTION	-	DRO	-	SJM	
MD-216-1000-EG-ST-CRT-1001	CIVIL, STRUCTURAL & ARCHITECTURAL DESIGN CRITERIA	A01	28/04/2020	ISSUED FOR REFERENCE	-	DRO	-	SJM	

DESIGNER: مكتب الفارج للاستشارات الهندسية — GULF CONSULT ARCHITECTS AND ENGINEERS

DRAWING NUMBER					REVISION
MD-NON-ADMIN-PL-001					C01
DATE	22/04/2020	DATE	23/04/2020	DATE	26/04/2020
DRAWN	ABD	CHECKED	ZYD	APPROVED	NILO

LARSEN & TOUBRO DRAWING NUMBER: O19045_900_A_G_25006_012 — REVISION: 2
OUTOTEC DRAWING NUMBER: 900707__GAU01__AN03__MTL01__40011 — DOCUMENT ID: OU100669241 — REVISION: 2

LARSEN & TOUBRO
This drawing is the property of LARSEN & TOUBRO and must not be passed on to any person or body not authorized by us to receive it nor be copied or otherwise made use either in full or in part by such person or body without our prior permission in writing.

Outotec
The content of these documents are the sole property of Outotec Oyj. Any rights not expressly granted herein are reserved. Reproduction, transfer or distribution of part or all of the contents in any form without prior written permission of Outotec is prohibited.

MA'ADEN معادن
Saudi Arabian Mining Company شركة التعدين العربية السعودية
This document and the information contained herein is Ma'aden proprietary know-how. This document or any part thereof should not be reproduced, stored in a retrieval system or transmitted by any means, electronic or otherwise, or divulged without prior written permission of Ma'aden.

DRAWN	-	-	MANSOURAH - MASSARAH GOLD PROJECT
CHECKED	DRO	27/04/2020	GENERAL ARRANGEMENT
ENGINEER	-	-	PROCESS AREA : ADMINISTRATION BUILDING
APPROVED	SJM	28/04/2020	PLUMBING & SANITARY DETAILS-2
EMPLOYER			
SCALE	1:150	A1	DRAWING NUMBER: MD-216-4000-EG-AR-GAD-3038 — REV: D01