


DRAWING NUMBER MD-216-4000-EG-AR-GAD-3049 REV D01

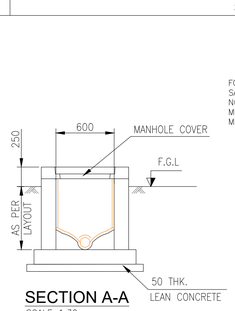


SECTION A-A
SCALE 1:30

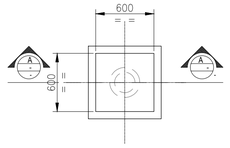


TYPICAL PLAN OF WASTE PIT
SCALE 1:30

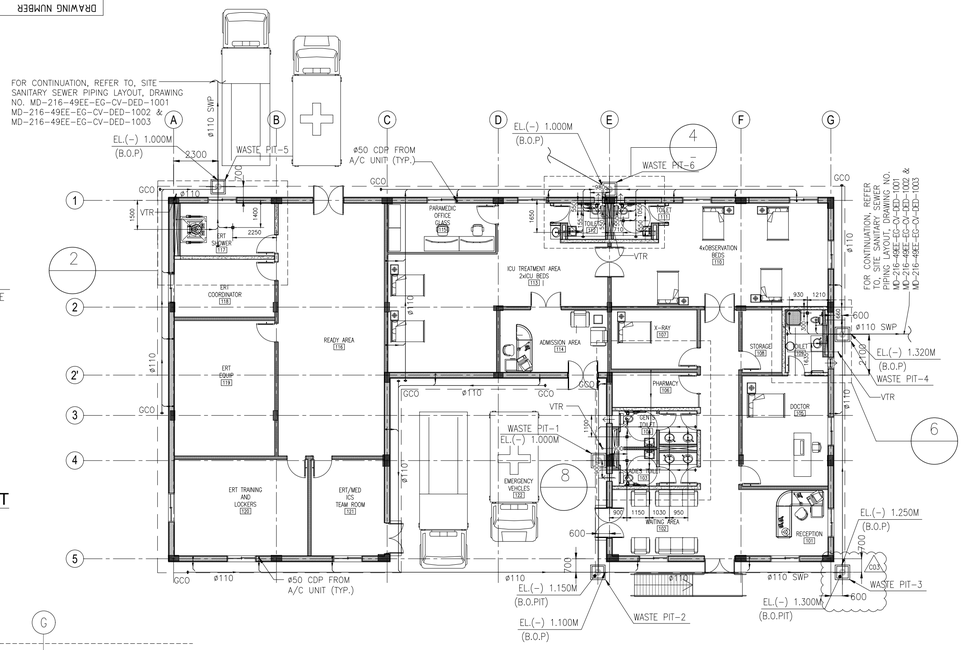


GROUND FLOOR SEWER DRAIN PIPING LAYOUT 1
SCALE- 1:150

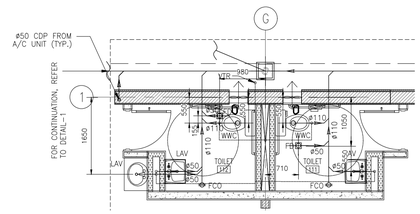


SEWER DRAIN PIPING LAYOUT - TOILETS 111 & 112 4
SCALE- 1:75

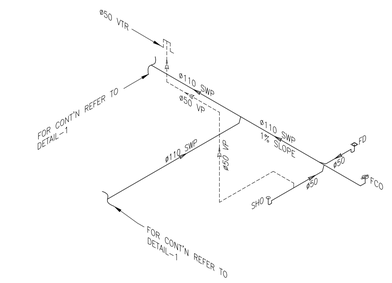


SEWER DRAIN PIPING ISOMETRIC-SHOWER 117 3
SCALE- NTS

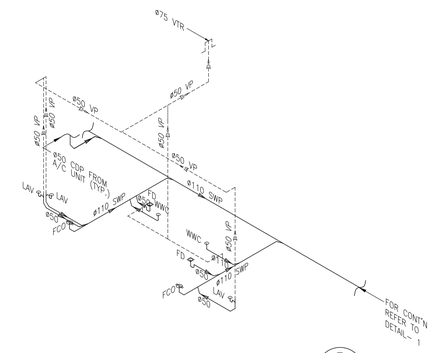


SEWER DRAIN PIPING ISOMETRIC-TOILETS 111 & 112 5
SCALE- NTS

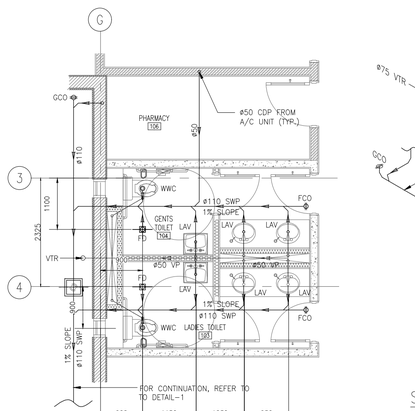


SEWER DRAIN PIPING LAYOUT - TOILET 103 & 104 8
SCALE- 1:75

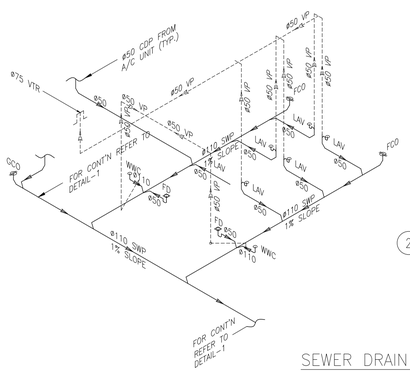


SEWER DRAIN PIPING ISOMETRIC - TOILET 103 & 104 9
SCALE- NTS

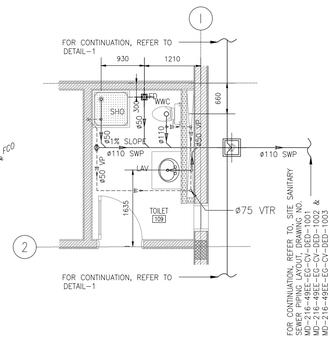

SEWER DRAIN PIPING LAYOUT-TOILET 109 6
SCALE- 1:75

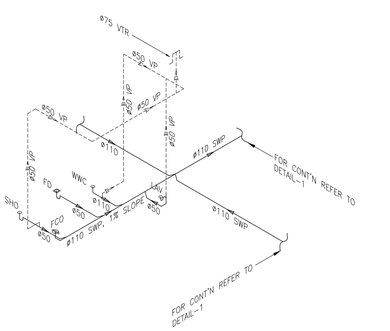


SEWER DRAIN PIPING ISOMETRIC-TOILET 109 7
SCALE- NTS

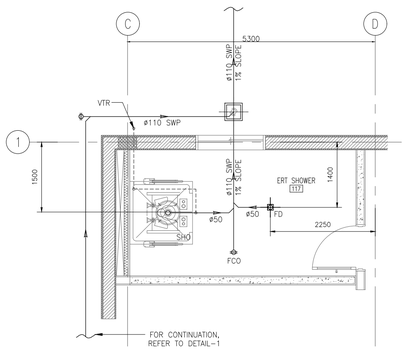


SEWER DRAIN PIPING LAYOUT-SHOWER 117 2
SCALE- 1:75

MASTER KEY PLAN

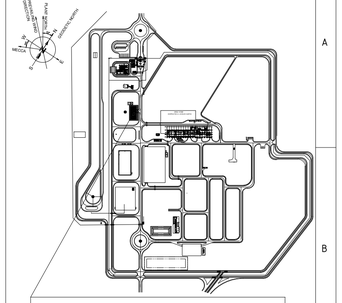

BUILDING KEY PLAN

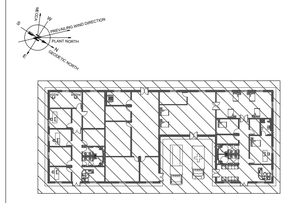

NOTES

1. ALL DIMENSIONS ARE IN MILLIMETERS AND ALL LEVELS ARE GIVEN IN METERS UNLESS OTHERWISE NOTED.
2. ALL DRAWINGS MUST BE READ IN CONJUNCTION WITH ALL OTHER ARCHITECTURAL AND ENGINEERING DRAWINGS RELATED TO THE SAME SHEET AND ANY ITEM ON IT.
3. FOR GRADED FINISHED FLOOR LEVEL (F.F.L) REFER DRAWING NUMBER MD-216-1000-EG-PPD-1002, PLOT PLAN GENERAL PROCESS PLANT LAYOUT.
4. FOR BUILDING SITE SETTING OUT PLAN AND DATA, SEE SURVEYORS/CIVIL DRAWINGS.
5. PLUMBING IN ACCORDANCE TO SBC 701.

LEGEND/ABBREVIATIONS

AC	AIR-CONDITIONING UNIT
FCO	FLOOR CLEAN-OUT
FD	FLOOR DRAIN
GCO	GROUND CLEANOUT
LAV	LAVATORY
SHO	SHOWER
SWP	SANITARY WASTE PIPE
VP	VENT PIPE
WWC	WESTERN WATER CLOSET
ø	DIAMETER

0 1 2 3 4 5 6 7 8 9 10
SCALE 1 : 100 METERS

DOCUMENT NUMBER	REFERENCE DOCUMENTS	REV	DATE	REVISION DESCRIPTION	DRN	CHK	ENG	APP	EMP
MD-216-4000-EG-AR-GAD-3047-A01	EMERGENCY SERVICES BUILLDING: TOILET DETAILS-2	D01	09/03/2023	AS-BUILT		DRO		SJM	
MD-216-4000-EG-AR-GAD-3046-A01	EMERGENCY SERVICES BUILLDING: TOILET DETAILS-1	C03	07/03/2021	ISSUED FOR CONSTRUCTION & REVISED AS MARKED C03		DRO		SJM	
MD-216-4000-EG-AR-GAD-3045-A01	EMERGENCY SERVICES BUILDING: BUILDING ELEVATIONS & SECTIONS	C02	22/09/2020	ISSUED FOR CONSTRUCTION & REVISED AS MARKED C02	-	DRO	-	SJM	
MD-216-3010-EG-AR-DGA-0002-C01	PROCESS AREA: EMERGENCY SERVICES BUILDING	C01	05/06/2020	ISSUED FOR CONSTRUCTION	-	DRO	-	SJM	
MD-216-1000-EG-ST-CRT-1001	CIVIL, STRUCTURAL & ARCHITECTURAL DESIGN CRITERIA	A01	02/05/2020	ISSUED FOR REFERENCE	-	DRO	-	SJM	

DESIGNER: مكتب الخليج للاستشارات الهندسية GULF CONSULT ARCHITECTS AND ENGINEERS

DRAWING NUMBER		REVISION
MD-NPB-ESB-PL-001		C02
DATE 26/04/2020	DATE 27/04/2020	DATE 28/04/2020
DRAWN ABD	CHECKED ZYD	APPROVED NILO

LARSEN & TOUBRO

This drawing is the property of LARSEN & TOUBRO and must not be passed on to any person or body not authorized by us to receive it nor be copied or otherwise made use either in full or in part by such person or body without our prior permission in writing.

Outotec

The content of these documents are the sole property of Outotec Oyj. Any rights not expressly granted herein are reserved. Reproduction, transfer or distribution of part or all of the contents in any form without prior written permission of Outotec is prohibited.

MA'ADEN معادن Saudi Arabian Mining Company شركة معادن العربية السعودية

This document and the information contained herein is Ma'aden proprietary know-how. This document or any part thereof should not be reproduced, stored in a retrieval system or transmitted by any means, electronic or otherwise, or divulged without prior written permission of Ma'aden.

LARSEN & TOUBRO DRAWING NUMBER		REVISION
O19045_900_A_G_25008_007		4
OUTOTEC DRAWING NUMBER	DOCUMENT ID	REVISION
900707__GAU01__AN03__MTL01__40027	OU100669257	4

DRAWN	-	-
CHECKED	DRO	30/04/2020
ENGINEER	-	-
APPROVED	SJM	02/05/2020
EMPLOYER		
SCALE	1:100	A1

MANSOURAH - MASSARAH GOLD PROJECT
GENERAL ARRANGEMENT DRAWING
PROCESS AREA: EMERGENCY SERVICES BUILDING
PLUMBING & SANITARY DETAILS-1

DRAWING NUMBER MD-216-4000-EG-AR-GAD-3049 REV D01