


DRAWING NUMBER: MD-216-4000-EG-AR-GAD-3050 | REV: D01

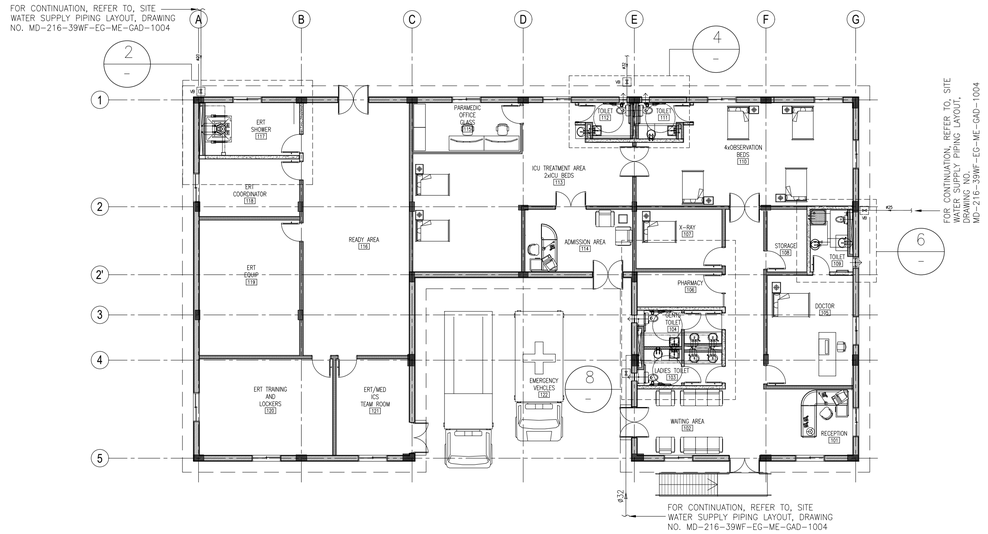


GROUND FLOOR WATER SUPPLY PIPING LAYOUT — 1
SCALE– 1:150

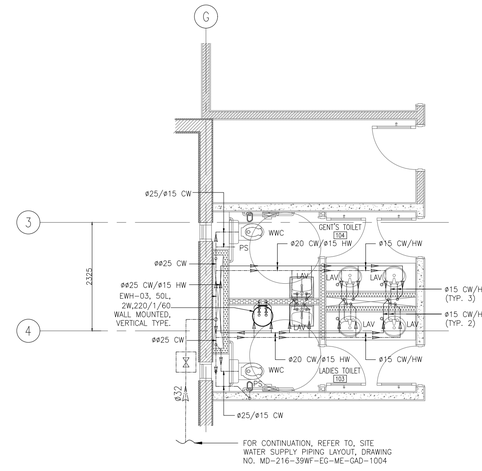


WATER SUPPLY PIPING LAYOUT–TOILET 103 & 104 — 8
SCALE– 1:75

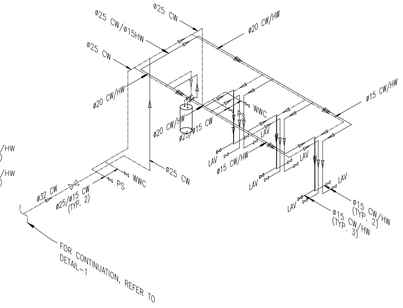


WATER SUPPLY PIPING ISOMETRIC–TOILET 103 & 104 — 9
SCALE– NTS

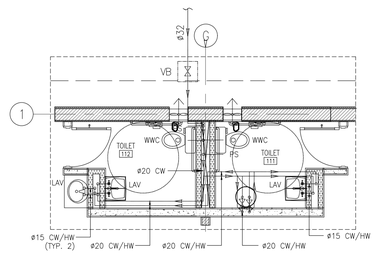


WATER SUPPLY PIPING LAYOUT–TOILETS 111 & 112 — 4
SCALE– 1:75

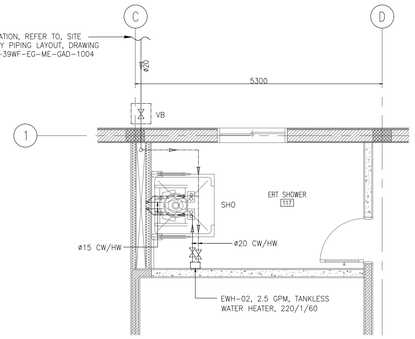


WATER SUPPLY PIPING LAYOUT–SHOWER 117 — 2
SCALE– 1:75

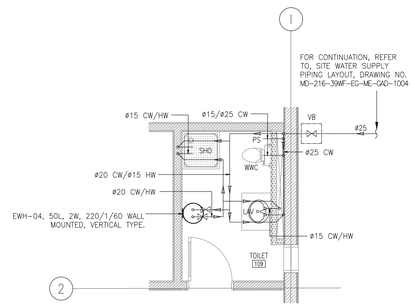


WATER SUPPLY PIPING LAYOUT–TOILET 109 — 6
SCALE– 1:75

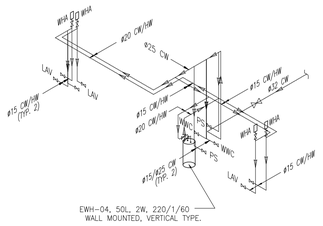

WATER SUPPLY PIPING ISOMETRIC–TOILETS 111 & 112 — 5
SCALE– NTS

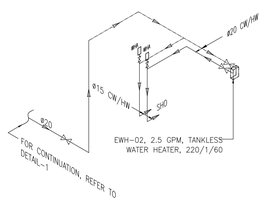


ISOMETRIC–SHOWER 117 — 3
SCALE– NTS

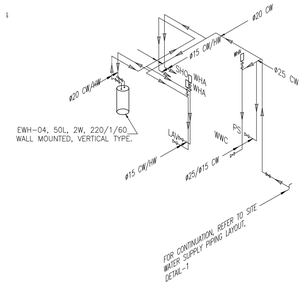


WATER SUPPLY PIPING ISOMETRIC–TOILET 109 — 7
SCALE– NTS

MASTER KEY PLAN

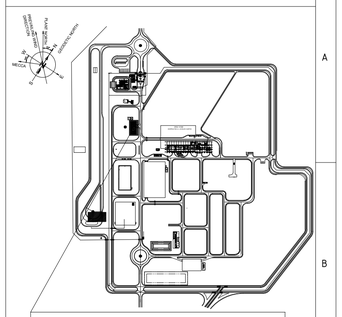

BUILDING KEY PLAN

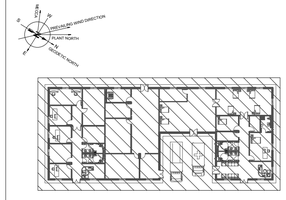

NOTES

1. ALL DIMENSIONS ARE IN MILLIMETERS AND ALL LEVELS ARE GIVEN IN METERS UNLESS OTHERWISE NOTED.
2. ALL DRAWINGS MUST BE READ IN CONJUNCTION WITH ALL OTHER ARCHITECTURAL AND ENGINEERING DRAWINGS RELATED TO THE SAME SHEET AND ANY ITEM ON IT.
3. FOR GRADED FINISHED FLOOR LEVEL (F.F.L) REFER DRAWING NUMBER MD-216-1000-EG-PPD-1002, PLOT PLAN GENERAL PROCESS PLANT LAYOUT.
4. FOR BUILDING SITE SETTING OUT PLAN AND DATA, SEE SURVEYORS/CIVIL DRAWINGS.
5. PLUMBING IN ACCORDANCE TO SBC 701.

LEGEND/ABBREVIATIONS

EWH	ELECTRIC WATER HEATER
CW	COLD WATER SUPPLY
HW	HOT WATER SUPPLY
PS	PERENIAL SPRAY
LAV	LAVATORY
SHO	SHOWER
WHA	WATER HAMMER ARRESTOR
WWC	WESTERN WATER CLOSET
ø	DIAMETER

0 1 2 3 4 5 6 7 8 9 10
SCALE 1 : 100 METERS

DOCUMENT NUMBER	REFERENCE DOCUMENTS	REV	DATE	REVISION DESCRIPTION	DRN	CHK	ENG	APP	EMP
MD-216-4000-EG-AR-GAD-3047-A01	EMERGENCY SERVICES BUILLDING: TOILET DETAILS-2								
MD-216-4000-EG-AR-GAD-3046-A01	EMERGENCY SERVICES BUILLDING: TOILET DETAILS-1	D01	09/03/2023	AS-BUILT	-	DRO	-	SJM	
MD-216-4000-EG-AR-GAD-3045-A01	EMERGENCY SERVICES BUILDING: BUILDING ELEVATIONS & SECTIONS	C02	22/09/2020	ISSUED FOR CONSTRUCTION & REVISED AS MARKED (002)	-	DRO	-	SJM	
MD-216-3010-EG-AR-DGA-0002-C01	PROCESS AREA: EMERGENCY SERVICES BUILDING	C01	05/06/2020	REVISED AS PER EMPLOYER'S COMMENTS DATED 29/05/2020	-	DRO	-	SJM	
MD-216-1000-EG-ST-CRT-1001	CIVIL, STRUCTURAL & ARCHITECTURAL DESIGN CRITERIA	A01	02/05/2020	ISSUED FOR REFERENCE	-	DRO	-	SJM	

DESIGNER: مكتب الخليج للاستشارات الهندسية GULF CONSULT ARCHITECTS AND ENGINEERS

DRAWING NUMBER: MD-NPB-ESB-PL-002 | REVISION: C02

DRAWN	DATE	CHECKED	DATE	APPROVED	DATE
ABD	26/04/2020	ZYD	27/04/2020	NILO	28/04/2020

LARSEN & TOUBRO DRAWING NUMBER: 019045_900_A_G_25008_008 | REVISION: 3

OUTOTEC DRAWING NUMBER: 900707 __GAU01 __AN03__MTL01 __40049 | DOCUMENT ID: OU100683326 | REVISION: 3

LARSEN & TOUBRO

This drawing is the property of LARSEN & TOUBRO and must not be passed on to any person or body not authorized by us to receive it nor be copied or otherwise made use either in full or in part by such person or body without our prior permission in writing.

Outotec

The content of these documents are the sole property of Outotec Oyj. Any rights not expressly granted herein are reserved. Reproduction, transfer or distribution of part or all of the contents in any form without prior written permission of Outotec is prohibited.

MA'ADEN معادن — Saudi Arabian Mining Company شركة معادن العربية السعودية

This document and the information contained herein is Ma'aden proprietary know-how. This document or any part thereof should not be reproduced, stored in a retrieval system or transmitted by any means, electronic or otherwise, or divulged without prior written permission of Ma'aden.

DRAWN	-	-
CHECKED	DRO	30/04/2020
ENGINEER	-	-
APPROVED	SJM	02/05/2020
EMPLOYER		
SCALE	1:100	A1

MANSOURAH - MASSARAH GOLD PROJECT
GENERAL ARRANGEMENT DRAWING
PROCESS AREA: EMERGENCY SERVICES BUILDING
PLUMBING & SANITARY DETAILS-2

DRAWING NUMBER: MD - 216 - 4000 - EG - AR - GAD - 3050 | REV: D01