


DRAWING NUMBER: MD-216-4000-EG-AR-GAD-3052 | REV: D01

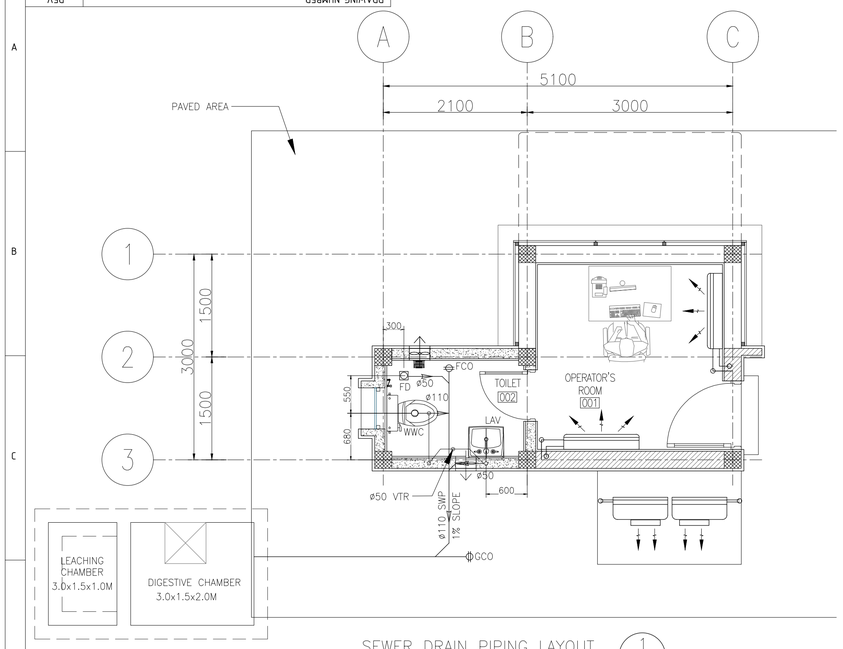


SEWER DRAIN PIPING LAYOUT (1) — SCALE– 1:30

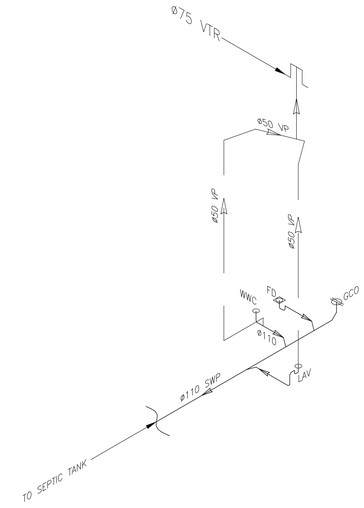


SEWER DRAIN PIPING ISOMETRIC (2) — SCALE– NTS

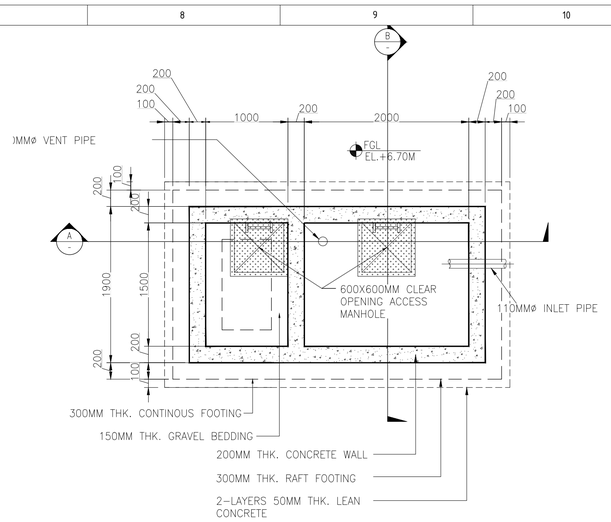


SEPTIC TANK FLOOR PLAN (5) — SCALE– NTS

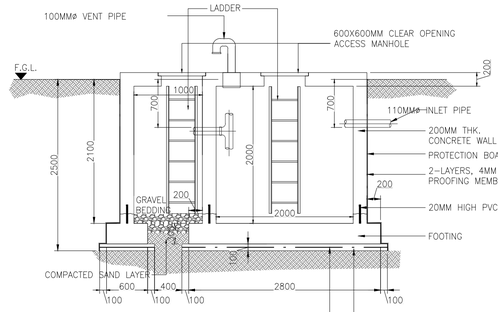


SEPTIC TANK SECTION–A (6) — SCALE– NTS

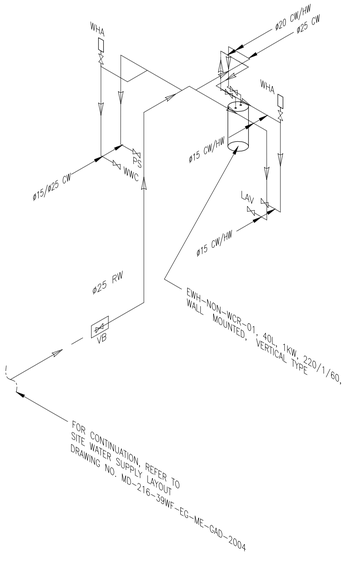

WATER SUPPLY PIPING ISOMETRIC (4) — SCALE– NTS

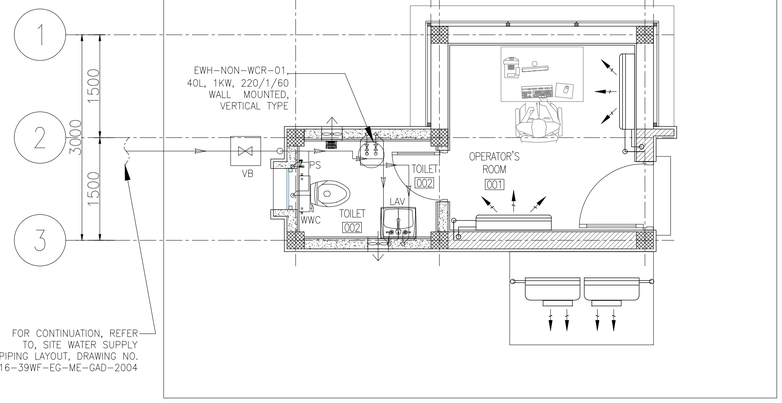


WATER SUPPLY PIPING LAYOUT (3) — SCALE– 1:30

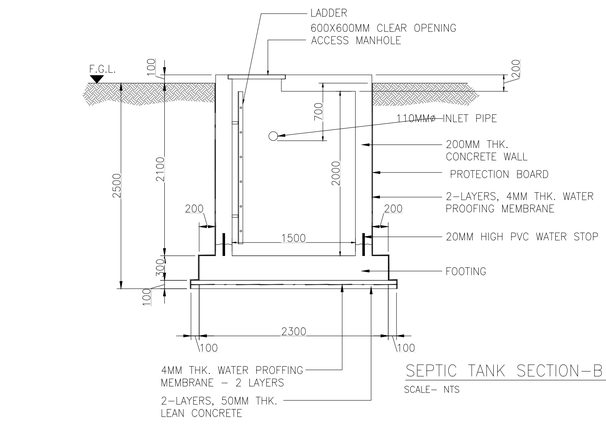


SEPTIC TANK SECTION–B (7) — SCALE– NTS

MASTER KEY PLAN

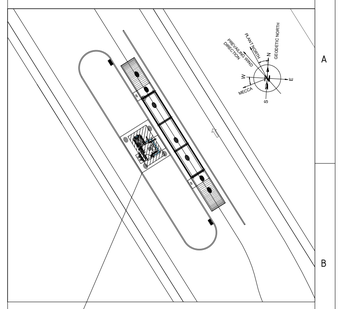

BUILDING KEY PLAN

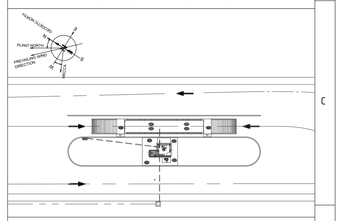

NOTES

1. ALL DIMENSIONS ARE IN MILLIMETRES AND ALL LEVELS ARE GIVEN IN METRES UNLESS OTHERWISE NOTED.
2. ALL DRAWINGS MUST BE READ IN CONJUNCTION WITH ALL OTHER ARCHITECTURAL AND ENGINEERING DRAWINGS RELATED TO THE SAME SHEET AND ANY ITEM ON IT.
3. FOR GRADED FINISHED FLOOR LEVEL (F.F.L) REFER DRAWING NUMBER MD–216–1000–EG–PPD–1002/ MD–216–1800–EG–CV–GAD–1565., PLOT PLAN GENERAL PROCESS PLANT LAYOUT.
4. FOR BUILDING SITE SETTING OUT PLAN AND DATA, SEE SURVEYORS/CIVIL DRAWINGS.
5. PLUMBING IN ACCORDANCE TO SBC 701.

LEGEND

EWH	ELECTRIC WATER HEATER
CW	COLD WATER SUPPLY
HW	HOT WATER SUPPLY
PS	PERENIAL SPRAY
LAV	LAVATORY
SHO	SHOWER
WHA	WATER HAMMER ARRESTOR
WWC	WESTERN WATER CLOSET
ø	DIAMETER
VB	VALVE BOX
F.G.L	FINISHED GROUND LEVEL
E.L.	ELEVATION
THK.	THICK
SWP	SOIL AND WASTE PIPE
VTR	VENT PIPE

DOCUMENT NUMBER	REFERENCE DOCUMENTS	REV	DATE	REVISION DESCRIPTION	DRN	CHK	ENG	APP	EMP
		D01	09/03/2023	AS-BUILT	–	DRO	–	SJM	
		C01	08/01/2021	ISSUED FOR CONSTRUCTION	–	DRO	–	SJM	
		A05	03/12/2020	ISSUED FOR REVIEW & REVISED AS PER EMPLOYER'S COMMENTS DATED 07/10/2020 & AS MARKED A05	–	DRO	–	SJM	
		A04	03/11/2020	REVISED AS PER EMPLOYER'S COMMENTS DATED 07/10/2020	–	DRO	–	SJM	
		A03	10/09/2020	REVISED AS PER EMPLOYER'S COMMENTS DATED 01/09/2020	–	DRO	–	SJM	
MD-216-4000-EG-AR-GAD-3051	WEIGHBRIDGE C.R.- PLAN, ELEVATIONS, SECTIONS & DETAILS	A02	05/08/2020	REVISED AS PER EMPLOYER'S COMMENTS DATED 31/07/2020	–	DRO	–	SJM	
MD-216-1000-EG-ST-CRT-1001	CIVIL, STRUCTURAL AND ARCHITECTURAL DESIGN CRITERIA	A01	07/07/2020	ISSUED FOR REFERENCE	–	DRO	–	SJM	

DESIGNER: مكتب الخليج للاستشارات الهندسية — GULF CONSULT ARCHITECTS AND ENGINEERS

DRAWING NUMBER						REVISION
AR-NON-WCR-PL-001						A05
DATE	16/06/2020	DATE	18/06/2020	DATE	22/06/2020	
DRAWN	ABD	CHECKED	ZYD	APPROVED	NILO	

LARSEN & TOUBRO DRAWING NUMBER: 019045_900_A_G_25009_002 — REVISION: 6

OUTOTEC DRAWING NUMBER: 900707__GAU01__AN03__MTL01__40082 — DOCUMENT ID: OU100689034 — REVISION: 6

LARSEN & TOUBRO

This drawing is the property of LARSEN & TOUBRO and must not be passed on to any person or body not authorized by us to receive it nor be copied or otherwise made use either in full or in part by such person or body without our prior permission in writing.

Outotec

The content of these documents are the sole property of Outotec Oyj. Any rights not expressly granted herein are reserved. Reproduction, transfer or distribution of part or all of the contents in any form without prior written permission of Outotec is prohibited.

MA'ADEN معادن — Saudi Arabian Mining Company شركة معادن العربية السعودية

This document and the information contained herein is Ma'aden proprietary know-how. This document or any part thereof should not be reproduced, stored in a retrieval system or transmitted by any means, electronic or otherwise, or divulged without prior written permission of Ma'aden.

DRAWN	–	–	MANSOURAH - MASSARAH GOLD PROJECT
CHECKED	DRO	06/07/2020	GENERAL ARRANGEMENT DRAWING
ENGINEER	–	–	PROCESS AREA- WEIGHBRIDGE CONTROL ROOM
APPROVED	SJM	07/07/2020	PLUMBING & SANITARY DETAILS
EMPLOYER			
SCALE	1:30	A1	

DRAWING NUMBER: MD – 216 – 4000 – EG– AR–GAD – 3052 — REV: D01