

DRAWING NUMBER: MD-216-4000-EG-AR-GAD-3053 | REV: D01




SEWER DRAIN PIPING LAYOUT (1)
SCALE- 1:75

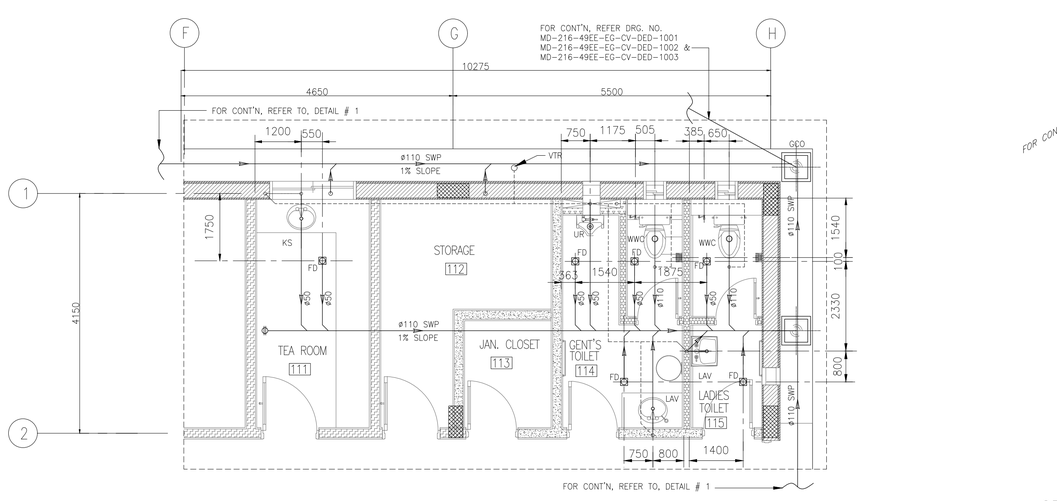


ENLARGED SEWER DRAIN PIPING LAYOUT (2)
SCALE- 1:50

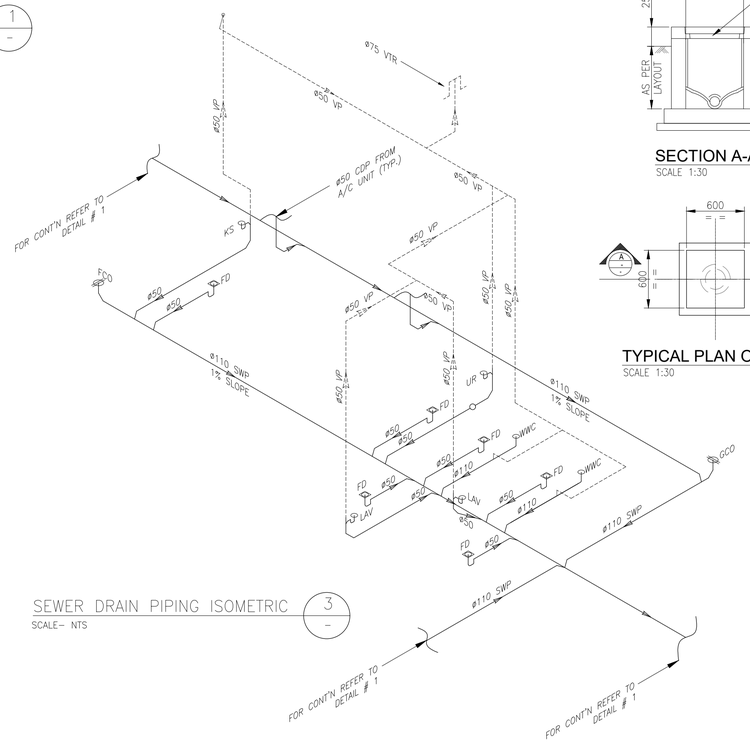

SEWER DRAIN PIPING ISOMETRIC (3)
SCALE- NTS

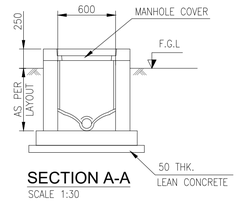


SECTION A-A
SCALE 1:30

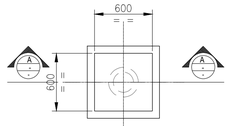


TYPICAL PLAN OF WASTE PIT
SCALE 1:30

MASTER KEY PLAN

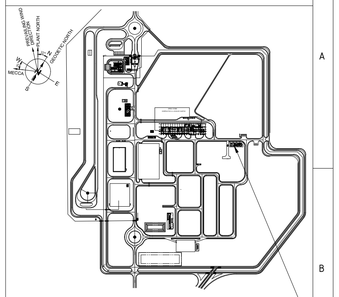

ENGINEERING OFFICE CUM CCR

BUILDING KEY PLAN

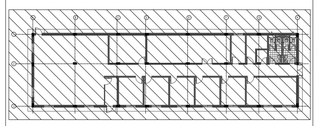


NOTES

1. ALL DIMENSIONS ARE IN MILLIMETERS AND ALL LEVELS ARE GIVEN IN METERS UNLESS OTHERWISE NOTED.
2. ALL DRAWINGS MUST BE READ IN CONJUNCTION WITH ALL OTHER ARCHITECTURAL AND ENGINEERING DRAWINGS RELATED TO THE SAME SHEET AND ANY ITEM ON IT.
3. FOR GRADED FINISHED FLOOR LEVEL (F.F.L) REFER DRAWING NUMBER MD-216-1000-EG-PPD-1002, PLOT PLAN GENERAL PROCESS PLANT LAYOUT.
4. FOR BUILDING SITE SETTING OUT PLAN AND DATA, SEE SURVEYORS/CIVIL DRAWINGS.
5. PLUMBING IN ACCORDANCE TO SBC 701.

LEGEND/ABBREVIATIONS

AC	AIR-CONDITIONING UNIT
FCO	FLOOR CLEAN-OUT
FD	FLOOR DRAIN
GCO	GROUND CLEANOUT
LAV	LAVATORY
SHO	SHOWER
SWP	SANITARY WASTE PIPE
VP	VENT PIPE
WWC	WESTERN WATER CLOSET
ø	DIAMETER

GRAPHICAL SCALE

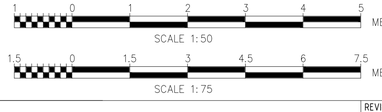

DOCUMENT NUMBER	REFERENCE DOCUMENTS	REV	DATE	REVISION DESCRIPTION	DRN	CHK	ENG	APP	EMP
		D01	09/03/2023	AS-BUILT	-	DRO	-	SJM	
		C02	08/03/2021	ISSUED FOR CONSTRUCTION & REVISED AS MARKED (02)		DRO		SJM	
MD-216-4000-EG-AR-GAD-3041-C01	ENGINEERING OFFICE CUM CCR: TOILET DETAILS	C01	15/07/2020	ISSUED FOR CONSTRUCTION & REVISED AS PER EMPLOYER'S	-	DRO	-	SJM	
MD-216-4000-EG-AR-GAD-3040-C01	ENGINEERING OFFICE CUM CCR: BUILDING ELEVATIONS & SECTIONS			COMMENTS DATED 14/07/2020 & AS MARKED (01)					
MD-216-1000-EG-ST-CRT-1001	CIVIL, STRUCTURAL & ARCHITECTURAL DESIGN CRITERIA	A01	19/06/2020	ISSUED FOR REFRENCE	-	DRO	-	SJM	

DESIGNER: مكتب الخليج للاستشارات الهندسية GULF CONSULT ARCHITECTS AND ENGINEERS

DRAWING NUMBER						REVISION
MD-NON-ENGG-PL-001						C01
DATE	02/06/2020	DATE	04/06/2020	DATE	08/06/2020	
DRAWN	ABD	CHECKED	ZYD	APPROVED	NILO	

LARSEN & TOUBRO DRAWING NUMBER		REVISION
019045_900_A_G_25009_003		3
OUTOTEC DRAWING NUMBER	DOCUMENT ID	REVISION
900707__GAU01__AN03__MTL01__40083	OU100689035	3

LARSEN & TOUBRO

This drawing is the property of LARSEN & TOUBRO and must not be passed on to any person or body not authorized by us to receive it nor be copied or otherwise made use either in full or in part by such person or body without our prior permission in writing.

Outotec

The content of these documents are the sole property of Outotec Oyj. Any rights not expressly granted herein are reserved. Reproduction, transfer or distribution of part or all of the contents in any form without prior written permission of Outotec is prohibited.

MA'ADEN معادن Saudi Arabian Mining Company شركة معادن العربية السعودية

This document and the information contained herein is Ma'aden proprietary know-how. This document or any part thereof should not be reproduced, stored in a retrieval system or transmitted by any means, electronic or otherwise, or divulged without prior written permission of Ma'aden.

DRAWN	-	-	MANSOURAH - MASSARAH GOLD PROJECT
CHECKED	DRO	18/06/2020	GENERAL ARRANGEMENT DRAWING
ENGINEER	-	-	PROCESS AREA : ENGINEERING OFFICE CUM CCR
APPROVED	SJM	19/06/2020	PLUMBING & SANITARY DETAILS-1
EMPLOYER			
SCALE	1:75	A1	

DRAWING NUMBER	REV
MD - 216 - 4000 - EG - AR - GAD - 3053	D01