


DRAWING NUMBER: MD-216-4000-EG-AR-GAD-3054 | REV: D01

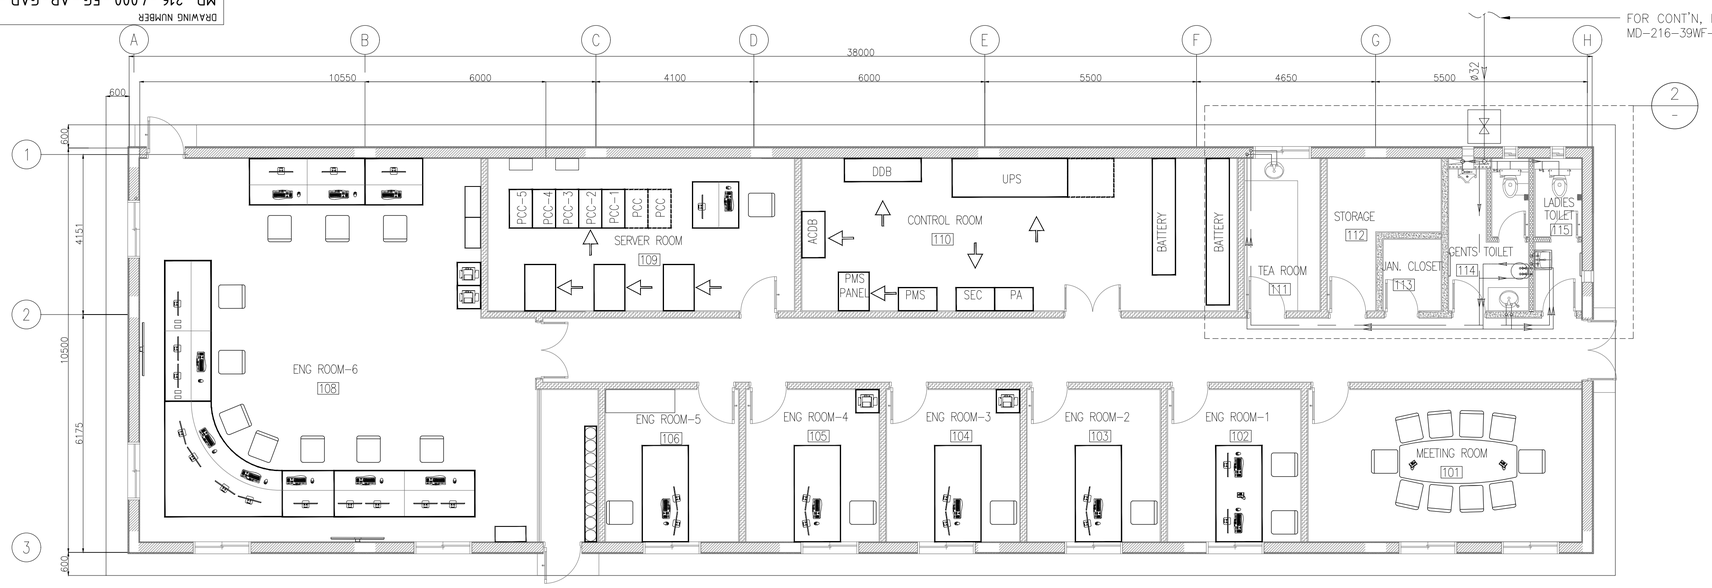

WATER SUPPLY PIPING LAYOUT (1)
SCALE- 1:75

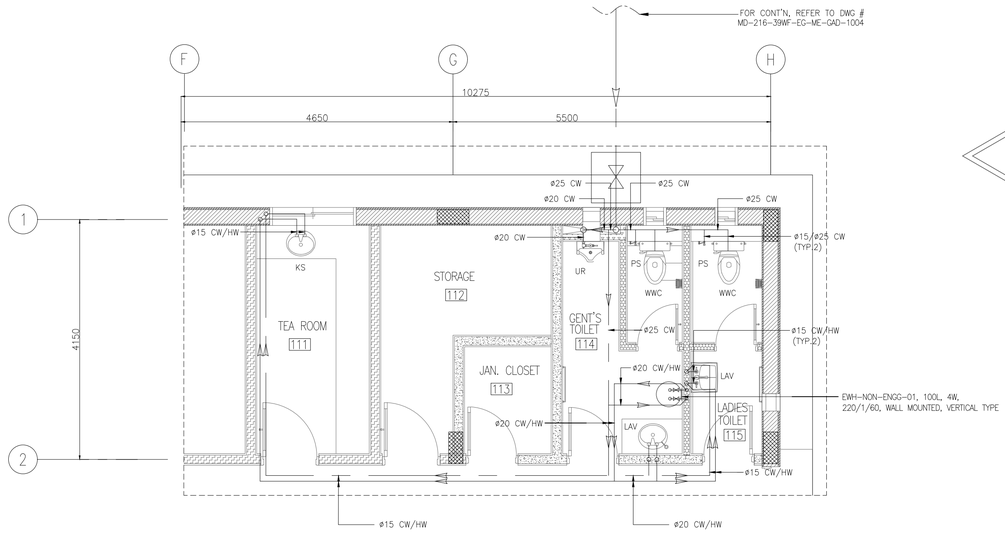


ENLARGED WATER SUPPLY PIPING LAYOUT (2)
SCALE- 1:50

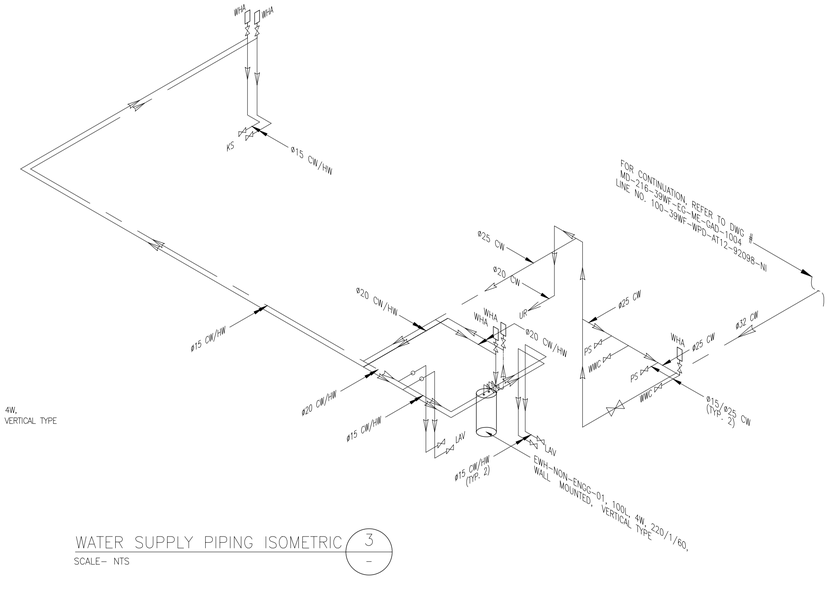


WATER SUPPLY PIPING ISOMETRIC (3)
SCALE- NTS

MASTER KEY PLAN

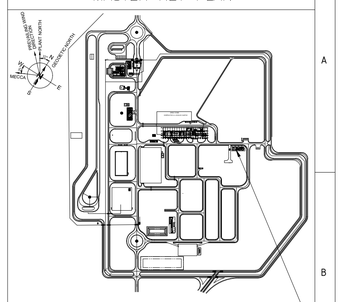

BUILDING KEY PLAN

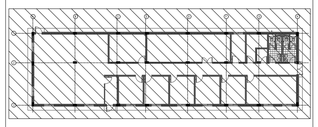

NOTES

1. ALL DIMENSIONS ARE IN MILLIMETERS AND ALL LEVELS ARE GIVEN IN METERS UNLESS OTHERWISE NOTED.
2. ALL DRAWINGS MUST BE READ IN CONJUNCTION WITH ALL OTHER ARCHITECTURAL AND ENGINEERING DRAWINGS RELATED TO THE SAME SHEET AND ANY ITEM ON IT.
3. FOR GRADED FINISHED FLOOR LEVEL (F.F.L) REFER DRAWING NUMBER MD-216-1000-EG-PPD-1002, PLOT PLAN GENERAL PROCESS PLANT LAYOUT.
4. FOR BUILDING SITE SETTING OUT PLAN AND DATA, SEE SURVEYORS/CIVIL DRAWINGS.
5. PLUMBING IN ACCORDANCE TO SBC 701.

LEGEND/ABBREVIATIONS

EWH	ELECTRIC WATER HEATER
CW	COLD WATER SUPPLY
HW	HOT WATER SUPPLY
PS	PERENIAL SPRAY
LAV	LAVATORY
SHO	SHOWER
WHA	WATER HAMMER ARRESTOR
WWC	WESTERN WATER CLOSET
ø	DIAMETER
CONT'N	CONTINUATION

GRAPHICAL SCALE

1 0 1 2 3 4 5 METERS
SCALE 1:50

1.5 0 1.5 3 4.5 6 7.5 METERS
SCALE 1:75

DOCUMENT NUMBER	REFERENCE DOCUMENTS	REV	DATE	REVISION DESCRIPTION	DRN	CHK	ENG	APP	EMP
		D01	09/03/2023	AS-BUILT	-	DRO	-	SJM	
MD-216-4000-EG-AR-GAD-3041-C01	ENGINEERING OFFICE CUM CCR: TOILET DETAILS	C01	15/07/2020	ISSUED FOR CONSTRUCTION & REVISED AS PER EMPLOYER'S COMMENTS DATED 14/07/2020 & AS MARKED /cm1	-	DRO	-	SJM	
MD-216-4000-EG-AR-GAD-3040-C01	ENGINEERING OFFICE CUM CCR: BUILDING ELEVATIONS & SECTIONS								
MD-216-1000-EG-ST-CRT-1001	CIVIL, STRUCTURAL & ARCHITECTURAL DESIGN CRITERIA	A01	19/06/2020	ISSUED FOR REFRENCE	-	DRO	-	SJM	

DESIGNER: مكتب الفليج للاستشارات الهندسية GULF CONSULT ARCHITECTS AND ENGINEERS

DRAWING NUMBER						REVISION
MD-NON-ENGG-PL-002						C01
DATE	02/06/2020	DATE	04/06/2020	DATE	08/06/2020	
DRAWN	ABD	CHECKED	ZYD	APPROVED	NILO	

LARSEN & TOUBRO DRAWING NUMBER		REVISION
019045_900_A_G_25009_004		2
OUTOTEC DRAWING NUMBER	DOCUMENT ID	REVISION
900707 _GAU01 _AN03_MTL01 _40084	0U100689036	2

LARSEN & TOUBRO

This drawing is the property of LARSEN & TOUBRO and must not be passed on to any person or body not authorized by us to receive it nor be copied or otherwise made use either in full or in part by such person or body without our prior permission in writing.

Outotec

The content of these documents are the sole property of Outotec Oyj. Any rights not expressly granted herein are reserved. Reproduction, transfer or distribution of part or all of the contents in any form without prior written permission of Outotec is prohibited.

MA'ADEN معادن
Saudi Arabian Mining Company شركة معادن العربية السعودية

This document and the information contained herein is Ma'aden proprietary know-how. This document or any part thereof should not be reproduced, stored in a retrieval system or transmitted by any means, electronic or otherwise, or divulged without prior written permission of Ma'aden.

DRAWN	-	-
CHECKED	DRO	18/06/2020
ENGINEER	-	-
APPROVED	SJM	19/06/2020
EMPLOYER		
SCALE	1:75	A1

MANSOURAH - MASSARAH GOLD PROJECT
GENERAL ARRANGEMENT DRAWING
PROCESS AREA : ENGINEERING OFFICE CUM CCR
PLUMBING & SANITARY DETAILS-2

DRAWING NUMBER: MD-216-4000-EG-AR-GAD-3054 | REV: D01