


DRAWING NUMBER: MD-216-4000-EG-AR-GAD-3055 | REV: D01

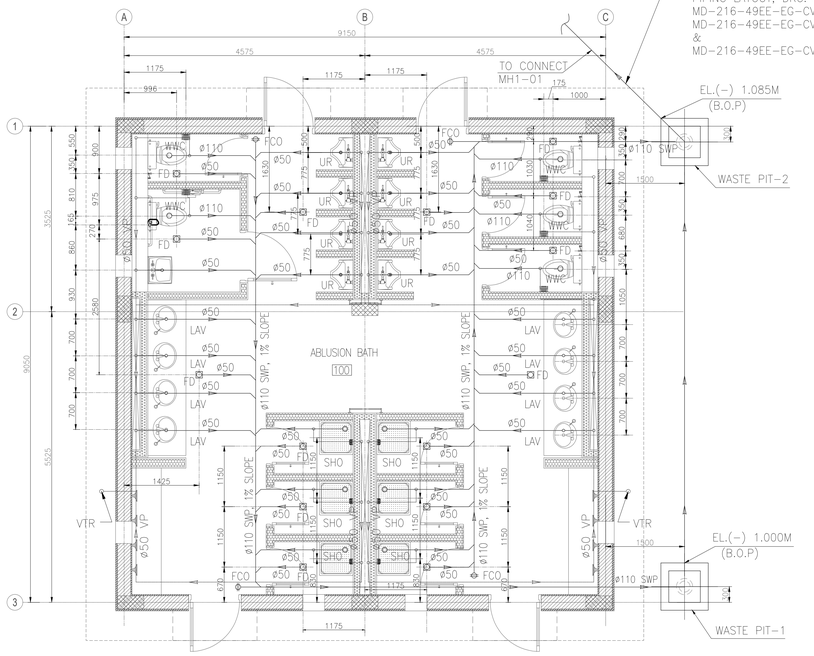


GROUND FLOOR SEWER DRAIN PIPING LAYOUT (1)
SCALE- 1:40

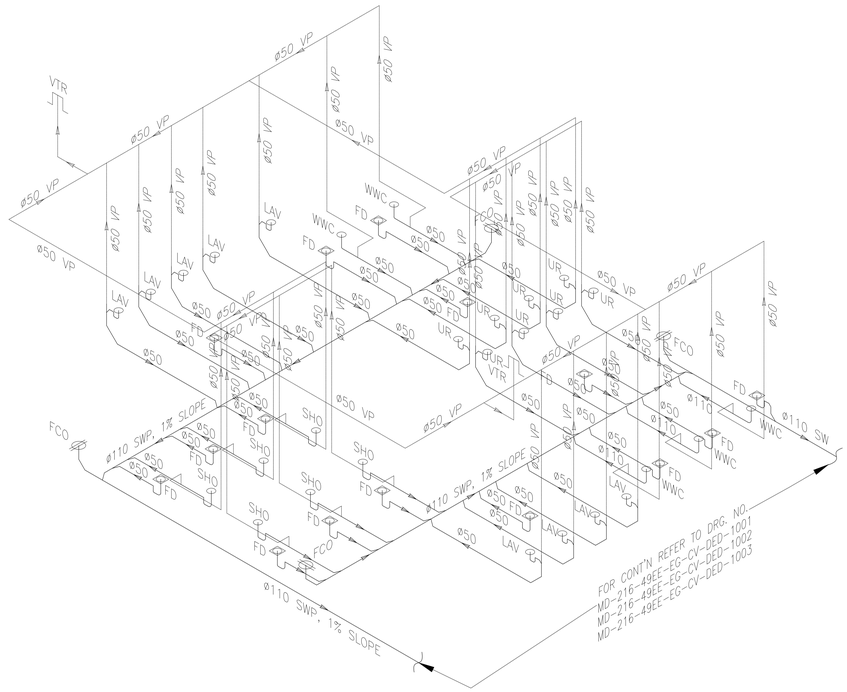

GROUND FLOOR SEWER DRAIN PIPING ISOMETRIC (2)
SCALE- NTS

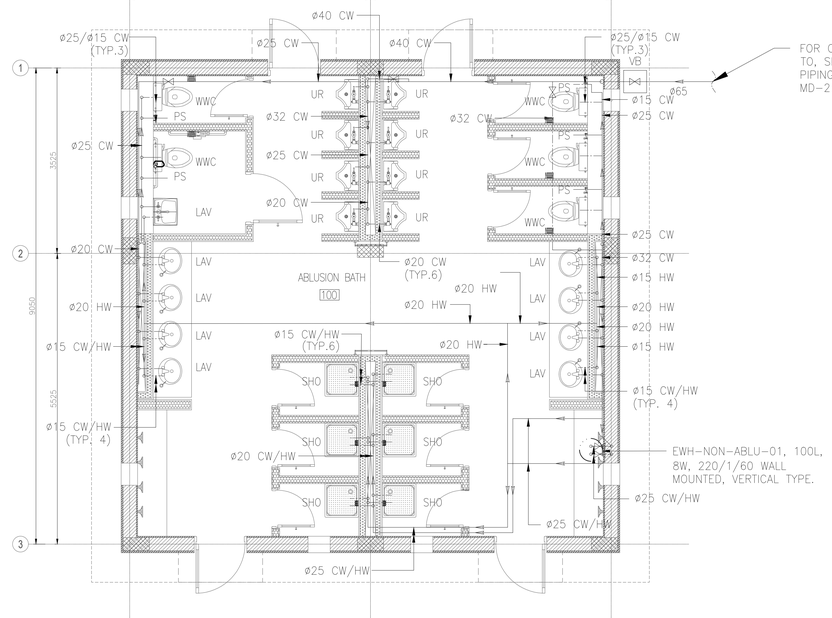


GROUND FLOOR WATER SUPPLY PIPING LAYOUT (3)
SCALE- 1:40

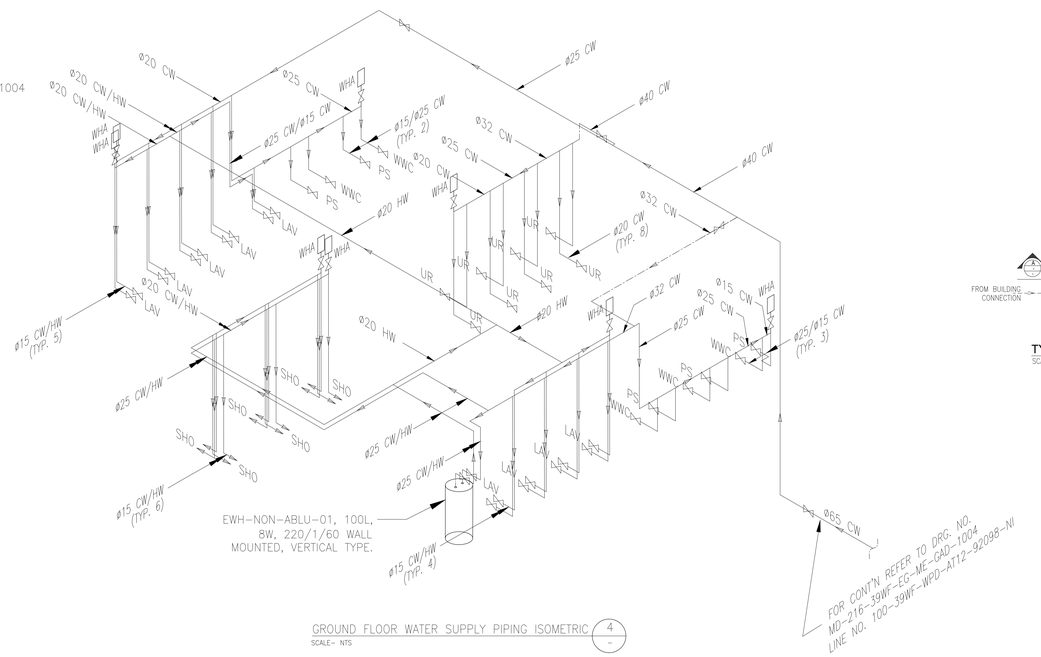


GROUND FLOOR WATER SUPPLY PIPING ISOMETRIC (4)
SCALE- NTS

MASTER KEY PLAN

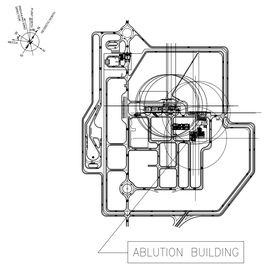

BUILDING KEY PLAN

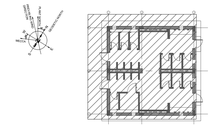


NOTES:


1. ALL DIMENSIONS ARE IN MILLIMETERS AND ALL LEVELS ARE GIVEN IN METERS UNLESS OTHERWISE NOTED.
2. ALL DRAWINGS MUST BE READ IN CONJUNCTION WITH ALL OTHER ARCHITECTURAL AND ENGINEERING DRAWINGS RELATED TO THE SAME SHEET AND ANY ITEM ON IT.
3. FOR GRADED FINISHED FLOOR LEVEL (F.F.L) REFER DRAWING NUMBER MD-216-1000-EG-PPD-1002, PLOT PLAN GENERAL PROCESS PLANT LAYOUT.
4. FOR BUILDING SITE SETTING OUT PLAN AND DATA, SEE SURVEYORS/CIVIL DRAWINGS.
5. PLUMBING IN ACCORDANCE TO SBC 701.

ABBREVIATIONS	
AC	AIR-CONDITIONING UNIT
FCO	FLOOR CLEAN-OUT
FD	FLOOR DRAIN
GCO	GROUND CLEANOUT
LAV	LAVATORY
SHO	SHOWER
SWP	SANITARY WASTE PIPE
VP	VENT PIPE
WWC	WESTERN WATER CLOSET
ø	DIAMETER
EWH	ELECTRIC WATER HEATER
CW	COLD WATER SUPPLY
HW	HOT WATER SUPPLY
PS	PERENIAL SPRAY
WHA	WATER HAMMER ARRESTOR
VB	VALVE BOX

0 1 2 3 4 5 SCALE 1 : 50 METERS

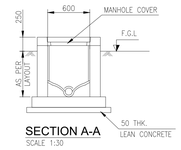

SECTION A-A
SCALE 1:30

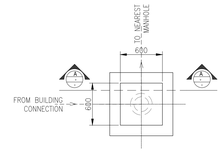

TYPICAL PLAN OF WASTE PIT
SCALE 1:30

REV	DATE	REVISION DESCRIPTION	DRN	CHK	ENG	APP	EMP
D01	09/03/2023	AS-BUILT	-	DRO	-	SJM	
C02	08/03/2021	ISSUED FOR CONSTRUCTION & REVISED AS MARKED (4)	-	DRO	-	SJM	
C01	15/07/2020	ISSUED FOR CONSTRUCTION & REVISED AS PER EMPLOYER'S COMMENTS DATED 14/07/2020 & AS MARKED (4)	-	DRO	-	SJM	
A01	18/06/2020	ISSUED FOR REFERENCE	-	DRO	-	SJM	

DOCUMENT NUMBER	REFERENCE DOCUMENTS
MD-216-4000-EG-AR-GAD-3025-C01	ABLUTION BUILDING: BUILDING PLANS & ELEVATIONS
MD-216-4000-EG-AR-GAD-3026-C01	ABLUTION BUILDING: BUILDING SECTIONS, DOORS & FINISH SCHEDULE
MD-216-1000-EG-ST-CRT-1001	CIVIL, STRUCTURAL AND ARCHITECTURAL DESIGN CRITERIA

DESIGNER: مكتب الفالح للاستشارات الهندسية القصر، المنطقة الشرقية السعودية — GULF CONSULT ARCHITECTS AND ENGINEERS

DRAWING NUMBER		REVISION
MD-NON-ABLU-PL-001		C01
DATE 04/06/2020	DATE 08/06/2020	DATE 10/06/2020
DRAWN ODE	CHECKED ARN	APPROVED NMA

LARSEN & TOUBRO DRAWING NUMBER: 019045_900_A_G_25009_005 — REVISION: 3
OUTOTEC DRAWING NUMBER: 900707__GAU01__AN03__MTL01__40085 — DOCUMENT ID: OU100689037 — REVISION: 3

This drawing is the property of LARSEN & TOUBRO and must not be passed on to any person or body not authorized by us to receive it nor be copied or otherwise made use either in full or in part by such person or body without our prior permission in writing.

The content of these documents are the sole property of Outotec Oyj. Any rights not expressly granted herein are reserved. Reproduction, transfer or distribution of part or all of the contents in any form without prior written permission of Outotec is prohibited.

This document and the information contained herein is Ma'aden proprietary know-how. This document or any part thereof should not be reproduced, stored in a retrieval system or transmitted by any means, electronic or otherwise, or divulged without prior written permission of Ma'aden.

DRAWN	-	-
CHECKED	DRO	17/06/2020
ENGINEER	-	-
APPROVED	SJM	18/06/2020
EMPLOYER		
SCALE	1:40	A0

MANSOURAH - MASSARAH GOLD PROJECT
GENERAL ARRANGEMENT DRAWING
PROCESS AREA: ABLUTION BUILDING
PLUMBING & SANITARY DETAILS

DRAWING NUMBER: MD - 216 - 4000 - EG - AR - GAD - 3055 | REV: D01