


DRAWING NUMBER MD-216-49PR-EG-AR-GAD-3188 REV D01

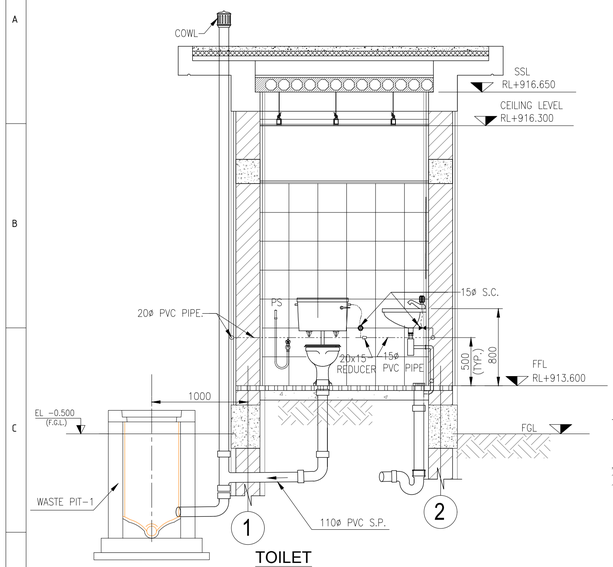



TOILET
SECTION A - A
SCALE 1:30

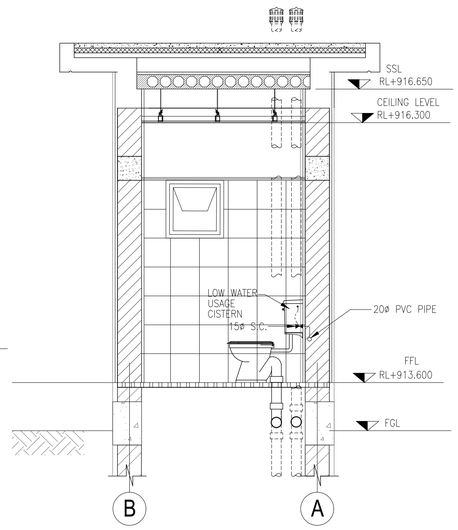


TOILET
SECTION B - B
SCALE 1:30

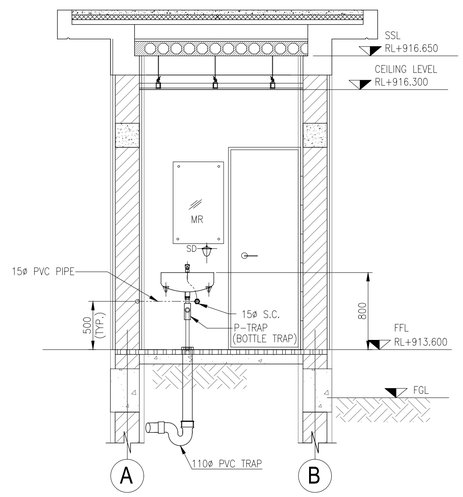




TOILET
SECTION C - C
SCALE 1:30

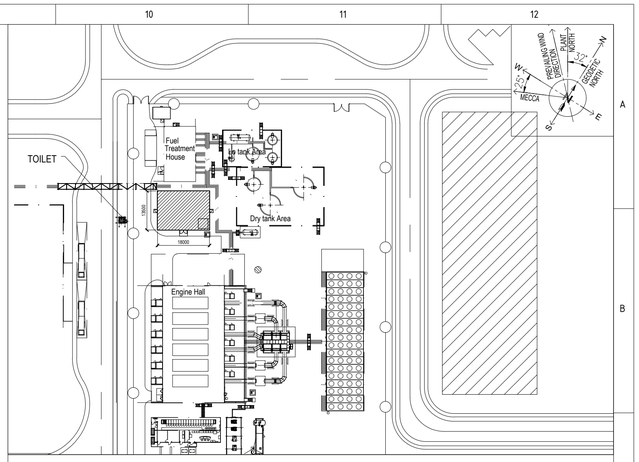


KEY PLAN
SCALE 1:1000

BUILDING KEY PLAN

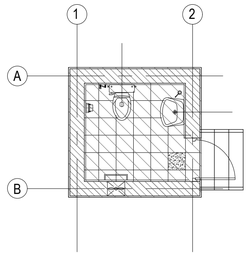

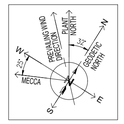
| LEGEND AND DESCRIPTION | | |
|---|---|---|
| WALL | FINISHES | SAMPLE |
| W01 | 150 MM THK. CMU BLOCK WALL WITH 25 MM, THK. PLASTER FINISHING FAIR FACED ON THE DRY SIDE AND GLAZED CERAMIC TILING ON TOILET SIDE. | |
| RCC | RCC COLUMN /WALL/ BEAM | |
| PCC | LEAN CONCRETE | |
| COMPACTED FILL | | |
| SANDWICH PANEL WITH ROCKWOOL INSULATION | | |
| HOLLOW CORE SLAB | | |

| ABBREVATIONS / LEGENDS | |
|---|---|
| FGL | FINISH GRADE LEVEL |
| FFL | FINISH FLOOR LEVEL |
| TYP. | TYPICAL |
| SD | SOAP DISH |
| V.P. | VENT PIPE |
| S.P. | SOIL PIPE |
| W.P. | WASTE PIPE |
| I.P. | INSPECTION PIT |
| u/g | UNDER GROUND |
| S.C. | STOP COCK |
| W.W.C | WESTERN WATER CLOSET |
| MR | MIRROR |
| PS | PERENNIAL SPRAY BY GROHE OR EQUAL |
| C.W.W | COMPACT WORKSHOP & WAREHOUSE |
| DWG | DRAWING |

LEGENDS


SOIL PIPE (S.P.) SHOWN THUS

WASTE PIPE (W.P.) SHOWN THUS


NORMAL WATER PIPE (PVC) SHOWN THUS

NOTES:


1. ALL DIMENSIONS ARE IN MILLIMETER & LEVELS ARE IN METER UNLESS OTHERWISE STATED.
2. ALL DWG. IN 1:30 SCALE UNLESS OTHERWISE STATED.
3. ALL DRAWINGS MUST BE READ IN CONJUNCTION WITH ALL OTHER ARCHITECTURAL AND ENGINEERING OTHER ARCHITECTURAL AND ENGINEERING DRAWINGS RELATED TO THE SAME SHEET AND ANY ITEM ON IT.
4. FOR GRADED FINISHED FLOOR LEVEL (F.F.L) REFER DRAWING NUMBER MD-216-1000-EG-PPD-1002, PLOT PLAN GENERAL PROCESS PLANT LAYOUT.
5. PLUMBING TO BE IN ACCORDANCE WITH SBC701.

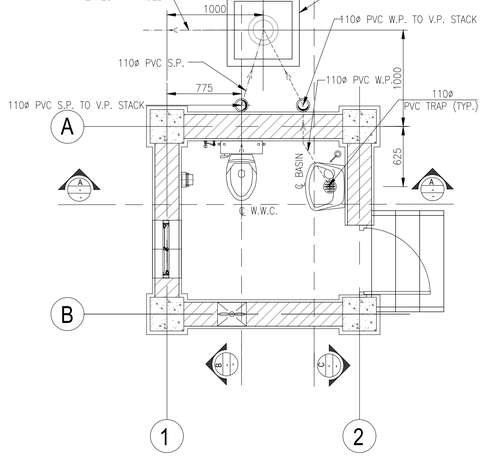



TOILET
PLAN OF TOILET AT ±0.0 LEVEL
LAYOUT OF SOIL, WASTE AND VENT PIPES
SCALE 1:30

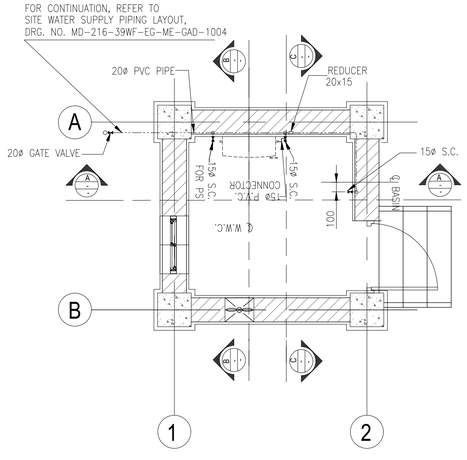


TOILET
PLAN OF TOILET AT ±0.0 LEVEL
LAYOUT OF WATER DISTRIBUTION PIPES
SCALE 1:30

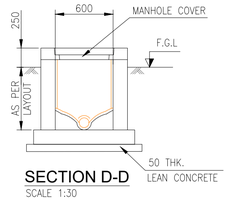


SECTION D-D
SCALE 1:30

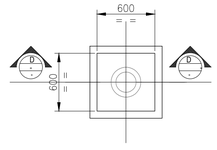


TYPICAL PLAN OF WASTE PIT
SCALE 1:30

| DOCUMENT NUMBER | REFERENCE DOCUMENTS | REV | DATE | REVISION DESCRIPTION | DRN | CHK | ENG | APP | EMP |
|---|---|---|---|---|---|---|---|---|---|
| | | D01 | 09/03/2023 | AS-BUILT | APEX | DRO | TH | SJM | |
| | | C02 | 02/04/2021 | ISSUED FOR CONSTRUCTION & REVISED AS MARKED /C02 | APEX | DRO | TH | SJM | |
| MD-216--49PR-EG-AR-GAD-3185 | PLAN, ELEVATION, SECTION & DETAILS | C01 | 13/10/2020 | ISSUED FOR CONSTRUCTION | APEX | DRO | DRO | SJM | |
| MD-216-1000-EG-ST-CRT-1001 | CIVIL, STRUCTURAL AND ARCHITECTURAL DESIGN CRITERIA | A01 | 16/09/2020 | ISSUED FOR REFERENCE | APEX | DRO | DRO | SJM | |

RESERVED FOR VENDOR LOGO AND DRAWING NUMBER

LARSEN & TOUBRO

This drawing is the property of LARSEN & TOUBRO and must not be passed on to any person or body not authorized by us to receive it nor be copied or otherwise made use either in full or in part by such person or body without our prior permission in writing.

Outotec

The content of these documents are the sole property of Outotec Oyj. Any rights not expressly granted herein are reserved. Reproduction, transfer or distribution of part or all of the contents in any form without prior written permission of Outotec is prohibited.

MA'ADEN معادن
Saudi Arabian Mining Company شركة التعدين العربية السعودية

This document and the information contained herein is Ma'aden proprietary know-how. This document or any part thereof should not be reproduced, stored in a retrieval system or transmitted by any means, electronic or otherwise, or divulged without prior written permission of Ma'aden.

LARSEN & TOUBRO DRAWING NUMBER: 019045_008_A_G_25146_001 — REVISION: 3

OUTOTEC DRAWING NUMBER: 900707__GAU01__WG01_MTL01__45115 — DOCUMENT ID: OU100697190 — REVISION: 3

| | | |
|---|---|---|
| DRAWN | APEX | 14/09/2020 |
| CHECKED | DRO | 15/09/2020 |
| ENGINEER | DRO | 15/09/2020 |
| APPROVED | SJM | 16/09/2020 |
| EMPLOYER | | |
| SCALE | 1:30 | A1 |

MANSOURAH - MASSARAH GOLD PROJECT
GENERAL ARRANGEMENT
POWER GENERATION : TOILET OUTSIDE OF C.W.W
PLUMBING AND SANITARY DETAILS

DRAWING NUMBER: MD-216-49PR-EG-AR-GAD-3188 — REV: D01