

DRAWING NUMBER MD-216-49PR-EG-CV-GAD-1630 REV D01

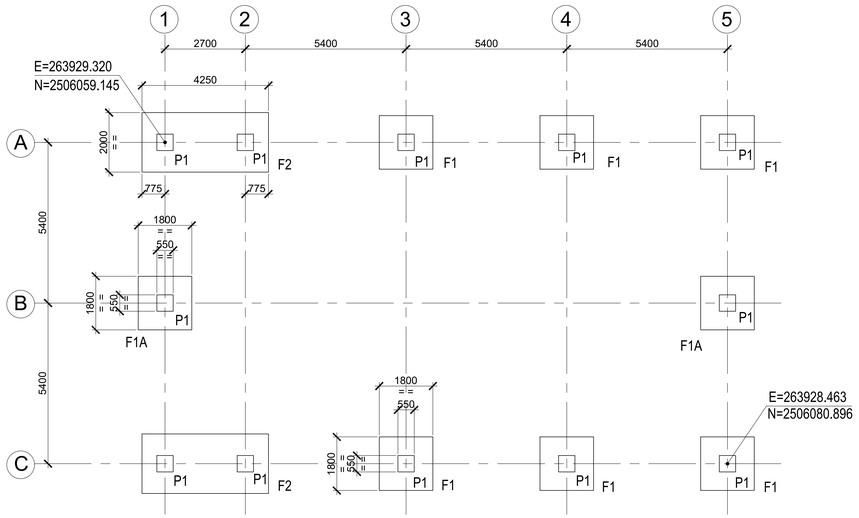


FOUNDATION LAYOUT PLAN
(SCALE 1:100)

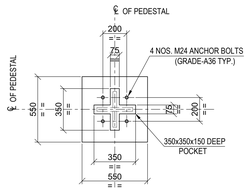


VIEW : 1A - 1A
(TYP. DETAIL OF PEDESTAL MKD. P1)
(SCALE- 1:20)

SCHEDULE OF BOLTS


BOLT DIA. (MM)	BOLT NUMBERS REQUIRED
M24	48

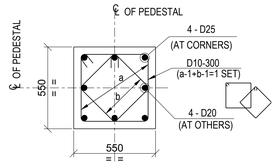


SECTION : 1B - 1B
(TYP. RC DETAIL OF PEDESTAL MKD. P1 & P2)
(SCALE- 1:20)

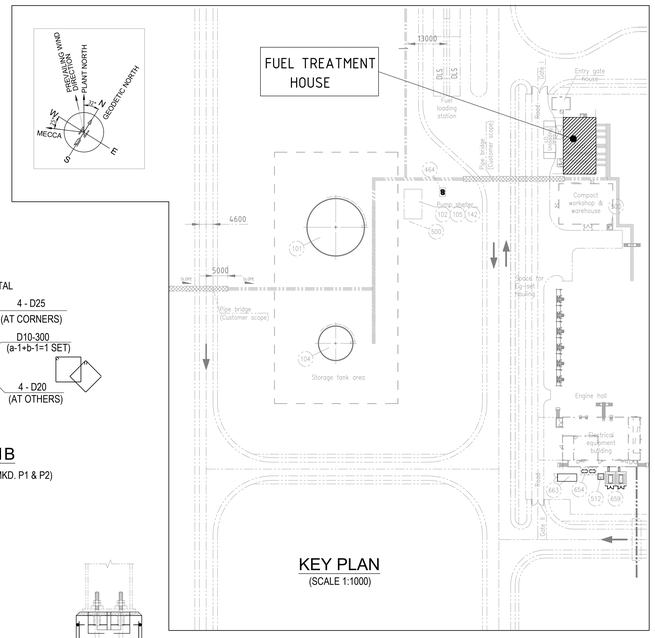


KEY PLAN
(SCALE 1:1000)

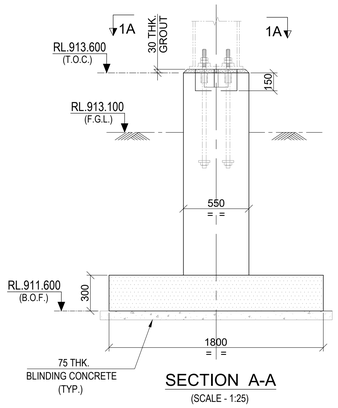


SECTION A-A
(SCALE - 1:25)

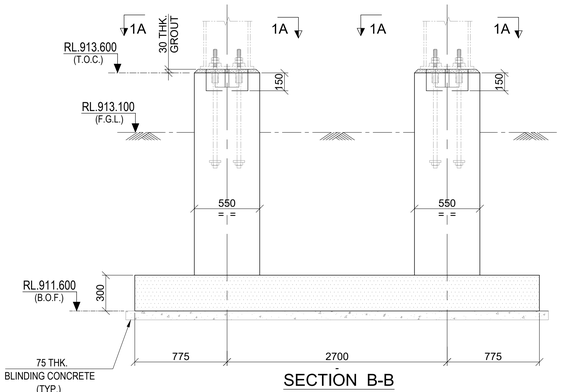


SECTION B-B
(SCALE - 1:25)

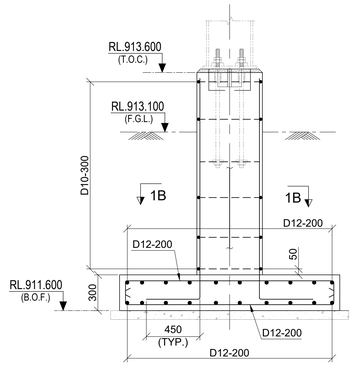


SECTION 1-1
(SCALE - 1:25)

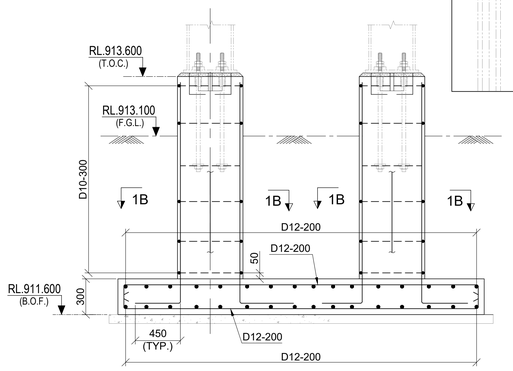


SECTION 2-2
(SCALE - 1:25)

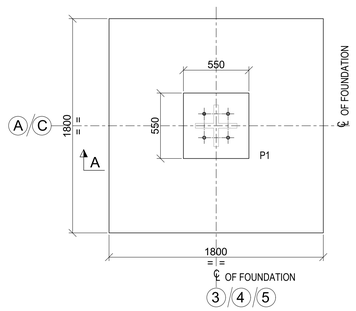


DETAIL OF FOUNDATION MKD. F1
(DETAIL OF FOUNDATION MKD. F1A SIMILAR)
(SCALE - 1:25)

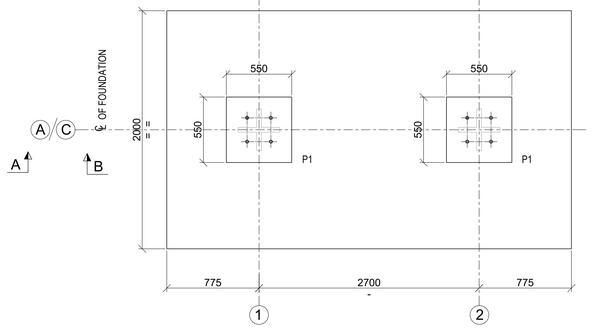

DETAIL OF FOUNDATION MKD. F2
(SCALE - 1:25)

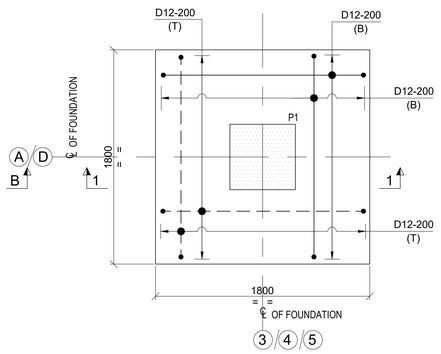

R.C. DETAIL OF FOUNDATION MKD. F1
(DETAIL OF FOUNDATION MKD. F1A SIMILAR)
(10 NOS. REQUIRED)
(SCALE - 1:25)

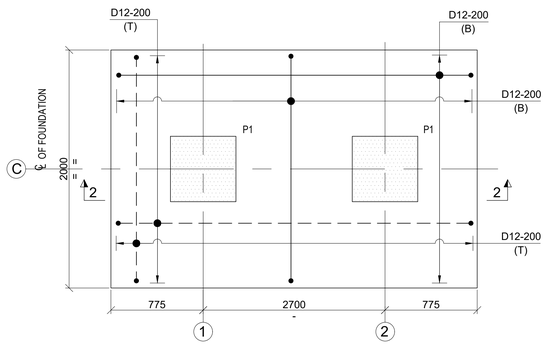

R.C. DETAIL OF FOUNDATION MKD. F2
(2 NOS. REQUIRED)
(SCALE - 1:25)

LEGEND :-

RL. - REDUCED LEVEL.
T.O.C. - TOP OF CONCRETE.
F.G.L. - FINISHED GROUND LEVEL.
B.O.F. - BOTTOM OF FOOTING.
℄ - CENTRE LINE.
TYP. - TYPICAL.
THK. - THICK.
MKD. - MARKED.
G.A. - GENERAL ARRANGEMENT.
DIA - DIAMETER.
B - BOTTOM REINFORCEMENT
T - TOP REINFORCEMENT
R.C. - REINFORCED CONCRETE

NOTES :-

1. ALL DIMENSIONS ARE IN MILLIMETERS AND LEVELS AND CO-ORDINATES ARE IN METERS. UNLESS OTHERWISE STATED.
2. GRADE OF CONCRETE SHALL BE 35 MPa FOR FOUNDATION & 15 MPa FOR BLINDING CONCRETE.
3. GRADE OF REINFORCEMENT SHALL BE DEFORMED BAR 420 MPa (GRADE 60) - ASTM A615/A615M.
4. NET SAFE BEARING CAPACITY OF SOIL AT BOTTOM OF FOUNDATION CONSIDER 500KN/ SQ. M.
5. CLEAR COVER TO MAIN REINFORCEMENT SHALL BE 75 mm FOR RAFT & 50 mm FOR COLUMN.
6. IF ANY PART OF FOUNDATION COMES ON BACKFILL ZONE OF ADJACENT FOUNDATION OR ANY LOOSE SOIL ARE ENCOUNTERED BELOW FOUNDATION LEVEL THE SAME SHALL BE REMOVED AND FILLED WITH PCC.
7. THIS DRAWING SHALL BE READ IN CONJUNCTION WITH DRAWING NO. MD-216-49PR-EG-ST-GAD-2405.
8. GENERAL NOTES FOR CIVIL WORKS & STANDARD REINFORCEMENT DETAIL REFER DRAWING NO. MD-216-1000-EG-CV-DED-1001 & 1005.

DOCUMENT NUMBER	REFERENCE DOCUMENTS	REV	DATE	REVISION DESCRIPTION	DRN	CHK	ENG	APP	EMP
		D01	17/02/2023	AS-BUILT	AMJ	SGC	SHD	PRI	
		C02	17/12/2020	ISSUED FOR CONSTRUCTION & REVISED AS MKD. C02	AMJ	SGC	SHD	PRI	
		C01	09/07/2020	ISSUED FOR CONSTRUCTION & REVISED AS MKD. C01	AMJ	SGC	SHD	PRI	
MD-216-49PR-EG-ME-GAD-V553-1055	FLOOR PLANS-FUEL TREATMENT HOUSE	A01	10/06/2020	ISSUED FOR REFERENCE	MK	SGC	SHD	PRI	

RESERVED FOR VENDOR LOGO AND DRAWING NUMBER

LARSEN & TOUBRO

This drawing is the property of LARSEN & TOUBRO and must not be passed on to any person or body not authorized by us to receive it nor be copied or otherwise made use either in full or in part by such person or body without our prior permission in writing.

Outotec

The content of these documents are the sole property of Outotec Oyj. Any rights not expressly granted herein are reserved. Reproduction, transfer or distribution of part or all of the contents in any form without prior written permission of Outotec is prohibited.

MA'ADEN معادن
Saudi Arabian Mining Company شركة معادن العربية السعودية

This document and the information contained herein is Ma'aden proprietary know-how. This document or any part thereof should not be reproduced, stored in a retrieval system or transmitted by any means, electronic or otherwise, or divulged without prior written permission of Ma'aden.

LARSEN & TOUBRO DRAWING NUMBER: O19045_008_C_G_24290_010 — REVISION: 3
OUTOTEC DRAWING NUMBER: 900707__GAU01__WG01__MTL01__45050 — DOCUMENT ID: OU100682326 — REVISION: 3

DRAWN	MK	03/06/2020
CHECKED	SGC	04/06/2020
ENGINEER	SHD	02/06/2020
APPROVED	PRI	06/06/2020
EMPLOYER		
SCALE	1:100,50:25	A1

MANSOURAH - MASSARAH GOLD PROJECT
GENERAL ARRANGEMENT
FUEL TREATMENT HOUSE
GA AND DETAIL OF FOUNDATION

DRAWING NUMBER: MD-216-49PR-EG-CV-GAD-1630 — REV: D01