MA'ADEN معادن

Saudi Arabian Mining Company شركة التعدين العربية السعودية

Project **Mansourah Massarah Gold Project**

Customer: **MA'ADEN GOLD AND BASE METALS (MA'ADEN)**

Title: **GENERAL ARRANGEMENT**
FUEL TREATMENT HOUSE
GA AND DETAIL OF GRADE SLAB

Document Number: **MD-216-49PR-EG-CV-GAD-1631**

Revision: D01

Revision Date: 03.07.2023


Status: **AS-BUILT**

Outotec Document Number:	900707	GAU01	WG01	MTL01	45051	OU100682327	8
L&T Document Number:	O19045	008	C	G	24290	011	8


REVISION HISTORY

Rev	Date	Revision Text	Prepared By	Reviewed By	Approved By	Employer
A01	03.07.2020	ISSUED FOR REFERENCE	AMJ	SGC	PRI	
C01	30.07.2020	ISSUED FOR CONSTRUCTION	AMJ	SGC	PRI	
C02	16.10.2020	ISSUED FOR CONSTRUCTION AND REVISED AS MKD. C02	AMJ	SGC	PRI	
C03	16.12.2020	ISSUED FOR CONSTRUCTION AND REVISED AS MKD. C03	AMJ	SGC	PRI	
C04	16.02.2021	ISSUED FOR CONSTRUCTION AND REVISED AS MKD. C04	AMJ	SGC	PRI	
C05	21.07.2021	ISSUED FOR CONSTRUCTION AND REVISED AS MKD. C05	AMJ	SGC	PRI	
C06	01.09.2021	ISSUED FOR CONSTRUCTION AND REVISED AS MKD. C06	SYA	SJM	AG	
C07	21.02.2022	ISSUED FOR CONSTRUCTION AND REVISED AS MKD. C07	SYA	SJM	AG	
D01	03.07.2023	AS - BUILT	SYA	SJM	AG	


DRAWING NUMBER: MD-216-49PR-EG-CV-GAD-1631 REV D01

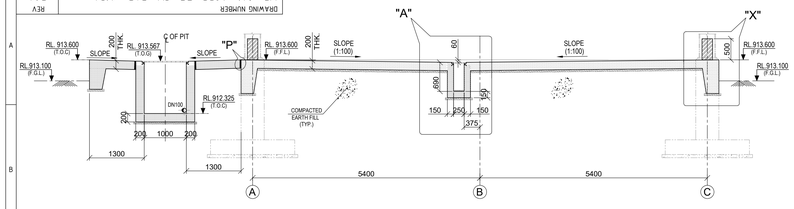


SECTION : 1 - 1
(SCALE - 1:50)

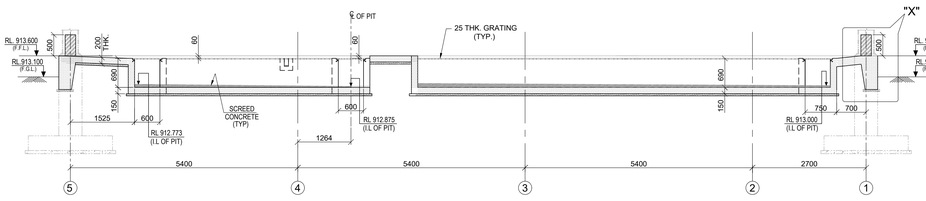



SECTION : 2 - 2
(SCALE - 1:50)

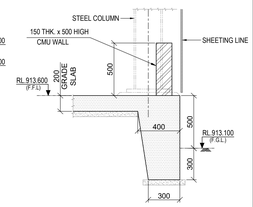



DETAIL - X
(SCALE 1:20)

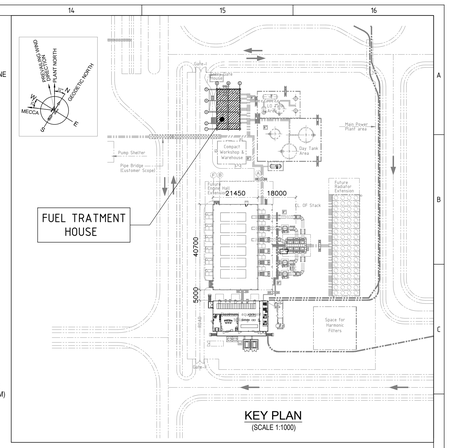


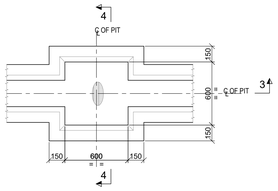


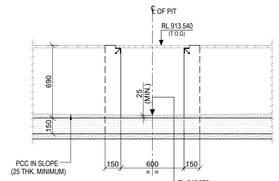


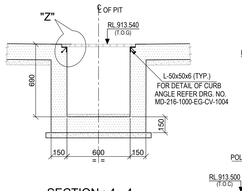


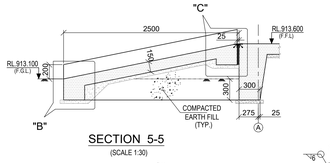


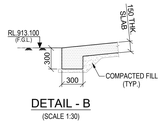


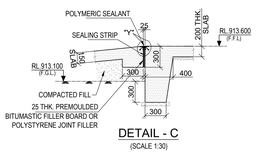


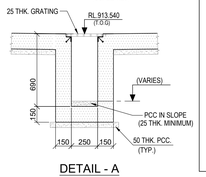


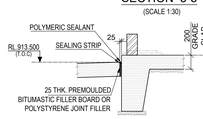


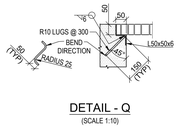


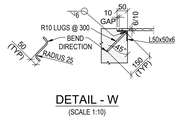


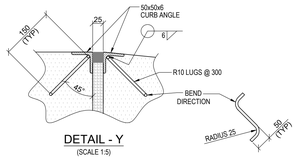


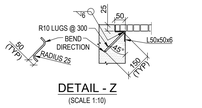


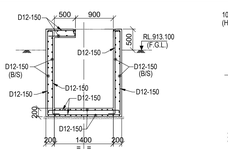


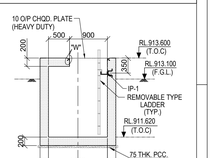


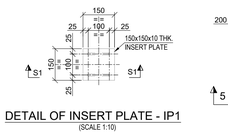


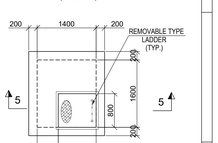


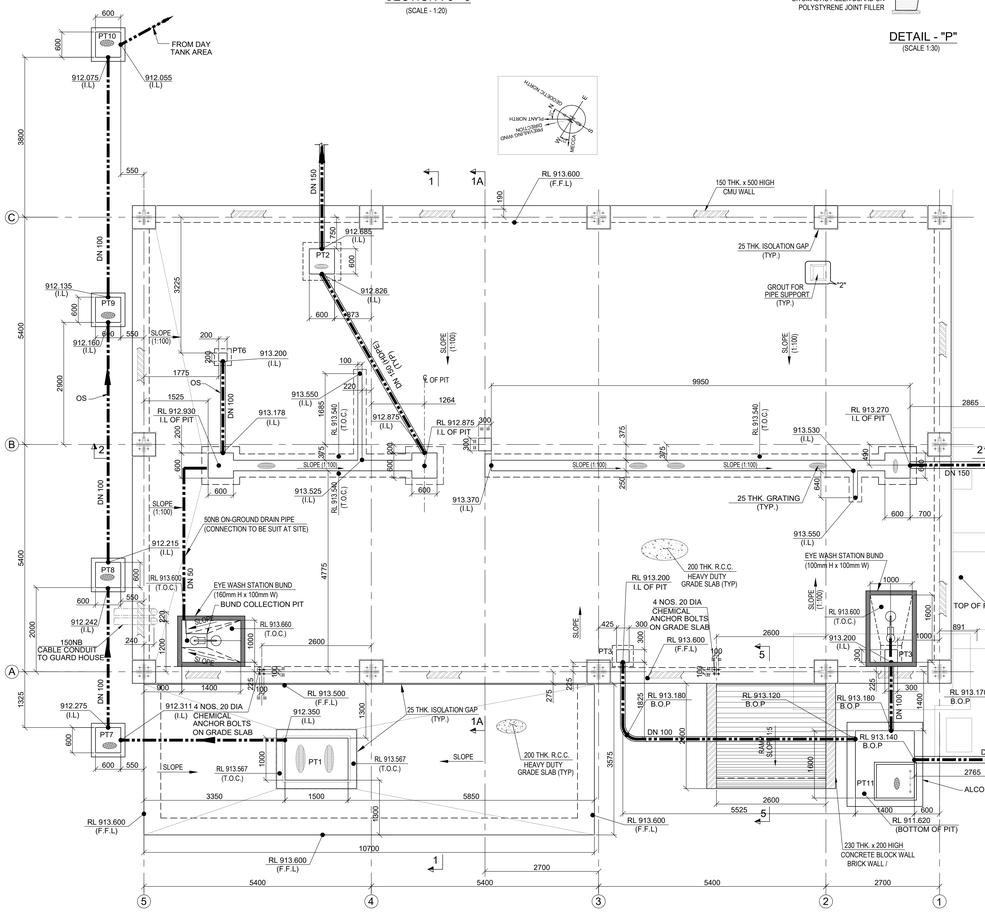


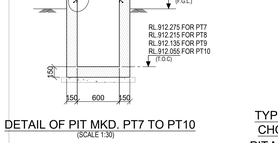


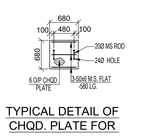


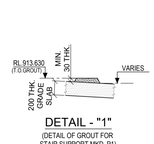


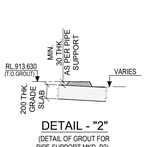


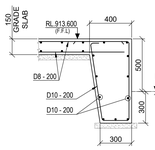


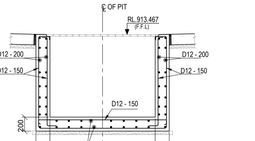


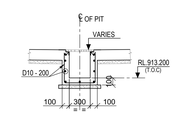


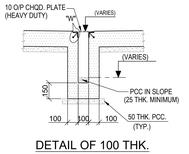


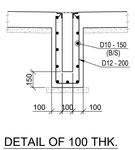


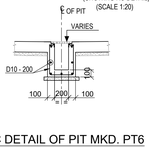


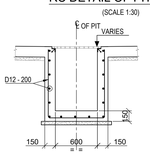


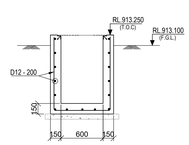


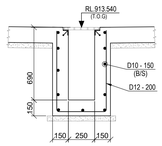


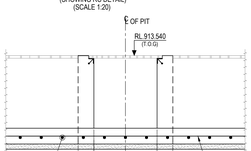

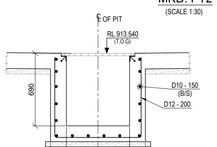

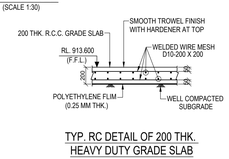

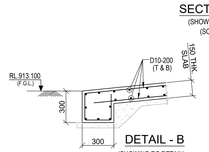

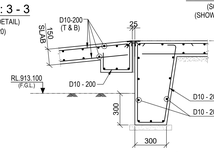

LEGEND :-

RL. - REDUCED LEVEL.
T.O.C. - TOP OF CONCRETE.
F.G.L. - FINISHED GROUND LEVEL.
B.O.P. - BOTTOM OF FOOTING.
℄ - CENTRE LINE.
TYP. - TYPICAL.
THK. - THICK.
MKD. - MARKED.
C/C - CENTER TO CENTER.
DIA - DIAMETER.
OS - OILY WATER DRAINAGE PIPE
CHQD. - CHEQUERED PLATE
I.L - INVERT LEVEL

NOTES :-

1. ALL DIMENSIONS ARE IN MILLIMETERS AND LEVELS AND CO-ORDINATES ARE IN METERS. UNLESS OTHERWISE STATED.
2. GRADE OF CONCRETE SHALL BE 35 MPa FOR FOUNDATION & 15 MPa FOR BLINDING CONCRETE.
3. GRADE OF REINFORCEMENT SHALL BE DEFORMED BAR 420 MPa (GRADE 60) - ASTM A615/A615M.
4. NET SAFE BEARING CAPACITY OF SOIL AT BOTTOM OF FOUNDATION CONSIDER 500 KN/ SQ. M.
5. CLEAR COVER TO MAIN REINFORCEMENT SHALL BE 75 mm FOR RAFT & 50 mm FOR COLUMN.
6. IF ANY PART OF FOUNDATION COMES ON BACKFILL ZONE OF ADJACENT FOUNDATION OR ANY LOOSE SOIL ARE ENCOUNTERED BELOW FOUNDATION LEVEL THE SAME SHALL BE REMOVED AND FILLED WITH PCC.
7. FOR DETAILS OF GRADE SLAB REFER DRG. NO. MD-216-1000-EG-CV-DED-1002.
8. THE CONTENT OF THIS DRAWING SHALL CONFORM TO THE PROVISIONS OF CIVIL, STRUCTURAL AND ARCHITECTURAL DESIGN CRITERIA DOC NO. MD-216-1000-EG-ST-CRT-1001.
9. THIS DRAWING SHALL BE READ IN CONJUNCTION WITH DRAWING NO. MD-216-49PR-EG-ST-GAD-2405.
10. ALL OTHER NOTES REFER DRAWING NO. MD-101-SMEM-EG-ST-DST-0001 TO 0008.
11. GENERAL NOTES FOR CIVIL WORKS & STANDARD REINFORCEMENT DETAIL REFER DRAWING NO. MD-216-1000-EG-CV-DED-1001 & 1005.
12. THIS DRAWING SHALL BE READ IN CONJUNCTION WITH DRAWING NO. MD-216-49PR-EG-CV-GAD-1630.
13. OILY WATER DRAINAGE TO BE ADJUSTED ACCORDING TO SITE CONDITION.
14. PIPING MATERIAL STANDARD - AT12, HDPE (PEA4710).
15. ALL LEVELS AS MENTIONED ARE BOTTOM OF PIPE.
16. FOR STANDARD DETAILS OF GRADE SLAB REFER DRAWING NO. MD-216-1000-EG-CV-DED-1002.

SHEET 1 OF 2

DOCUMENT NUMBER	REFERENCE DOCUMENTS	REV	DATE	REVISION DESCRIPTION	DRN	CHK	ENG	APP	EMP
		D01	03/07/2023	AS - BUILT	SYA	SJM	AVG	AG	
		C07	21/02/2022	ISSUED FOR CONSTRUCTION AND REVISED AS MKD. (1A)	SYA	SJM	AVG	AG	
		C06	01/09/2021	ISSUED FOR CONSTRUCTION AND REVISED AS MKD. (1A)	SYA	SJM	AVG	AG	
		C05	21/07/2021	ISSUED FOR CONSTRUCTION AND REVISED AS MKD. (1A)	SYA	SJM	AVG	AG	
		C04	16/02/2021	ISSUED FOR CONSTRUCTION AND REVISED AS MKD. (1A)	PDK	SGC	SHD	PRI	
		C03	16/12/2020	ISSUED FOR CONSTRUCTION AND REVISED AS MKD. (1A)	AMJ	SGC	SHD	PRI	
MD-216-1000-EG-CV-DED-1003	ANCHOR BOLTS STANDARD DETAILS.	C02	16/10/2020	ISSUED FOR CONSTRUCTION AND REVISED AS MKD. (1A)	AMJ	SGC	SHD	PRI	
MD-216-1000-EG-ST-CRT-1001	CIVIL, STRUCTURAL & ARCHITECTURAL - DESIGN CRITERIA	C01	30/07/2020	ISSUED FOR CONSTRUCTION	AMJ	SGC	SHD	PRI	
MD-216-49PR-EG-ME-LAD-V553-1055	FLOOR PLANS - FUEL TREATMENT HOUSE	A01	03/07/2020	ISSUED FOR REFERENCE	AMJ	SGC	SHD	PRI	

RESERVED FOR VENDOR LOGO AND DRAWING NUMBER


LARSEN & TOUBRO
This drawing is the property of LARSEN & TOUBRO and must not be passed on to any person or body not authorized by us to receive it nor be copied or otherwise made use either in full or in part by such person or body without our prior permission in writing.

Outotec
The content of these documents are the sole property of Outotec Oyj. Any rights not expressly granted herein are reserved. Reproduction, transfer or distribution of part or all of the contents in any form without prior written permission of Outotec is prohibited.


MA'ADEN معادن
Saudi Arabian Mining Company شركة معادن العربية السعودية
This document and the information contained herein is Ma'aden proprietary know-how. This document or any part thereof should not be reproduced, stored in a retrieval system or transmitted by any means, electronic or otherwise, or divulged without prior written permission of Ma'aden.

LARSEN & TOUBRO DRAWING NUMBER	019045_008_C_G_24290_011
REVISION	8
OUTOTEC DRAWING NUMBER	900707__GAU01__WG01_MTL01__45051
DOCUMENT ID	OU100682327
REVISION	8
DRAWN	AMJ 20/06/2020
CHECKED	SGC 22/06/2020
ENGINEER	SHD 18/06/2020
APPROVED	PRI 03/07/2020
EMPLOYER	
SCALE	1:200,100,20
PROJECT	MANSOURAH - MASSARAH GOLD PROJECT
GENERAL ARRANGEMENT	
FUEL TREATMENT HOUSE	
GA AND DETAIL OF GRADE SLAB	
DRAWING NUMBER	MD - 216 - 49PR - EG - CV - GAD - 1631
REV	D01
SIZE	A0


DRAWING NUMBER MD-216-49PR-EG-CV-GAD-1631 REV D01

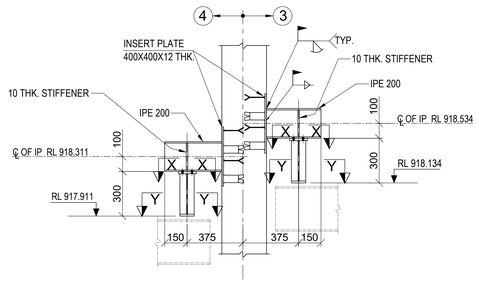


SECTION E-E
SCALE- 1:20

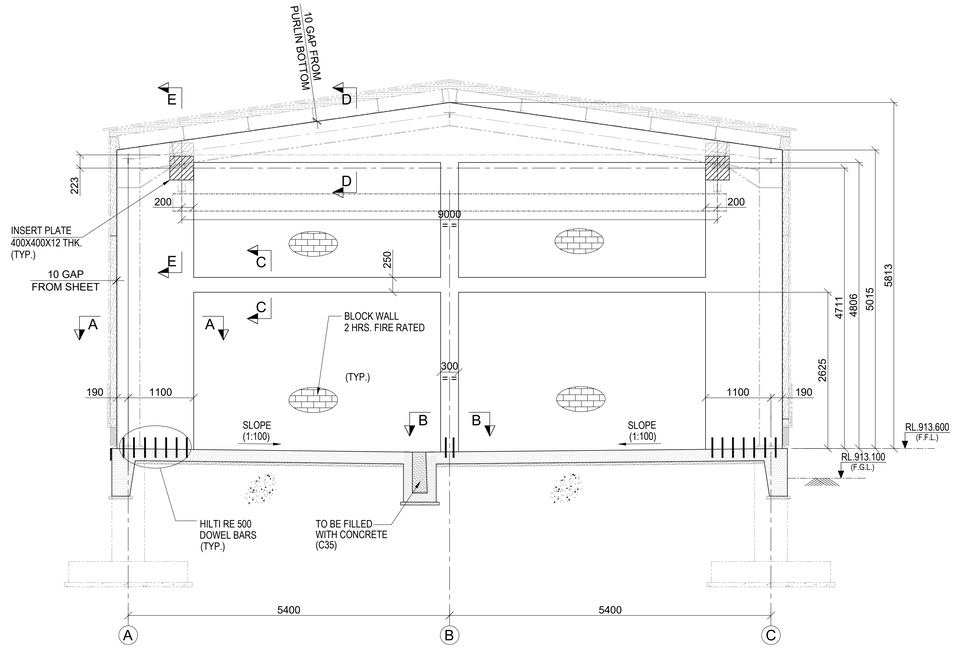


FTH WALL SECTION 1A-1A
SCALE 1:50

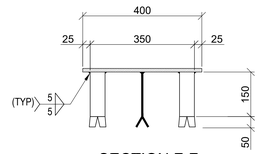


SECTION F-F
SCALE-1:25

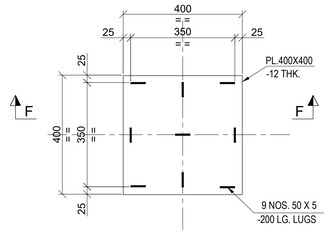


DETAIL OF INSERT PLATE
SCALE-1:10

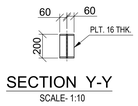


SECTION Y-Y
SCALE- 1:10

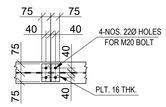


SECTION X-X
SCALE- 1:10

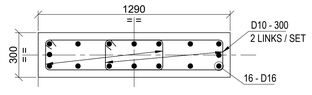


SECTION A-A
SCALE 1:20

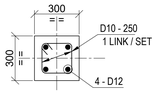

SECTION B-B
SCALE 1:20

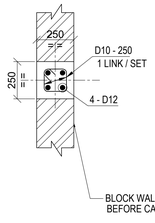

SECTION C-C
SCALE 1:20

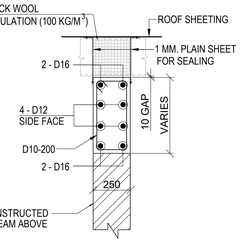

SECTION D-D
SCALE 1:20

FOR NOTES REFER STANDARD DRAWING NOS.
MD-216-1000-EG-CV-DED-1001
MD-216-1000-EG-ST-DED-1001

LEGEND :-

RL. - REDUCED LEVEL.
T.O.C. - TOP OF CONCRETE.
F.G.L. - FINISHED GROUND LEVEL.
B.O.F. - BOTTOM OF FOOTING.
℄ - CENTRE LINE.
TYP. - TYPICAL.
THK. - THICK.
MKD. - MARKED.
C/C - CENTER TO CENTER.
DIA. - DIAMETER.
OS. - OILY WATER DRAINAGE PIPE
CHQD. - CHEQUERED PLATE
I.L - INVERT LEVEL

NOTES :-

1. ALL DIMENSIONS ARE IN MILLIMETERS AND LEVELS AND CO-ORDINATES ARE IN METERS. UNLESS OTHERWISE STATED.
2. GRADE OF CONCRETE SHALL BE 35 MPa FOR FOUNDATION & 15 MPa FOR BLINDING CONCRETE.

SHEET 2 OF 2

DOCUMENT NUMBER	REFERENCE DOCUMENTS			REVISION DESCRIPTION	DRN	CHK	ENG	APP	EMP
		D01	03/07/2023	AS - BUILT	SYA	SJM	AVG	AG	
		C07	21/02/2022	ISSUED FOR CONSTRUCTION AND REVISED AS MKD. C07	SYA	SJM	AVG	AG	
		C06	01/09/2021	ISSUED FOR CONSTRUCTION AND REVISED AS MKD. C06	SYA	SJM	AVG	AG	
		C05	21/07/2021	ISSUED FOR CONSTRUCTION AND REVISED AS MKD. C05	SYA	SJM	AVG	AG	
MD-216-49BL-EG-CV-DED-1066	DETAIL OF ROOF & GRADE SLAB	C04	16/02/2021	ISSUED FOR CONSTRUCTION AND REVISED AS MKD. C04	PDK	SGC	SHD	PRI	
MD-216-49BL-EG-CV-DED-1065	DETAIL OF FDN. COL. & GRADE BEAM	C03	16/12/2020	ISSUED FOR CONSTRUCTION AND REVISED AS MKD. C03	AMJ	SGC	SHD	PRI	
MD-216-49BL-EG-HV-LAD-V567-1002	HVAC SYSTEM FOR LABORATORY BUILDING	C02	16/10/2020	ISSUED FOR CONSTRUCTION AND REVISED AS MKD. C02	AMJ	SGC	SHD	PRI	
MD-216-49BL-EG-HV-LAD-V567-1001	HVAC SYSTEM FOR LABORATORY BUILDING	C01	30/07/2020	ISSUED FOR CONSTRUCTION	AMJ	SGC	SHD	PRI	
MD-216-49BL-EG-ME-GAD-1001	LABORATORY PLAN & ELEVATION VIEW	A01	03/07/2020	ISSUED FOR REFERENCE	AMJ	SGC	SHD	PRI	

RESERVED FOR VENDOR LOGO AND DRAWING NUMBER

LARSEN & TOUBRO

This drawing is the property of LARSEN & TOUBRO and must not be passed on to any person or body not authorized by us to receive it nor be copied or otherwise made use either in full or in part by such person or body without our prior permission in writing.

Outotec

The content of these documents are the sole property of Outotec Oyj. Any rights not expressly granted herein are reserved. Reproduction, transfer or distribution of part or all of the contents in any form without prior written permission of Outotec is prohibited.

MA'ADEN معادن
Saudi Arabian Mining Company شركة معادن العربية السعودية

This document and the information contained herein is Ma'aden proprietary know-how. This document or any part thereof should not be reproduced, stored in a retrieval system or transmitted by any means, electronic or otherwise, or divulged without prior written permission of Ma'aden.

LARSEN & TOUBRO DRAWING NUMBER: O19045_008_C_G_24290_011 — REVISION: 8
OUTOTEC DRAWING NUMBER: 900707__GAU01__WG01__MTL01__45051 — DOCUMENT ID: OU100723932 — REVISION: 8

DRAWN	AMJ	20/06/2020
CHECKED	SGC	22/06/2020
ENGINEER	SHD	18/06/2020
APPROVED	PRI	03/07/2020
EMPLOYER		
SCALE 1:50, 20, 10		A1

MANSOURAH - MASSARAH GOLD PROJECT
GENERAL ARRANGEMENT
FUEL TREATMENT HOUSE
GA AND DETAIL OF GRADE SLAB

DRAWING NUMBER: MD - 216 - 49PR- EG - CV - GAD - 1631 — REV: D01