DRAWING NUMBER
MD - 216 - 49PR - EG - CV - GAD - 2005
REV
D01

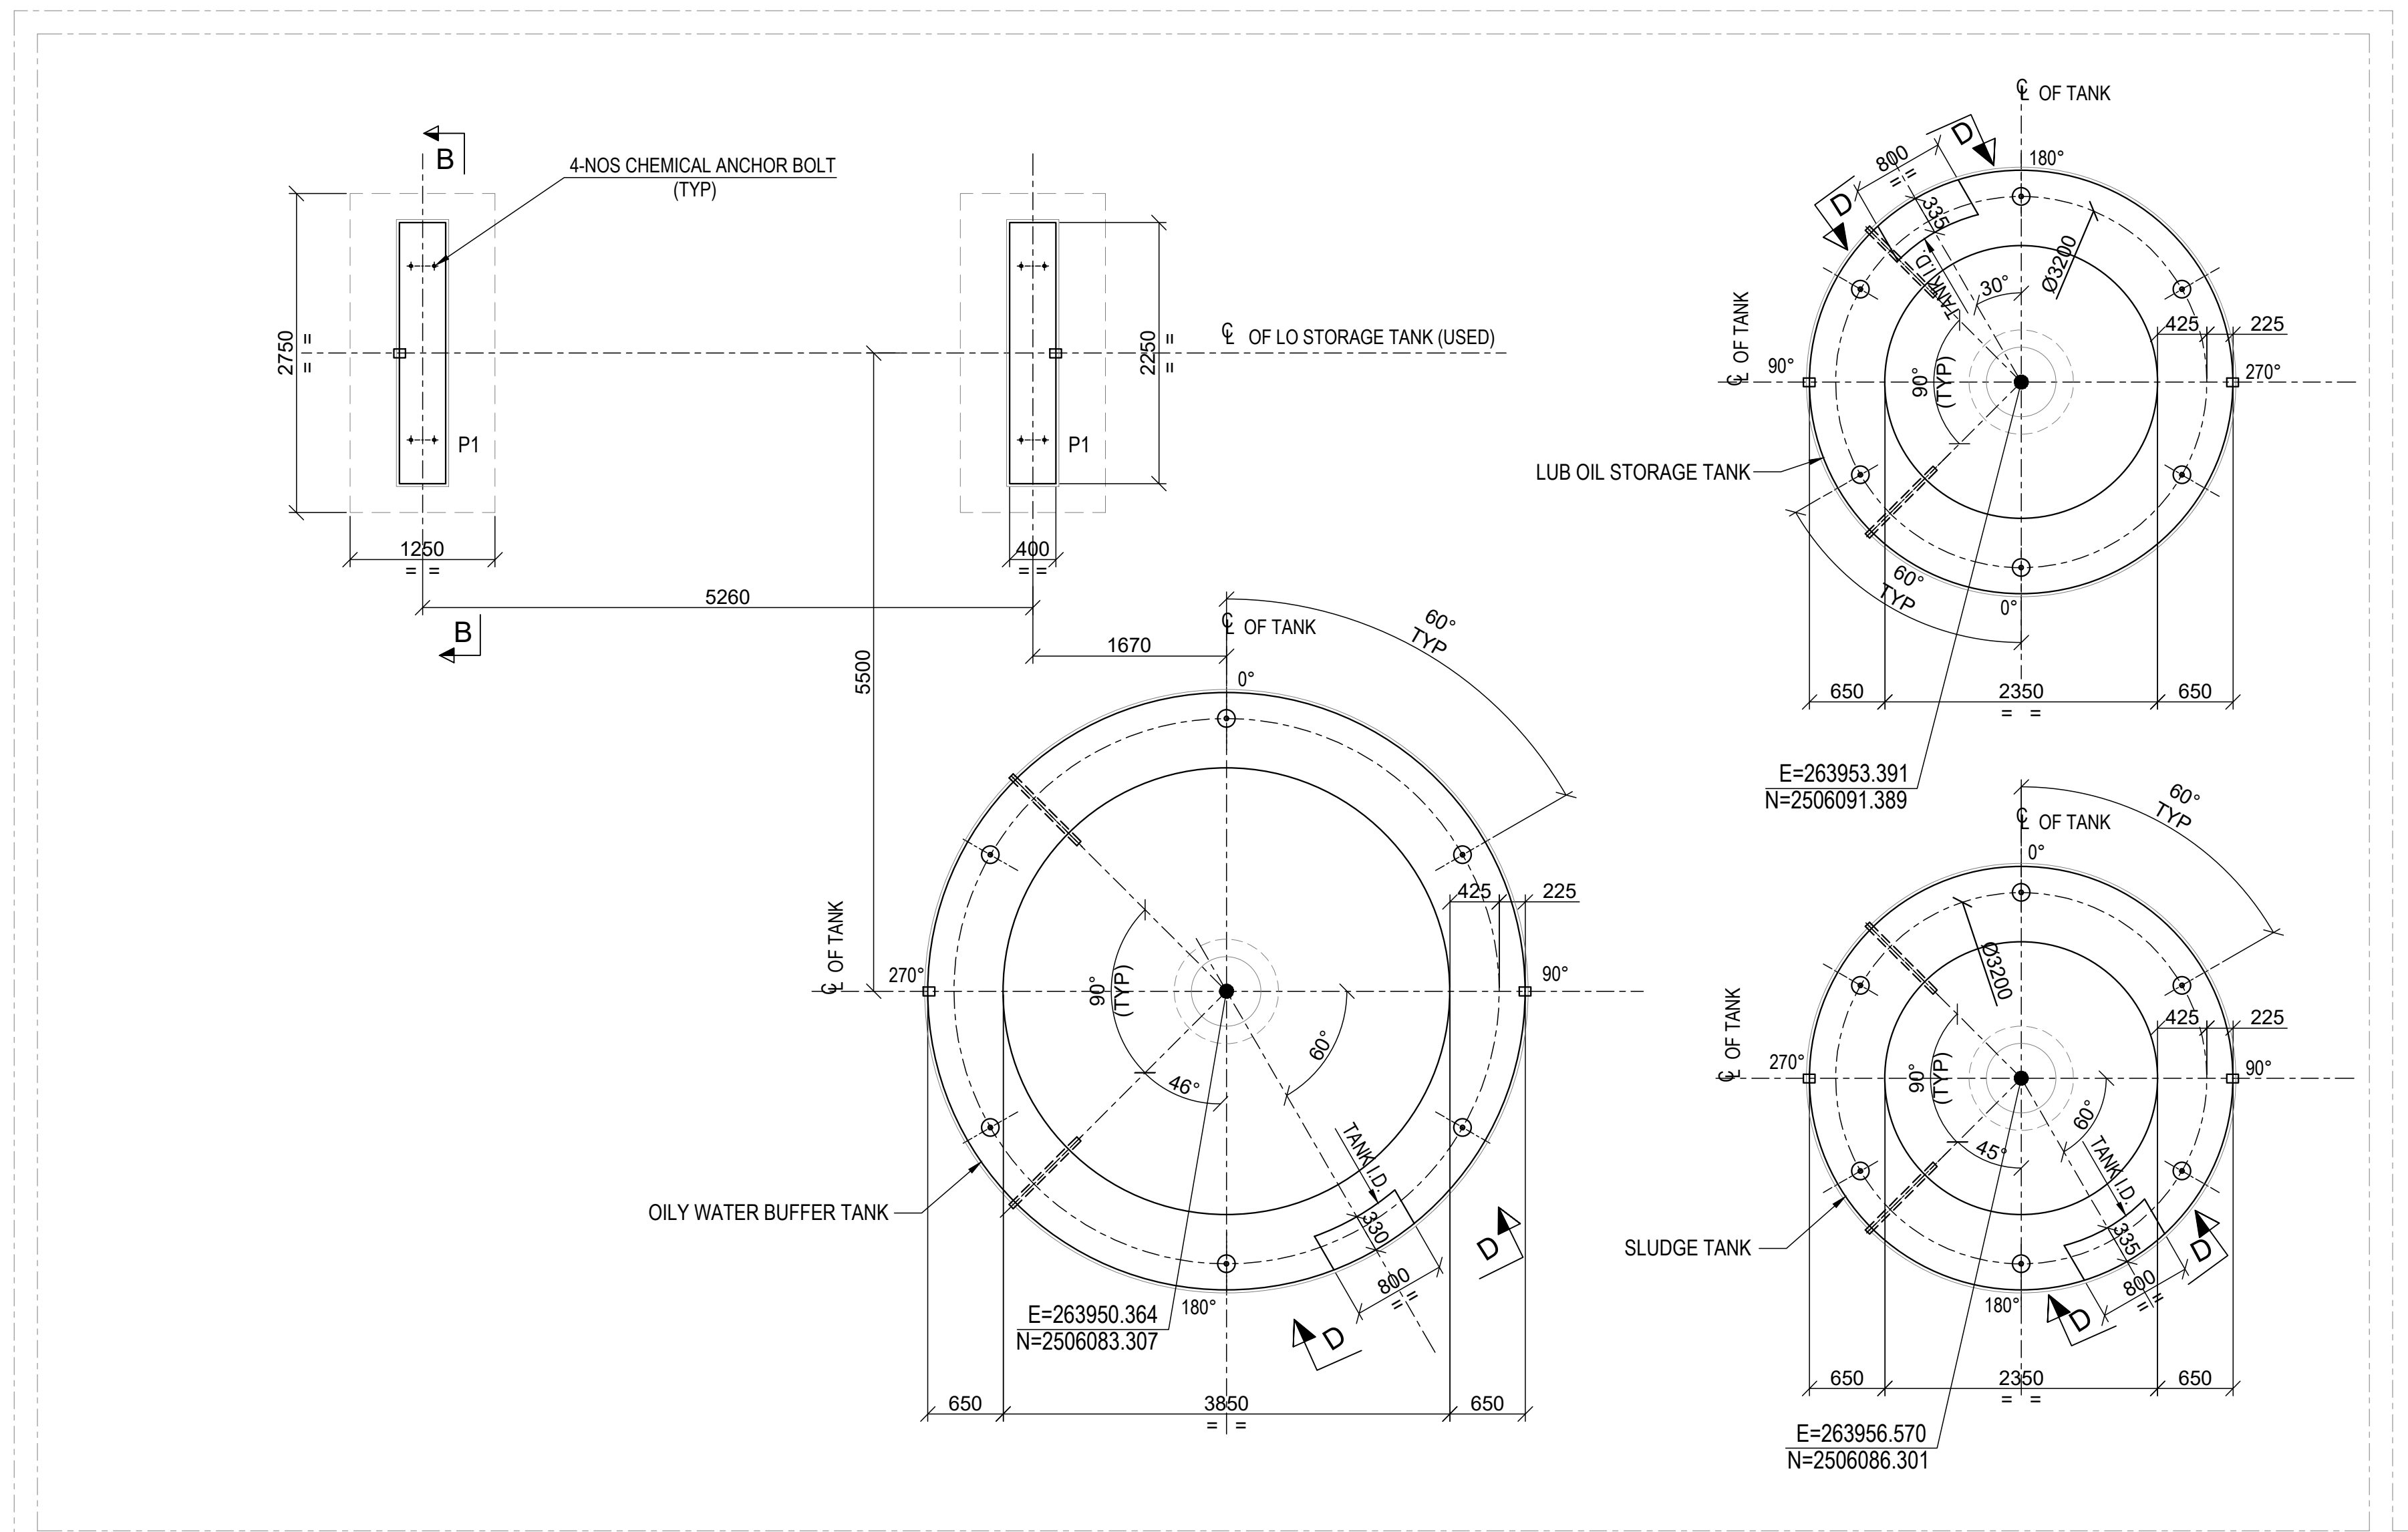

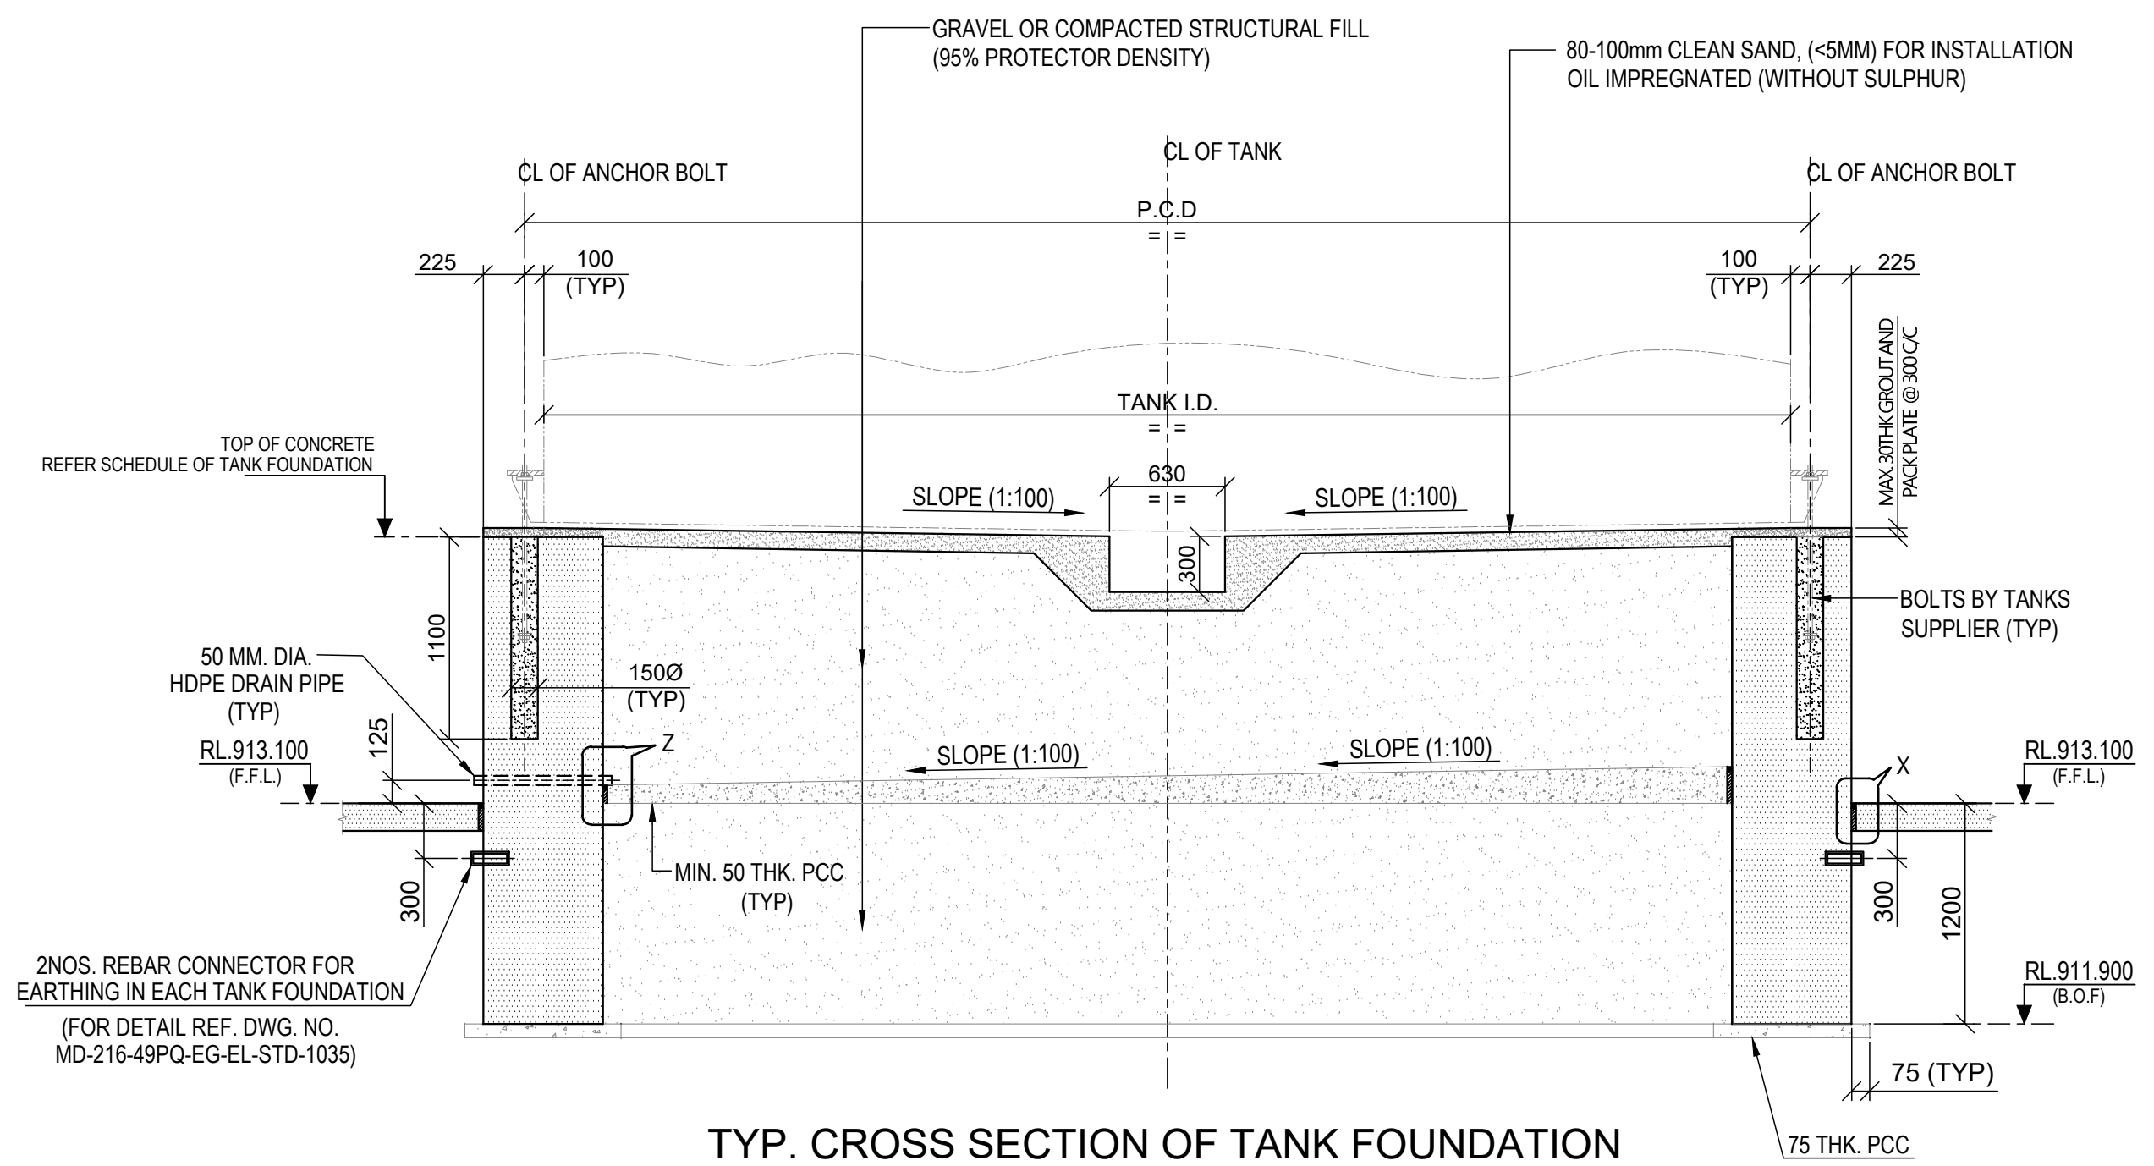
GRAVEL OR COMPACTED STRUCTURAL FILL (95% PROTECTOR DENSITY)
80-100mm CLEAN SAND, (<5MM) FOR INSTALLATION OIL IMPREGNATED (WITHOUT SULPHUR)
℄L OF ANCHOR BOLT
℄L OF TANK
℄L OF ANCHOR BOLT
P.C.D
225
100 (TYP)
100 (TYP)
225
TANK I.D.
TOP OF CONCRETE REFER SCHEDULE OF TANK FOUNDATION
SLOPE (1:100)
630
SLOPE (1:100)
300
MAX 30THK GROUT AND PACK PLATE @ 300 C/C
BOLTS BY TANKS SUPPLIER (TYP)
1100
50 MM. DIA. HDPE DRAIN PIPE (TYP)
150Ø (TYP)
RL.913.100 (F.F.L.)
125
Z
SLOPE (1:100)
SLOPE (1:100)
X
RL.913.100 (F.F.L.)
MIN. 50 THK. PCC (TYP)
300
300
1200
2NOS. REBAR CONNECTOR FOR EARTHING IN EACH TANK FOUNDATION
(FOR DETAIL REF. DWG. NO. MD-216-49PQ-EG-EL-STD-1035)
RL.911.900 (B.O.F)
75 (TYP)
75 THK. PCC (TYP.)

TYP. CROSS SECTION OF TANK FOUNDATION

(SCALE 1:40)

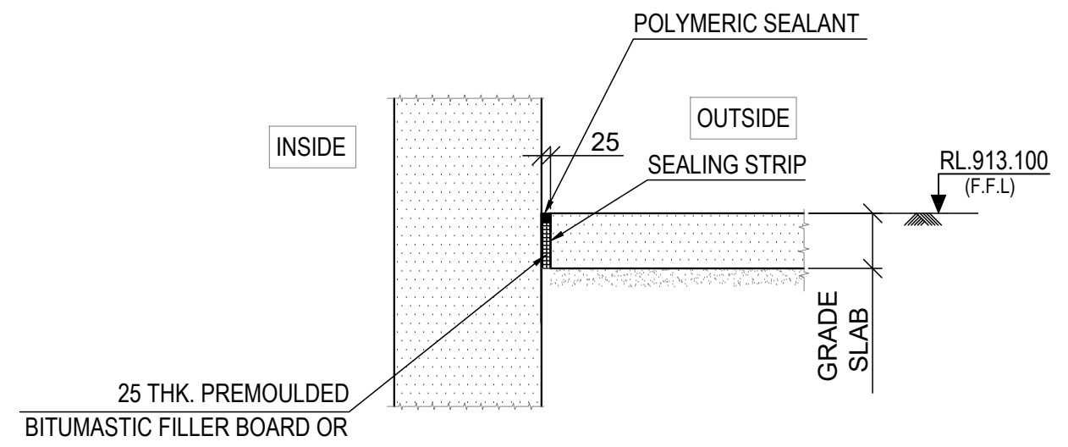

DETAIL - X

(SCALE 1:20)

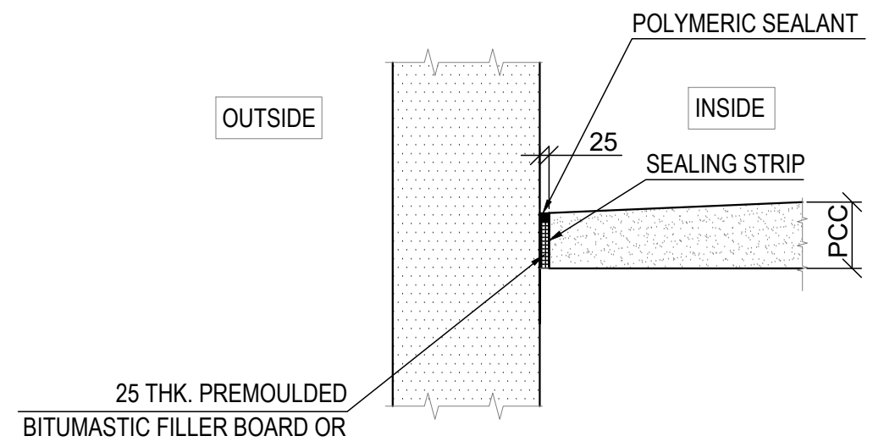
POLYMERIC SEALANT
OUTSIDE
INSIDE
25
SEALING STRIP
PCC
25 THK. PREMOULDED BITUMASTIC FILLER BOARD OR POLYSTYRENE JOINT FILLER

DETAIL - Z

(SCALE 1:20)

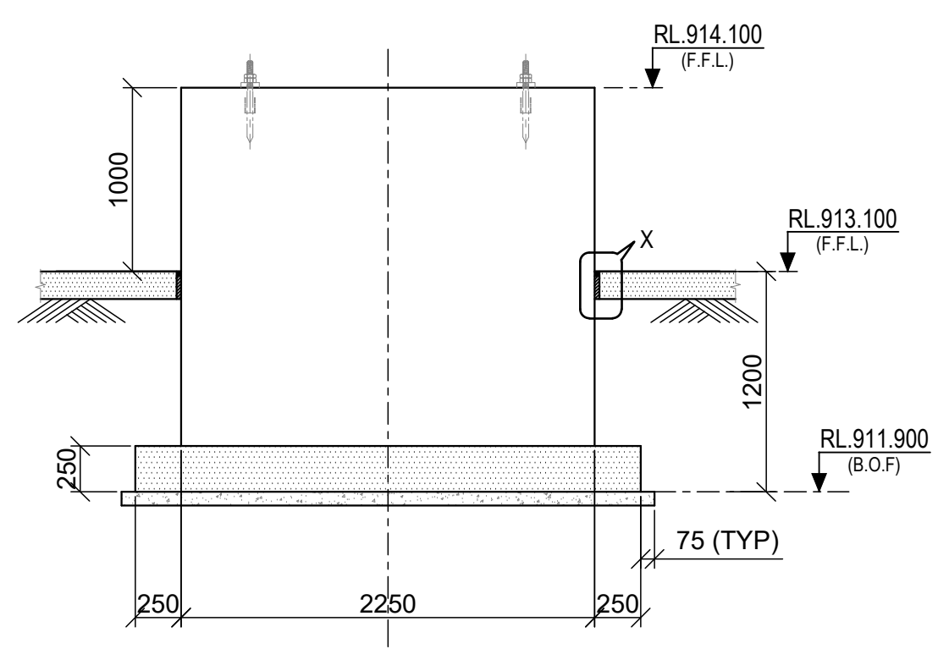

SECTION B - B

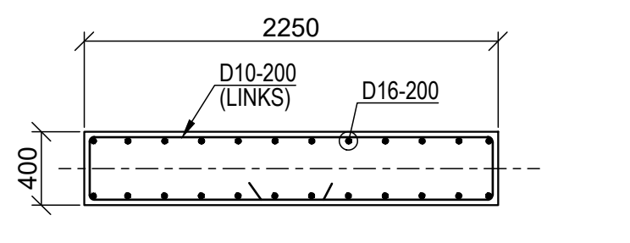

SECTION C - C

(RC DETAIL OF PEDESTAL MKD. P1)
(SCALE 1:40)

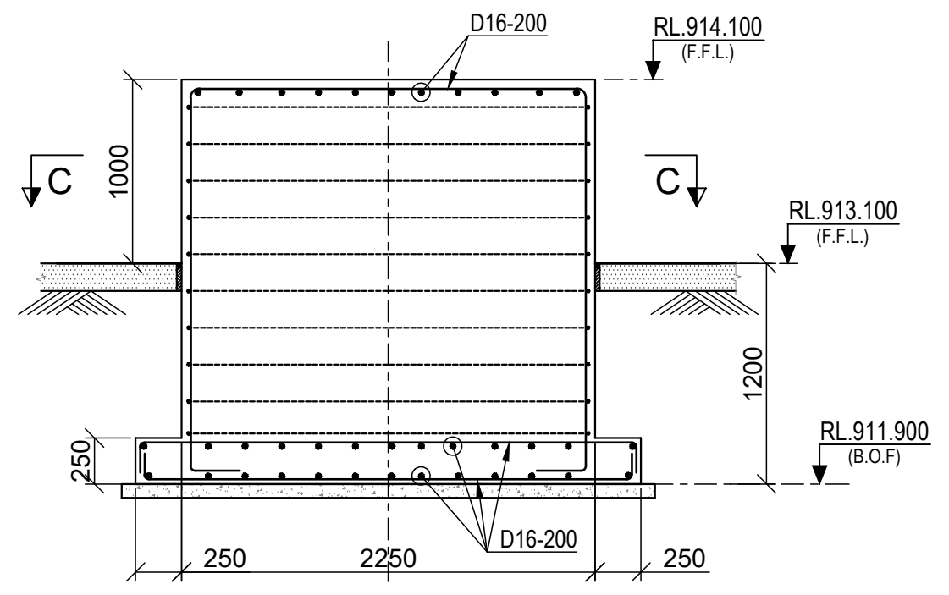

SECTION B - B

(SHOWING RC DETAIL)
(SCALE 1:40)

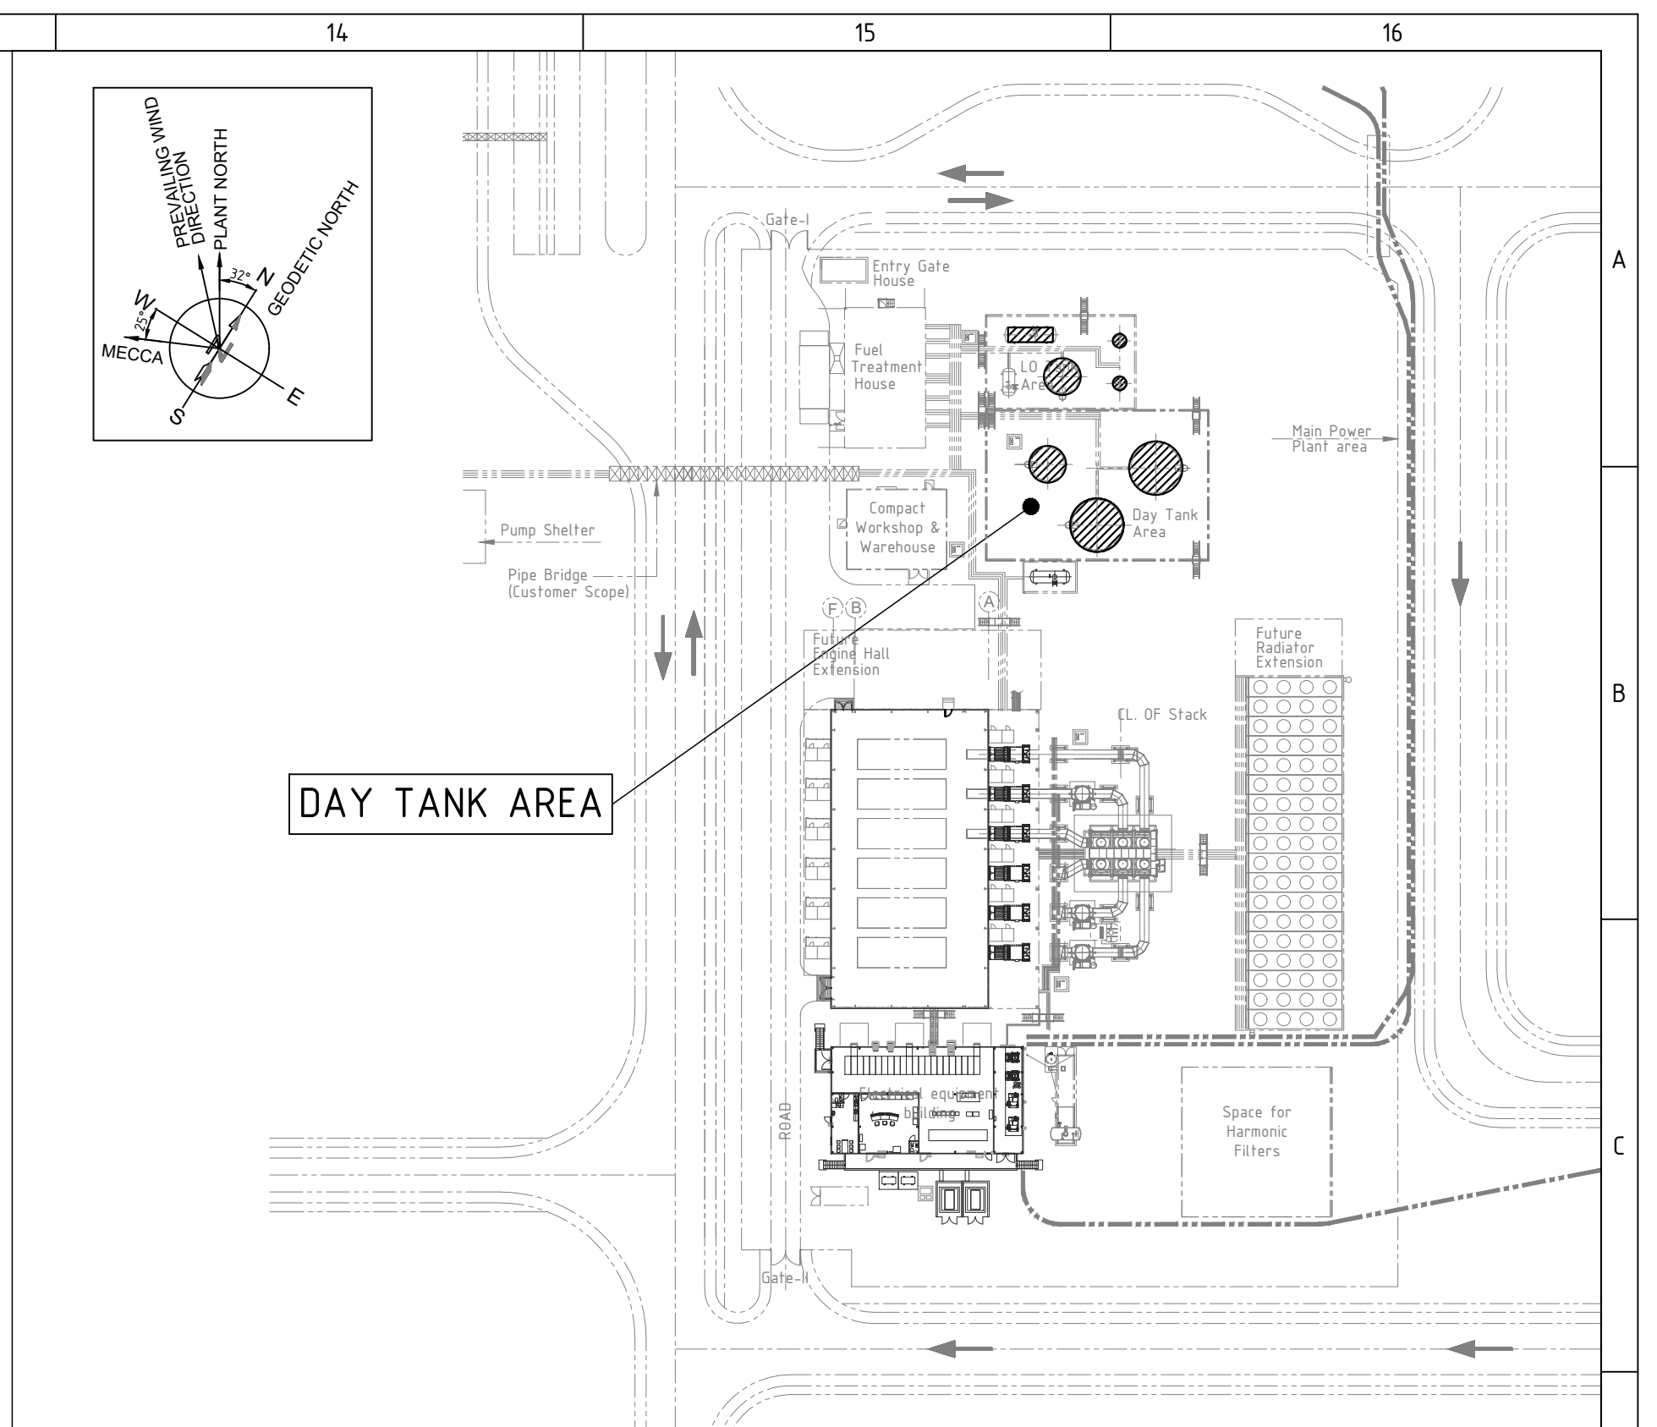

KEY PLAN

(SCALE 1:1000)

SCHEDULE OF TANK FOUNDATION

SERIAL NO.	TANK NAME	TANK I.D.	P.C.D	BOLT DIA. (MM)	BOLT NUMBERS REQUIRED	T.O.C OF RING WALL FDN.	REMARKS
1.	HFO DAY TANK	6800Ø	7000Ø	36	8	RL. 914.570	BOLT IS SUPPLIED BY TANK SUPPLIER
2.	LFO DAY TANK	6800Ø	7000Ø	36	8	RL. 913.970	
3.	HFO BUFFER TANK	4500Ø	4700Ø	36	6	RL. 913.970	
4.	OILY WATER BUFFER TANK	4500Ø	4700Ø	36	6	RL. 913.970	
5.	LUB OIL STORAGE TANK	3000Ø	3200Ø	36	6	RL. 913.970	
6.	SLUDGE TANK	3000Ø	3200Ø	36	6	RL. 913.970	

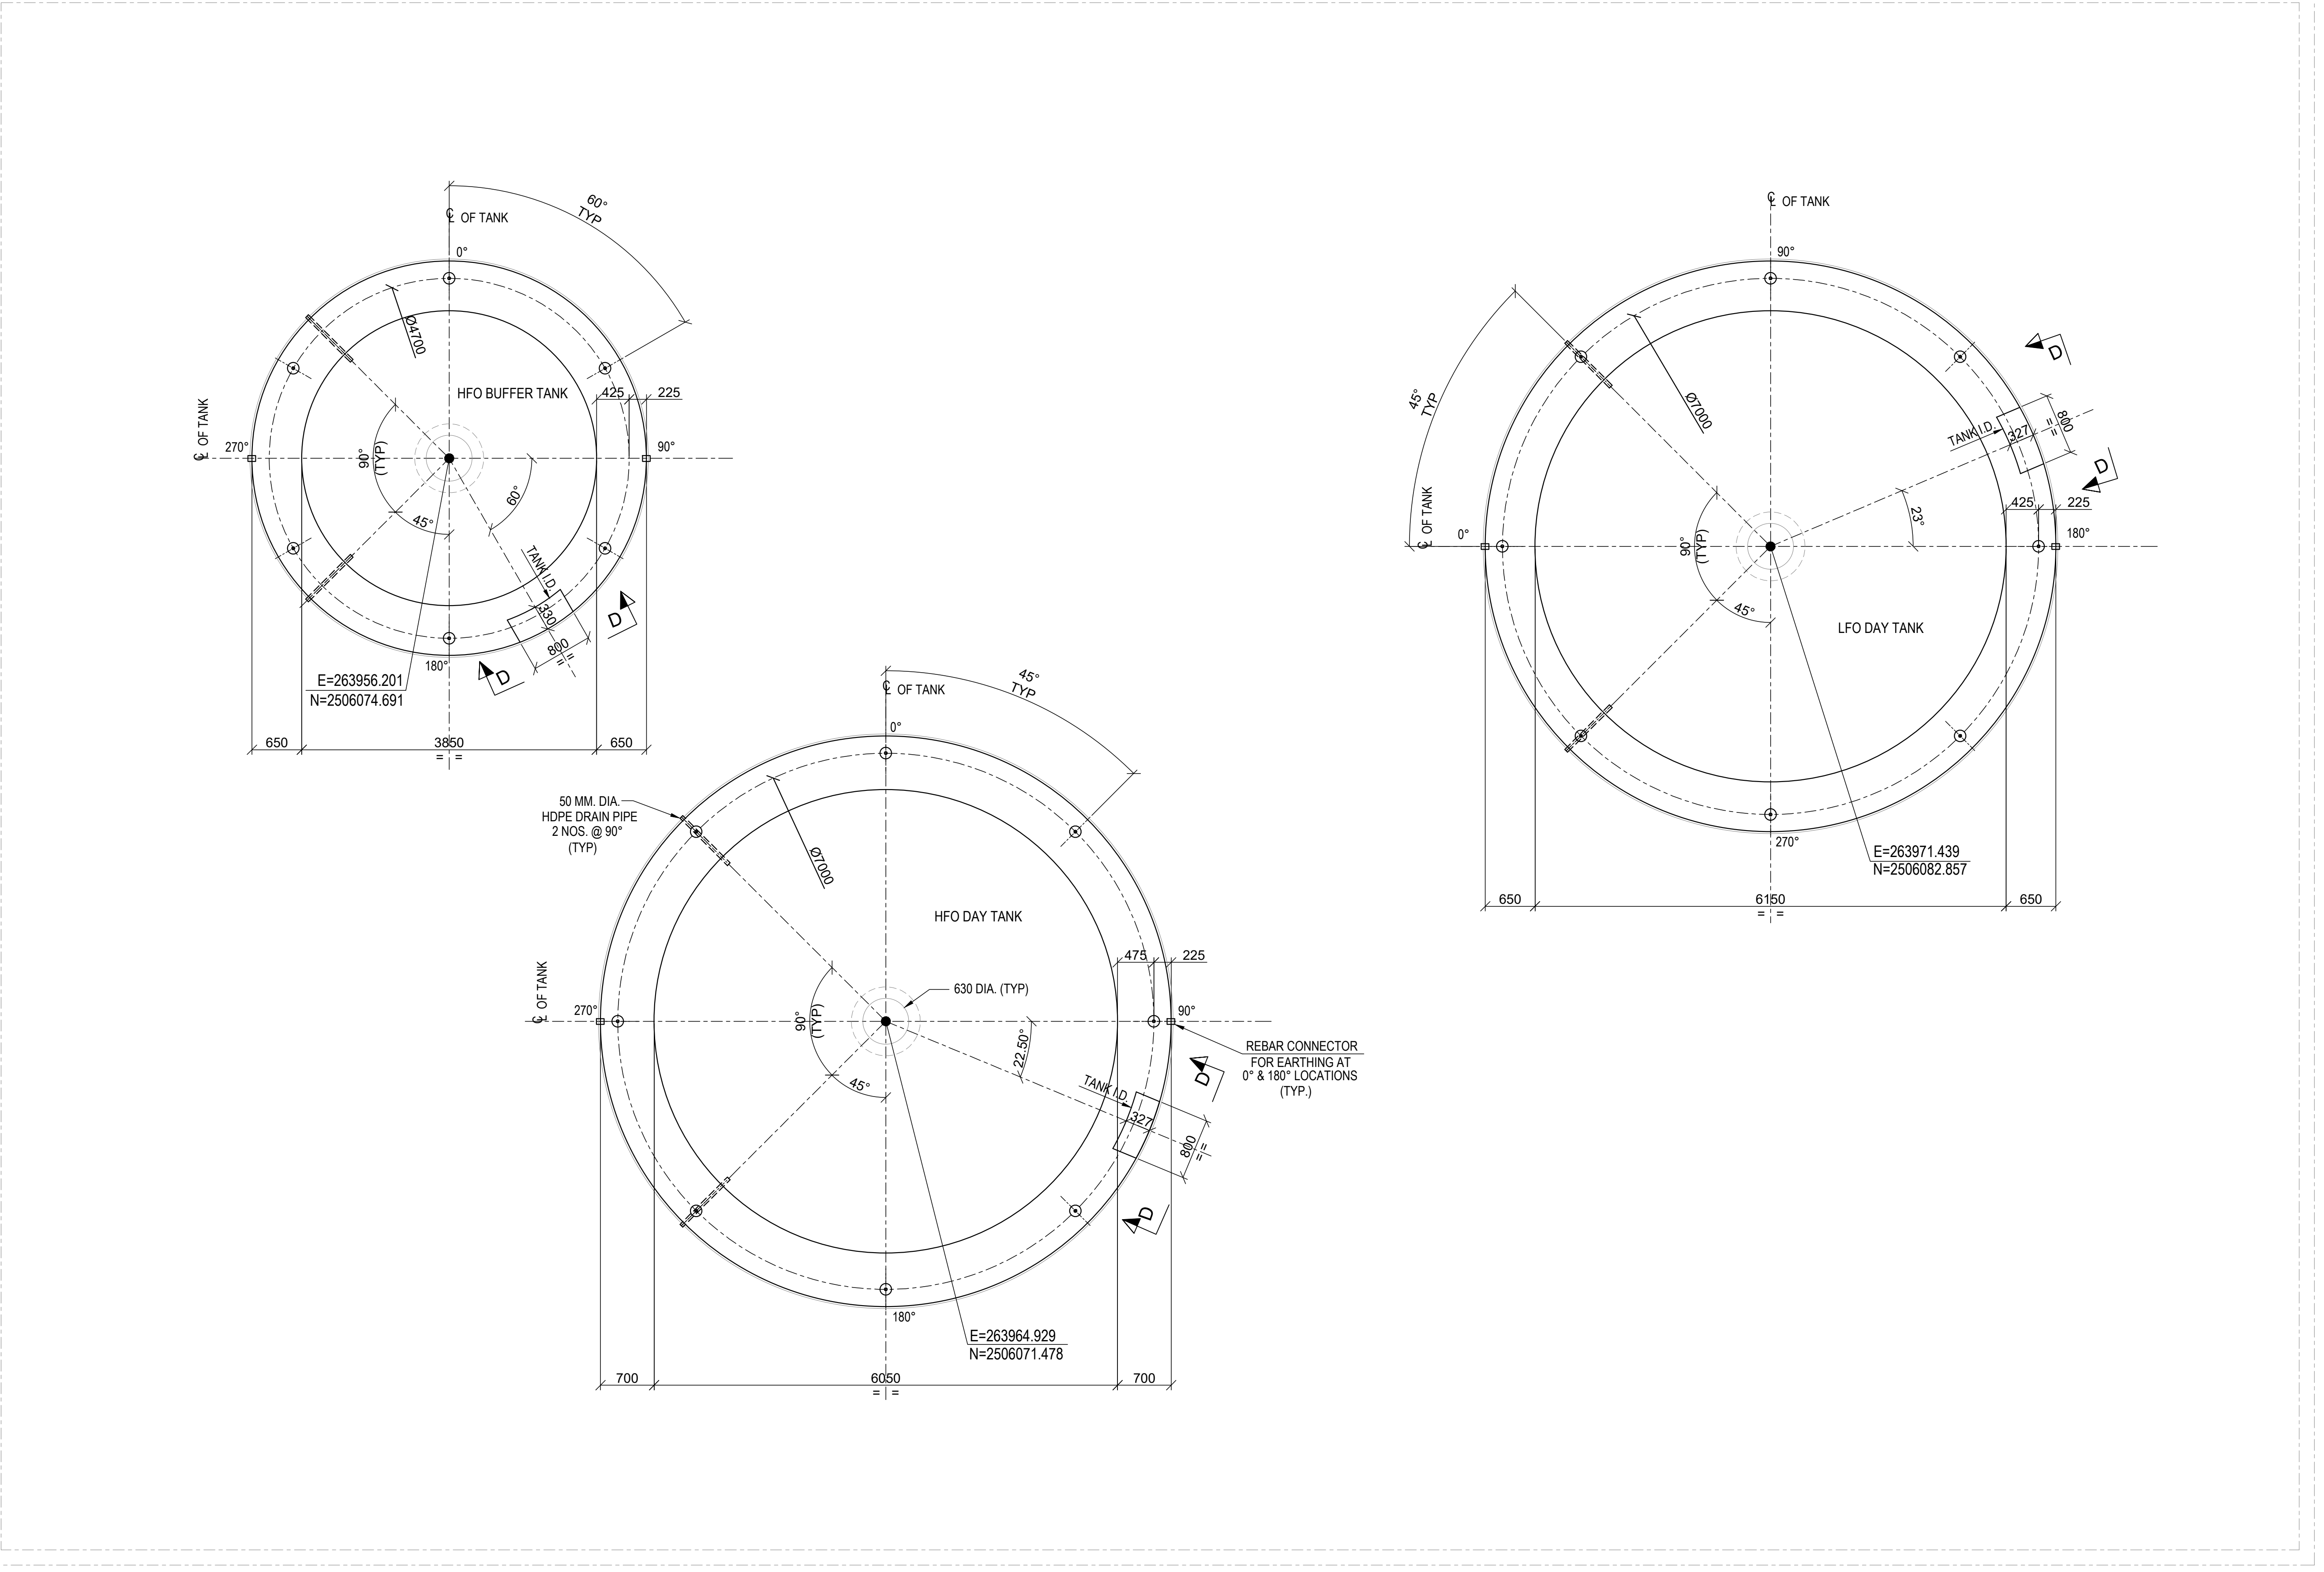

LAYOUT OF DAY TANK AREA

(SCALE 1:50)

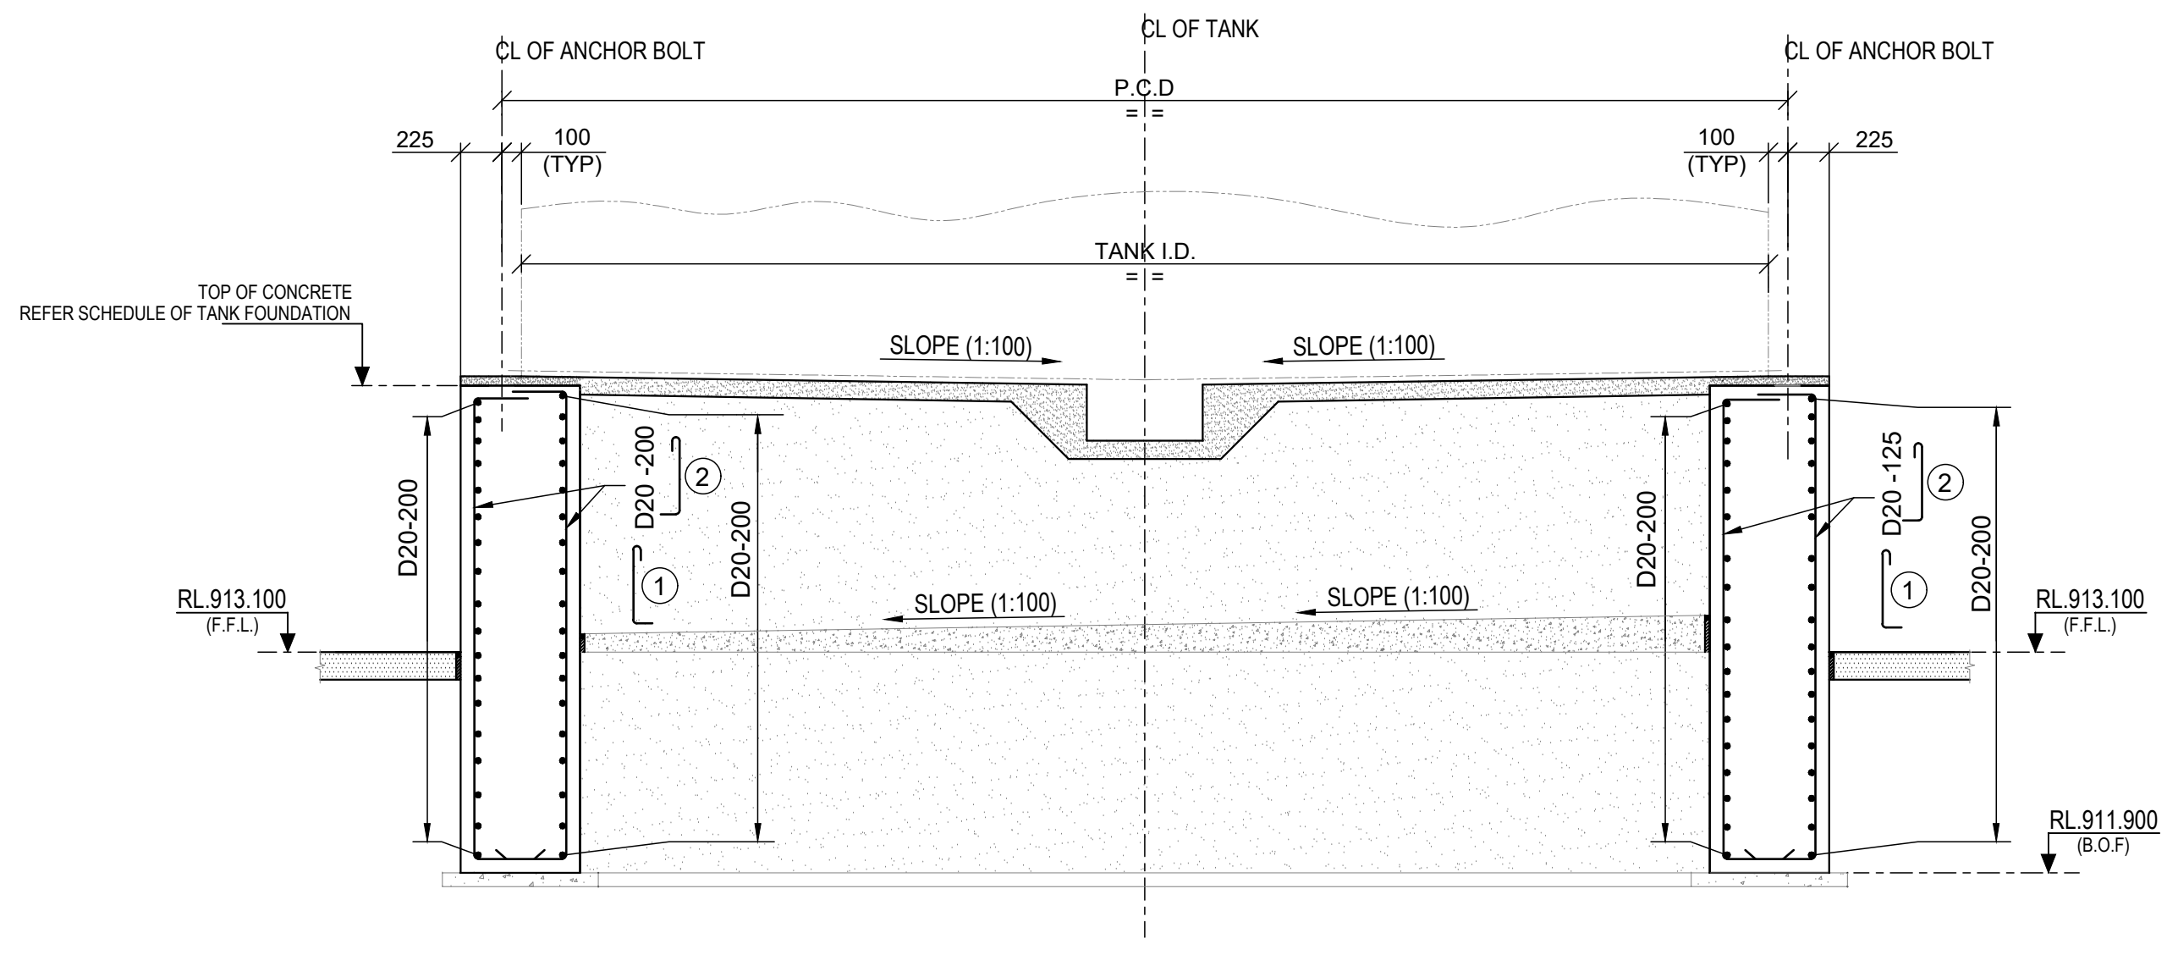

SECTION A - A

(SCALE 1:40)

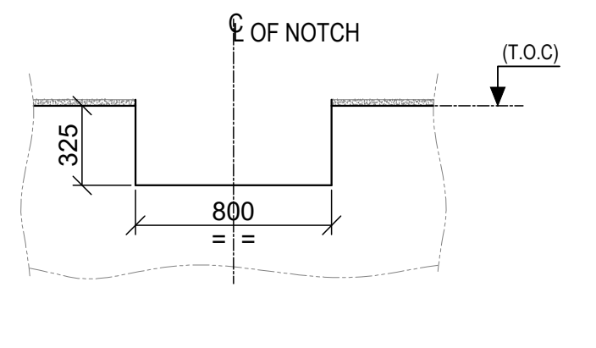

SECTION D -D

(SCALE 1:30)

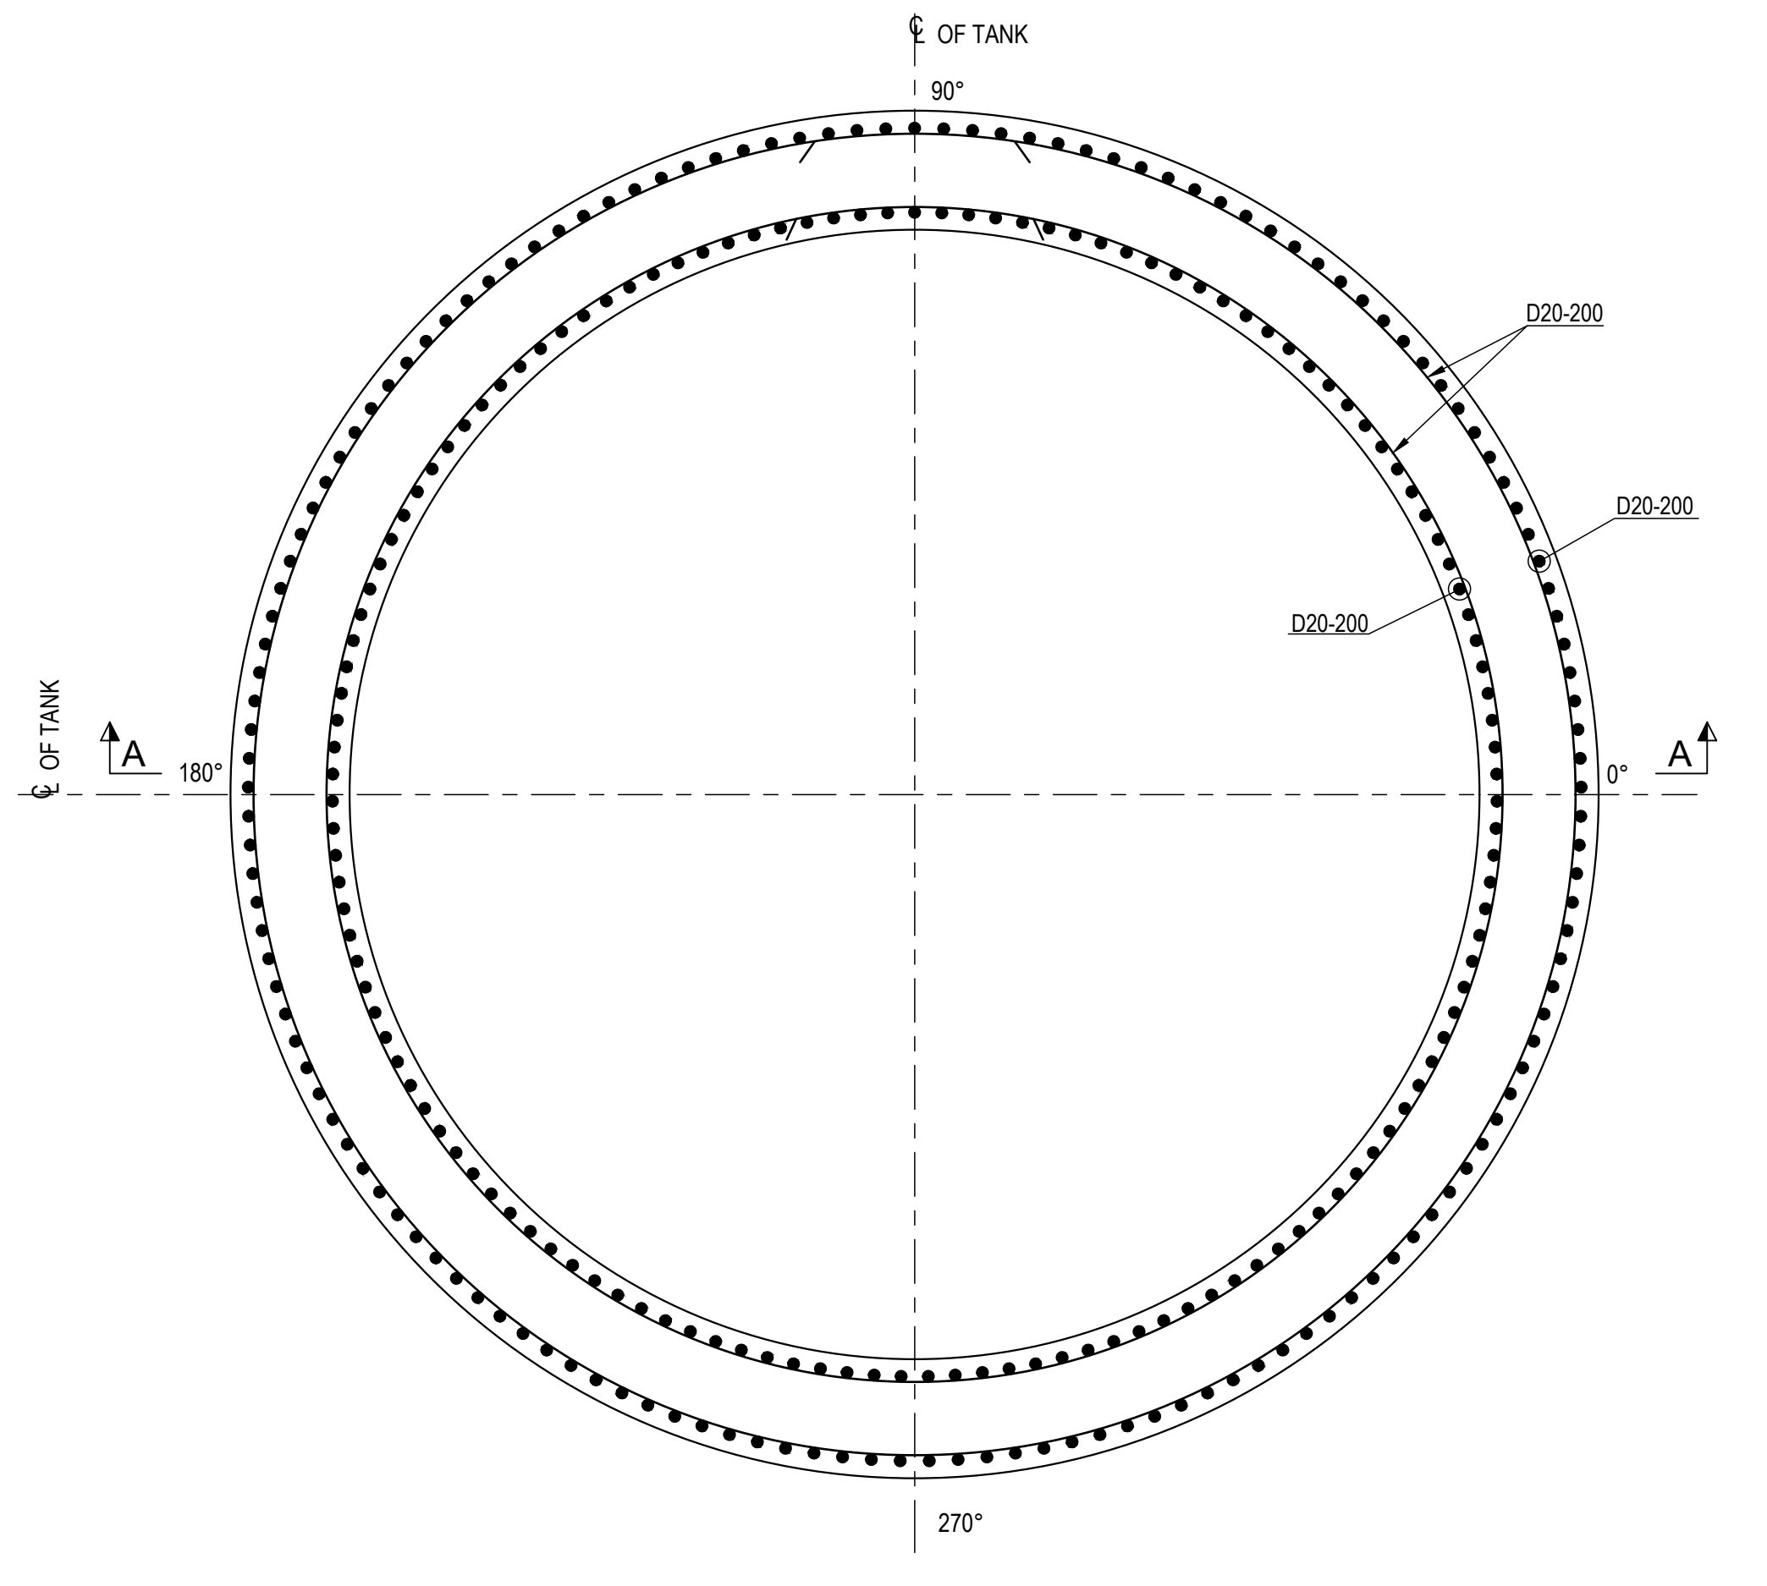

RC DETAIL OF PLAN FOR TANK FOUNDATION

(SCALE 1:40)

LEGEND :-

RL. - REDUCED LEVEL.
℄. - CENTRE LINE.
T.O.C. - TOP OF CONCRETE.
T.O.G. - TOP OF GROUT
F.G.L. - FINISHED GROUND LEVEL.
P.C.D. - PITCH CIRCLE DIAMETER.
TYP. - TYPICAL.
PCC. - PLAIN CEMENT CONCRETE.
MKD. - MARKED.
Ø - DIAMETER.
R - RADIUS.
I.D - INNER DIAMETER.
O.D - OUTER DIAMETER.
THK. - THICK.
DET. - DETAIL.
TNK. - TANK.
FDN. - FOUNDATION.
TOP REINFORCEMENT. - - - -
BOTTOM REINFORCEMENT. ———

NOTES :-

1. ALL DIMENSIONS ARE IN MILLIMETRES AND LEVELS AND CO-ORDINATES ARE IN METRES. UNLESS OTHERWISE STATED.
2. GRADE OF CONCRETE SHALL BE 35 MPa FOR FOUNDATION & 15 MPa FOR BLINDING CONCRETE.
3. GRADE OF REINFORCEMENT SHALL BE DEFORMED BAR 420 MPa (GRADE 60) - ASTM A615/A615M.
4. NET SAFE BEARING CAPACITY OF SOIL AT BOTTOM OF FOUNDATION CONSIDER 500KN/ SQ. M.
5. CLEAR COVER TO MAIN REINFORCEMENT SHALL BE FOUNDATIONS = 50 MM., WALLS = 50 MM., GRADE SLAB = 25 MM.
6. IF ANY PART OF FOUNDATION COMES ON BACKFILL ZONE OF ADJACENT FOUNDATION OR ANY LOOSE SOIL ARE ENCOUNTERED BELOW FOUNDATION LEVEL THE SAME SHALL BE REMOVED AND FILLED WITH PCC.
7. BOLTS TO BE SUPPLIED BY EQUIPMENT SUPPLIER.
8. ALL OTHER NOTES REFER DRAWING NO. MD-101-SMEM-EG-ST-DST-0001 TO 0008.
9. GENERAL NOTES FOR CIVIL WORKS & STANDARD REINFORCEMENT DETAIL REFER DRAWING NO. MD-216-1000-EG-CV-DED-1001 & 1005.
10. REBAR AT NOTCH LOCATION TO BE ADJUSTED SUIT AT SITE.

DOCUMENT NUMBER	REFERENCE DOCUMENTS	REV	DATE	REVISION DESCRIPTION	DRN	CHK	ENG	APP	EMP
MD-216-49PR-EG-ME-GAD-V553-1040	LFO DAY TANK	D01	17/02/2023	AS-BUILT	AMJ	SGC	SHD	PRI	
MD-216-49PR-EG-ME-GAD-V553-1039	SLUDGE TANK	C04	07/01/2021	ISSUED FOR CONSTRUCTION AND REVISED AS MKD. C04	AMJ	SGC	SHD	PRI	
MD-216-49PR-EG-ME-GAD-V553-1038	LUBE OIL STORAGE TANK	C03	21/11/2020	ISSUED FOR CONSTRUCTION AND REVISED AS MKD. C03	PDK	SGC	SHD	PR1	
MD-216-49PR-EG-ME-GAD-V553-1036	HFO BUFFER TANK	C02	12/09/2020	ISSUED FOR CONSTRUCTION AND REVISED AS MKD. C02	AMJ	SGC	SHD	PR1	
MD-216-1000-EG-ST-CRT-1001	CIVIL, STRUCTURAL & ARCHITECTURAL - DESIGN CRITERIA	C01	24/08/2020	ISSUED FOR CONSTRUCTION C01	AMJ	SGC	SHD	PRI	
MD-216-49PR-EG-ME-LAD-V553-1002	LAYOUT OF POWER GENERATION	A01	31/07/2020	ISSUED FOR REFERENCE	AMJ	SGC	SHD	PRI	

DOCUMENT NUMBER	REFERENCE DOCUMENTS	REV	DATE	REVISION DESCRIPTION	DRN	CHK	ENG	APP	EMP

RESERVED FOR VENDOR LOGO AND DRAWING NUMBER

LARSEN & TOUBRO

This drawing is the property of LARSEN & TOUBRO and must not be passed on to any person or body not authorized by us to receive it nor be copied or otherwise made use either in full or in part by such person or body without our prior permission in writing.

Outotec

The content of these documents are the sole property of Outotec Oyj. Any rights not expressly granted herein are reserved. Reproduction, transfer or distribution of part or all of the contents in any form without prior written permission of Outotec is prohibited.

MA'ADEN معادن
Saudi Arabian Mining Company شركة التعدين العربية السعودية

This document and the information contained herein is Ma'aden proprietary know-how. This document or any part thereof should not be reproduced, stored in a retrieval system or transmitted by any means, electronic or otherwise, or divulged without prior written permission of Ma'aden.

LARSEN & TOUBRO DRAWING NUMBER	019045__008__C__G__24292__002		REVISION 5
OUTOTEC DRAWING NUMBER	900707 __ GAU01 __ WG01__MTL01 __45078	DOCUMENT ID 0U100688136	REVISION 5
DRAWN	AMJ	17/07/2020	
CHECKED	SGC	19/06/2020	
ENGINEER	SHD	15/07/2020	
APPROVED	PRI	31/07/2020	
EMPLOYER			
SCALE	1:100, 1:40, 1:20	A0	

MANSOURAH - MASSARAH GOLD PROJECT
GENERAL ARRANGEMENT
POWER PLANT DAY TANK AREA
GA AND DETAIL OF TANK FOUNDATION

DRAWING NUMBER
MD - 216 - 49PR - EG - CV - GAD - 2005
REV
D01