MD - 216 - 49PR - EG - CV - GAD - 2008
DRAWING NUMBER
D01
REV

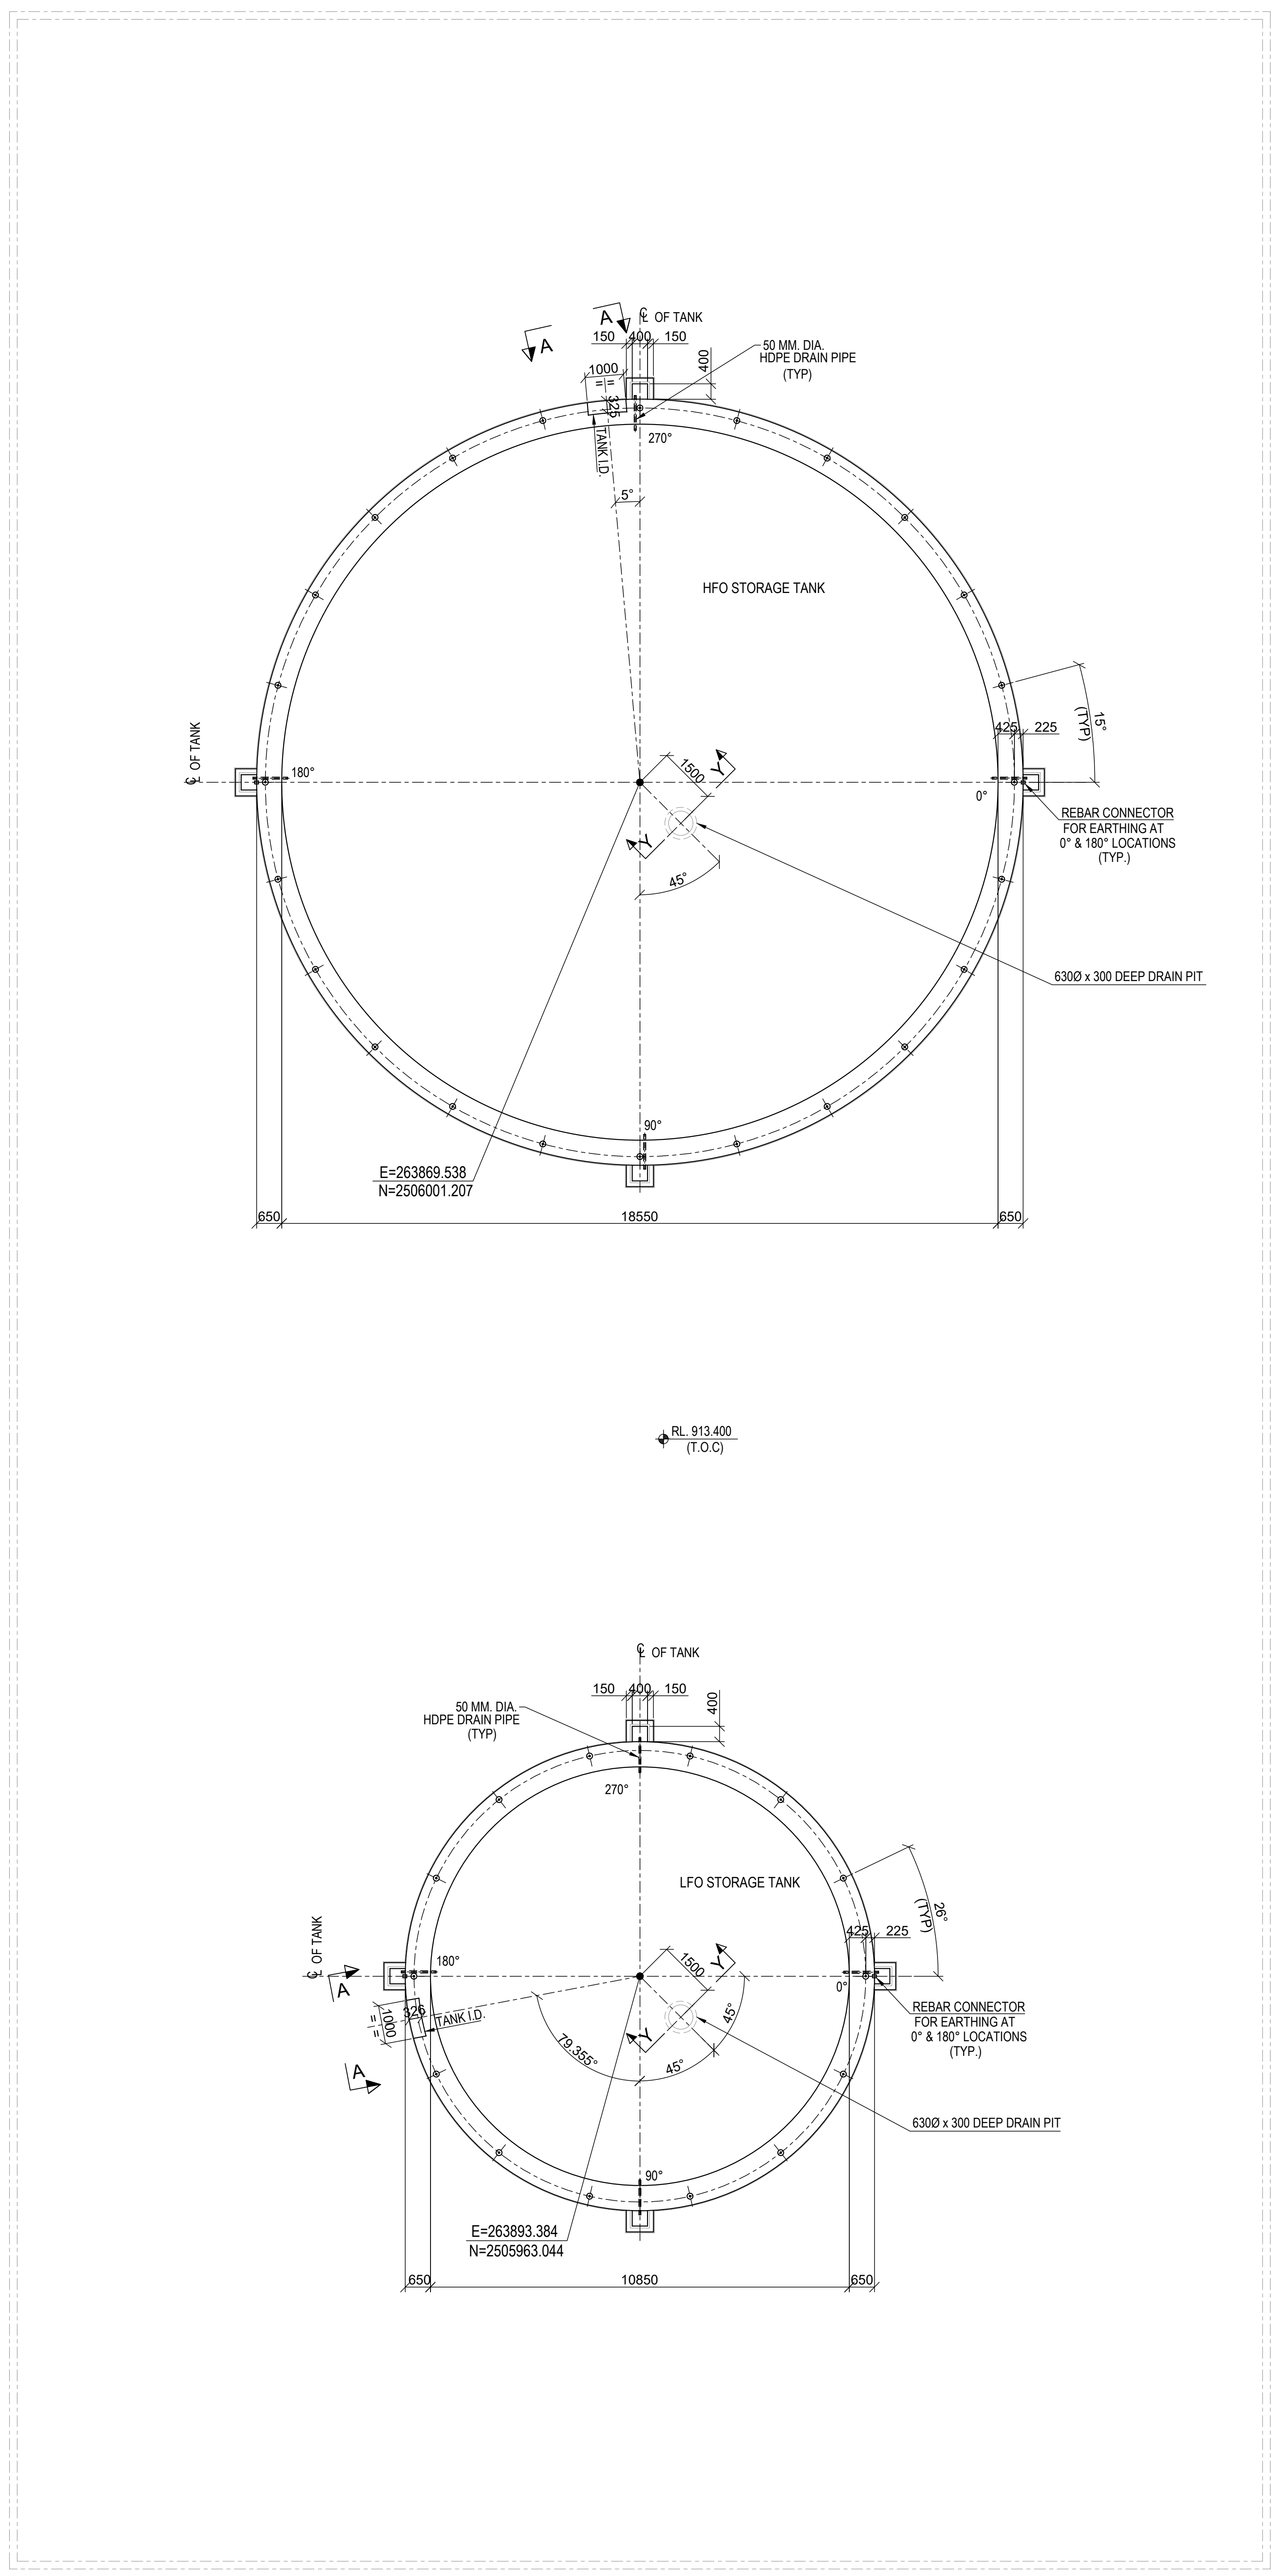

LAYOUT OF STORAGE TANK AREA
(SCALE 1:100)

SCHEDULE OF TANK FOUNDATION

SERIAL NO.	TANK NAME	TANK I.D.	P.C.D	BOLT DIA. (MM)	BOLT NUMBERS REQUIRED	T.O.C OF RING WALL FDN.	REMARKS
1.	LFO STORAGE TANK	11500Ø	11700Ø	36	14	RL. 914.670	BOLT IS SUPPLIED BY TANK SUPPLIER
2.	HFO STORAGE TANK	19200Ø	19400Ø	36	24	RL. 914.670	

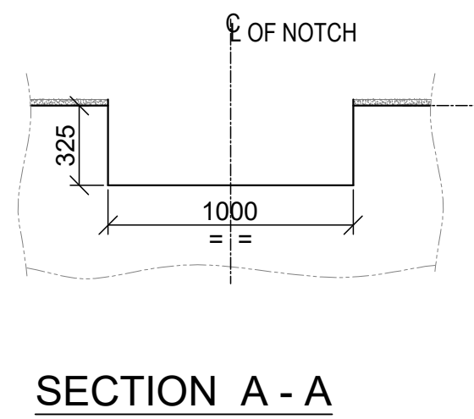

SECTION A - A
(SCALE 1:30)

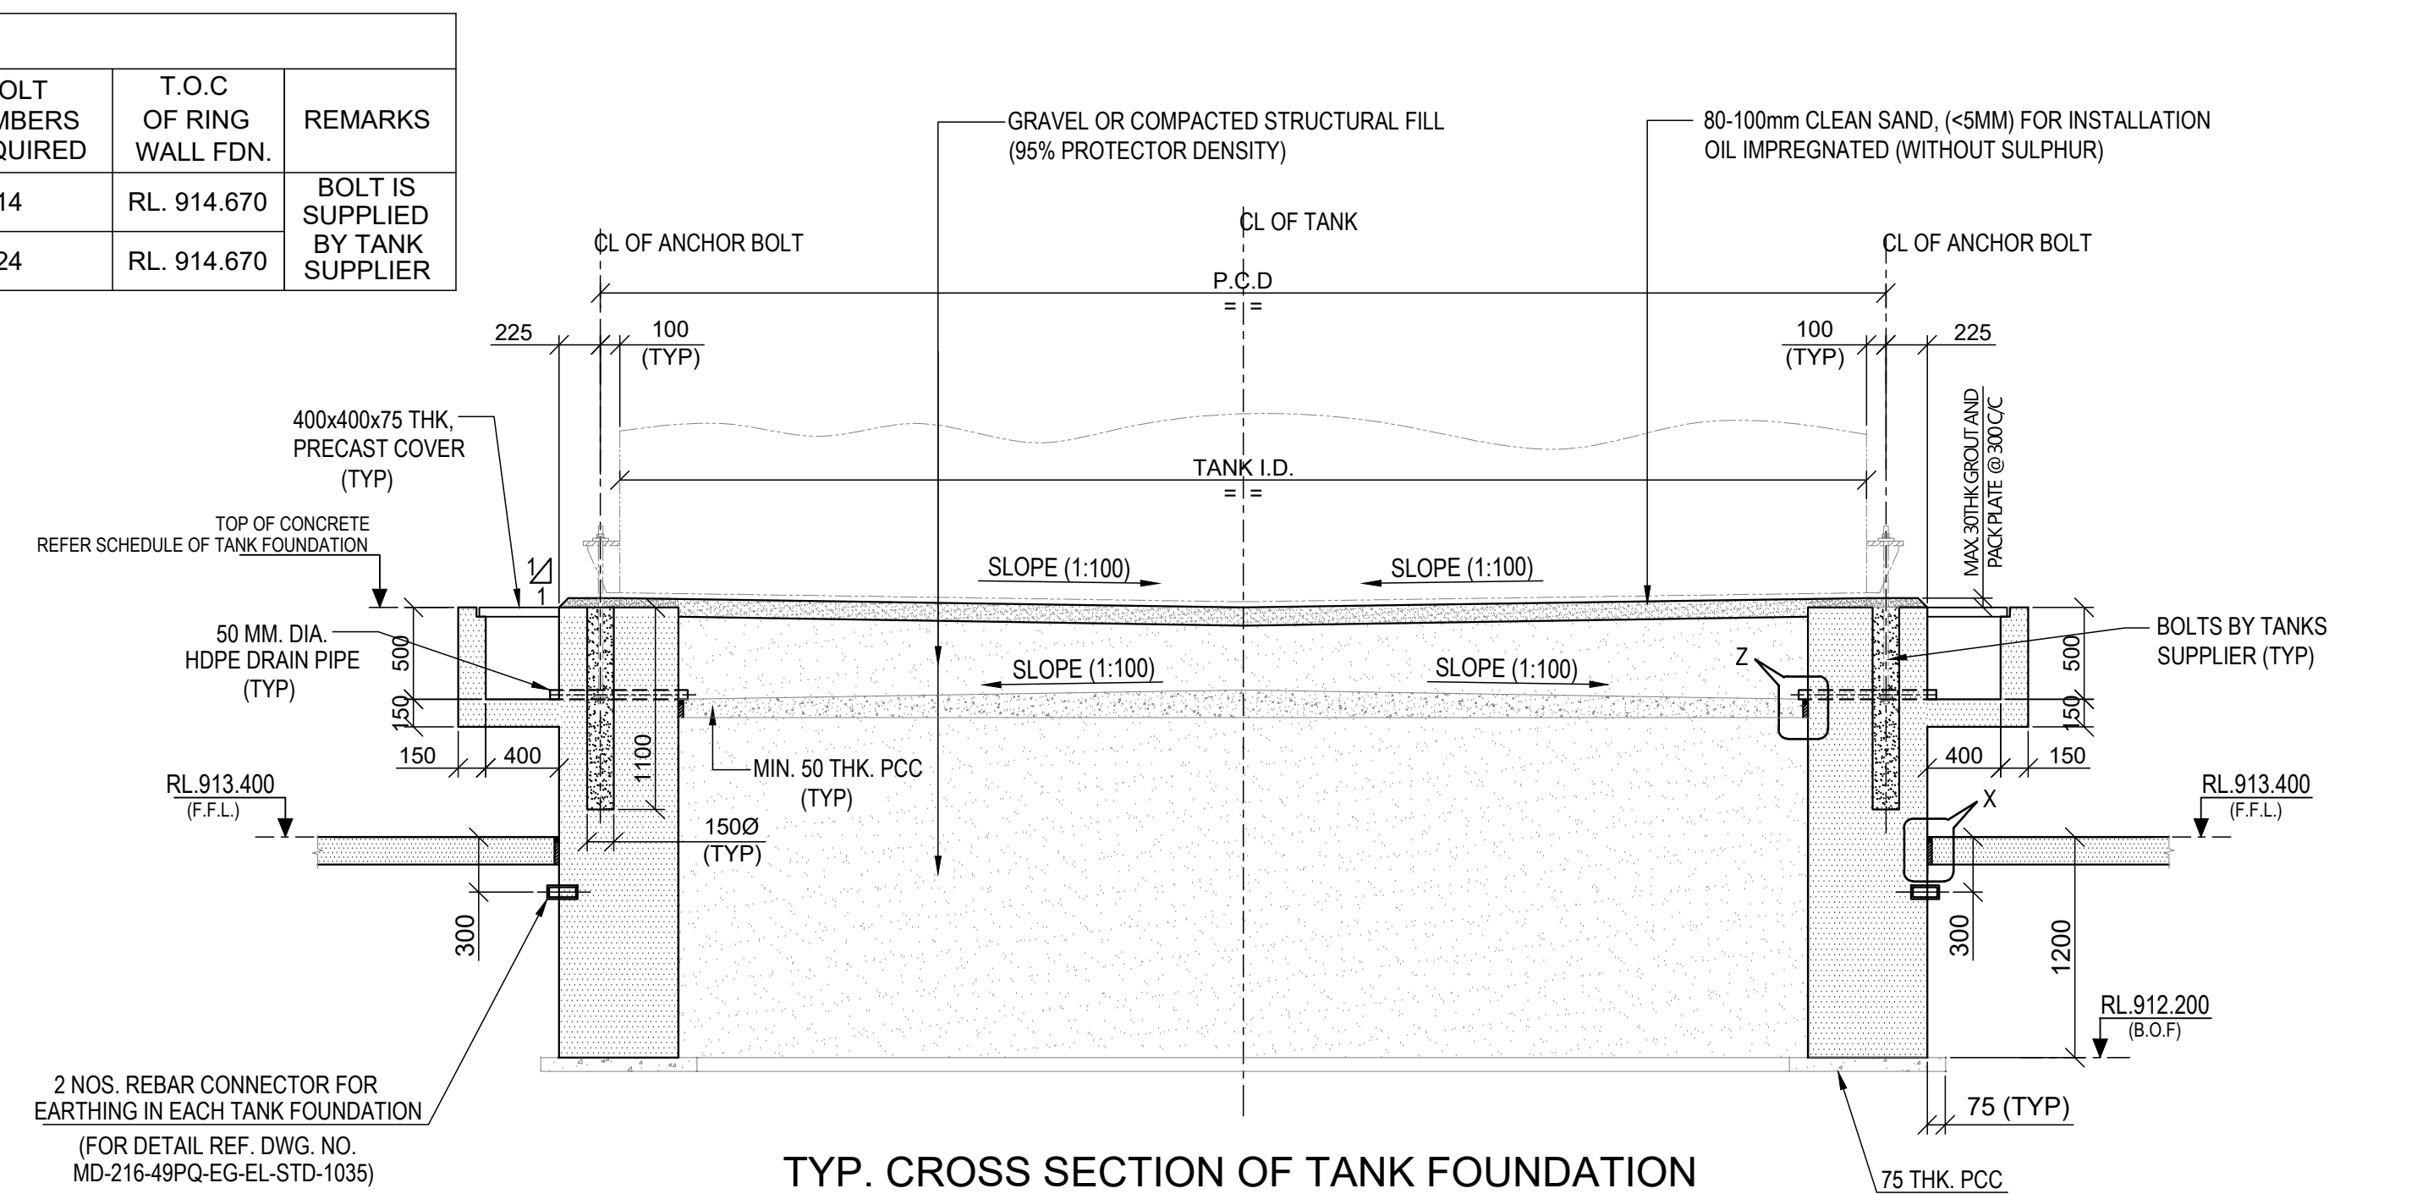

TYP. CROSS SECTION OF TANK FOUNDATION
(SCALE 1:40)

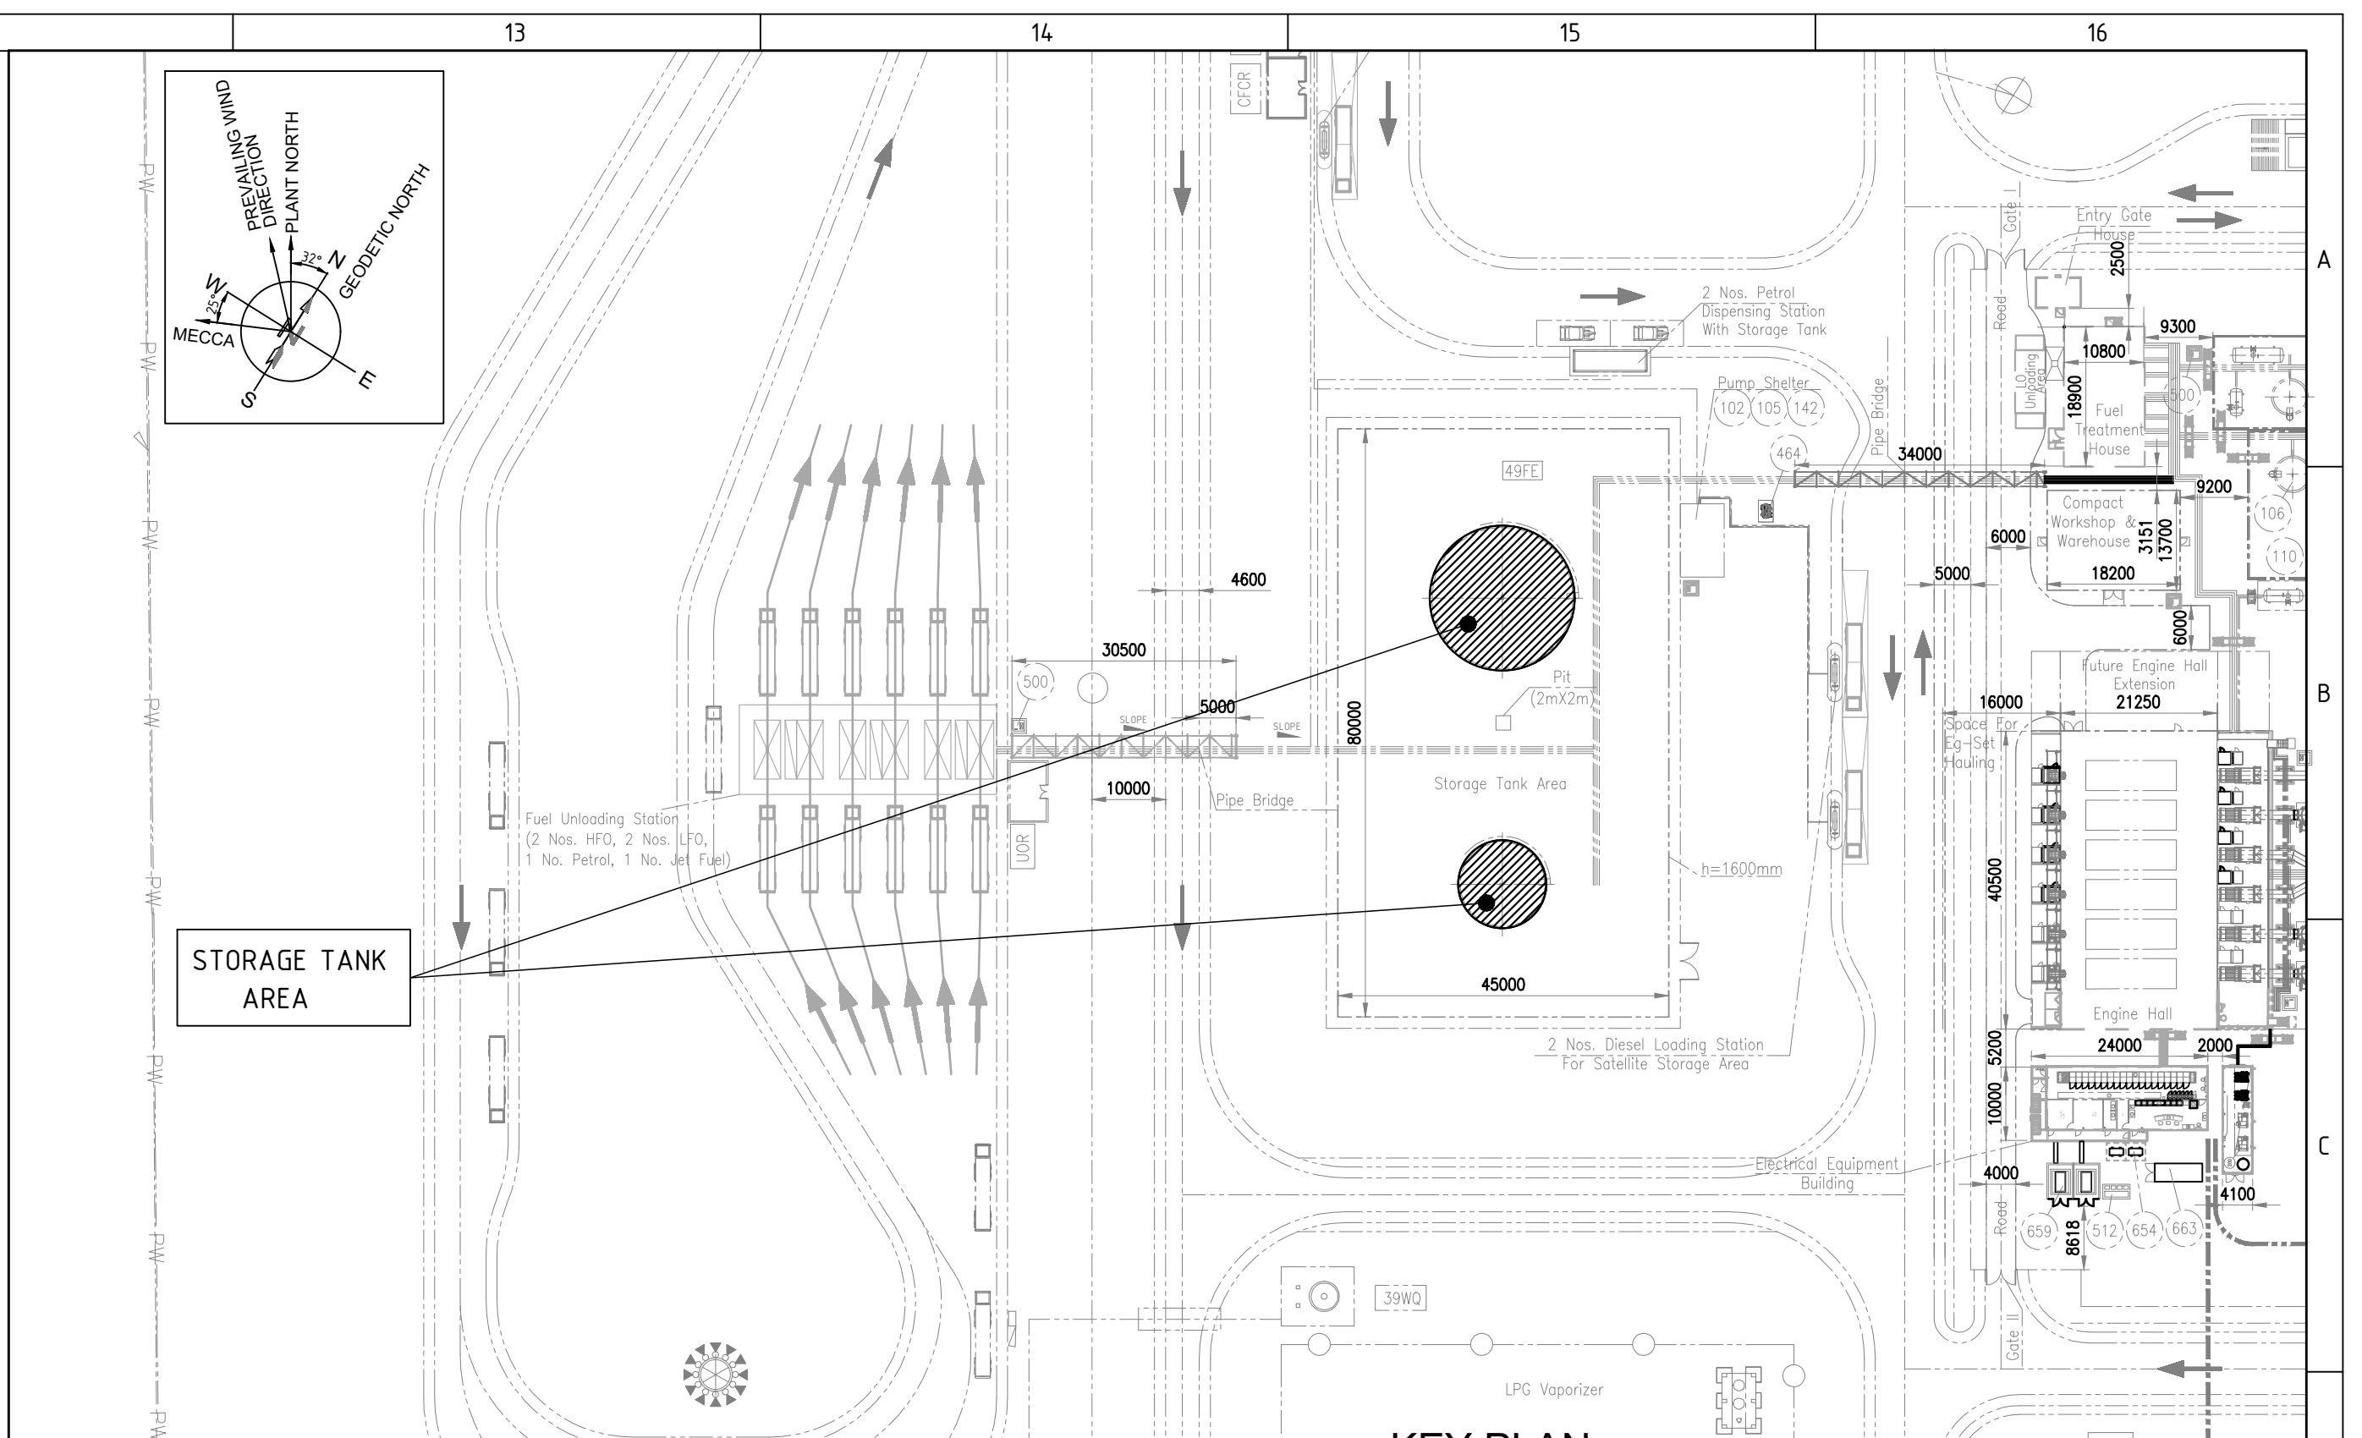

KEY PLAN
(SCALE 1:1000)

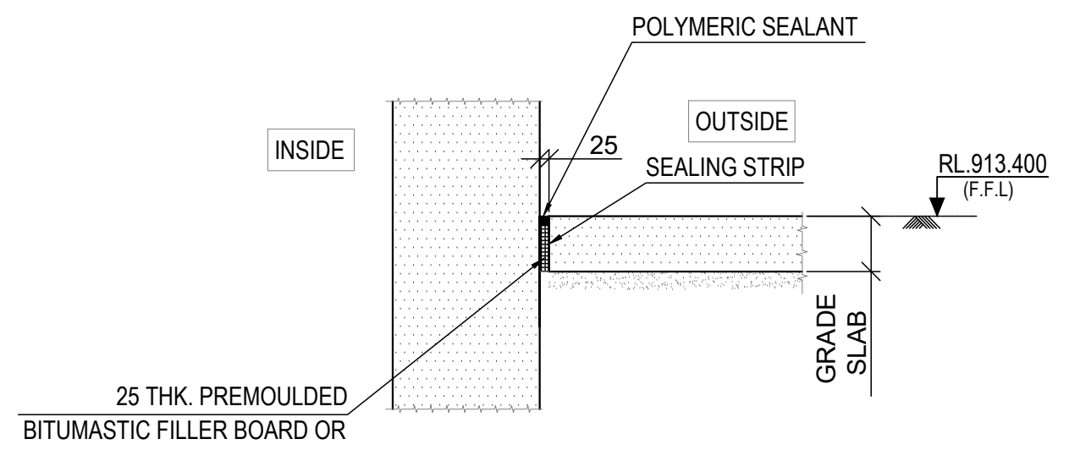

DETAIL - X
(SCALE 1:20)

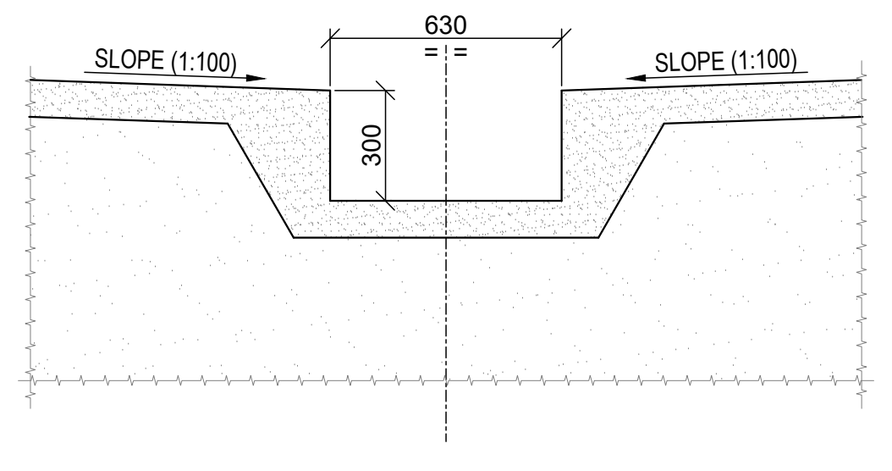

DETAIL - Y
(SCALE 1:20)

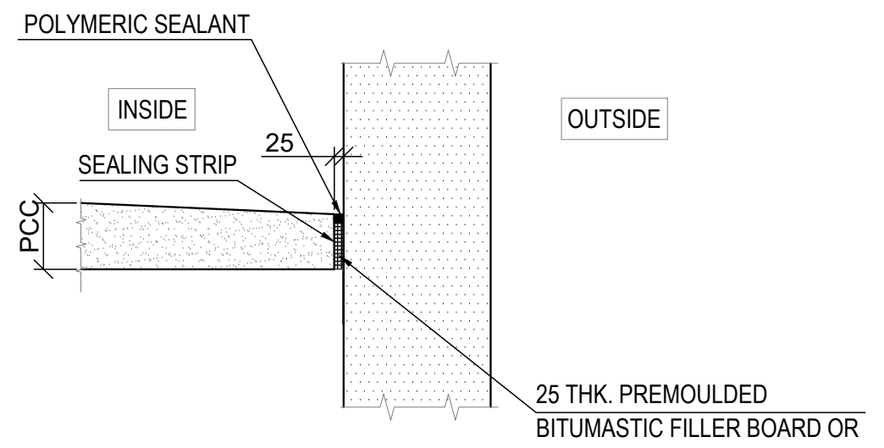

DETAIL - Z
(SCALE 1:20)

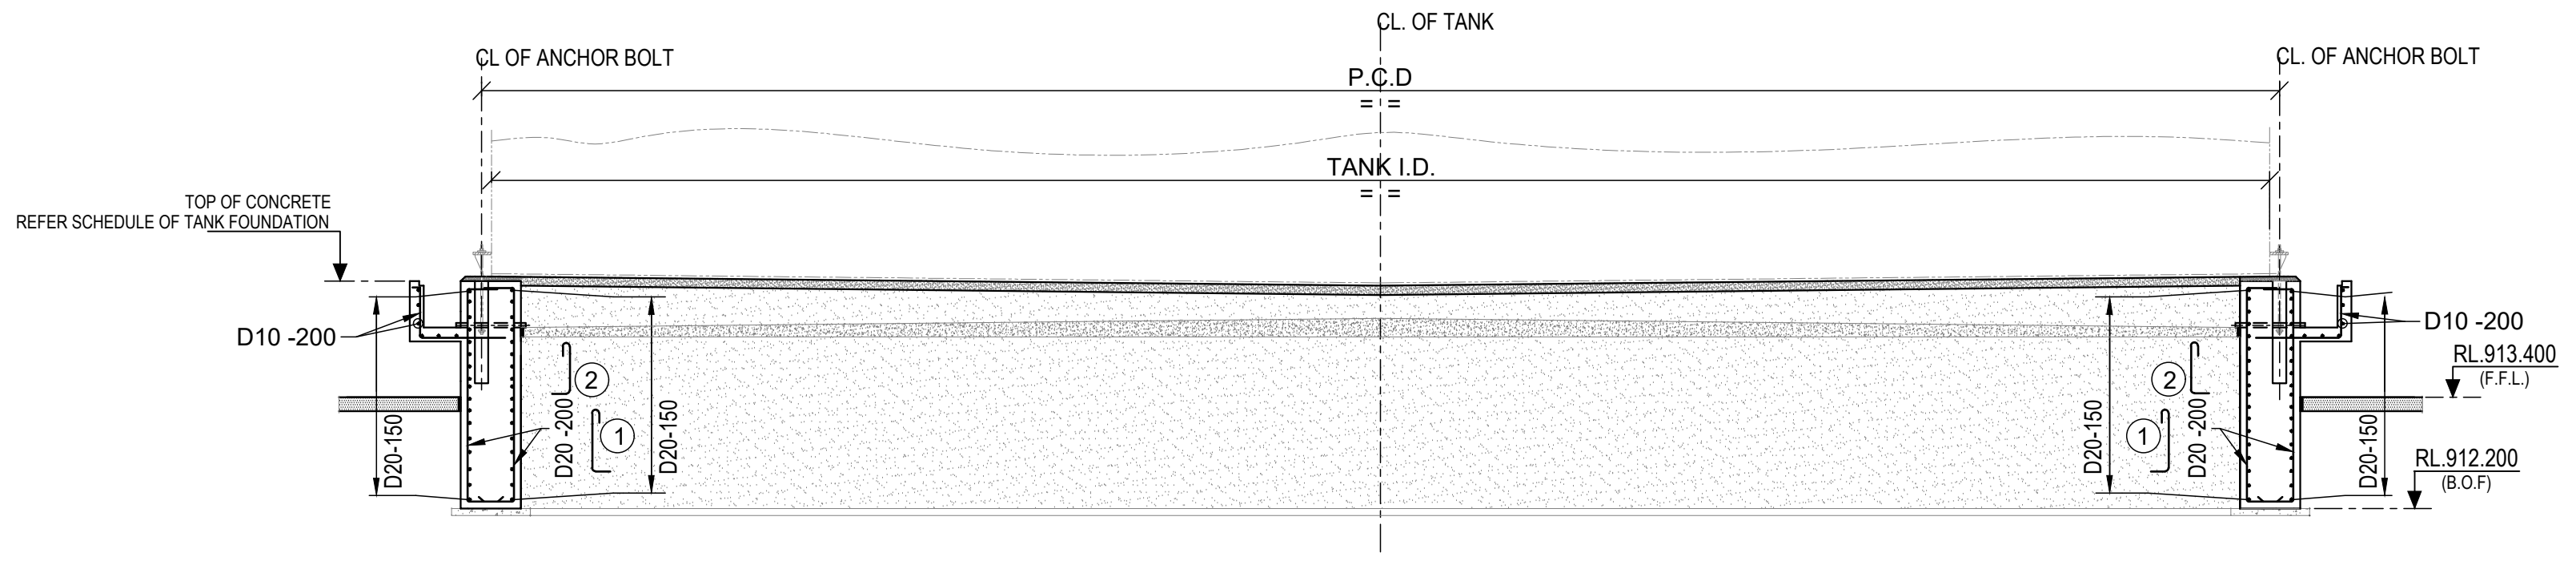

SECTION 2 - 2
(SCALE 1:75)

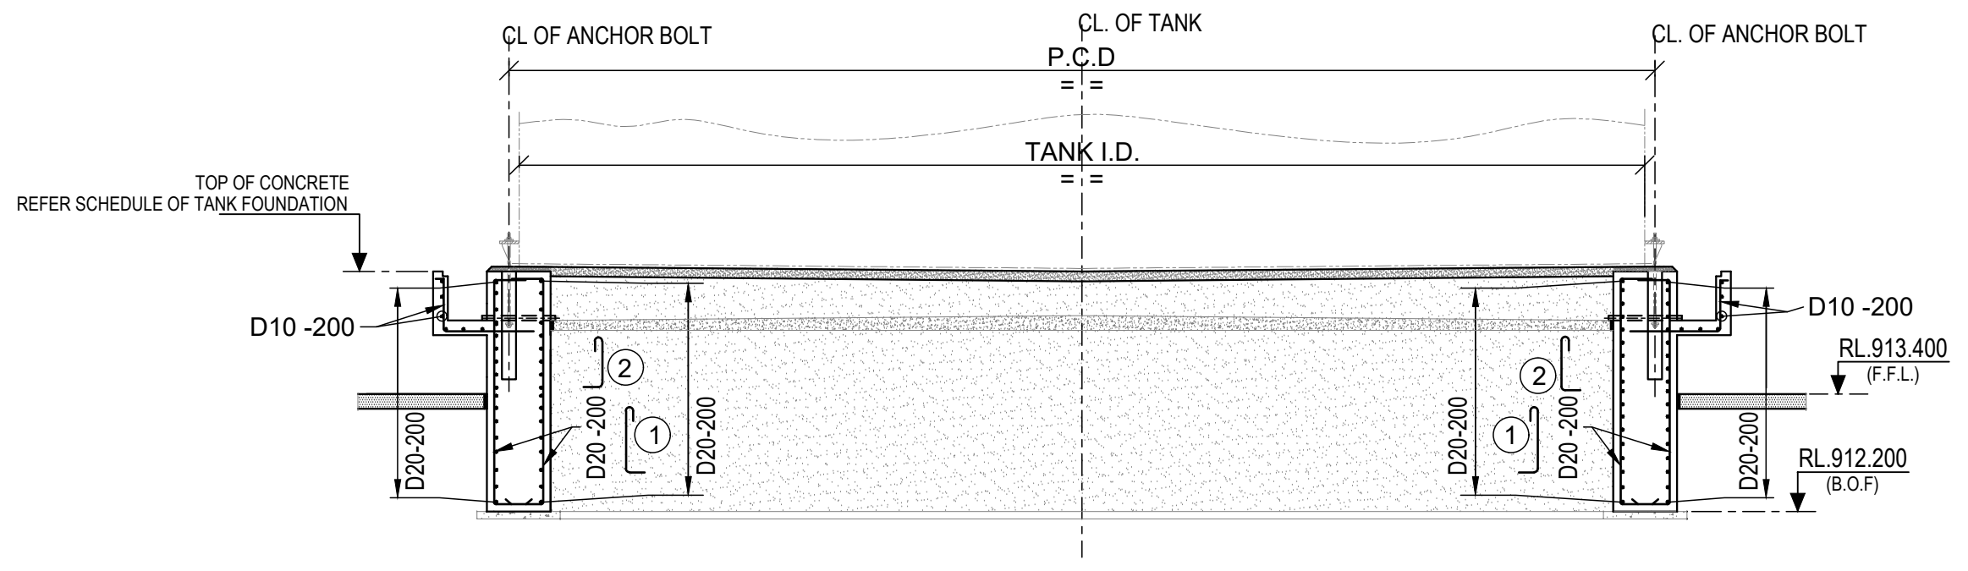

SECTION 1 - 1
(SCALE 1:75)

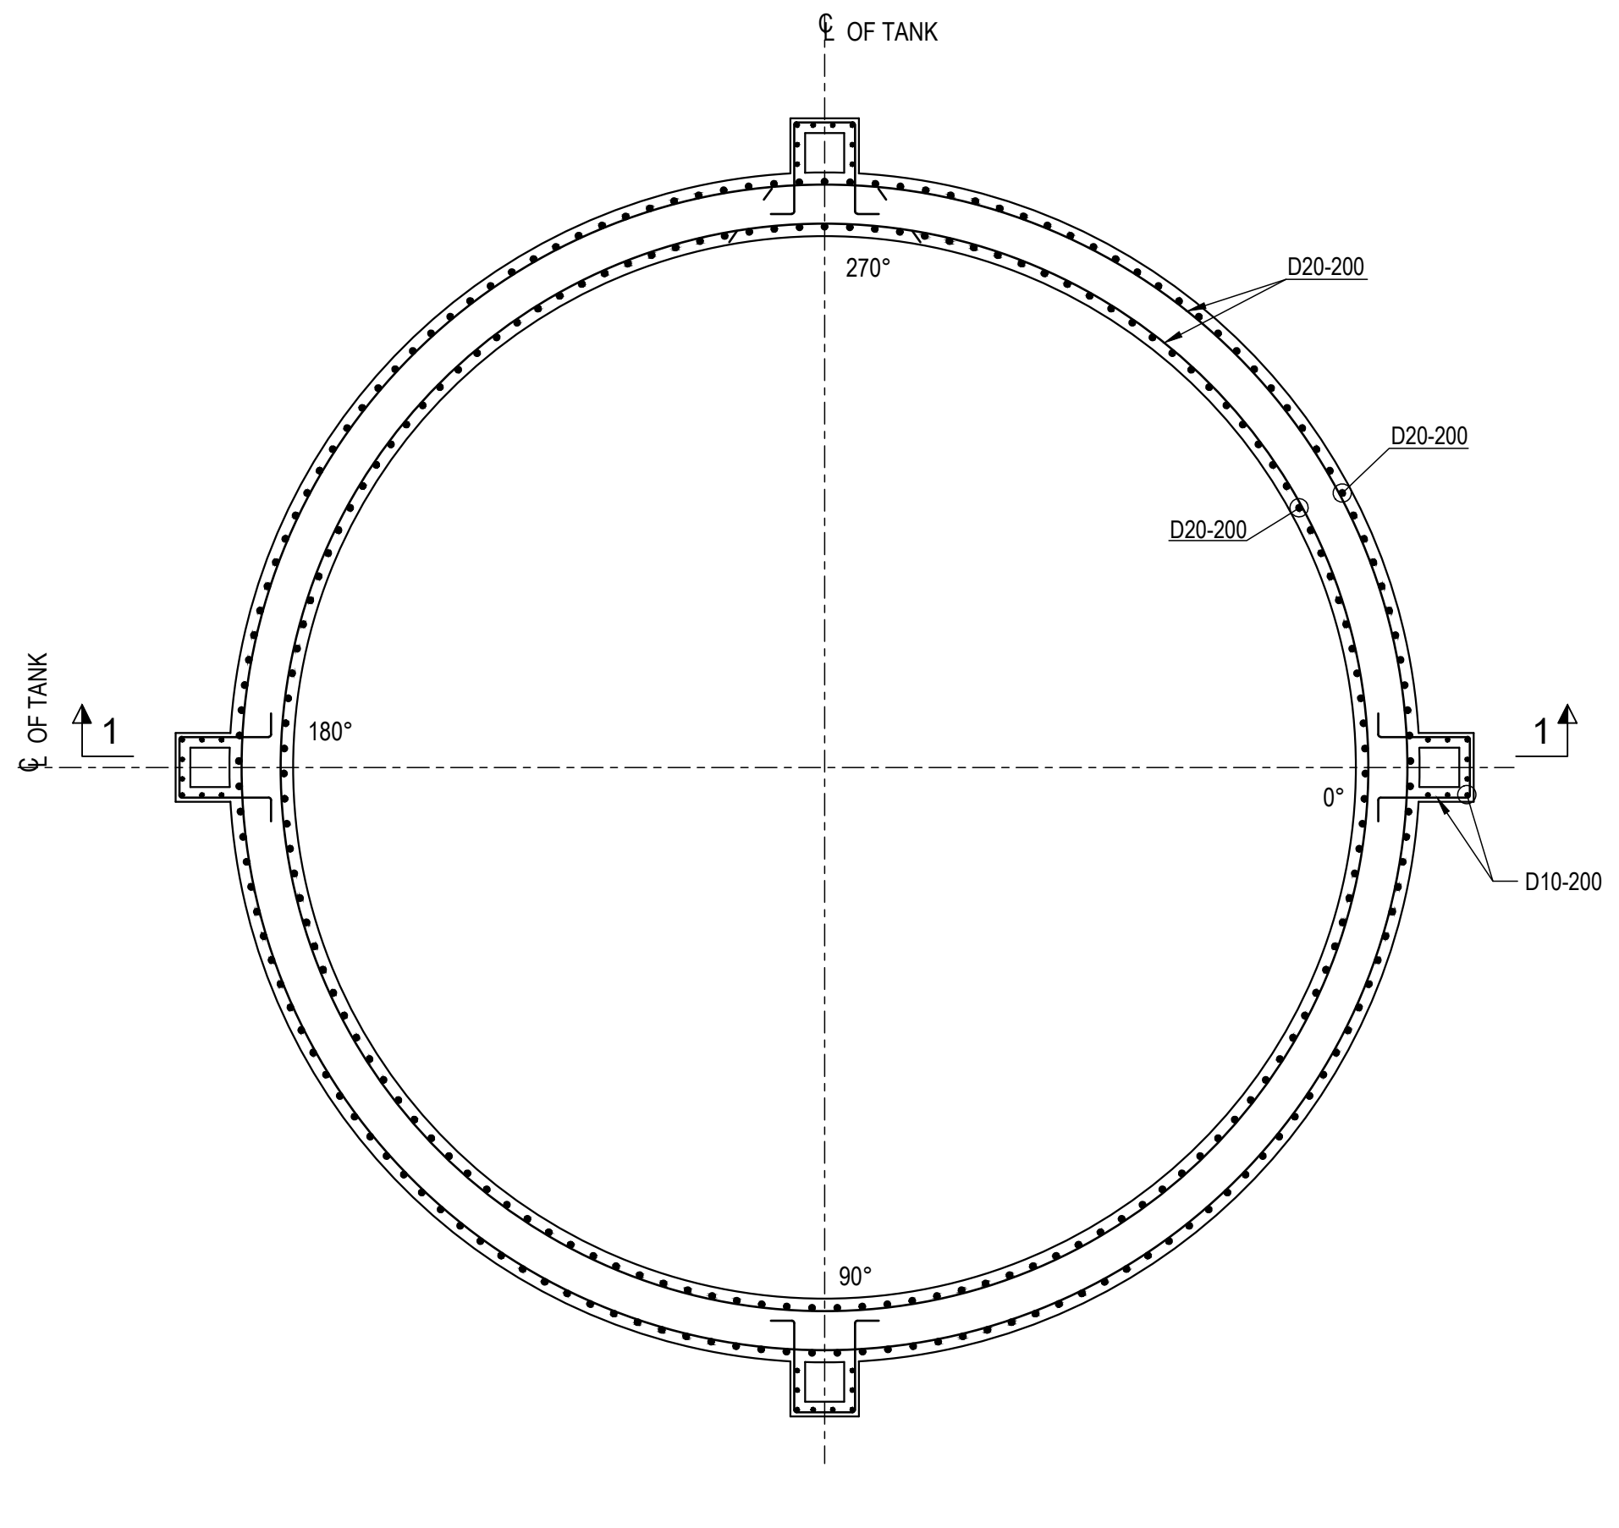

RC DETAIL OF LFO STORAGE TANK
(SCALE 1:75)

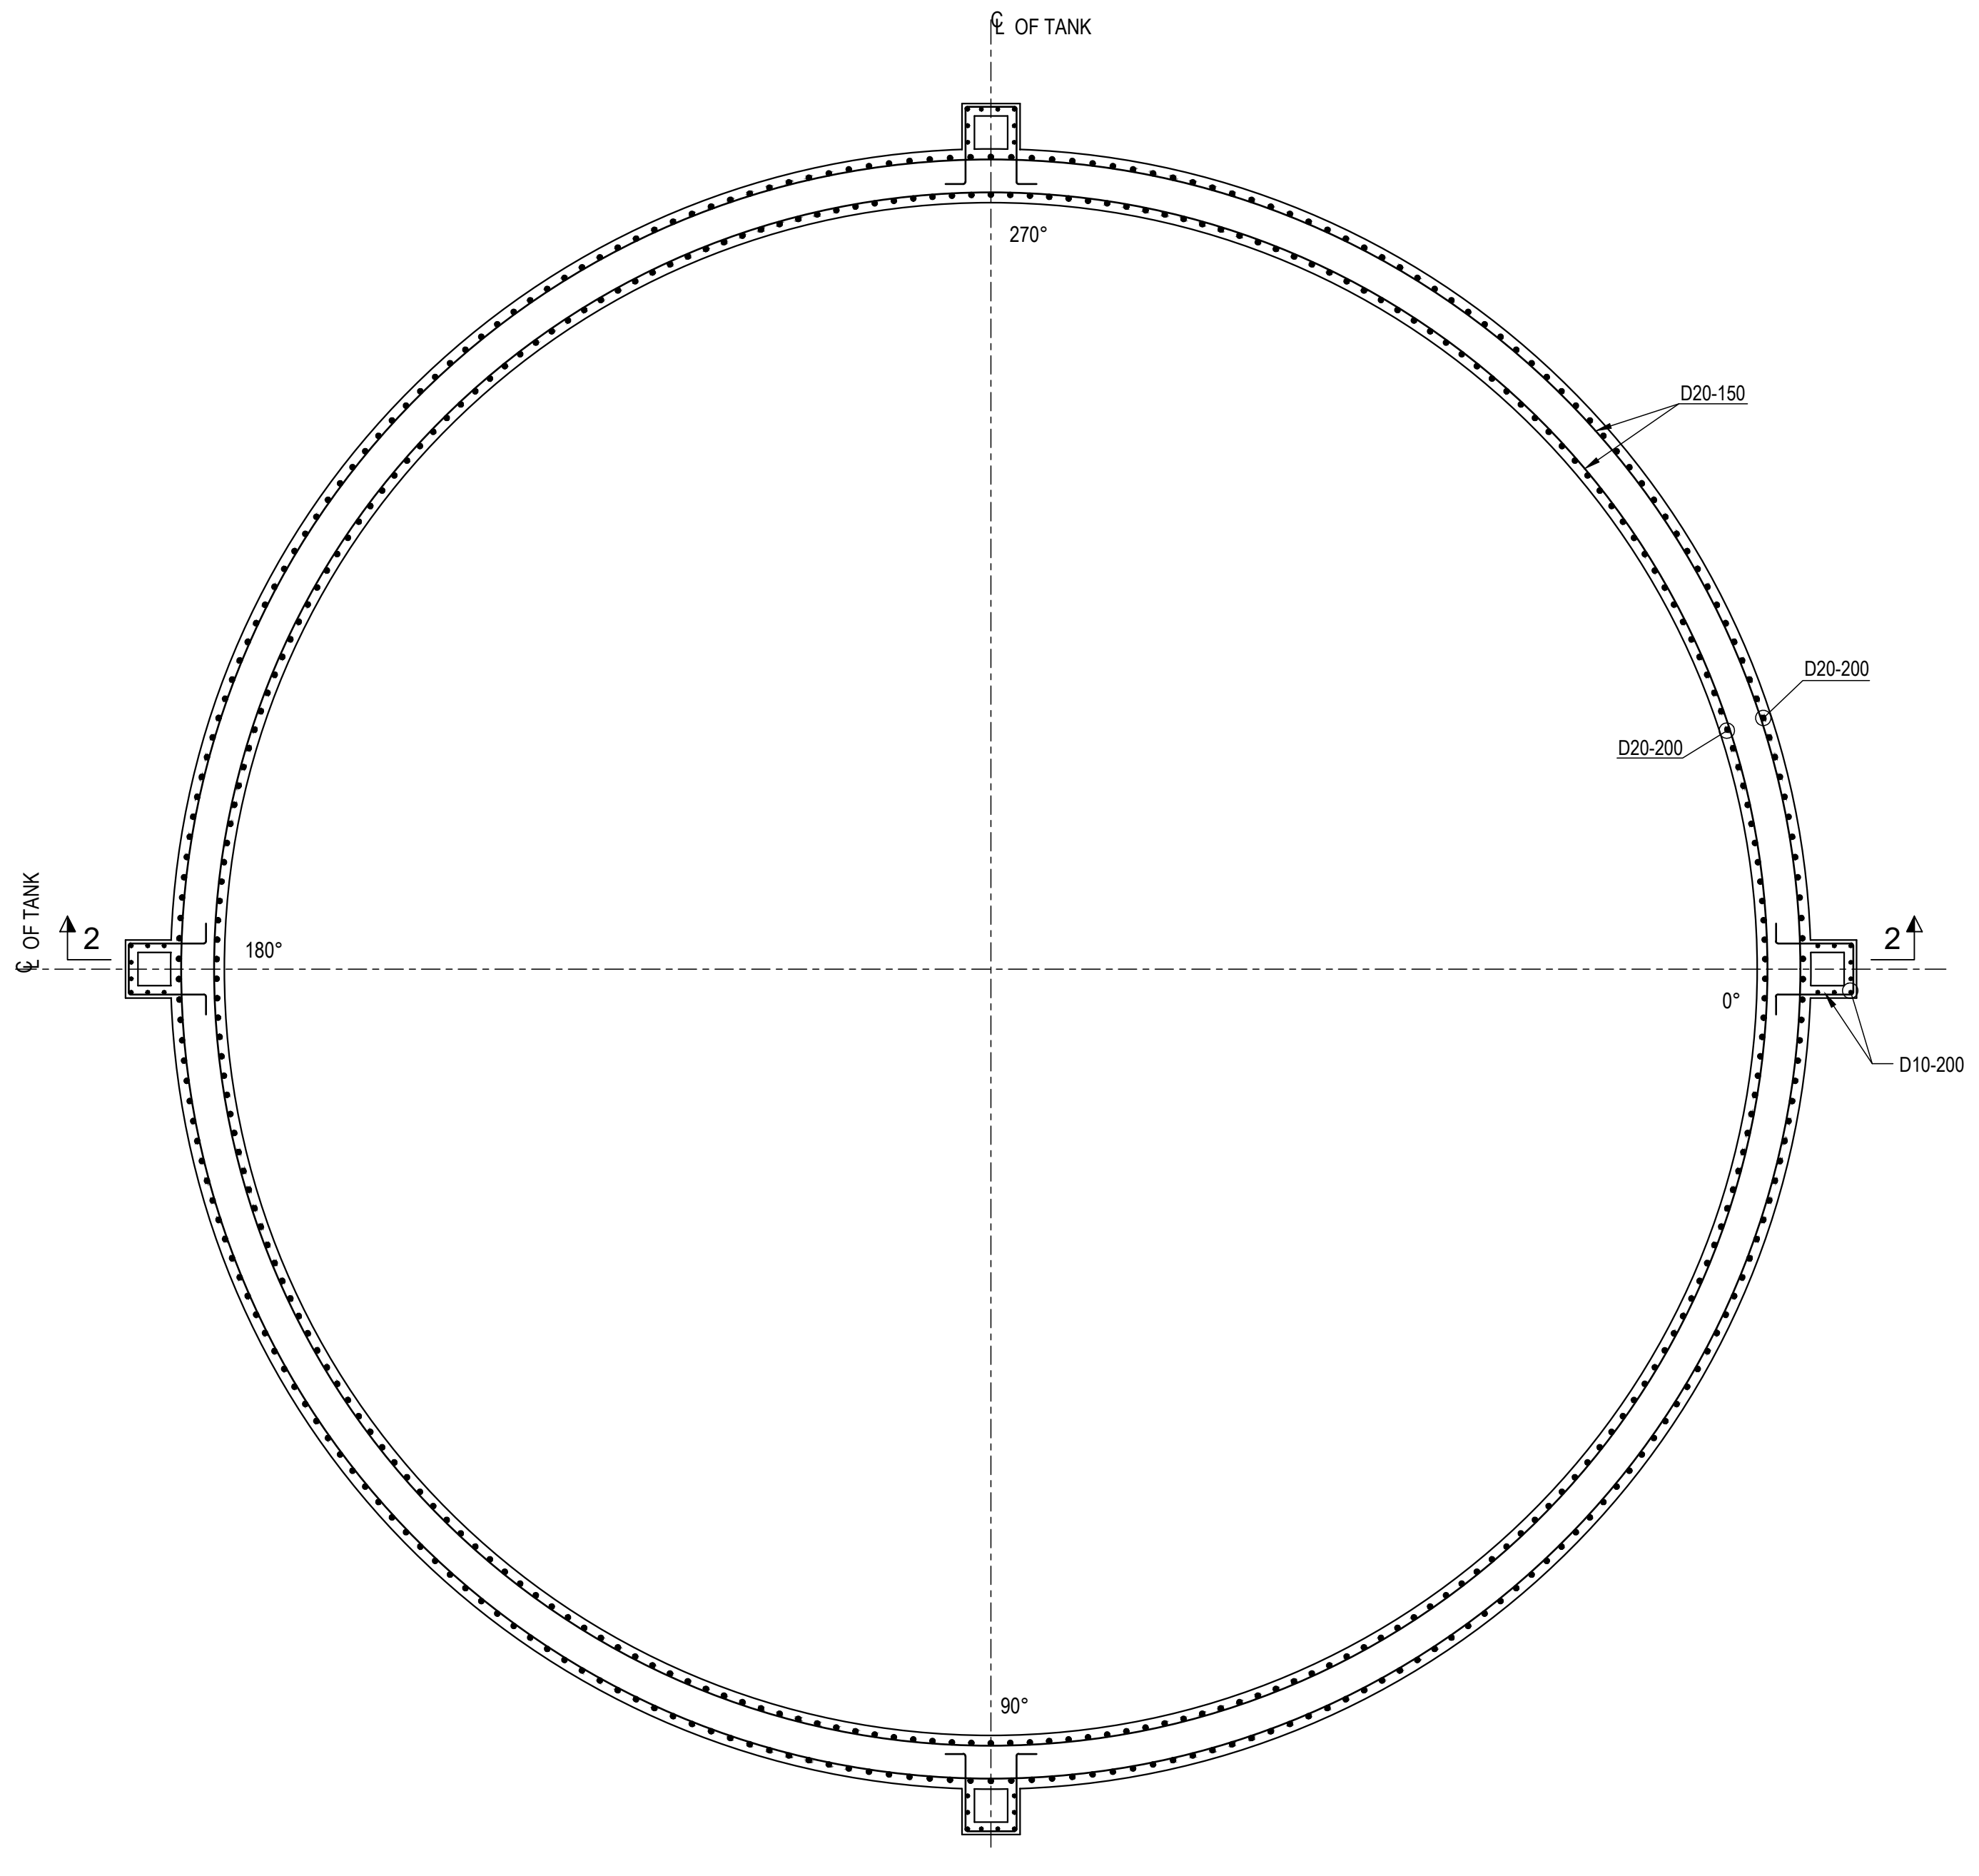

RC DETAIL OF HFO STORAGE TANK
(SCALE 1:75)

LEGEND :-

RL. - REDUCED LEVEL.
℄. - CENTRE LINE.
T.O.C. - TOP OF CONCRETE.
T.O.G. - TOP OF GROUT
F.G.L. - FINISHED GROUND LEVEL.
P.C.D. - PITCH CIRCLE DIAMETER.
TYP. - TYPICAL.
PCC. - PLAIN CEMENT CONCRETE.
MKD. - MARKED.
Ø - DIAMETER.
R - RADIUS.
I.D - INNER DIAMETER.
O.D - OUTER DIAMETER.
THK. - THICK.
DET. - DETAIL.
TNK. - TANK.
FDN. - FOUNDATION.
TOP REINFORCEMENT. - - - -
BOTTOM REINFORCEMENT. ———

NOTES :-

1. ALL DIMENSIONS ARE IN MILLIMETRES AND LEVELS AND CO-ORDINATES ARE IN METRES. UNLESS OTHERWISE STATED.
2. GRADE OF CONCRETE SHALL BE 35 MPa FOR FOUNDATION & 15 MPa FOR BLINDING CONCRETE.
3. GRADE OF REINFORCEMENT SHALL BE DEFORMED BAR 420 MPa (GRADE 60) - ASTM A615/A615M.
4. NET SAFE BEARING CAPACITY OF SOIL AT BOTTOM OF FOUNDATION CONSIDER 500KN/ SQ. M.
5. CLEAR COVER TO MAIN REINFORCEMENT SHALL BE FOUNDATIONS = 50 MM., WALLS = 50 MM., GRADE SLAB = 25 MM.
6. IF ANY PART OF FOUNDATION COMES ON BACKFILL ZONE OF ADJACENT FOUNDATION OR ANY LOOSE SOIL ARE ENCOUNTERED BELOW FOUNDATION LEVEL THE SAME SHALL BE REMOVED AND FILLED WITH PCC.
7. BOLTS TO BE SUPPLIED BY EQUIPMENT SUPPLIER.
8. ALL OTHER NOTES REFER DRAWING NO. MD-101-SMEM-EG-ST-DST-0001 TO 0008.
9. GENERAL NOTES FOR CIVIL WORKS & STANDARD REINFORCEMENT DETAIL REFER DRAWING NO. MD-216-1000-EG-CV-DED-1001 & 1005.
10. REBAR AT NOTCH LOCATION TO BE ADJUSTED SUIT AT SITE.

DOCUMENT NUMBER	REFERENCE DOCUMENTS	REV	DATE	REVISION DESCRIPTION	DRN	CHK	ENG	APP	EMP
		D01	17/02/2023	AS-BUILT	AMJ	SGC	SHD	PRI	
MD-216-49PR-EG-ME-LAD-V553-1002	LAYOUT OF POWER GENERATION	C03	07/01/2021	ISSUED FOR CONSTRUCTION AND REVISED AS MKD. C03	AMJ	SGC	SHD	PRI	
MD-216-1000-EG-ST-CRT-1001	CIVIL, STRUCTURAL & ARCHITECTURAL - DESIGN CRITERIA	C02	12/09/2020	ISSUED FOR CONSTRUCTION AND REVISED AS MKD. C02	AMJ	SGC	SHD	PRI	
MD-216-49PR-EG-ME-GAD-V553-1042	LFO STORAGE TANK	C01	24/08/2020	ISSUED FOR CONSTRUCTION C01	AMJ	SGC	SHD	PRI	
MD-216-49PR-EG-ME-GAD-V553-1041	HFO STORAGE TANK	A01	31/07/2020	ISSUED FOR REFERENCE	AMJ	SGC	SHD	PRI	

DOCUMENT NUMBER	REFERENCE DOCUMENTS	REV	DATE	REVISION DESCRIPTION	DRN	CHK	ENG	APP	EMP

RESERVED FOR VENDOR LOGO AND DRAWING NUMBER

LARSEN & TOUBRO

This drawing is the property of LARSEN & TOUBRO and must not be passed on to any person or body not authorized by us to receive it nor be copied or otherwise made use either in full or in part by such person or body without our prior permission in writing.

Outotec

The content of these documents are the sole property of Outotec Oyj. Any rights not expressly granted herein are reserved. Reproduction, transfer or distribution of part or all of the contents in any form without prior written permission of Outotec is prohibited.

MA'ADEN معادن
Saudi Arabian Mining Company شركة التعدين العربية السعودية

This document and the information contained herein is Ma'aden proprietary know-how. This document or any part thereof should not be reproduced, stored in a retrieval system or transmitted by any means, electronic or otherwise, or divulged without prior written permission of Ma'aden.

LARSEN & TOUBRO DRAWING NUMBER	019045_008_C_G_24292_004	REVISION 4
OUTOTEC DRAWING NUMBER	900707 __ GAU01 __ WG01_MTL01 __45080	DOCUMENT ID 0U100688138 / REVISION 4

DRAWN	AMJ	12/06/2020
CHECKED	SGC	13/06/2020
ENGINEER	SHD	10/06/2020
APPROVED	PRI	31/07/2020
EMPLOYER		
SCALE	1:100, 1:40, 1:20	A0

MANSOURAH - MASSARAH GOLD PROJECT
GENERAL ARRANGEMENT
POWER PLANT STORAGE TANK AREA
GA AND DETAIL OF TANK FOUNDATION

DRAWING NUMBER
MD - 216 - 49PR - EG - CV - GAD - 2008
REV
D01