


DRAWING NUMBER: MD-216-3410-EG-CV-DED-1241
REV: D01

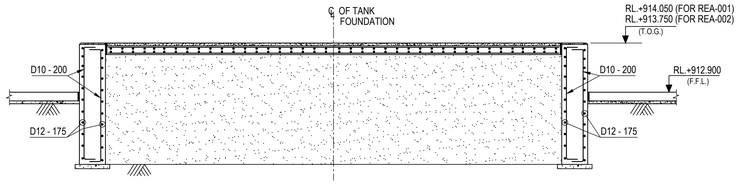


SECTION : A-A
SCALE 1:50

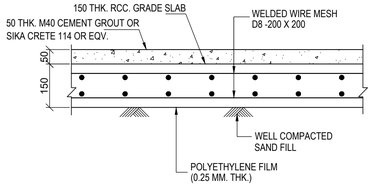


TYP. DET. OF 150 THK. GRADE SLAB
SCALE 1:10

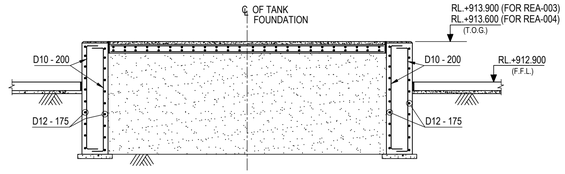


SECTION : B-B
SCALE 1:50

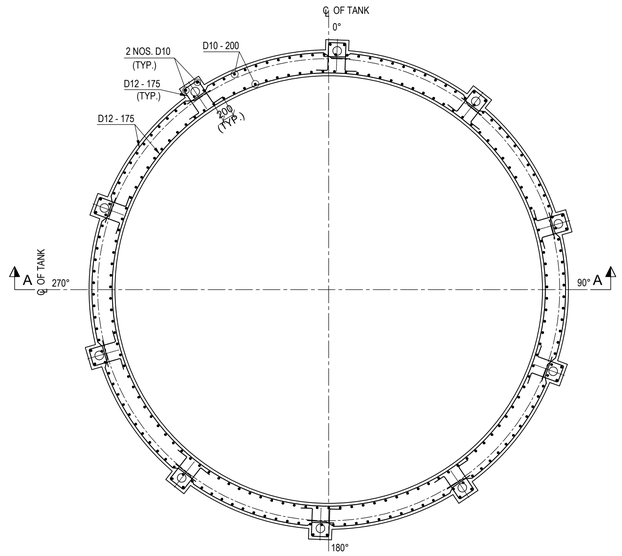

TYP. RCC. DET. OF TANK FOUNDATION AT TOP
(TANK MKD. 3410-REA-001 & 3410-REA-002)
SCALE 1:50

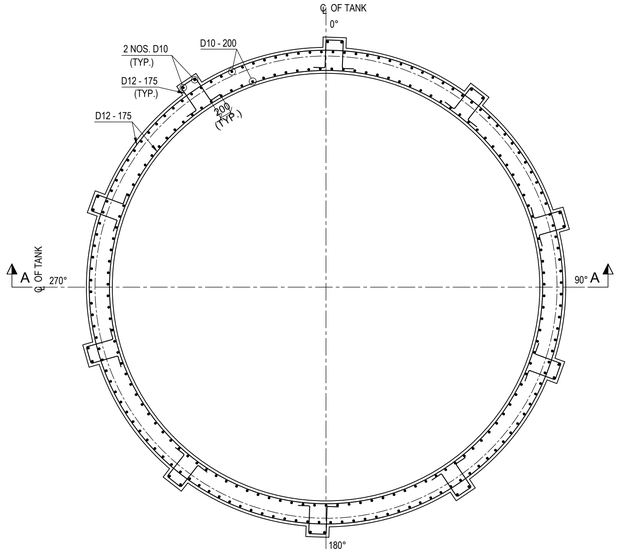

TYP. RCC. DET. OF TANK FOUNDATION AT BOTTOM
(TANK MKD. 3410-REA-001 & 3410-REA-002)
SCALE 1:50

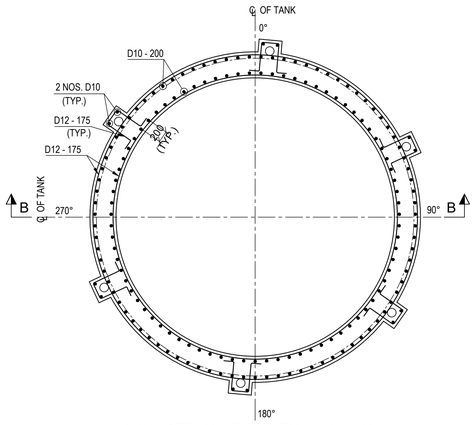

RCC. DET. OF TANK FOUNDATION
(TANK MKD. 3410-REA-003 & 3410-REA-004)
SCALE 1:50

LEGEND :-

R.L. - REDUCED LEVEL
℄ - CENTRE LINE
T.O.C. - TOP OF CONCRETE
F.G.L. - FINISHED GROUND LEVEL
B.O.F. - BOTTOM OF FOUNDATION
TYP. - TYPICAL
P.C.D. - PITCH CIRCLE DIAMETER
R.C.C - REINFORCED CEMENT CONCRETE
P.C.C - PLAIN CEMENT CONCRETE
MKD. - MARKED
THK. - THICK
EQV. - EQUIVALENT
T.O.G. - TOP OF GROUT

NOTES :-

1. ALL DIMENSIONS ARE IN MILLIMETRES AND LEVELS AND CO-ORDINATES ARE IN METRES. UNLESS OTHERWISE STATED.
2. GRADE OF CONCRETE SHALL BE C35 FOR FOUNDATION.
3. GRADE OF REINFORCEMENT SHALL BE DEFORMED BAR ASTM A615 - GRADE 60 (fy = 420 MPa).
4. NET SAFE BEARING CAPACITY OF SOIL AT BOTTOM OF FOUNDATION CONSIDERED 350KN/SQ. M.
5. CLEAR COVER TO MAIN REINFORCEMENT SHALL BE AS
   a) FOUNDATION = 75 mm (BOTTOM & SIDE) 50 mm. (TOP)
   b) RING WALL = 50mm
6. MINIMUM LAP LENGTH OF REINFORCEMENT SHALL BE 40 x DIA. OF BAR. AS PER DRAWING NO. MD-216-1000-EG-CV-DED-1001.
7. THIS DRG. SHALL BE READ IN CONJUNCTION WITH DRG. NO. MD-216-3410-EG-CV-GAD-1240.
8. GRADE OF WELDED WIRE MESH SHALL BE GRADE 60 (fy = 420 MPa) ACCORDING TO A1064.
9. FOR STANDARD REINFORCEMENT DETAIL & GENERAL NOTES FOR CIVIL WORKS REFER DRAWING NO. MD-216-1000-EG-CV-DED-1005 & 1001.

DOCUMENT NUMBER	REFERENCE DOCUMENTS	REV	DATE	REVISION DESCRIPTION	DRN	CHK	ENG	APP	EMP
MD-216-1000-EG-ST-CRT-1001	CIVIL, STRUCTURAL & ARCHITECTURAL - DESIGN CRITERIA								
MD-216-3410-EG-ME-PLN-1004	3410-REA-004 POX RECYCLE TANK								
MD-216-3410-EG-ME-PLN-1003	3410-REA-003 POX RECYCLE TANK	D01	15/03/2023	AS-BUILT	ABS	SJM	SOR	AG	
MD-216-3410-EG-ME-PLN-1002	3410-REA-002 POX FEED TANK	C01	29/04/2020	ISSUED FOR CONSTRUCTION AND REVISED AS PER EMPLOYER	ABS	SJM	SOR	AG	
MD-216-3410-EG-ME-PLN-1001	3410-REA-001 POX FEED TANK			COMMENTS ON 24/04/2020 & REVISED AS MKD. (C01)					
MD-216-3410-EG-CV-GAD-1001	PRESSURE OXIDATION - AUTOCLAVE FEED STORAGE	A01	13/03/2020	ISSUED FOR REFERENCE	ABS	SJM	SOR	AG	

RESERVED FOR VENDOR LOGO AND DRAWING NUMBER

LARSEN & TOUBRO

This drawing is the property of LARSEN & TOUBRO and must not be passed on to any person or body not authorized by us to receive it nor be copied or otherwise made use either in full or in part by such person or body without our prior permission in writing.

Outotec

The content of these documents are the sole property of Outotec Oyj. Any rights not expressly granted herein are reserved. Reproduction, transfer or distribution of part or all of the contents in any form without prior written permission of Outotec is prohibited.

MA'ADEN معادن
Saudi Arabian Mining Company شركة التعدين العربية السعودية

This document and the information contained herein is Ma'aden proprietary know-how. This document or any part thereof should not be reproduced, stored in a retrieval system or transmitted by any means, electronic or otherwise, or divulged without prior written permission of Ma'aden.

LARSEN & TOUBRO DRAWING NUMBER: 019045_450_C_D_24105_001
REVISION: 2
OUTOTEC DRAWING NUMBER: 900707__GAU01__HH12__CTB17__34101
DOCUMENT ID: OU100675110
REVISION: 2

DRAWN	ABS	15/02/2020	
CHECKED	SJM	20/02/2020	
ENGINEER	SOR	15/02/2020	
APPROVED	AG	13/03/2020	
EMPLOYER			
SCALE	1:50, 1:10	A1	

MANSOURAH - MASSARAH GOLD PROJECT
DETAIL DRAWING
PRESSURE OXIDATION - AUTOCL. FEED STORAGE
RC. DETAIL OF TANK FOUNDATIONS

DRAWING NUMBER: MD-216-3410-EG-CV-DED-1241
REV: D01