

DRAWING NUMBER MD-216-3410-EG-CV-DED-1243 REV D01

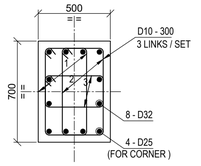


RCC. DET. OF P1 / P2

SCALE 1:20

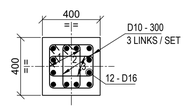

RCC. DET. OF P3


SCALE 1:20

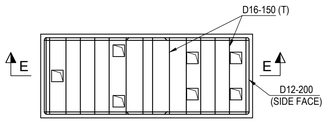

RCC DET. OF FDN. FOR PUMP MKD.

3450-PMP-001,002

(TOP VIEW OF FIRST STAGE CONCRETE)

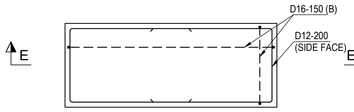


RCC DET. OF FDN. FOR PUMP MKD.

3450-PMP-001,002


(BOTTOM VIEW)

SCALE 1:40

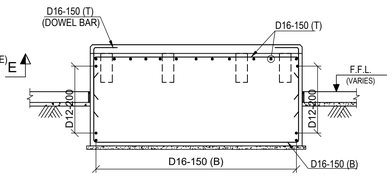

SECTION : E-E


SCALE 1:40

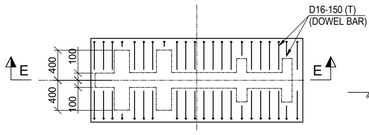

RCC DET. OF FDN. FOR PUMP MKD.


3450-PMP-001,002

(TOP VIEW OF SECOND STAGE CONCRETE)

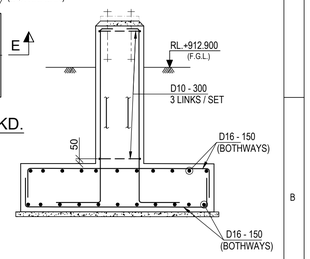


SECTION : C-C

SCALE 1:30

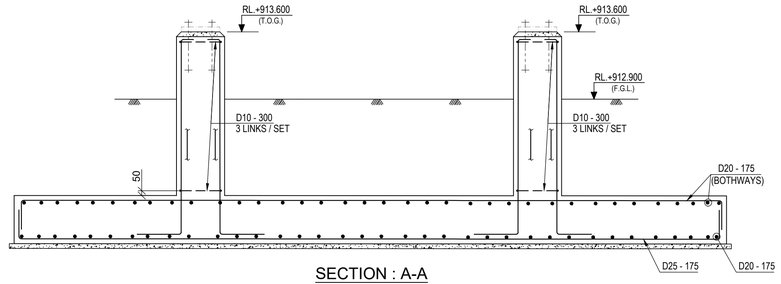


SECTION : A-A

SCALE 1:30

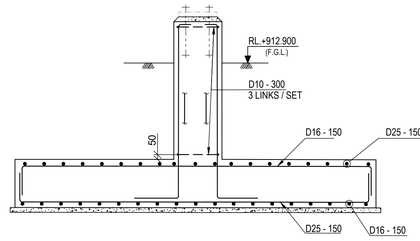


SECTION : B-B

SCALE 1:30

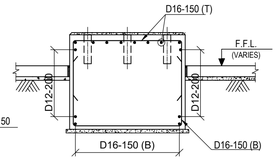

SECTION : F-F

SCALE 1:40

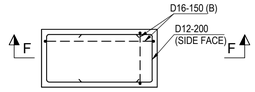


RCC DET. OF FDN. FOR PUMP MKD.

3450-PMP-005 & 006

(BOTTOM VIEW)


SCALE 1:40

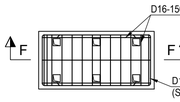

RCC DET. OF FDN. FOR PUMP MKD.

3450-PMP-005,006


(TOP VIEW)

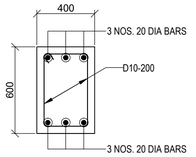

SECTION D1-D1

(R.C DETAILS)


SCALE 1:20

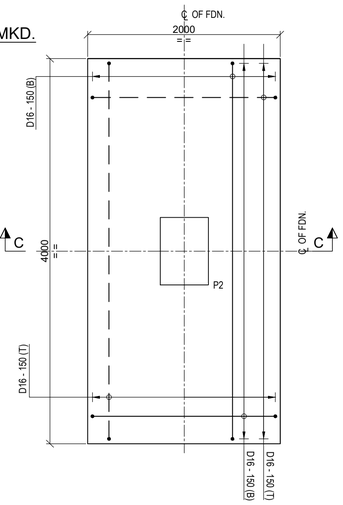

RCC. DET. OF FOUNDATION

MKD. F3


SCALE 1:30

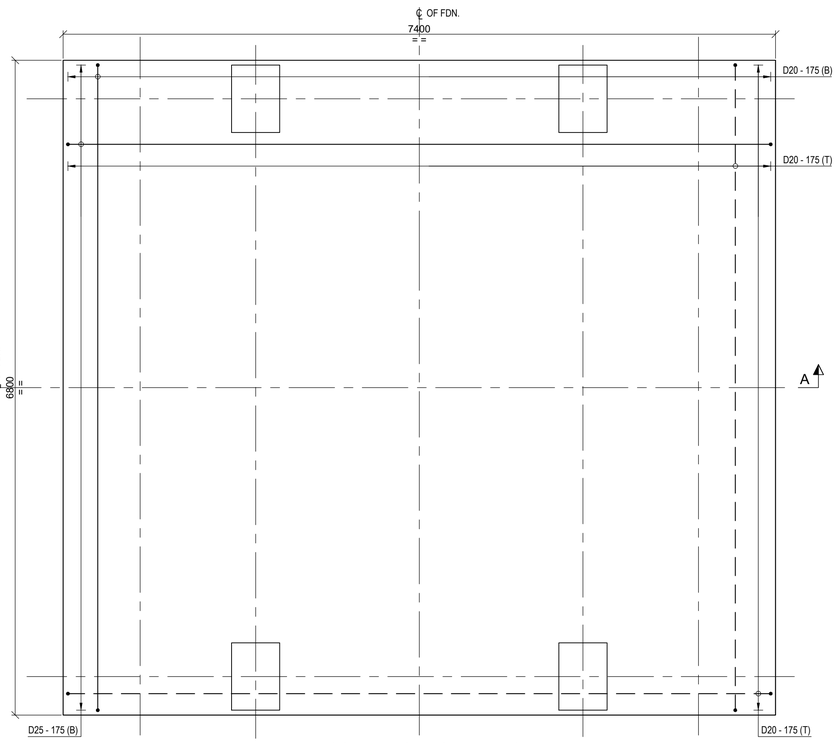

RCC. DET. OF FOUNDATION

MKD. F1


SCALE 1:30

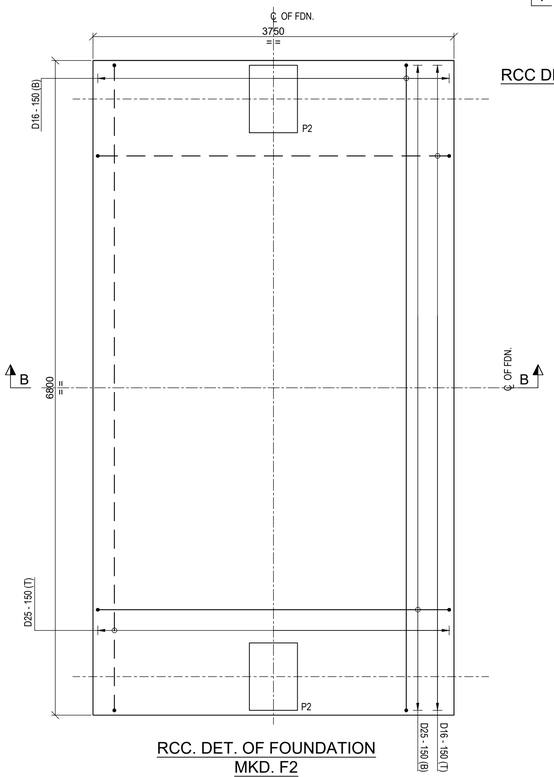

RCC. DET. OF FOUNDATION


MKD. F2

SCALE 1:30

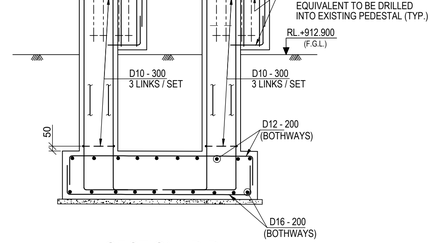

SECTION : D-D

SCALE 1:30

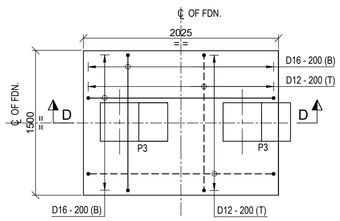

RCC. DET. OF FOUNDATION

MKD. F4

SCALE 1:30

LEGEND :-

R.L. - REDUCED LEVEL
T.O.C. - TOP OF CONCRETE.
F.G.L. - FINISHED GROUND LEVEL.
B.O.F. - BOTTOM OF FOUNDATION
TYP. - TYPICAL
P.C.D. - PITCH CIRCLE DIAMETER.
P.C.C - PLAIN CEMENT CONCRETE
BOTTOM REINF.(B) - ————
TOP REINF.(T) - – – – – –
MKD. - MARKED.
TOG - TOP OF GROUT
DIA - DIAMETER
FDN. - FOUNDATION
DRG. - DRAWING
℄ - CENTRE LINE
RCC - REINFORCED CEMENT CONCRETE
DET - DETAIL
REINF - REINFORCEMENT

NOTES :-

1. ALL DIMENSIONS ARE IN MILLIMETRES AND LEVELS AND CO-ORDINATES ARE IN METRES. UNLESS OTHERWISE STATED.
2. GRADE OF CONCRETE SHALL BE C35 FOR FOUNDATION.
3. GRADE OF REINFORCEMENT SHALL BE DEFORMED BAR ASTM A615 - GRADE 60 (fy = 420 MPa).
4. NET SAFE BEARING CAPACITY OF SOIL AT BOTTOM OF FOUNDATION CONSIDERED 400KN/SQ. M.
5. CLEAR COVER TO MAIN REINFORCEMENT SHALL BE AS
   a) FOUNDATION = 75 mm (BOTTOM & SIDE) 50 mm. (TOP)
   b) COLUMN = 50mm
6. MINIMUM LAP LENGTH OF REINFORCEMENT SHALL BE 40 x DIA. OF BAR.
7. THIS DRG. SHALL BE READ IN CONJUNCTION WITH DRG. NO. MD-216-3380-EG-CV-GAD--1005.

DOCUMENT NUMBER	REFERENCE DOCUMENTS	REV	DATE	REVISION DESCRIPTION	DRN	CHK	ENG	APP	EMP
		D01	15/03/2023	AS-BUILT	SYA	SJM	SOR	AG	
		C02	05/01/2022	ISSUED FOR CONSTRUCTION & REVISED AS MARKED C02	SYA	SJM	SOR	AG	
MD-216-3420-EG-ME-GAD-1011	FEED STORAGE - PLAN AT EL. +912.900	C01	07/12/2020	ISSUED FOR CONSTRUCTION & REVISED AS MARKED C01	AUD	SJM	SOR	AG	
MD-216-3410-EG-ST-GAD-2227	FEED STORAGE - PLAN, ELEVATIONS & DETAILS	A01	16/10/2020	ISSUED FOR REFERENCE	AUD	SJM	SOR	AG	

RESERVED FOR VENDOR LOGO AND DRAWING NUMBER

LARSEN & TOUBRO

This drawing is the property of LARSEN & TOUBRO and must not be passed on to any person or body not authorized by us to receive it nor be copied or otherwise made use either in full or in part by such person or body without our prior permission in writing.

Outotec

The content of these documents are the sole property of Outotec Oyj. Any rights not expressly granted herein are reserved. Reproduction, transfer or distribution of part or all of the contents in any form without prior written permission of Outotec is prohibited.

MA'ADEN معادن
Saudi Arabian Mining Company شركة التعدين العربية السعودية

This document and the information contained herein is Ma'aden proprietary know-how. This document or any part thereof should not be reproduced, stored in a retrieval system or transmitted by any means, electronic or otherwise, or divulged without prior written permission of Ma'aden.

DRAWN	AUD	10/10/2020
CHECKED	SJM	14/10/2020
ENGINEER	SOR	10/10/2020
APPROVED	AG	16/10/2020
EMPLOYER		
SCALE 1:50, 1:30, 1:25, 1:20		A1

LARSEN & TOUBRO DRAWING NUMBER: 019045_450_C_D_24431_001 — REVISION: 3

OUTOTEC DRAWING NUMBER: 900707__GAU01__HH12__CTB17__34103 — DOCUMENT ID: OU100704923 — REVISION: 3

MANSOURAH - MASSARAH GOLD PROJECT
DETAIL DRAWING
PRESSURE OXIDATION - AUTOCL. FEED STORAGE
RCC DETAILS OF BUILDING FOUNDATION

DRAWING NUMBER: MD-216-3410-EG-CV-DED-1243 — REV: D01