


DRAWING NUMBER: MD-216-3410-EG-CV-GAD-1240 REV D01

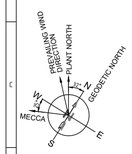


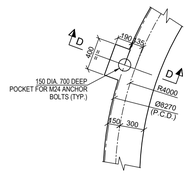


DETAIL : 'Z'
SCALE 1:25

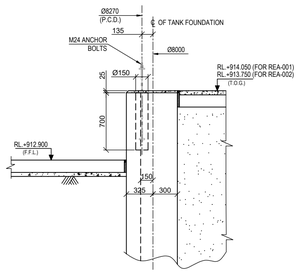


SECTION : D-D
SCALE 1:25

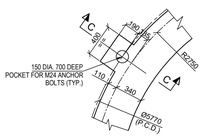


DETAIL : 'Y'
SCALE 1:25

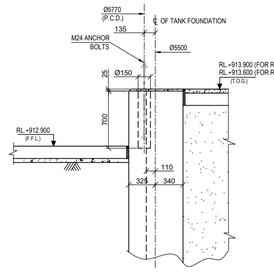


SECTION : C-C
SCALE 1:25

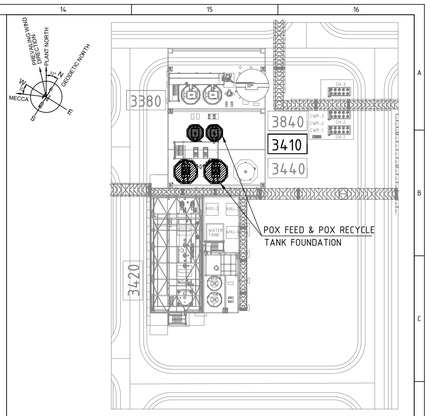


KEY PLAN
(SCALE- 1:750)

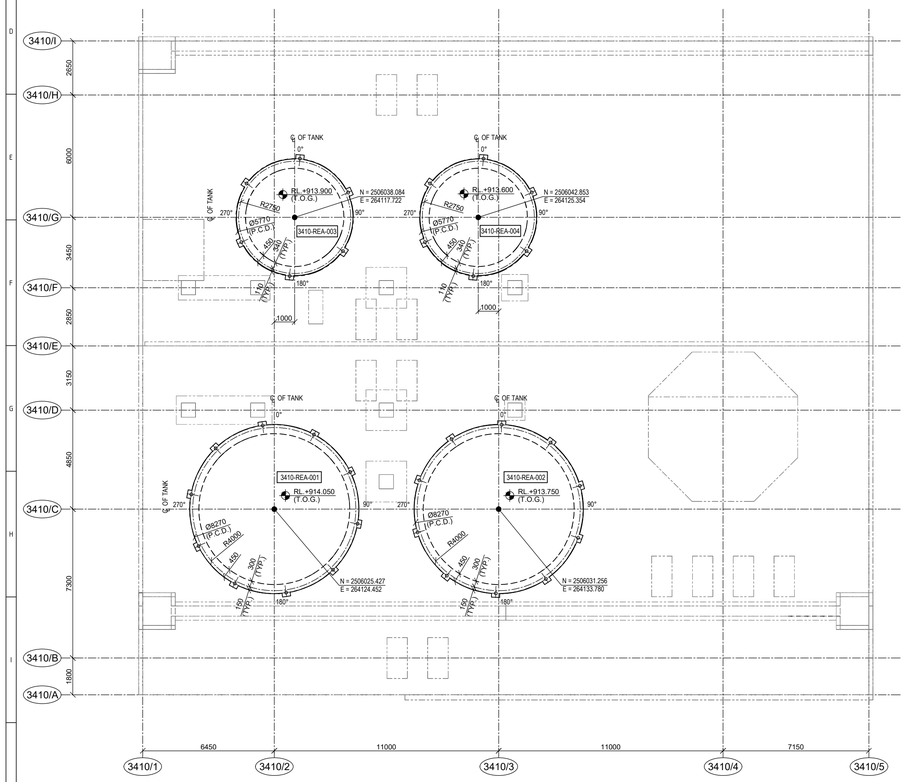


LAYOUT OF FOUNDATION
FOR POX FEED TANK & POX RECYCLE TANK
(TANK MKD. 3410-REA-001, 002, 003 & 004)
(SCALE - 1:100)

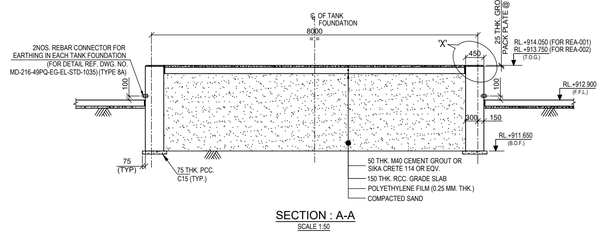


SECTION : A-A
SCALE 1:50

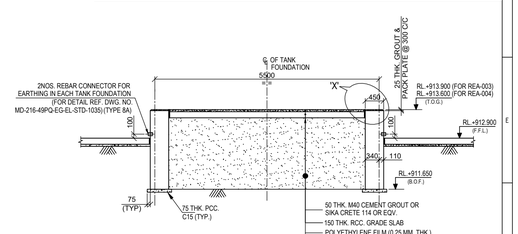


SECTION : B-B
SCALE 1:50

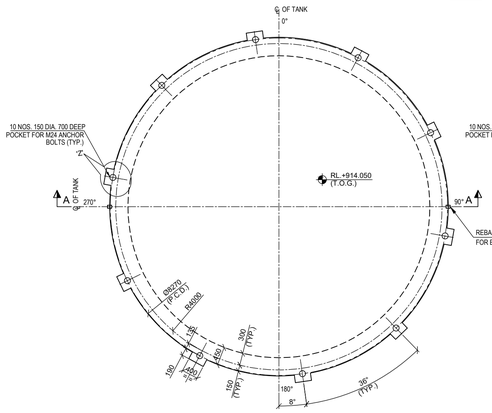


DETAIL OF TANK FOUNDATION MKD. 3410-REA-001
SCALE 1:50

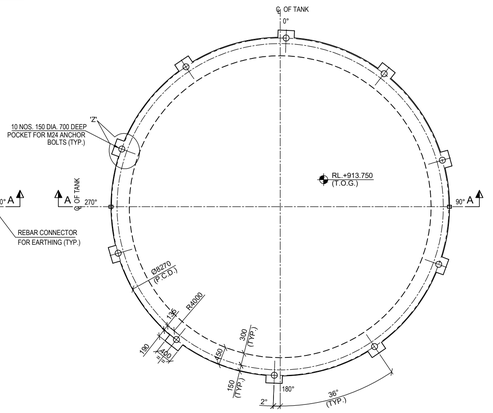


DETAIL OF TANK FOUNDATION MKD. 3410-REA-002
SCALE 1:50

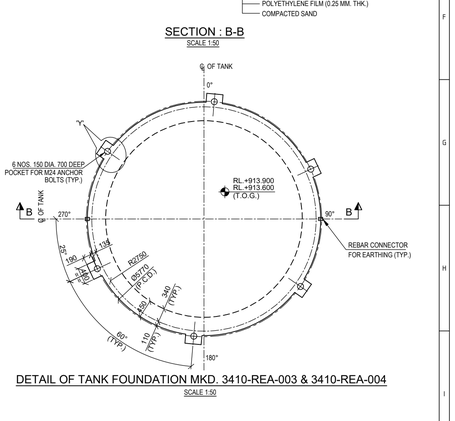

DETAIL OF TANK FOUNDATION MKD. 3410-REA-003 & 3410-REA-004
SCALE 1:50

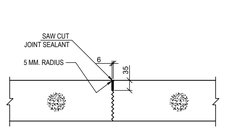

TYP. DETAIL OF CONSTRUCTION JOINT
SCALE 1:10

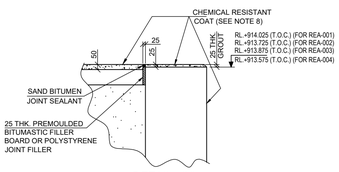

DETAIL - 'X'
SCALE 1:20

LEGEND :-

AUTOCL. - AUTOCLAVE
R.L - REDUCED LEVEL
℄ - CENTRE LINE
T.O.C. - TOP OF CONCRETE
TYP. - TYPICAL
R - RADIUS
F.G.L. - FINISHED GROUND LEVEL
F.F.L. - FINISHED FLOOR LEVEL
B.O.F. - BOTTOM OF FOUNDATION
P.C.D. - PITCH CIRCLE DIAMETER
Ø - DIAMETER
I.D. - INTERNAL DIAMETER
P.C.C. - PLAIN CEMENT CONCRETE
MKD. - MARKED
THK. - THICK
T.O.G. - TOP OF GROUT
EQV. - EQUIVALENT
C/C - CENTRE TO CENTRE

NOTES :-

1. ALL DIMENSIONS ARE IN MILLIMETRES AND LEVELS AND CO-ORDINATES ARE IN METRES, UNLESS OTHERWISE STATED.
2. GRADE OF CONCRETE SHALL BE C35 FOR FOUNDATION. UNLESS OTHERWISE STATED.
3. GRADE OF REINFORCEMENT SHALL BE DEFORMED BAR ASTM A615 - GRADE 60 (fy = 420 MPa).
4. NET SAFE BEARING CAPACITY OF SOIL AT BOTTOM OF FOUNDATION CONSIDERED 350KN/SQ. M.
5. IF ANY PART OF FOUNDATION COMES ON BACKFILL ZONE OF ADJACENT FOUNDATION OR ANY LOOSE SOIL ARE ENCOUNTERED BELOW FOUNDATION LEVEL THE SAME SHALL BE REMOVED AND FILLED WITH PCC.
6. THE CONTENT OF THIS DRAWING SHALL CONFORM TO THE PROVISIONS OF CIVIL, STRUCTURAL AND ARCHITECTURAL DESIGN CRITERIA DOC. NO. MD-216-1000-EG-ST-CRT-1001.
7. THIS DRG. SHALL BE READ IN CONJUNCTION WITH DRG. NO. MD-216-3410-EG-CV-DED-1241.
8. PRIMING COAT SIKAFLOOR 161 + BASE & SEALER COAT OF SIKA GUARD PW OR EQUIVALENT AS PER MANUFACTURER'S SPECIFICATION.

DOCUMENT NUMBER	REFERENCE DOCUMENTS	REV	DATE	REVISION DESCRIPTION	DRN	CHK	ENG	APP	EMP
MD-216-3410-EG-ME-PLN-1004	3410-REA-004 POX RECYCLE TANK								
MD-216-3410-EG-ME-PLN-1003	3410-REA-003 POX RECYCLE TANK	D01	15/03/2023	AS-BUILT	ABS	SJM	SOR	AG	
MD-216-3410-EG-ME-PLN-1002	3410-REA-002 POX FEED TANK	C01	29/04/2020	ISSUED FOR CONSTRUCTION AND REVISED AS PER EMPLOYER	ABS	SJM	SOR	AG	
MD-216-3410-EG-ME-PLN-1001	3410-REA-001 POX FEED TANK			COMMENTS ON 24/04/2020 & REVISED AS MKD.					
MD-216-3410-EG-CV-GAD-1001	PRESSURE OXIDATION - AUTOCLAVE FEED STORAGE	A01	13/03/2020	ISSUED FOR REFERENCE	ABS	SJM	SOR	AG	

RESERVED FOR VENDOR LOGO AND DRAWING NUMBER

LARSEN & TOUBRO

This drawing is the property of LARSEN & TOUBRO and must not be passed on to any person or body not authorized by us to receive it nor be copied or otherwise made use either in full or in part by such person or body without our prior permission in writing.

Outotec

The content of these documents are the sole property of Outotec Oyj. Any rights not expressly granted herein are reserved. Reproduction, transfer or distribution of part or all of the contents in any form without prior written permission of Outotec is prohibited.

MA'ADEN معادن
Saudi Arabian Mining Company شركة معادن السعودية للتعدين

This document and the information contained herein is Ma'aden proprietary know-how. This document or any part thereof should not be reproduced, stored in a retrieval system or transmitted by any means, electronic or otherwise, or divulged without prior written permission of Ma'aden.

LARSEN & TOUBRO DRAWING NUMBER		REVISION
019045_450_C_G_24104_001		2
OUTOTEC DRAWING NUMBER	DOCUMENT ID	REVISION
900707__GAU01__HH12__MTL01__34106	OU100675109	2

DRAWN	ABS	15/02/2020
CHECKED	SJM	20/02/2020
ENGINEER	SOR	15/02/2020
APPROVED	AG	13/03/2020
EMPLOYER		
SCALE	1:100, 1:50, 1:25, 1:20	A0

MANSOURAH - MASSARAH GOLD PROJECT
GENERAL ARRANGEMENT DRAWING
PRESSURE OXIDATION - AUTOCL. FEED STORAGE
LAYOUT & DETAIL OF TANK FOUNDATIONS

DRAWING NUMBER: MD - 216 - 3410 - EG - CV - GAD - 1240
REV: D01