


DRAWING NUMBER: MD-216-3410-EG-CV-GAD-1241 REV D01

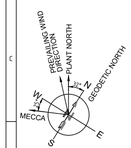


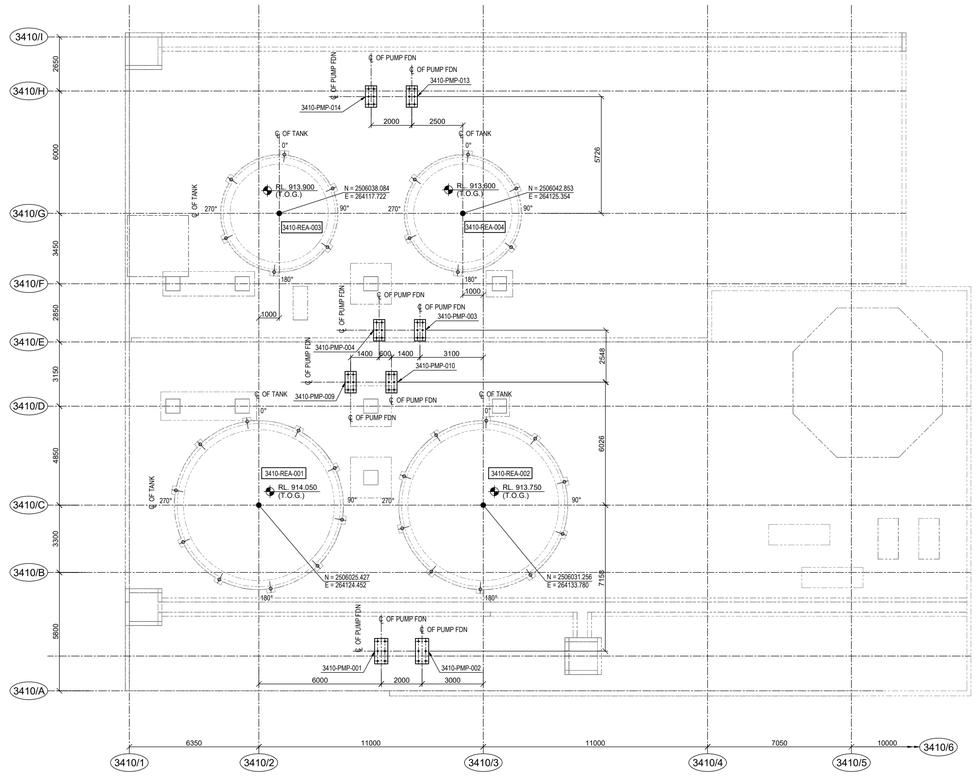


LAYOUT OF PUMP FOUNDATION
FOR AUTOCLAVE FEED STORAGE AREA
(SCALE - 1:100)

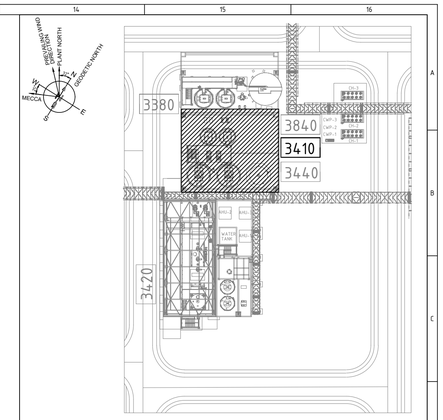


KEY PLAN
(SCALE- 1:750)

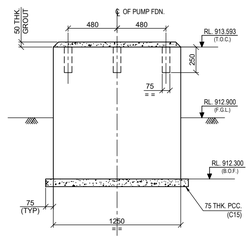


SECTION : A-A
SCALE 1:20

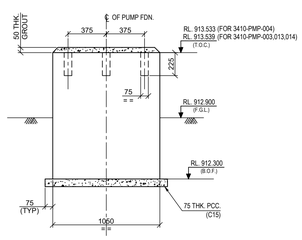


SECTION : B-B
SCALE 1:20

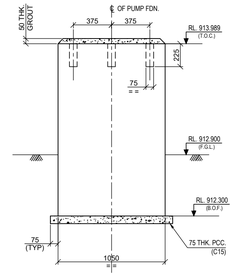


SECTION : C-C
SCALE 1:20

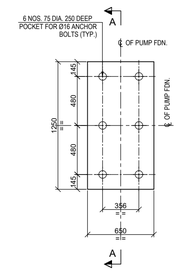

FDN. FOR PUMP MKD. 3410-PMP-001,3410-PMP-002
(2 NOS. REQD.)
SCALE 1:20

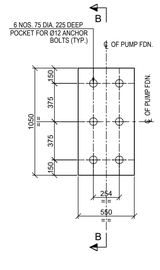

FDN. FOR PUMP MKD. 3410-PMP-003,3410-PMP-004,
3410-PMP-013,3410-PMP-014
(4 NOS. REQD.)
SCALE 1:20

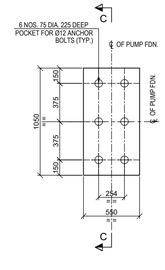

FDN. FOR PUMP MKD. 3410-PMP-009,3410-PMP-010
(2 NOS. REQD.)
SCALE 1:20

LEGEND :-
AUTOCL. - AUTOCLAVE
R.L. - REDUCED LEVEL
℄ - CENTRE LINE
T.O.C. - TOP OF CONCRETE
T.O.G. - TOP OF GROUT
TYP. - TYPICAL
F.G.L. - FINISHED GROUND LEVEL
F.F.L. - FINISHED FLOOR LEVEL
B.O.F. - BOTTOM OF FOUNDATION
Ø - DIAMETER
P.C.C - PLAIN CEMENT CONCRETE
MKD. - MARKED
THK. - THICK
C/C - CENTRE TO CENTRE
FDN. - FOUNDATION
DET. - DETAIL
REQD. - REQUIRED
DIA - DIAMETER

NOTES :-
1. ALL DIMENSIONS ARE IN MILLIMETRES AND LEVELS AND CO-ORDINATES ARE IN METRES. UNLESS OTHERWISE STATED.
2. GRADE OF CONCRETE SHALL BE C35 (35MPa) FOR FOUNDATION.
3. GRADE OF REINFORCEMENT SHALL BE DEFORMED BAR ASTM A615 - GRADE 60 (fy = 420 MPa).
4. NET SAFE BEARING CAPACITY OF SOIL AT BOTTOM OF FOUNDATION IS CONSIDERED AS 350 KN/SQ.M.
5. IF ANY PART OF FOUNDATION COMES ON BACKFILL ZONE OF ADJACENT FOUNDATION OR ANY LOOSE SOIL ARE ENCOUNTERED BELOW FOUNDATION LEVEL THE SAME SHALL BE REMOVED AND FILLED WITH PCC.
6. FOR STANDARD REINFORCEMENT DETAIL & GENERAL NOTES FOR CIVIL WORKS REFER DRAWING NO. MD-216-1000-EG-CV-DED-1005 &1001.

DOCUMENT NUMBER	REFERENCE DOCUMENTS	REV	DATE	REVISION DESCRIPTION	DRN	CHK	ENG	APP	EMP
MD-216-3410-EG-ME-GAD-V051-1008	3410-PMP-014								
MD-216-3410-EG-ME-GAD-V051-1007	3410-PMP-013								
MD-216-3410-EG-ME-GAD-V051-1006	3410-PMP-010								
MD-216-3410-EG-ME-GAD-V051-1005	3410-PMP-009								
MD-216-3410-EG-ME-GAD-V051-1004	3410-PMP-004								
MD-216-3410-EG-ME-GAD-V051-1003	3410-PMP-003								
MD-216-3410-EG-ME-GAD-V051-1002	3410-PMP-002								
MD-216-3410-EG-ME-GAD-V051-1001	3410-PMP-001	D01	15/03/2023	AS-BUILT	PML	SJM	SOR	AG	
MD-216-3420-EG-ME-GAD-1011	PRESSURE OXIDATION - FEED STORAGE	C01	13/11/2020	ISSUED FOR CONSTRUCTION	PML	SJM	SOR	AG	
	PLAN AT EL. +912.900	A01	29/09/2020	ISSUED FOR APPROVAL	PML	SJM	SOR	AG	

RESERVED FOR VENDOR LOGO AND DRAWING NUMBER

This drawing is the property of LARSEN & TOUBRO and must not be passed on to any person or body not authorised by us to receive it nor be copied or otherwise made use either in full or in part by such person or body without our prior permission in writing.

The content of these documents are the sole property of Outotec Oy. Any rights not expressly granted herein are reserved. Reproduction, transfer or distribution of part or all of the contents in any form without prior written permission of Outotec is prohibited.

This document and the information contained herein is Ma'aden proprietary know-how. This document or any part thereof should not be reproduced, stored in a retrieval system or transmitted by any means, electronic or otherwise, or divulged without prior written permission of Ma'aden.

LARSEN & TOUBRO DRAWING NUMBER	019045_450_C_G_24424_001
REVISION	2
OUTOTEC DRAWING NUMBER	900707__GAU01__HH12__MTL01__34110
DOCUMENT ID	OU100698185
REVISION	2
DRAWN	PML 21/09/2020
CHECKED	SJM 22/09/2020
ENGINEER	SOR 21/09/2020
APPROVED	AG 29/09/2020
EMPLOYER	
SCALE	1:100, 1:50, 1:25, 1:20
	A0
DRAWING NUMBER	MD-216-3410-EG-CV-GAD-1241
REV	D01

MANSOURAH - MASSARAH GOLD PROJECT
GENERAL ARRANGEMENT DRAWING
PRESSURE OXIDATION - AUTOCL. FEED STORAGE
GA & DETAILS OF PUMP FOUNDATION