


DRAWING NUMBER: MD - 216 - 3410 - EG - CV - GAD - 1242
REV: D01

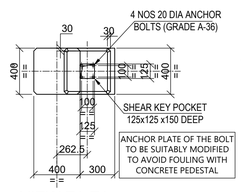


VIEW Z1-Z1
FOR COLUMN MKD. P3
SCALE 1:25

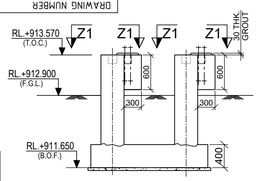


SECTION D - D
SCALE 1:50

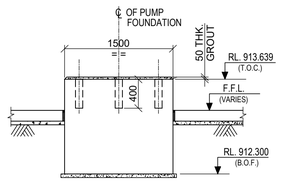


SECTION : F-F
SCALE 1:40

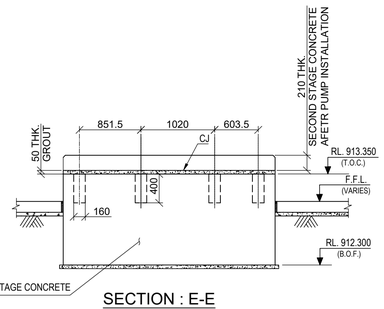


SECTION : E-E
SCALE 1:40

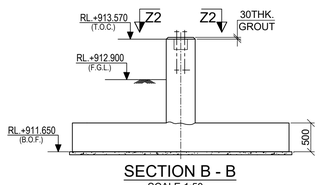


SECTION B - B
SCALE 1:50

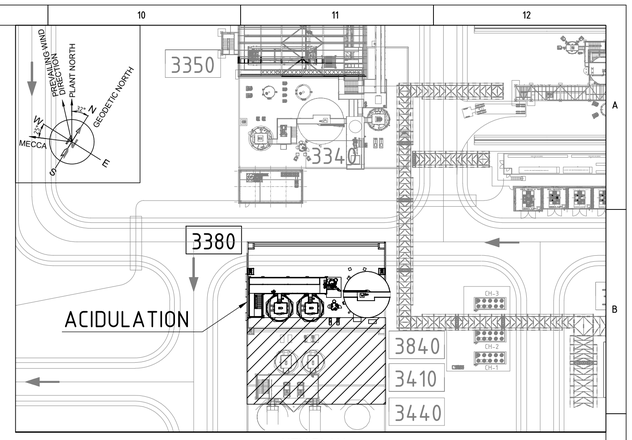


KEY PLAN
(SCALE- 1:750)

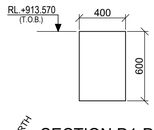


SECTION D1-D1
SCALE 1:25

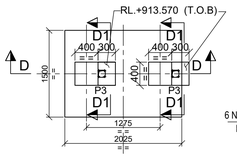


DETAILS OF FDN. MKD F4
SCALE 1:50

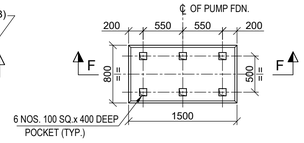


FDN. FOR PUMP MKD.
3450-PMP-005,006
SCALE 1:40

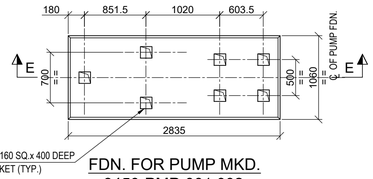


FDN. FOR PUMP MKD.
3450-PMP-001,002
SCALE 1:40

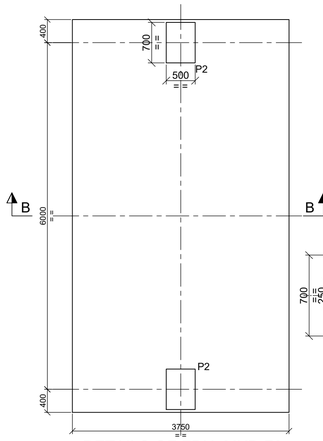


DETAILS OF FDN. MKD F2
SCALE 1:50

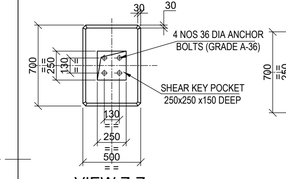


VIEW Z-Z
FOR COLUMN MKD. P1
SCALE 1:25

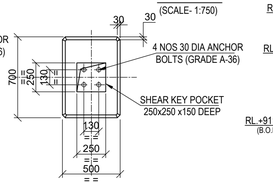


VIEW Z2-Z2
FOR COLUMN MKD. P2
SCALE 1:25

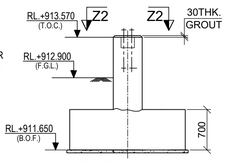


SECTION C - C
SCALE 1:50

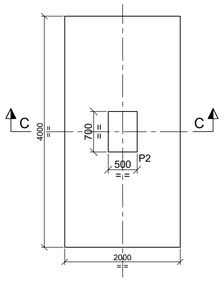

DETAILS OF FDN. MKD F3
SCALE 1:50

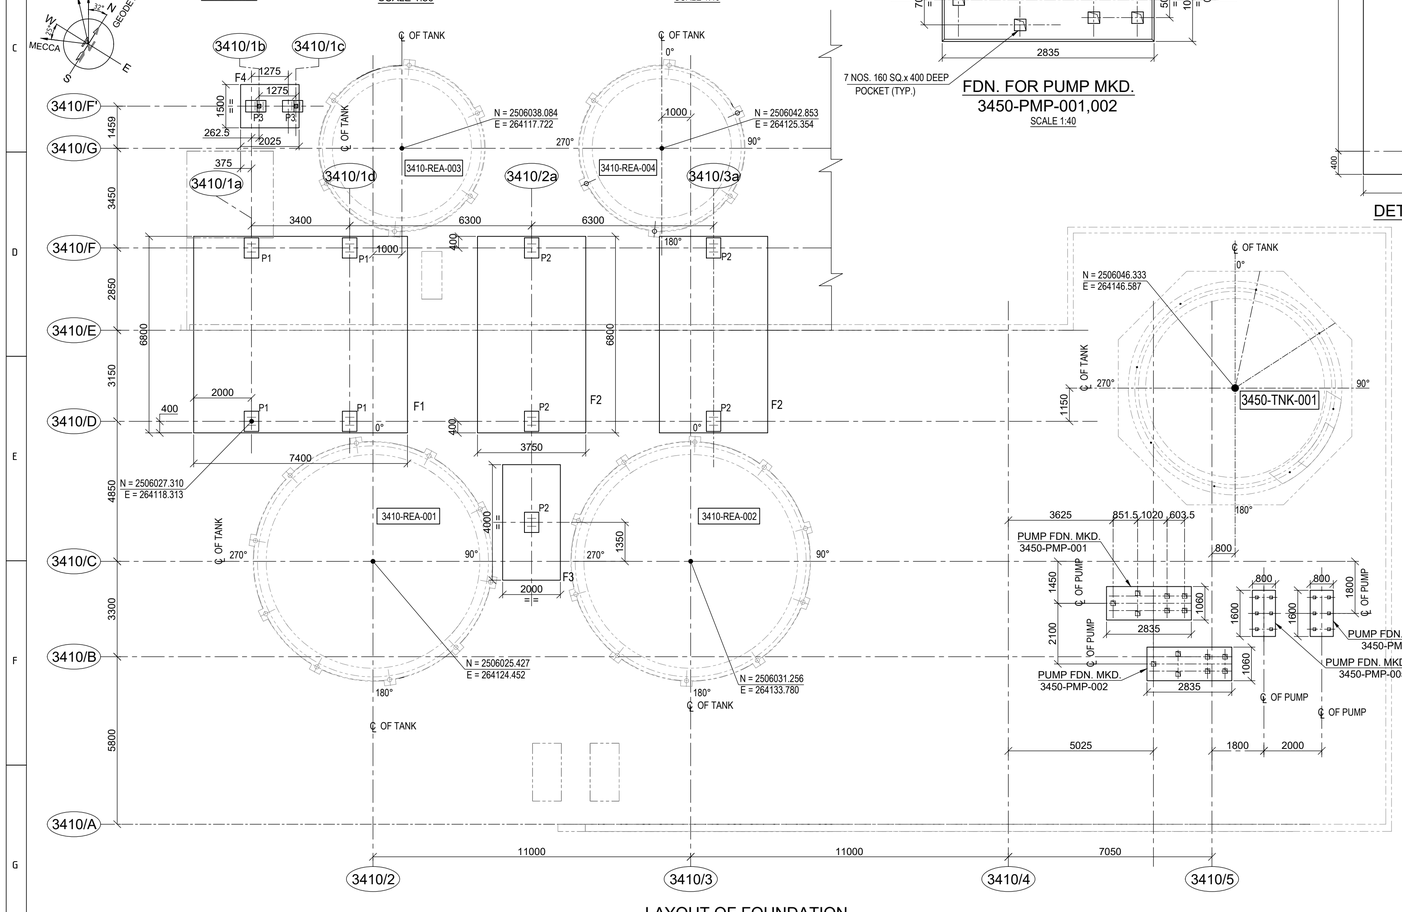

LAYOUT OF FOUNDATION

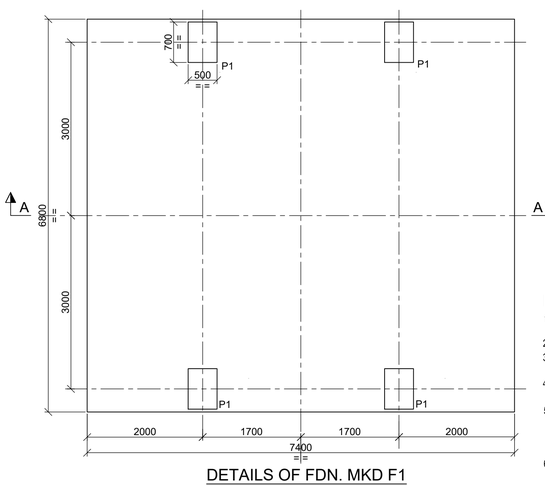

SECTION A - A
SCALE 1:50

DETAILS OF FDN. MKD F1
SCALE 1:50

LEGEND :-

R.L. - REDUCED LEVEL
T.O.C. - TOP OF CONCRETE.
F.G.L. - FINISHED GROUND LEVEL.
F.F.L. - FINISHED FLOOR LEVEL.
B.O.F. - BOTTOM OF FOUNDATION
TYP. - TYPICAL
P.C.D. - PITCH CIRCLE DIAMETER.
P.C.C - PLAIN CEMENT CONCRETE
MKD. - MARKED.
THK. - THICK
EQV. - EQUIVALENT
Ø - DIAMETER
CJ - CONSTRUCTION JOINT
DIA - DIAMETER
FDN. - FOUNDATION
DRG. - DRAWING
℄ - CENTRE LINE
T.O.B - TOP OF BEAM

NOTES :-

1. ALL DIMENSIONS ARE IN MILLIMETRES AND LEVELS AND CO-ORDINATES ARE IN METERS. UNLESS OTHERWISE STATED.
2. GRADE OF CONCRETE SHALL BE C35 FOR FOUNDATION.
3. GRADE OF REINFORCEMENT SHALL BE DEFORMED BAR ASTM A615 - GRADE 60 (fy = 420 MPa).
4. NET SAFE BEARING CAPACITY OF SOIL AT BOTTOM OF FOUNDATION IS CONSIDERED 400KN/SQ. M.
5. IF ANY PART OF FOUNDATION COMES ON BACKFILL ZONE OF ADJACENT FOUNDATION OR ANY LOOSE SOIL ARE ENCOUNTERED BELOW FOUNDATION LEVEL THE SAME SHALL BE REMOVED AND FILLED WITH PCC.
6. THIS DRG. SHALL BE READ IN CONJUNCTION WITH DRG. NO. MD-216-3410-EG-CV-DED-1243.

DOCUMENT NUMBER	REFERENCE DOCUMENTS	REV	DATE	REVISION DESCRIPTION	DRN	CHK	ENG	APP	EMP
		D01	15/03/2023	AS-BUILT	SYA	SJM	SOR	AG	
		C02	05/01/2022	ISSUED FOR CONSTRUCTION & REVISED AS MARKED	SYA	SJM	SOR	AG	
MD-216-3420-EG-ME-GAD-1011	FEED STORAGE - PLAN AT EL. +912.900	C01	24/11/2020	ISSUED FOR CONSTRUCTION & REVISED AS MARKED	SYA	SJM	SOR	AG	
MD-216-3410-EG-ST-GAD-2227	FEED STORAGE - PLAN, ELEVATIONS & DETAILS	A01	16/10/2020	ISSUED FOR REFERENCE	AUD	SJM	SOR	AG	

RESERVED FOR VENDOR LOGO AND DRAWING NUMBER

LARSEN & TOUBRO
This drawing is the property of LARSEN & TOUBRO and must not be passed on to any person or body not authorized by us to receive it nor be copied or otherwise made use either in full or in part by such person or body without our prior permission in writing.

Outotec
The content of these documents are the sole property of Outotec Oyj. Any rights not expressly granted herein are reserved. Reproduction, transfer or distribution of part or all of the contents in any form without prior written permission of Outotec is prohibited.

MA'ADEN معادن
Saudi Arabian Mining Company شركة معادن العربية السعودية
This document and the information contained herein is Ma'aden proprietary know-how. This document or any part thereof should not be reproduced, stored in a retrieval system or transmitted by any means, electronic or otherwise, or divulged without prior written permission of Ma'aden.

LARSEN & TOUBRO DRAWING NUMBER: 019045_450_C_G_24430_001 — REVISION: 3
OUTOTEC DRAWING NUMBER: 900707 _GAU01 _HH12 _MTL01 _34111 — DOCUMENT ID: OU100703592 — REVISION: 3

DRAWN	AUD	10/10/2020	MANSOURAH - MASSARAH GOLD PROJECT
CHECKED	SJM	14/10/2020	GENERAL ARRANGEMENT DRAWING
ENGINEER	SOR	10/10/2020	PRESSURE OXIDATION - AUTOCL. FEED STORAGE
APPROVED	AG	16/10/2020	GA & DETAILS OF BUILDING FOUNDATION
EMPLOYER			
SCALE	1:75, 1:50, 1:25, 1:10	A1	DRAWING NUMBER: MD - 216 - 3410 - EG - CV - GAD - 1242 — REV: D01