


DRAWING NUMBER: MD-216-3410-EG-CV-GAD-1243 | REV: D01

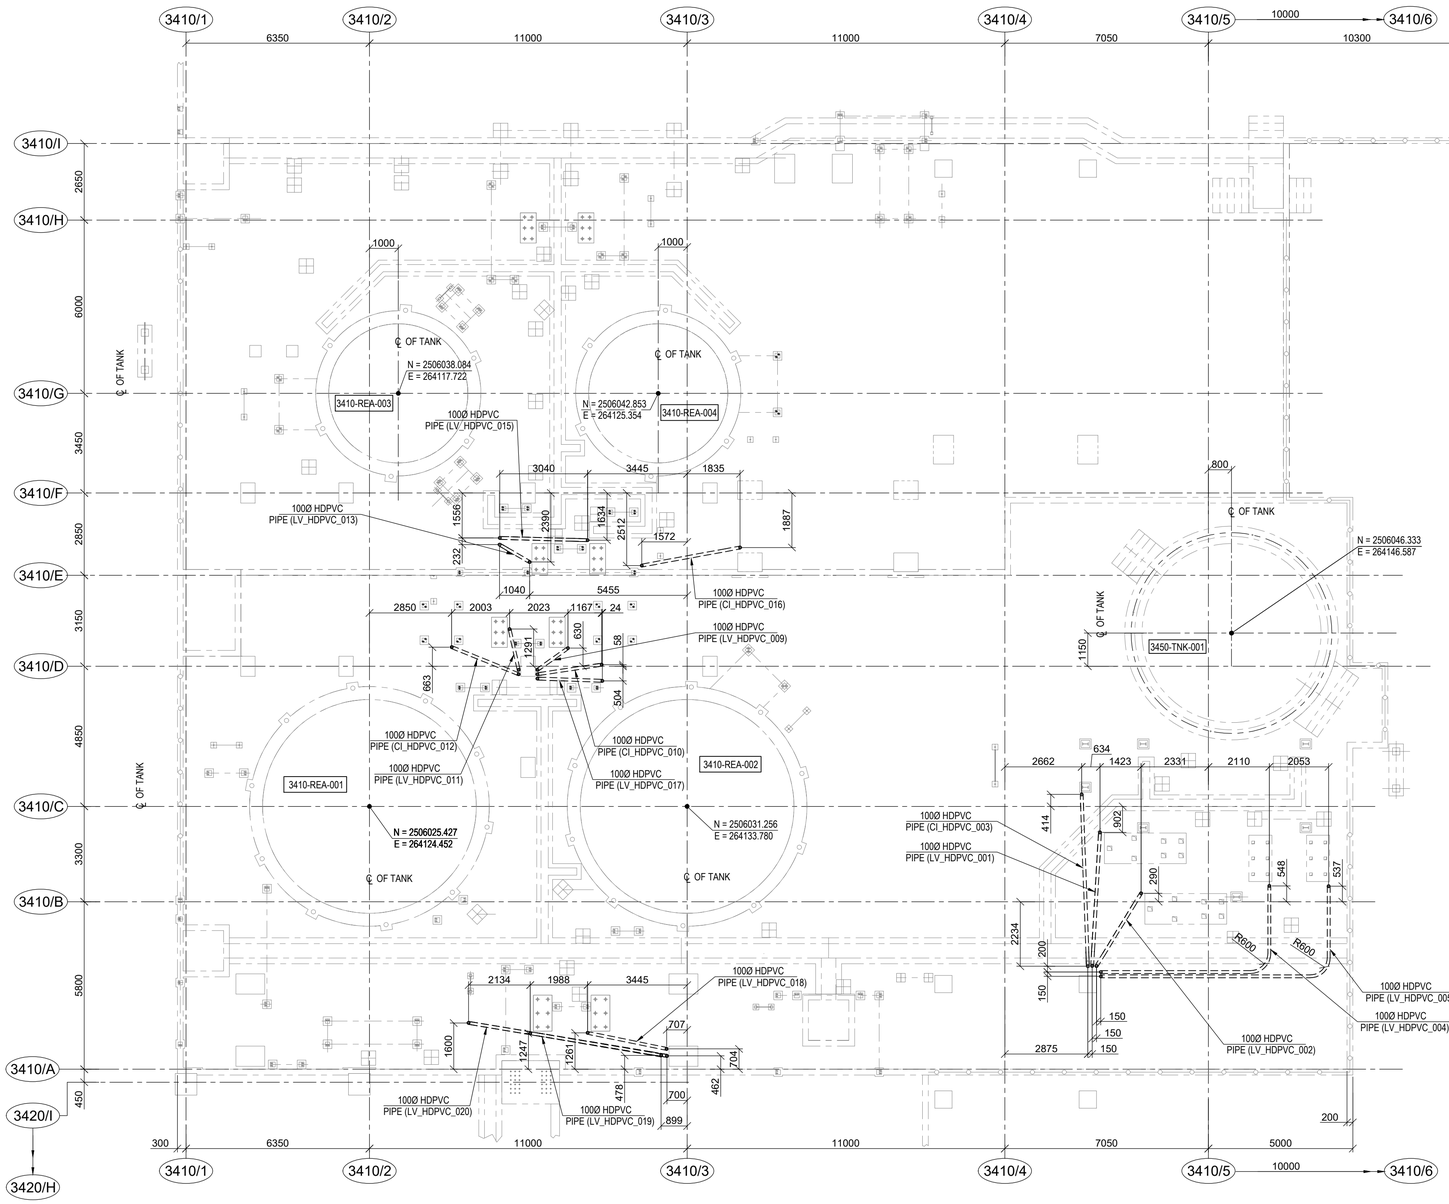

LAYOUT OF EMBEDDED ELECTRICAL CONDUITS
(SCALE - 1:100)

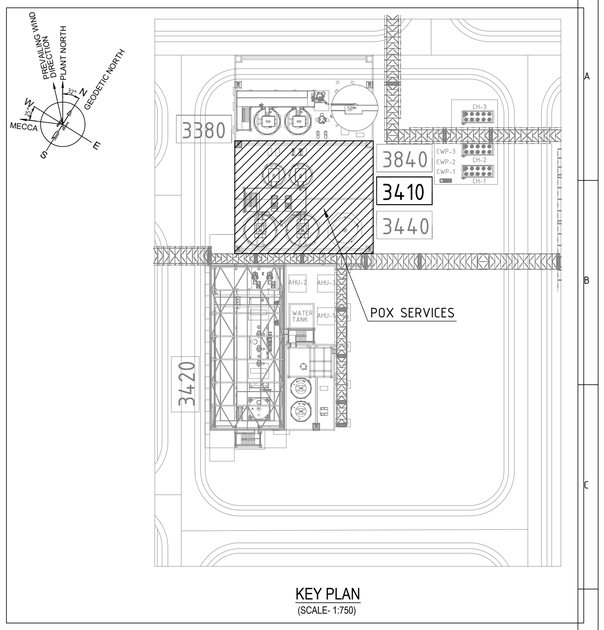

KEY PLAN
(SCALE- 1:750)

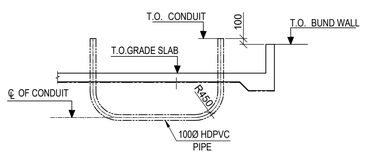

TYPICAL DETAIL OF CONDUIT
SCALE 1:50

SCHEDULE OF CONDUIT :-

CONDUIT MKD.	ELEVATION AT ℄ OF CONDUIT
LV_HDPVC_001	RL 911.070
LV_HDPVC_002	RL 911.070
CI_HDPVC_003	RL 911.070
LV_HDPVC_004	RL 911.070
LV_HDPVC_005	RL 911.070
LV_HDPVC_009	RL 912.320
CI_HDPVC_010	RL 912.320
LV_HDPVC_011	RL 912.320
CI_HDPVC_012	RL 912.320
LV_HDPVC_013	RL 912.220
LV_HDPVC_015	RL 912.270
CI_HDPVC_016	RL 912.420
LV_HDPVC_017	RL 912.320
LV_HDPVC_018	RL 912.375
LV_HDPVC_019	RL 912.375
LV_HDPVC_020	RL 912.225

LEGEND :-

R.L. - REDUCED LEVEL
I.L. - INVERT LEVEL
THK. - THICK
TYP. - TYPICAL.
T.O.C - TOP OF CONCRETE
℄ - CENTRE LINE
P.C.C - PLAIN CEMENT CONCRETE
Ø - DIAMETER
T.O. BUND WALL - TOP OF BUND WALL
T.O. CONDUIT - TOP OF CONDUIT
R - RADIUS
DIA - DIAMETER

NOTES:-

1. ALL DIMENSIONS ARE IN MILLIMETRES AND LEVELS AND CO-ORDINATES ARE IN METRES UNLESS OTHERWISE STATED.
2. THIS DRAWING IS TO BE READ IN CONJUNCTION WITH DRAWING NO- MD-216-3450-EG-CV-DED-1266,1267 & MD-216-3450-EG-CV-GAD-1259,1260.

DOCUMENT NUMBER	REFERENCE DOCUMENTS	REV	DATE	REVISION DESCRIPTION	DRN	CHK	ENG	APP	EMP
MD-216-3400-EG-EL-LAD-1001	PRESSURE OXIDATION								
	CABLE ROUTE LAYOUT								
MD-216-3420-EG-ME-GAD-1001	GENERAL ARRANGEMENT DRAWING PRESSURE OXIDATION	D01	15/03/2023	AS-BUILT	PML	SJM	SOR	AG	
	-FEED STORAGE PLAN AT EL. +912.900	C02	12/04/2021	ISSUED FOR CONSTRUCTION AND REVISED AS MARKED C02	PML	SJM	SOR	AG	
MD-216-3410-EG-CV-GAD-1001	CIVIL WORKS GUIDE DRAWING PRESSURE OXIDATION-	C01	06/04/2021	ISSUED FOR CONSTRUCTION AND REVISED AS MARKED C01	PML	SJM	SOR	AG	
	AUTOCLAVE FEED STORAGE PLAN AT EL. +912.900	A01	11/03/2021	ISSUED FOR REVIEW	PML	SJM	SOR	AG	

RESERVED FOR VENDOR LOGO AND DRAWING NUMBER

LARSEN & TOUBRO
This drawing is the property of LARSEN & TOUBRO and must not be passed on to any person or body not authorized by us to receive it nor be copied or otherwise made use either in full or in part by such person or body without our prior permission in writing.

Outotec
The content of these documents are the sole property of Outotec Oy). Any rights not expressly granted herein are reserved. Reproduction, transfer or distribution of part or all of the contents in any form without prior written permission of Outotec is prohibited.

MA'ADEN معادن
Saudi Arabian Mining Company شركة التعدين العربية السعودية
This document and the information contained herein is Ma'aden proprietary know-how. This document or any part thereof should not be reproduced, stored in a retrieval system or transmitted by any means, electronic or otherwise, or divulged without prior written permission of Ma'aden.

LARSEN & TOUBRO DRAWING NUMBER	019045_450_C_G_24430_002		REVISION 3
OUTOTEC DRAWING NUMBER	900707__GAU01__HH12__MTL01__34112	DOCUMENT ID OU100703593	REVISION 3
DRAWN	PML	08/03/2021	MANSOURAH - MASSARAH GOLD PROJECT
CHECKED	SJM	09/03/2021	GENERAL ARRANGEMENT DRAWING
ENGINEER	SOR	08/03/2021	PRESSURE OXIDATION - AUTOCL. FEED STORAGE
APPROVED	AG	11/03/2021	LAYOUT & DETAIL OF EMBEDDED CONDUITS
EMPLOYER			
SCALE 1:100, 1:50	A1		DRAWING NUMBER MD-216-3410-EG-CV-GAD-1243 REV D01