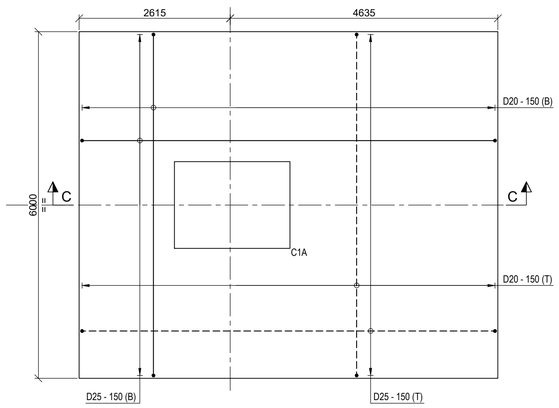
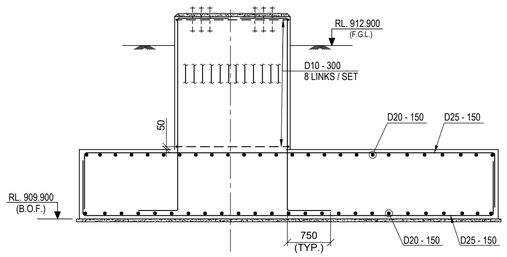
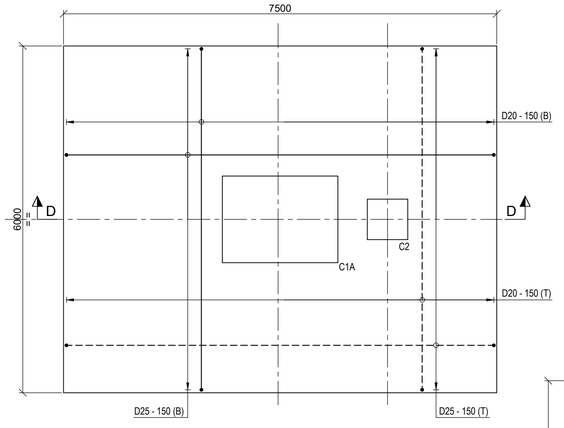
DRAWING NUMBER: MD-216-3420-EG-CV-DED-1245 | REV: D01



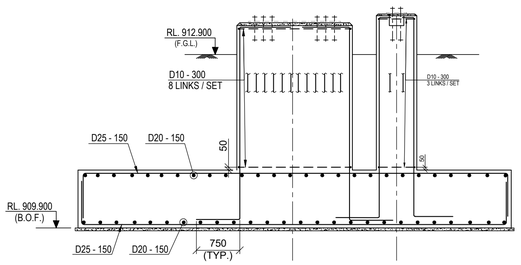

## RCC DETAILS OF FOUNDATION MKD. F2
SCALE 1:50



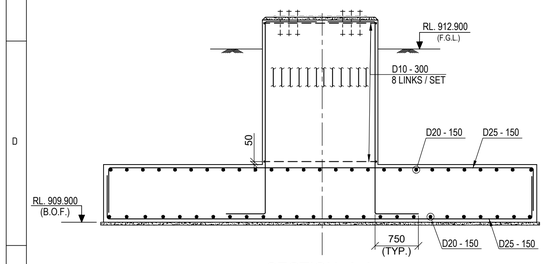

## SECTION C-C
SCALE 1:50



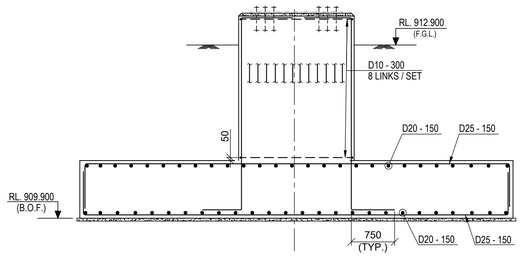

## RCC DETAILS OF FOUNDATION MKD. F3
SCALE 1:50



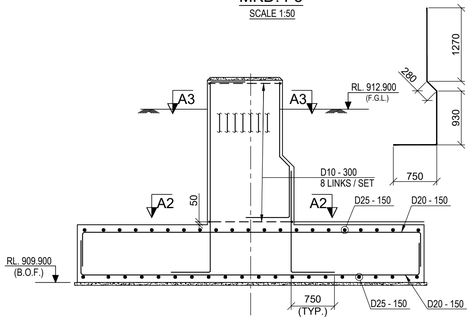

## SECTION D-D
SCALE 1:50



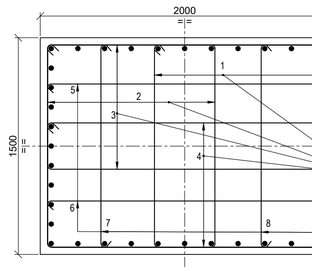

## SECTION A-A
SCALE 1:50



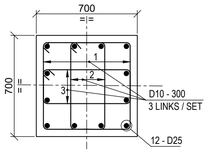

## SECTION B-B
SCALE 1:50



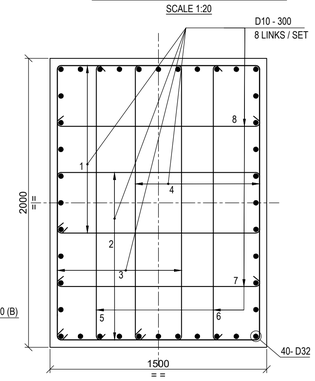

## SECTION A1-A1
SCALE 1:50



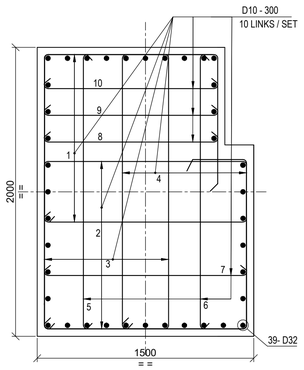

## RCC DETAILS OF C1/C1A
SCALE 1:20



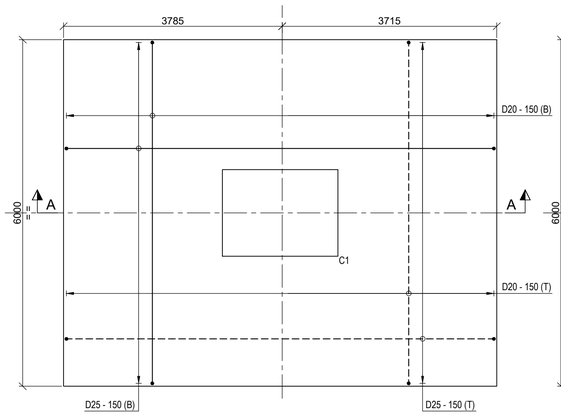

## RCC DETAILS OF C2
SCALE 1:20



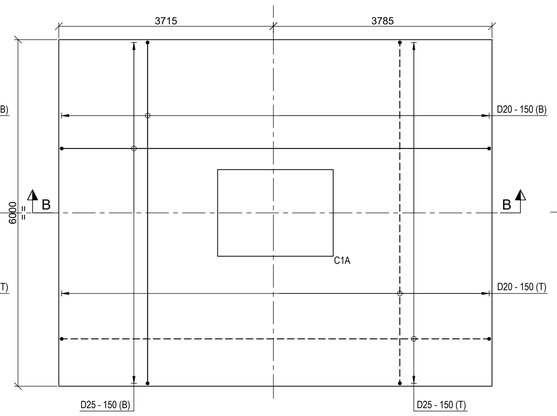

## VIEW A2-A2
SCALE 1:25



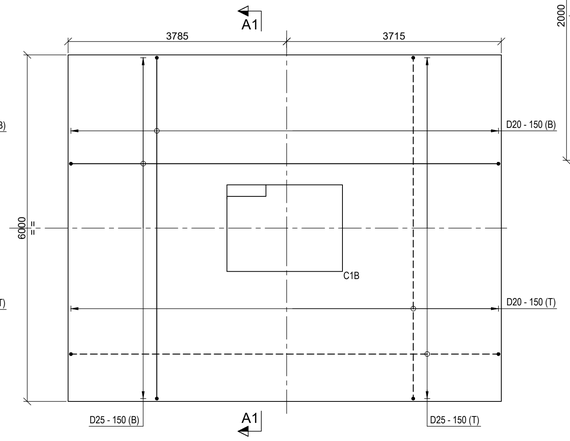

## VIEW A3-A3
SCALE 1:25




## RCC DETAILS OF FOUNDATION MKD. F1
SCALE 1:50




## RCC DETAILS OF FOUNDATION MKD. F1A
SCALE 1:50




## RCC DETAILS OF FOUNDATION MKD. F1B
SCALE 1:50

### LEGEND :-
R.L. - REDUCED LEVEL
T.O.C. - TOP OF CONCRETE.
F.G.L. - FINISHED GROUND LEVEL.
TYP. - TYPICAL
P.C.C - PLAIN CEMENT CONCRETE
BOTTOM REINF.(B) - ————
TOP REINF.(T) - – – – – –
MKD. - MARKED
℄ - CENTRE LINE
B.O.F. - BOTTOM OF FOUNDATION
THK. - THICK
FDN. - FOUNDATION
RCC - REINFORCED CEMENT CONCRETE

### NOTES :-
1. ALL DIMENSIONS ARE IN MILLIMETRES AND LEVELS AND CO-ORDINATES ARE IN METRES. UNLESS OTHERWISE STATED.
2. GRADE OF CONCRETE SHALL BE C35 (35MPa) FOR FOUNDATION & COLUMN.
3. GRADE OF REINFORCEMENT SHALL BE DEFORMED BAR ASTM A615 - GRADE 60 (fy = 420 MPa).
4. NET SAFE BEARING CAPACITY OF SOIL AT BOTTOM OF FOUNDATION IS CONSIDERED AS 475KN/SQ.M. AT RL. 909.900.
5. CLEAR COVER TO MAIN REINFORCEMENT SHALL BE AS
   a) FOUNDATION = 50 mm (BOTTOM & SIDE) 50 mm. (TOP)
   b) COLUMN = 50mm
6. IF ANY PART OF FOUNDATION COMES ON BACKFILL ZONE OF ADJACENT FOUNDATION OR ANY LOOSE SOIL ARE ENCOUNTERED BELOW FOUNDATION LEVEL THE SAME SHALL BE REMOVED AND FILLED WITH PCC.
7. FOR STANDARD REINFORCEMENT DETAIL & GENERAL NOTES FOR CIVIL WORKS REFER DRAWING NO. MD-216-1000-EG-CV-DED-1005 &1001.

| DOCUMENT NUMBER | REFERENCE DOCUMENTS | REV | DATE | REVISION DESCRIPTION | DRN | CHK | ENG | APP | EMP |
|---|---|---|---|---|---|---|---|---|---|
| MD-216-3420-EG-CV-GAD-1244 | PRESSURE OXIDATION - AUTOCLAVE BUILDINGS | | | | | | | | |
| | GA & DETAILS OF FOUNDATION | | | | | | | | |
| MD-216-3420-EG-ST-GAD-2230 | PRESSURE OXIDATION - AUTOCLAVE BUILDINGS | | | | | | | | |
| | COLUMN REACTIONS | D01 | 15/03/2023 | AS-BUILT | PML | SJM | SOR | AG | |
| MD-216-3420-EG-ST-GAD-2229 | PRESSURE OXIDATION - AUTOCLAVE BUILDINGS | C05 | 11/11/2020 | ISSUED FOR CONSTRUCTION AND REVISED AS MARKED C05 | PML | SJM | SOR | AG | |
| | ANCHOR BOLT PLAN & DETAILS | C04 | 03/11/2020 | ISSUED FOR CONSTRUCTION AND REVISED AS MARKED C04 | SYA | SJM | SOR | AG | |
| MD-216-3420-EG-ME-GAD-1013 | PRESSURE OXIDATION - AUTOCLAVE | C03 | 09/10/2020 | ISSUED FOR CONSTRUCTION AND REVISED AS MARKED C03 | PML | SJM | SOR | AG | |
| | PLAN AT EL. +912.900 | C02 | 31/08/2020 | ISSUED FOR CONSTRUCTION AND REVISED AS MARKED C02 | SYA | SJM | SOR | AG | |
| MD-216-3420-EG-CV-GAD-1001 | PRESSURE OXIDATION - AUTOCL. FLASH V. & SCRUBBER | C01 | 13/08/2020 | ISSUED FOR CONSTRUCTION | SYA | SJM | SOR | AG | |
| | PLAN AT EL. +913.400 | A01 | 13/07/2020 | ISSUED FOR REFERENCE | SYA | SJM | SOR | AG | |

RESERVED FOR VENDOR LOGO AND DRAWING NUMBER

LARSEN & TOUBRO

This drawing is the property of LARSEN & TOUBRO and must not be passed on to any person or body not authorized by us to receive it nor be copied or otherwise made use either in full or in part by such person or body without our prior permission in writing.

Outotec

The content of these documents are the sole property of Outotec Oyj. Any rights not expressly granted herein are reserved. Reproduction, transfer or distribution of part or all of the contents in any form without prior written permission of Outotec is prohibited.

MA'ADEN معادن
Saudi Arabian Mining Company شركة فتحين العربية السعودية

This document and the information contained herein is Ma'aden proprietary know-how. This document or any part thereof should not be reproduced, stored in a retrieval system or transmitted by any means, electronic or otherwise, or divulged without prior written permission of Ma'aden.

| | | |
|---|---|---|
| DRAWN | SYA | 09/07/2020 |
| CHECKED | SJM | 10/07/2020 |
| ENGINEER | SOR | 09/07/2020 |
| APPROVED | AG | 13/07/2020 |
| EMPLOYER | | |
| SCALE | 1:50, 1:10 | A1 |

LARSEN & TOUBRO DRAWING NUMBER: 019045_450_C_D_24986_003 | REVISION: 6
OUTOTEC DRAWING NUMBER: 900707__GAU01__HH12__CTB17__34233 | DOCUMENT ID: OU100688791 | REVISION: 6

MANSOURAH - MASSARAH GOLD PROJECT
DETAIL DRAWING
PRESSURE OXIDATION - AUTOCLAVE BUILDING
RCC DETAILS OF FOUNDATION

DRAWING NUMBER: MD-216-3420-EG-CV-DED-1245 | REV: D01