

DRAWING NUMBER MD-216-3420-EG-CV-DED-2002 REV D01

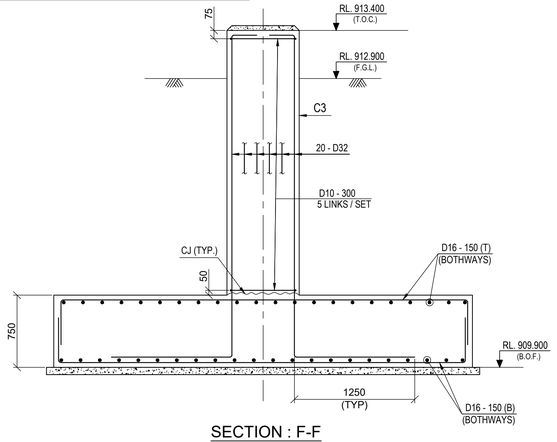


SECTION : F-F

SCALE 1:30

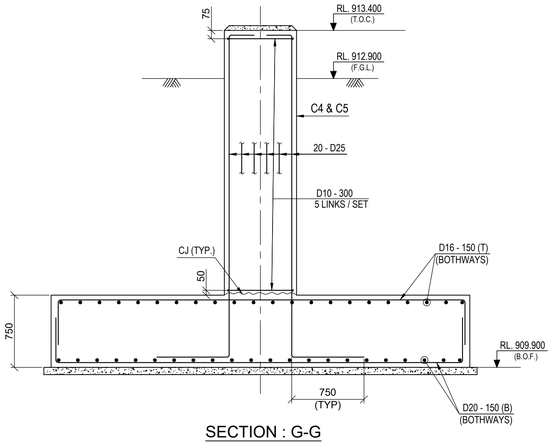


SECTION : G-G

SCALE 1:30

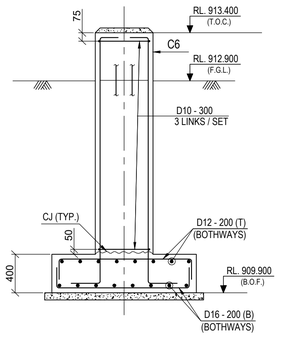


SECTION : H-H

SCALE 1:30

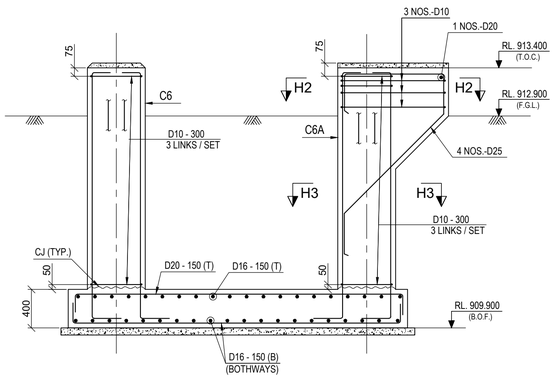


SECTION : H1-H1

SCALE 1:30

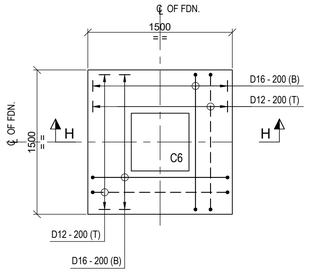

RC. DETAIL OF FOUNDATION MKD. F6


SCALE 1:30

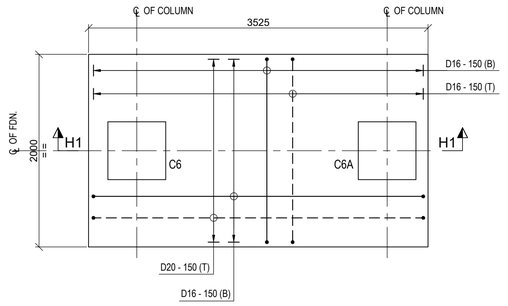

RC. DETAIL OF FOUNDATION MKD. F6A

SCALE 1:30


3420/2 3420/3

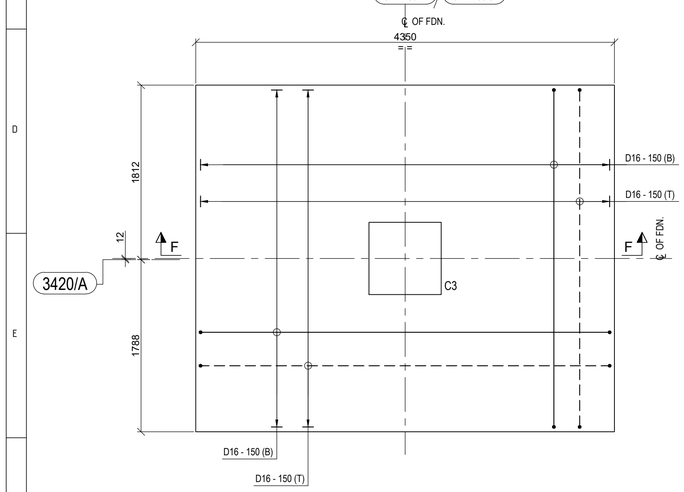

RC. DETAIL OF FOUNDATION MKD. F4

SCALE 1:30


3420/2 3420/3

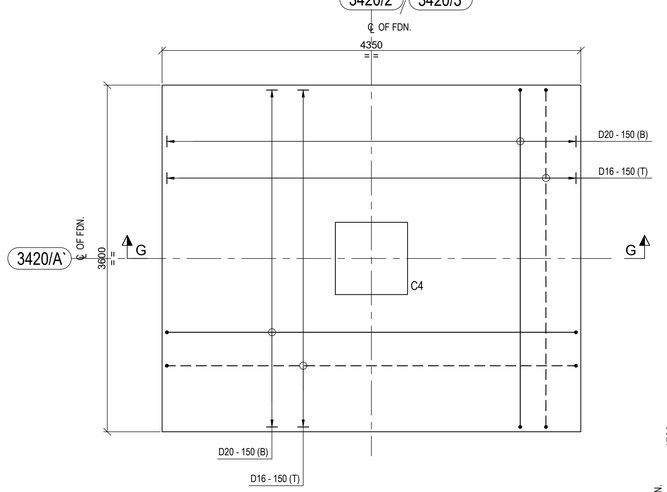

RC. DETAIL OF FOUNDATION MKD. F5

SCALE 1:30

3420/2 3420/3

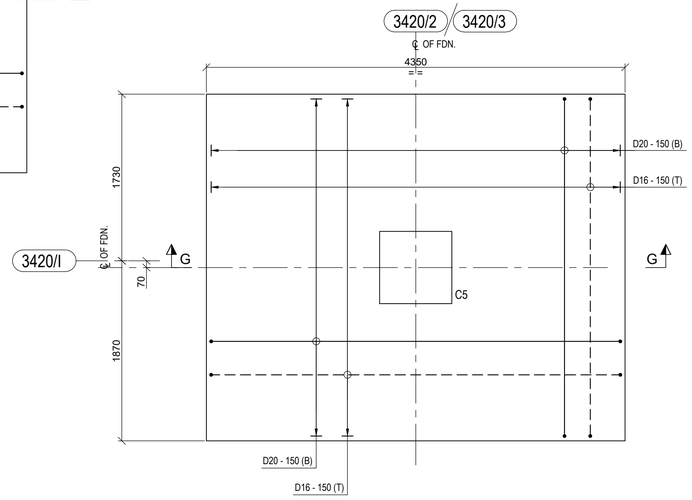

RC. DETAIL OF FOUNDATION MKD. F5A


SCALE 1:30

LEGEND :-

R.L. - REDUCED LEVEL
T.O.C. - TOP OF CONCRETE.
F.G.L. - FINISHED GROUND LEVEL.
TYP. - TYPICAL.
P.C.C - PLAIN CEMENT CONCRETE
BOTTOM REINF.(B) - ————
TOP REINF.(T) - — — — —
MKD. - MARKED
℄ - CENTRE LINE
B.O.F. - BOTTOM OF FOUNDATION
THK. - THICK
FDN. - FOUNDATION
RCC - REINFORCED CEMENT CONCRETE
CJ - CONSTRUCTION JOINT
RC - REINFORCED CONCRETE
Ø - DIAMETER


NOTES :-

1. ALL DIMENSIONS ARE IN MILLIMETRES AND LEVELS AND CO-ORDINATES ARE IN METRES. UNLESS OTHERWISE STATED.
2. GRADE OF CONCRETE SHALL BE C35 (35MPa) FOR FOUNDATION & COLUMN.
3. GRADE OF REINFORCEMENT SHALL BE DEFORMED BAR ASTM A615 - GRADE 60 (fy = 420 MPa).
4. NET SAFE BEARING CAPACITY OF SOIL AT BOTTOM OF FOUNDATION IS CONSIDERED AS 475KN/SQ.M. AT RL. 909.900.
5. CLEAR COVER TO MAIN REINFORCEMENT SHALL BE AS
   a) FOUNDATION = 50 mm (BOTTOM & SIDE) 50 mm. (TOP)
   b) COLUMN = 50mm
6. IF ANY PART OF FOUNDATION COMES ON BACKFILL ZONE OF ADJACENT FOUNDATION OR ANY LOOSE SOIL ARE ENCOUNTERED BELOW FOUNDATION LEVEL THE SAME SHALL BE REMOVED AND FILLED WITH PCC.
7. FOR STANDARD REINFORCEMENT DETAIL & GENERAL NOTES FOR CIVIL WORKS REFER DRAWING NO. MD-216-1000-EG-CV-DED-1005 &1001.

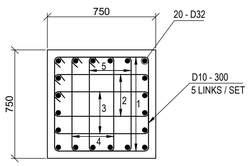


RC. DETAIL OF C3

SCALE 1:20

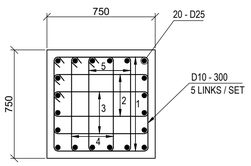


RC. DETAIL OF C4 & C5

SCALE 1:20

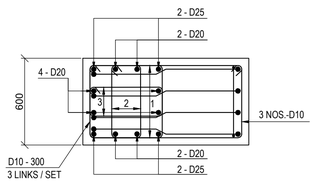

SECTION : H2-H2

SCALE 1:20

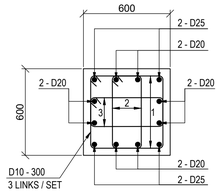

SECTION : H3-H3

SCALE 1:20

MD-216-3420-EG-CV-GAD-1244	PRESSURE OXIDATION - AUTOCLAVE BUILDINGS								
	GA & DETAILS OF FOUNDATION								
MD-216-3420-EG-ST-GAD-2230	PRESSURE OXIDATION - AUTOCLAVE BUILDINGS								
	COLUMN REACTIONS								
MD-216-3420-EG-ST-GAD-2229	PRESSURE OXIDATION - AUTOCLAVE BUILDINGS								
	ANCHOR BOLT PLAN & DETAILS	D01	15/03/2023	AS-BUILT	PML	SJM	SOR	AG	
MD-216-3420-EG-ME-GAD-1013	PRESSURE OXIDATION - AUTOCLAVE	C01	01/10/2020	ISSUED FOR CONSTRUCTION & REVISED AS MARKED (01)	PML	SJM	SOR	AG	
	PLAN AT EL. +912.900	A01	11/09/2020	ISSUED FOR REFERENCE	PML	SJM	SOR	AG	
DOCUMENT NUMBER	REFERENCE DOCUMENTS	REV	DATE	REVISION DESCRIPTION	DRN	CHK	ENG	APP	EMP

RESERVED FOR VENDOR LOGO AND DRAWING NUMBER

LARSEN & TOUBRO

This drawing is the property of LARSEN & TOUBRO and must not be passed on to any person or body not authorized by us to receive it nor be copied or otherwise made use either in full or in part by such person or body without our prior permission in writing.

Outotec

The content of these documents are the sole property of Outotec Oyj. Any rights not expressly granted herein are reserved. Reproduction, transfer or distribution of part or all of the contents in any form without prior written permission of Outotec is prohibited.

MA'ADEN معادن
Saudi Arabian Mining Company شركة معادن العربية السعودية

This document and the information contained herein is Ma'aden proprietary know-how. This document or any part thereof should not be reproduced, stored in a retrieval system or transmitted by any means, electronic or otherwise, or divulged without prior written permission of Ma'aden.

LARSEN & TOUBRO DRAWING NUMBER: 019045_450_C_D_24986_001 — REVISION: 2
OUTOTEC DRAWING NUMBER: 900707__GAU01__HH12__CTB17__34231 — DOCUMENT ID: OU100688026 — REVISION: 2

DRAWN	PML	07/09/2020
CHECKED	SJM	09/09/2020
ENGINEER	SOR	07/09/2020
APPROVED	AG	11/09/2020
EMPLOYER		
SCALE 1:50, 1:10	A1	

MANSOURAH - MASSARAH GOLD PROJECT
DETAIL DRAWING
PRESSURE OXIDATION - AUTOCLAVE BUILDING
RCC DETAILS OF FOUNDATION

DRAWING NUMBER: MD-216-3420-EG-CV-DED-2002 — REV: D01